


| | |
|--------------|------|
| FINAL SURVEY | DATE |
| NO. | |
| NOTED | BY |
| NO. | |
| NOTED | DATE |
| NO. | |
| NOTED | DATE |
| NO. | |

| | |
|-----------------|------|
| ORIGINAL SURVEY | DATE |
| NO. | |
| NOTED | BY |
| NO. | |
| NOTED | DATE |
| NO. | |
| NOTED | DATE |
| NO. | |

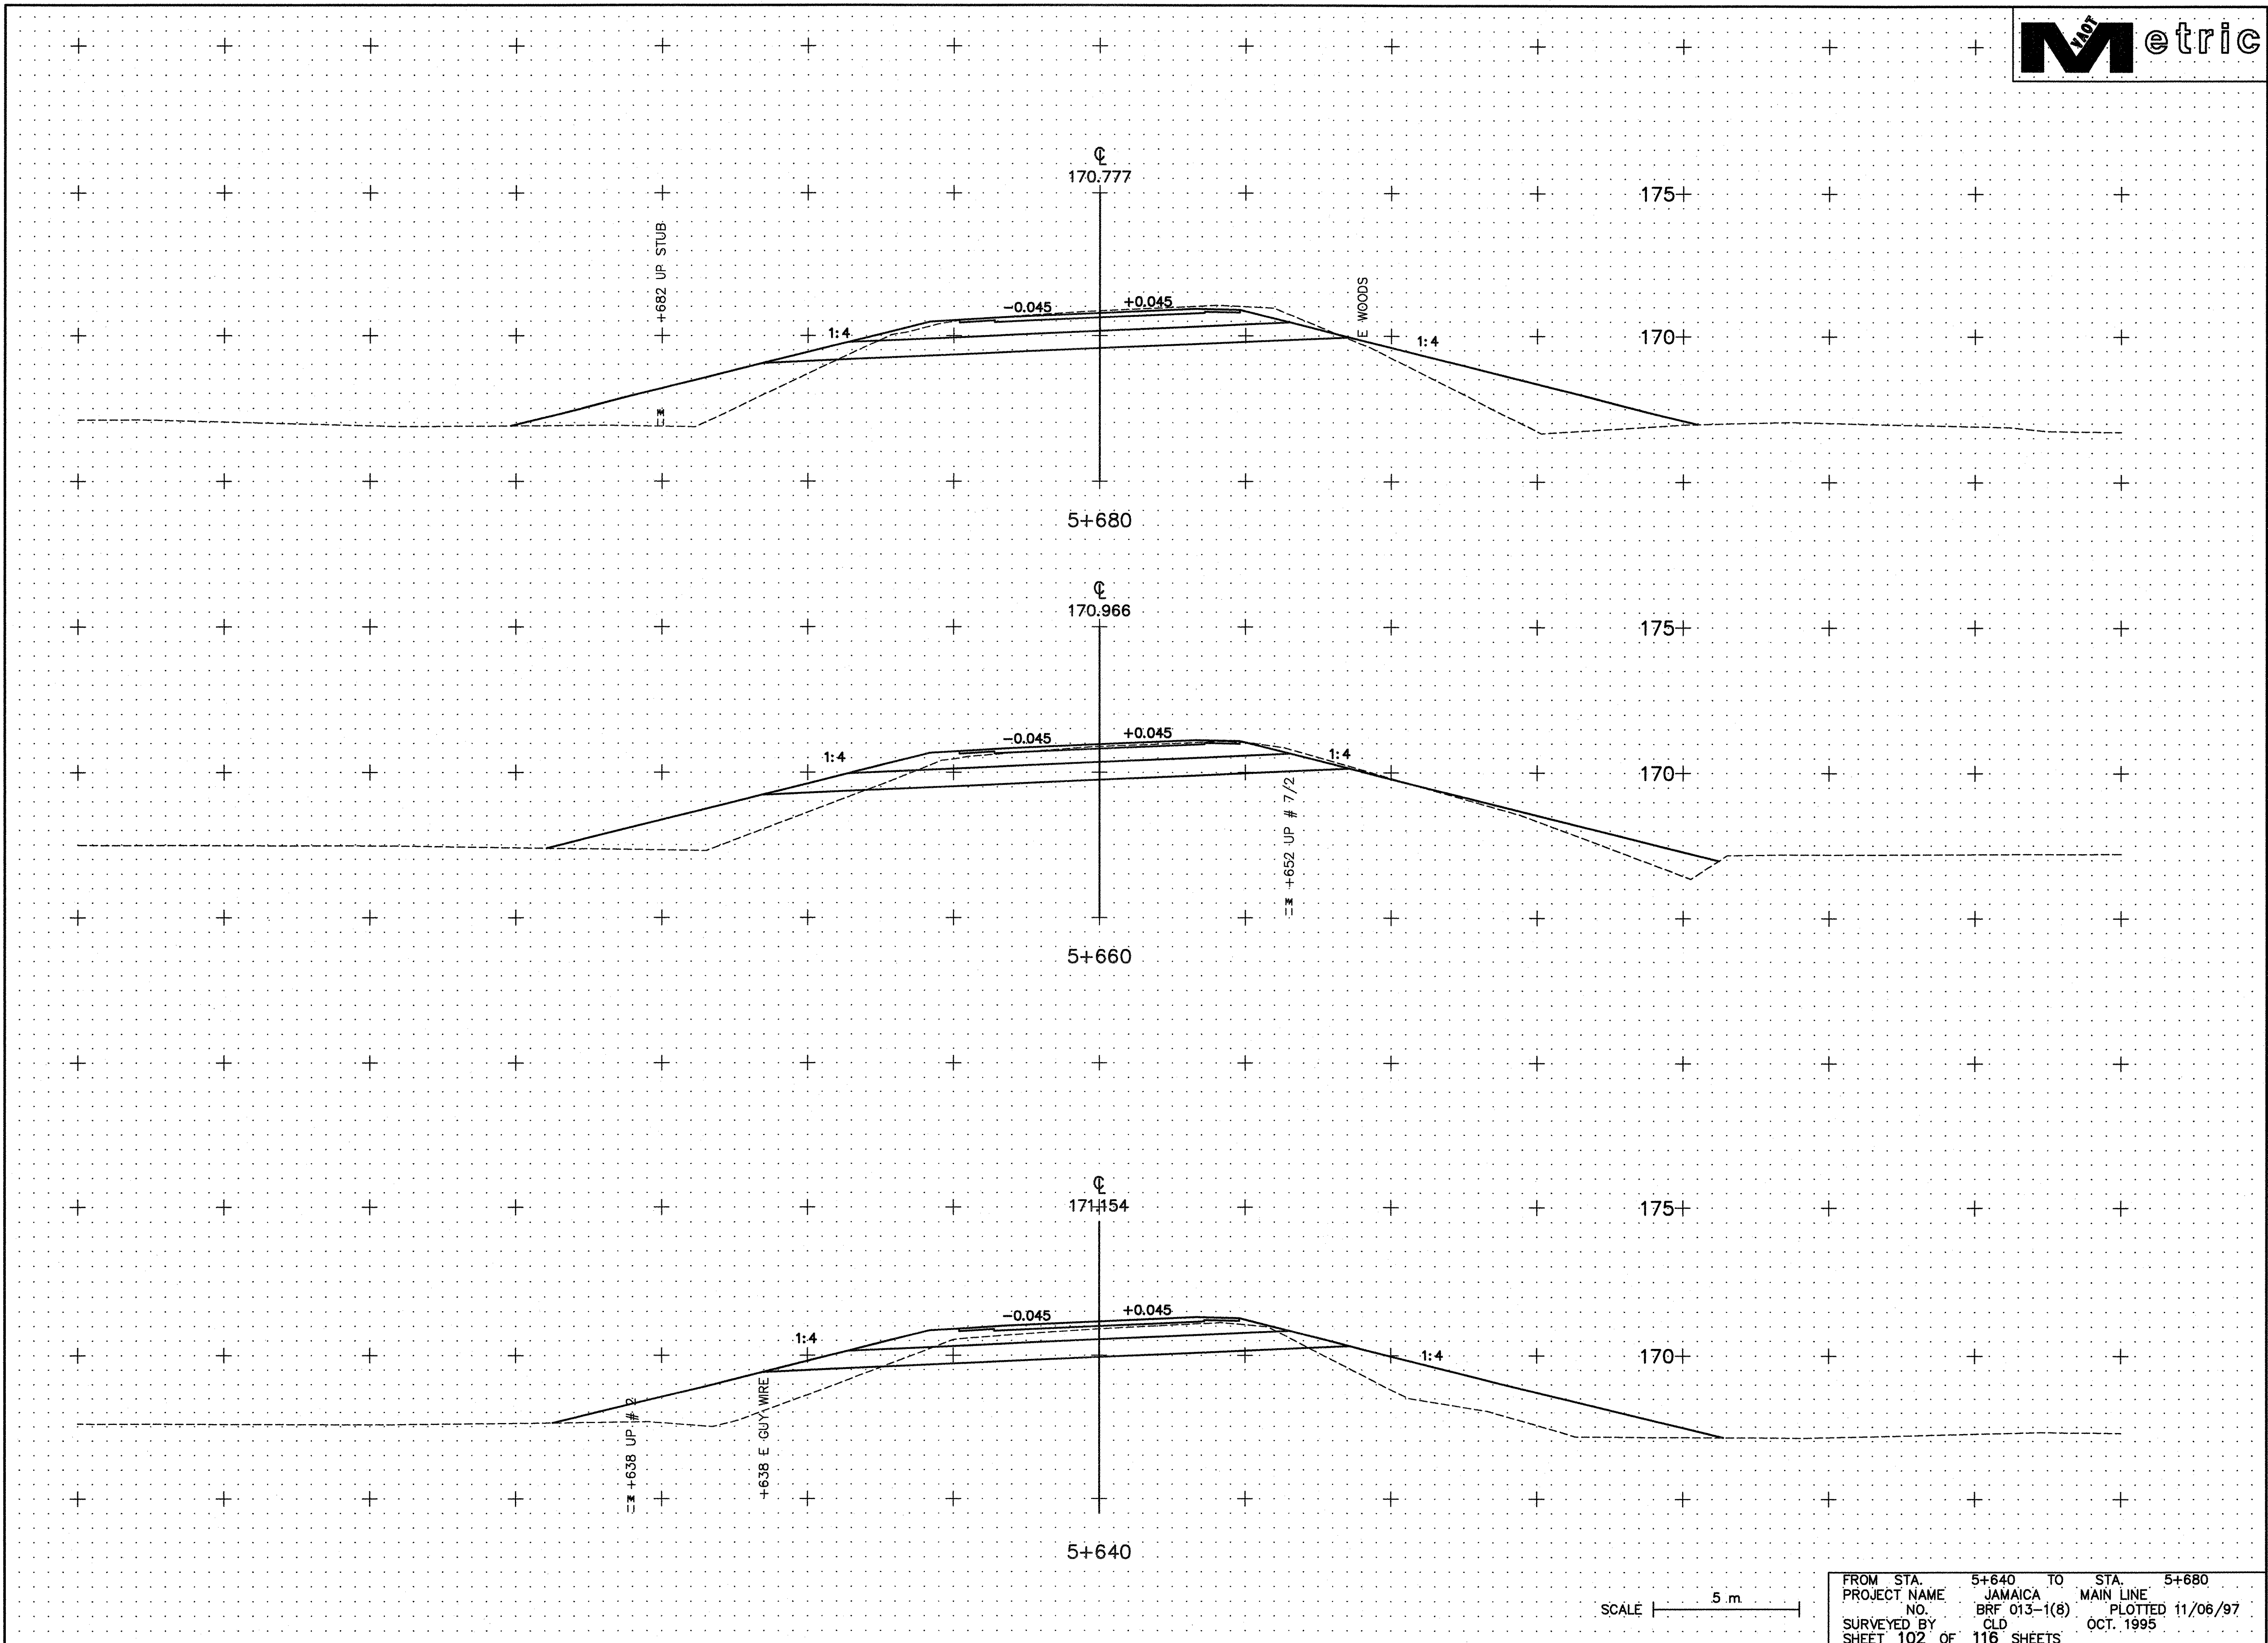

SCALE 5 m

FROM STA. 5+640 TO STA. 5+680
 PROJECT NAME JAMAICA MAIN LINE
 NO. BR 013-1(8) PLOTTED 11/06/97
 SURVEYED BY CLD OCT. 1995
 SHEET 102 OF 116 SHEETS