


FINAL SURVEY NO.	DATE
PROPOSED DATE	
NOTED DATE	
AREAS CHECKED	

ORIGINAL SURVEY NO.	DATE
PROPOSED DATE	
NOTED DATE	
AREAS CHECKED	

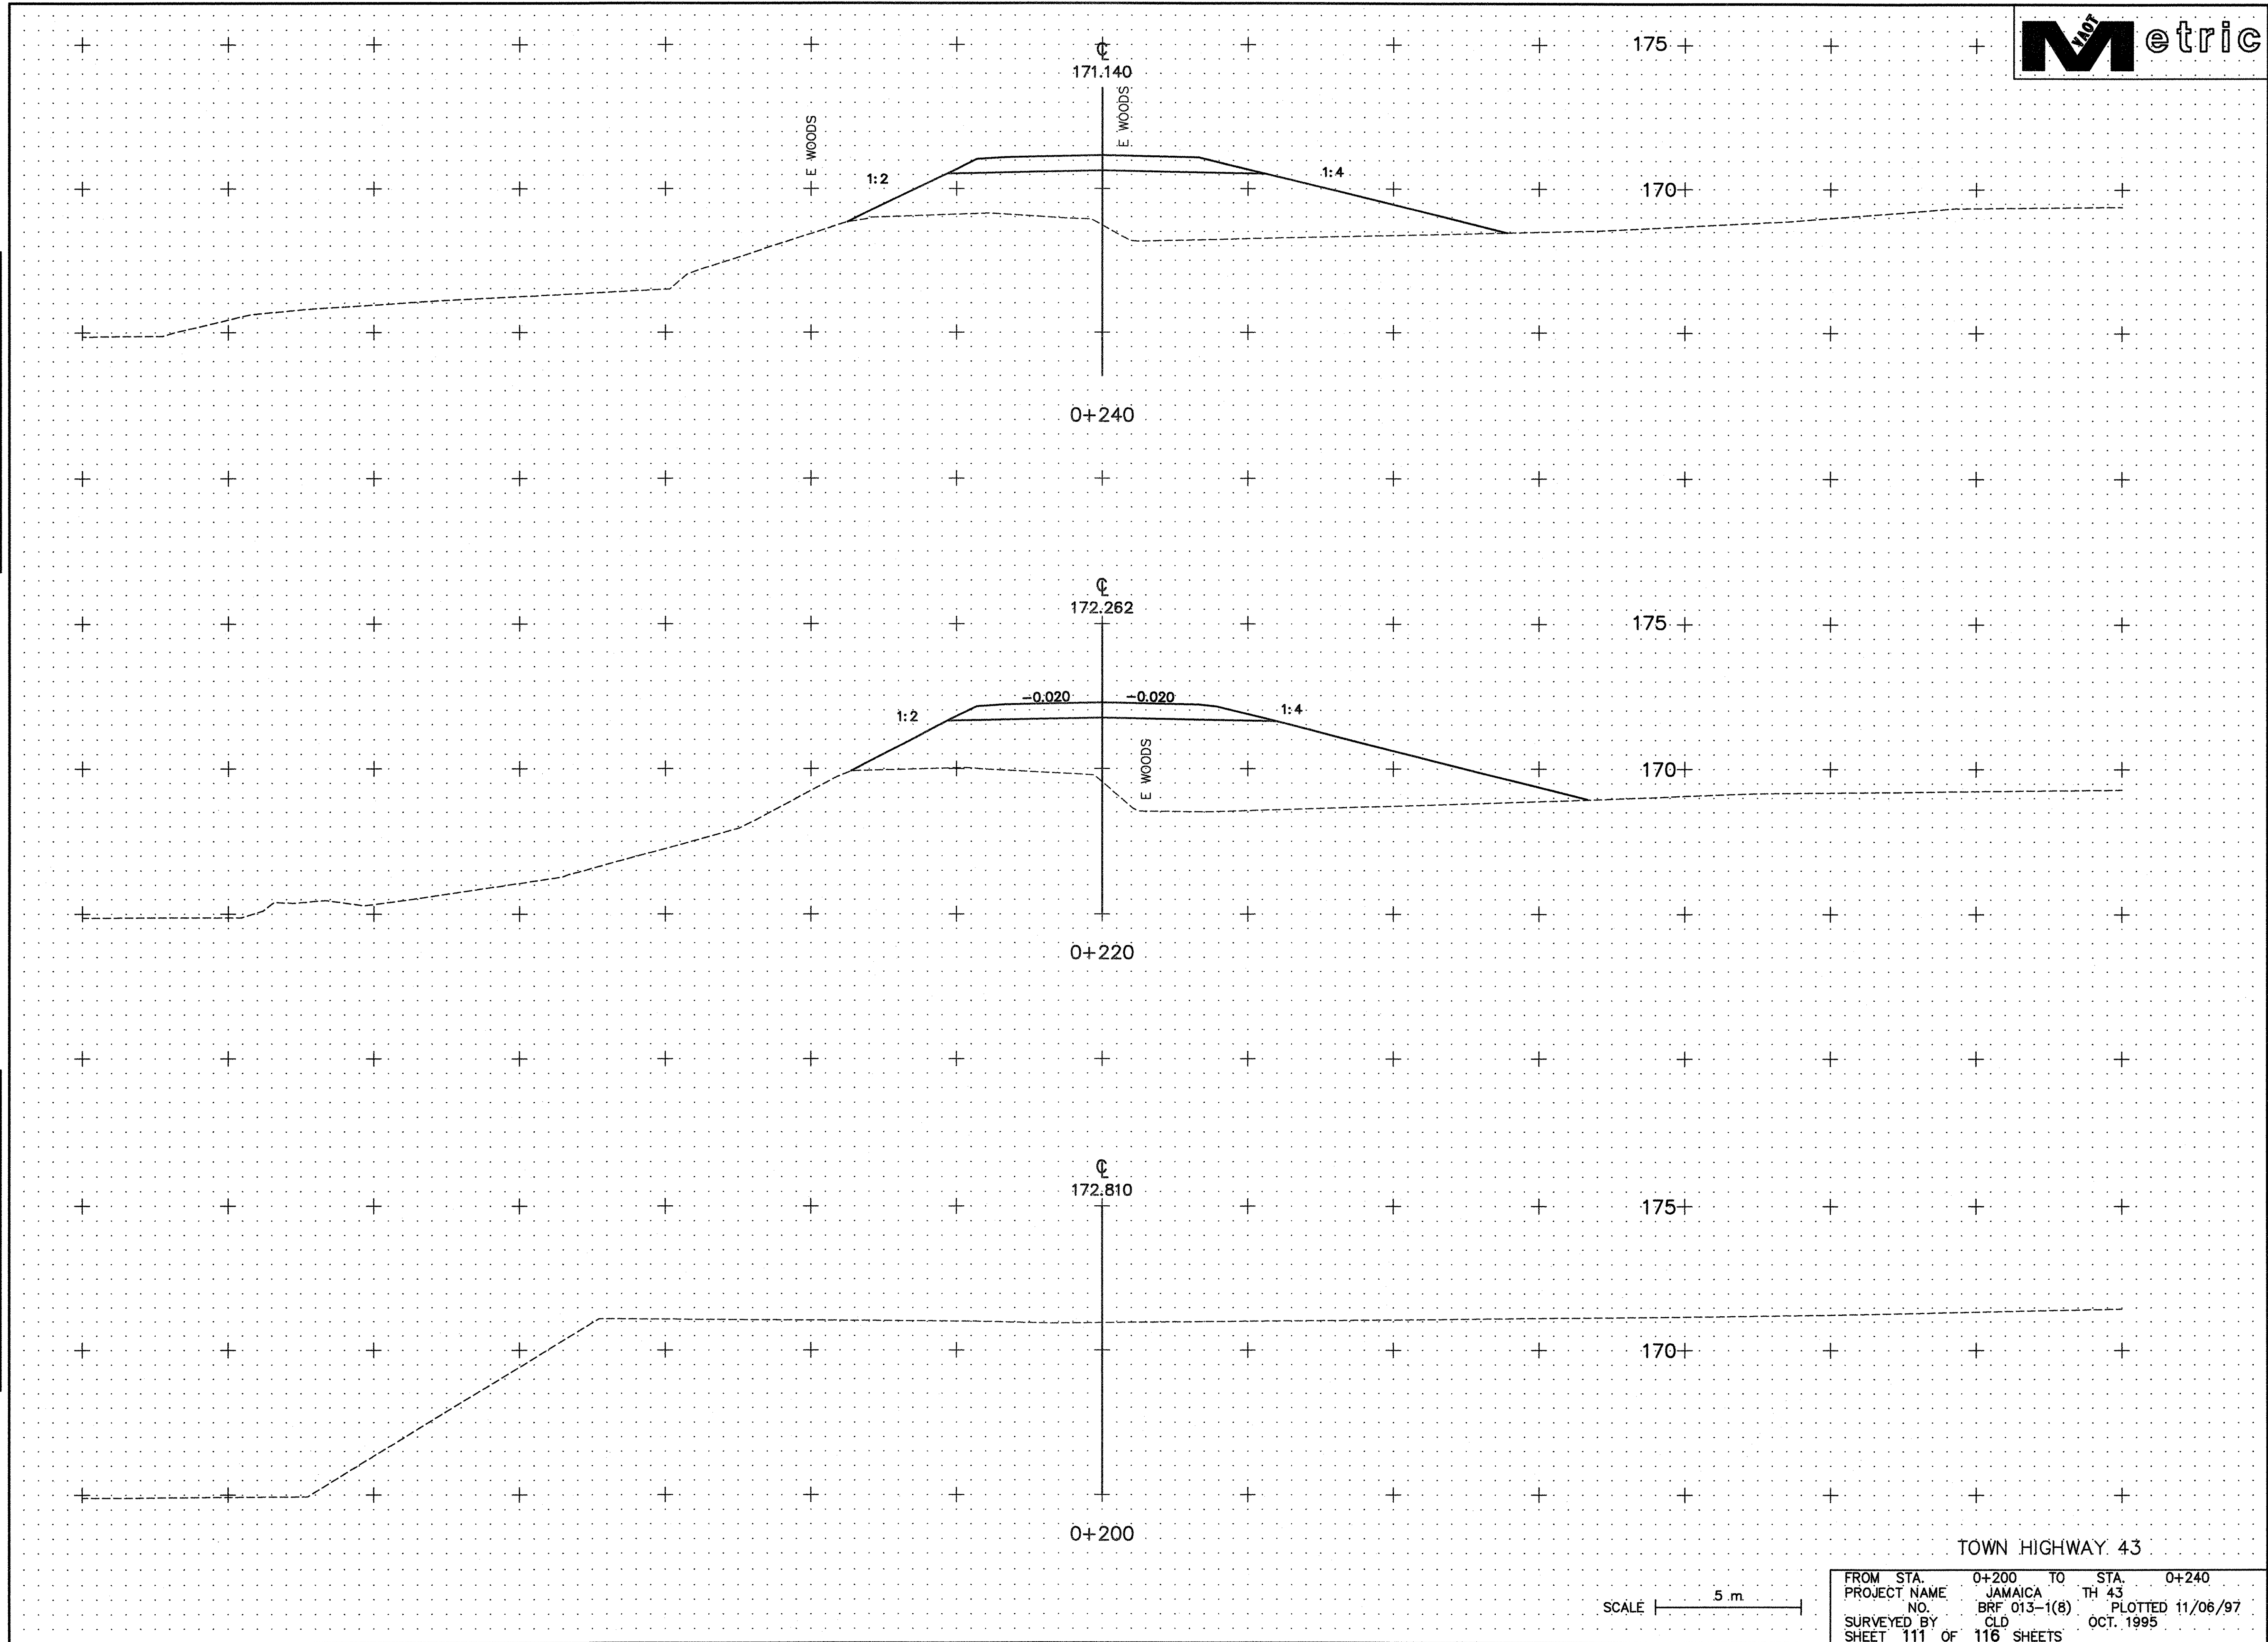

TOWN HIGHWAY 43

FROM STA.	0+200	TO STA.	0+240
PROJECT NAME	JAMAICA	TH 43	
NO.	BRF 013-1(8)	PLOTTED	11/06/97
SURVEYED BY	CLD	OCT. 1995	
SHEET	111	OF	116 SHEETS