


DATE	
BY	
REVIEWED	
PROBLEM	
AREAS	
NO.	
AREAS CHECKED	
FINAL SURVEY	
NOTEBOOK	
NO.	
AREAS CHECKED	

DATE	
BY	
REVIEWED	
PROBLEM	
AREAS	
NO.	
AREAS CHECKED	
ORIGINAL SURVEY	
NOTEBOOK	
NO.	
AREAS CHECKED	

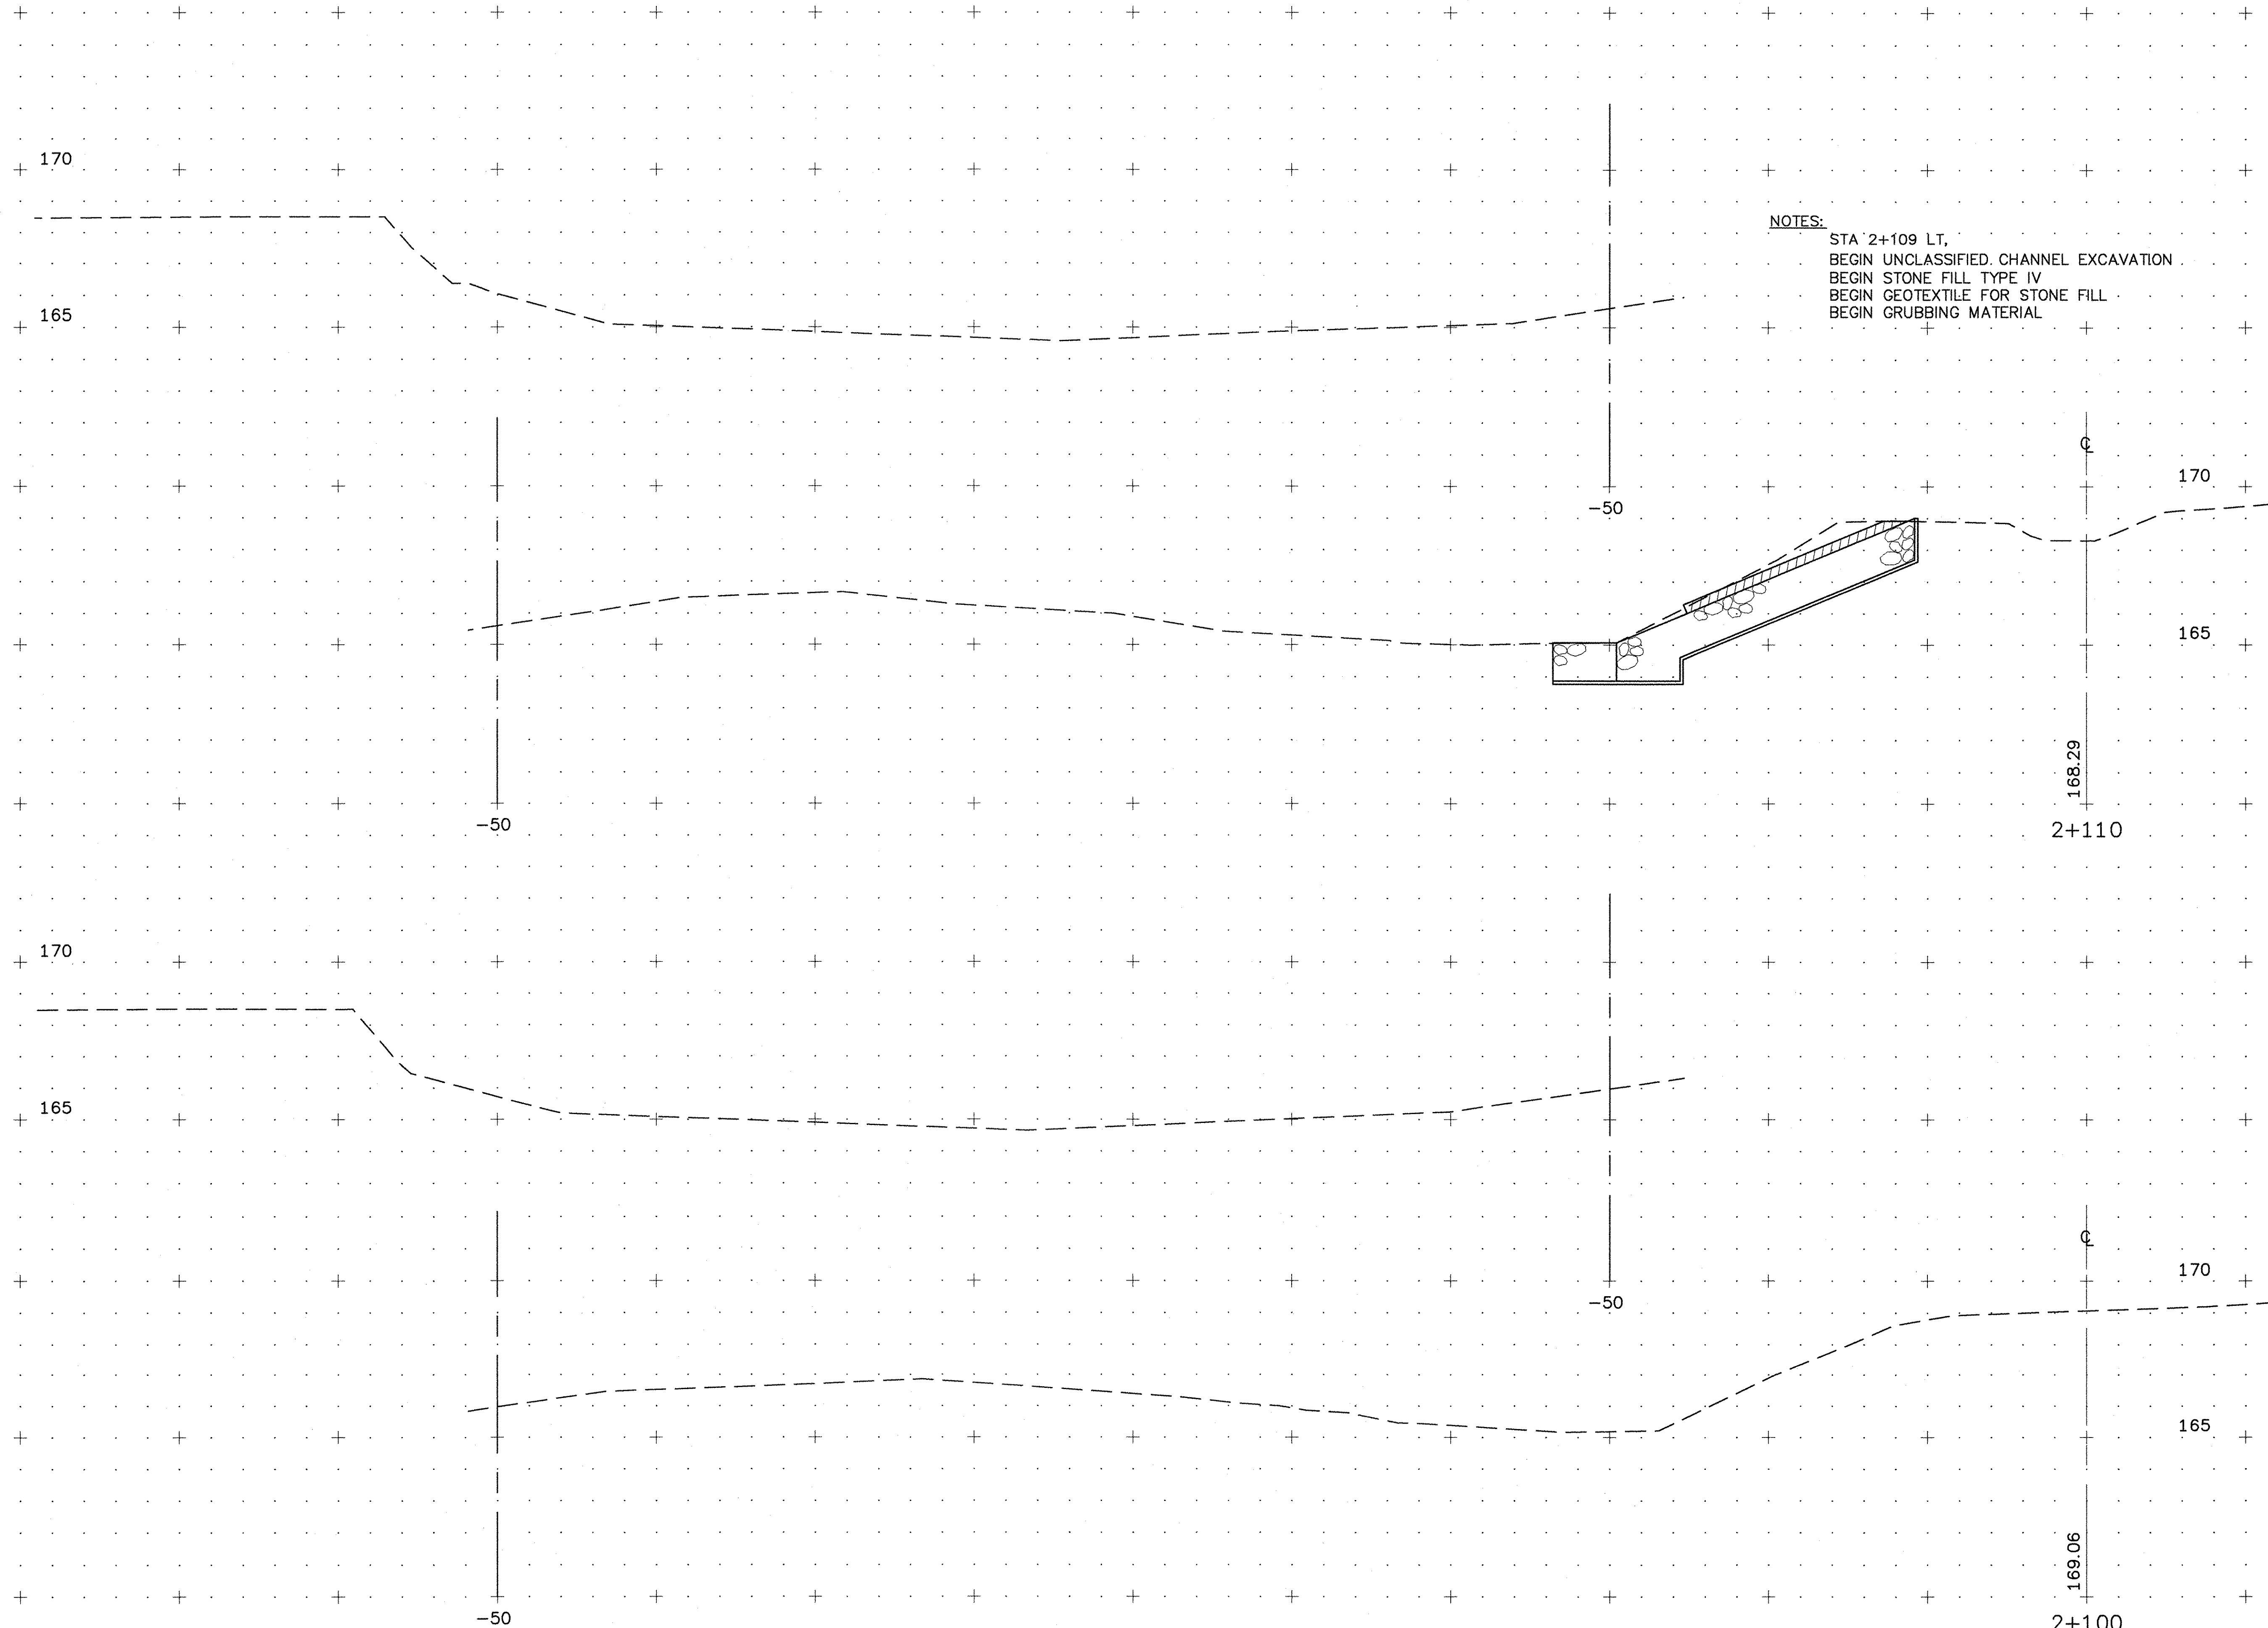

NOTES:
 STA 2+109 LT.
 BEGIN UNCLASSIFIED CHANNEL EXCAVATION
 BEGIN STONE FILL TYPE IV
 BEGIN GEOTEXTILE FOR STONE FILL
 BEGIN GRUBBING MATERIAL

SCALE |----- 5 m -----|

FROM STA. 2+100 TO STA. 2+110
 PROJECT NAME JAMAICA CHANNEL LINE
 NO. BRF 013-1(8) PLOTTED 11/06/97
 SURVEYED BY CLD OCT. 1995
 SHEET 114 OF 116 SHEETS