


DATE	
BY	
SURVEYED	
PLOTTED	
AREAS CHECKED	
FINAL SURVEY	
NOTEBOOK NO.	

DATE	
BY	
SURVEYED	
PLOTTED	
AREAS CHECKED	
ORIGINAL SURVEY	
NOTEBOOK NO.	

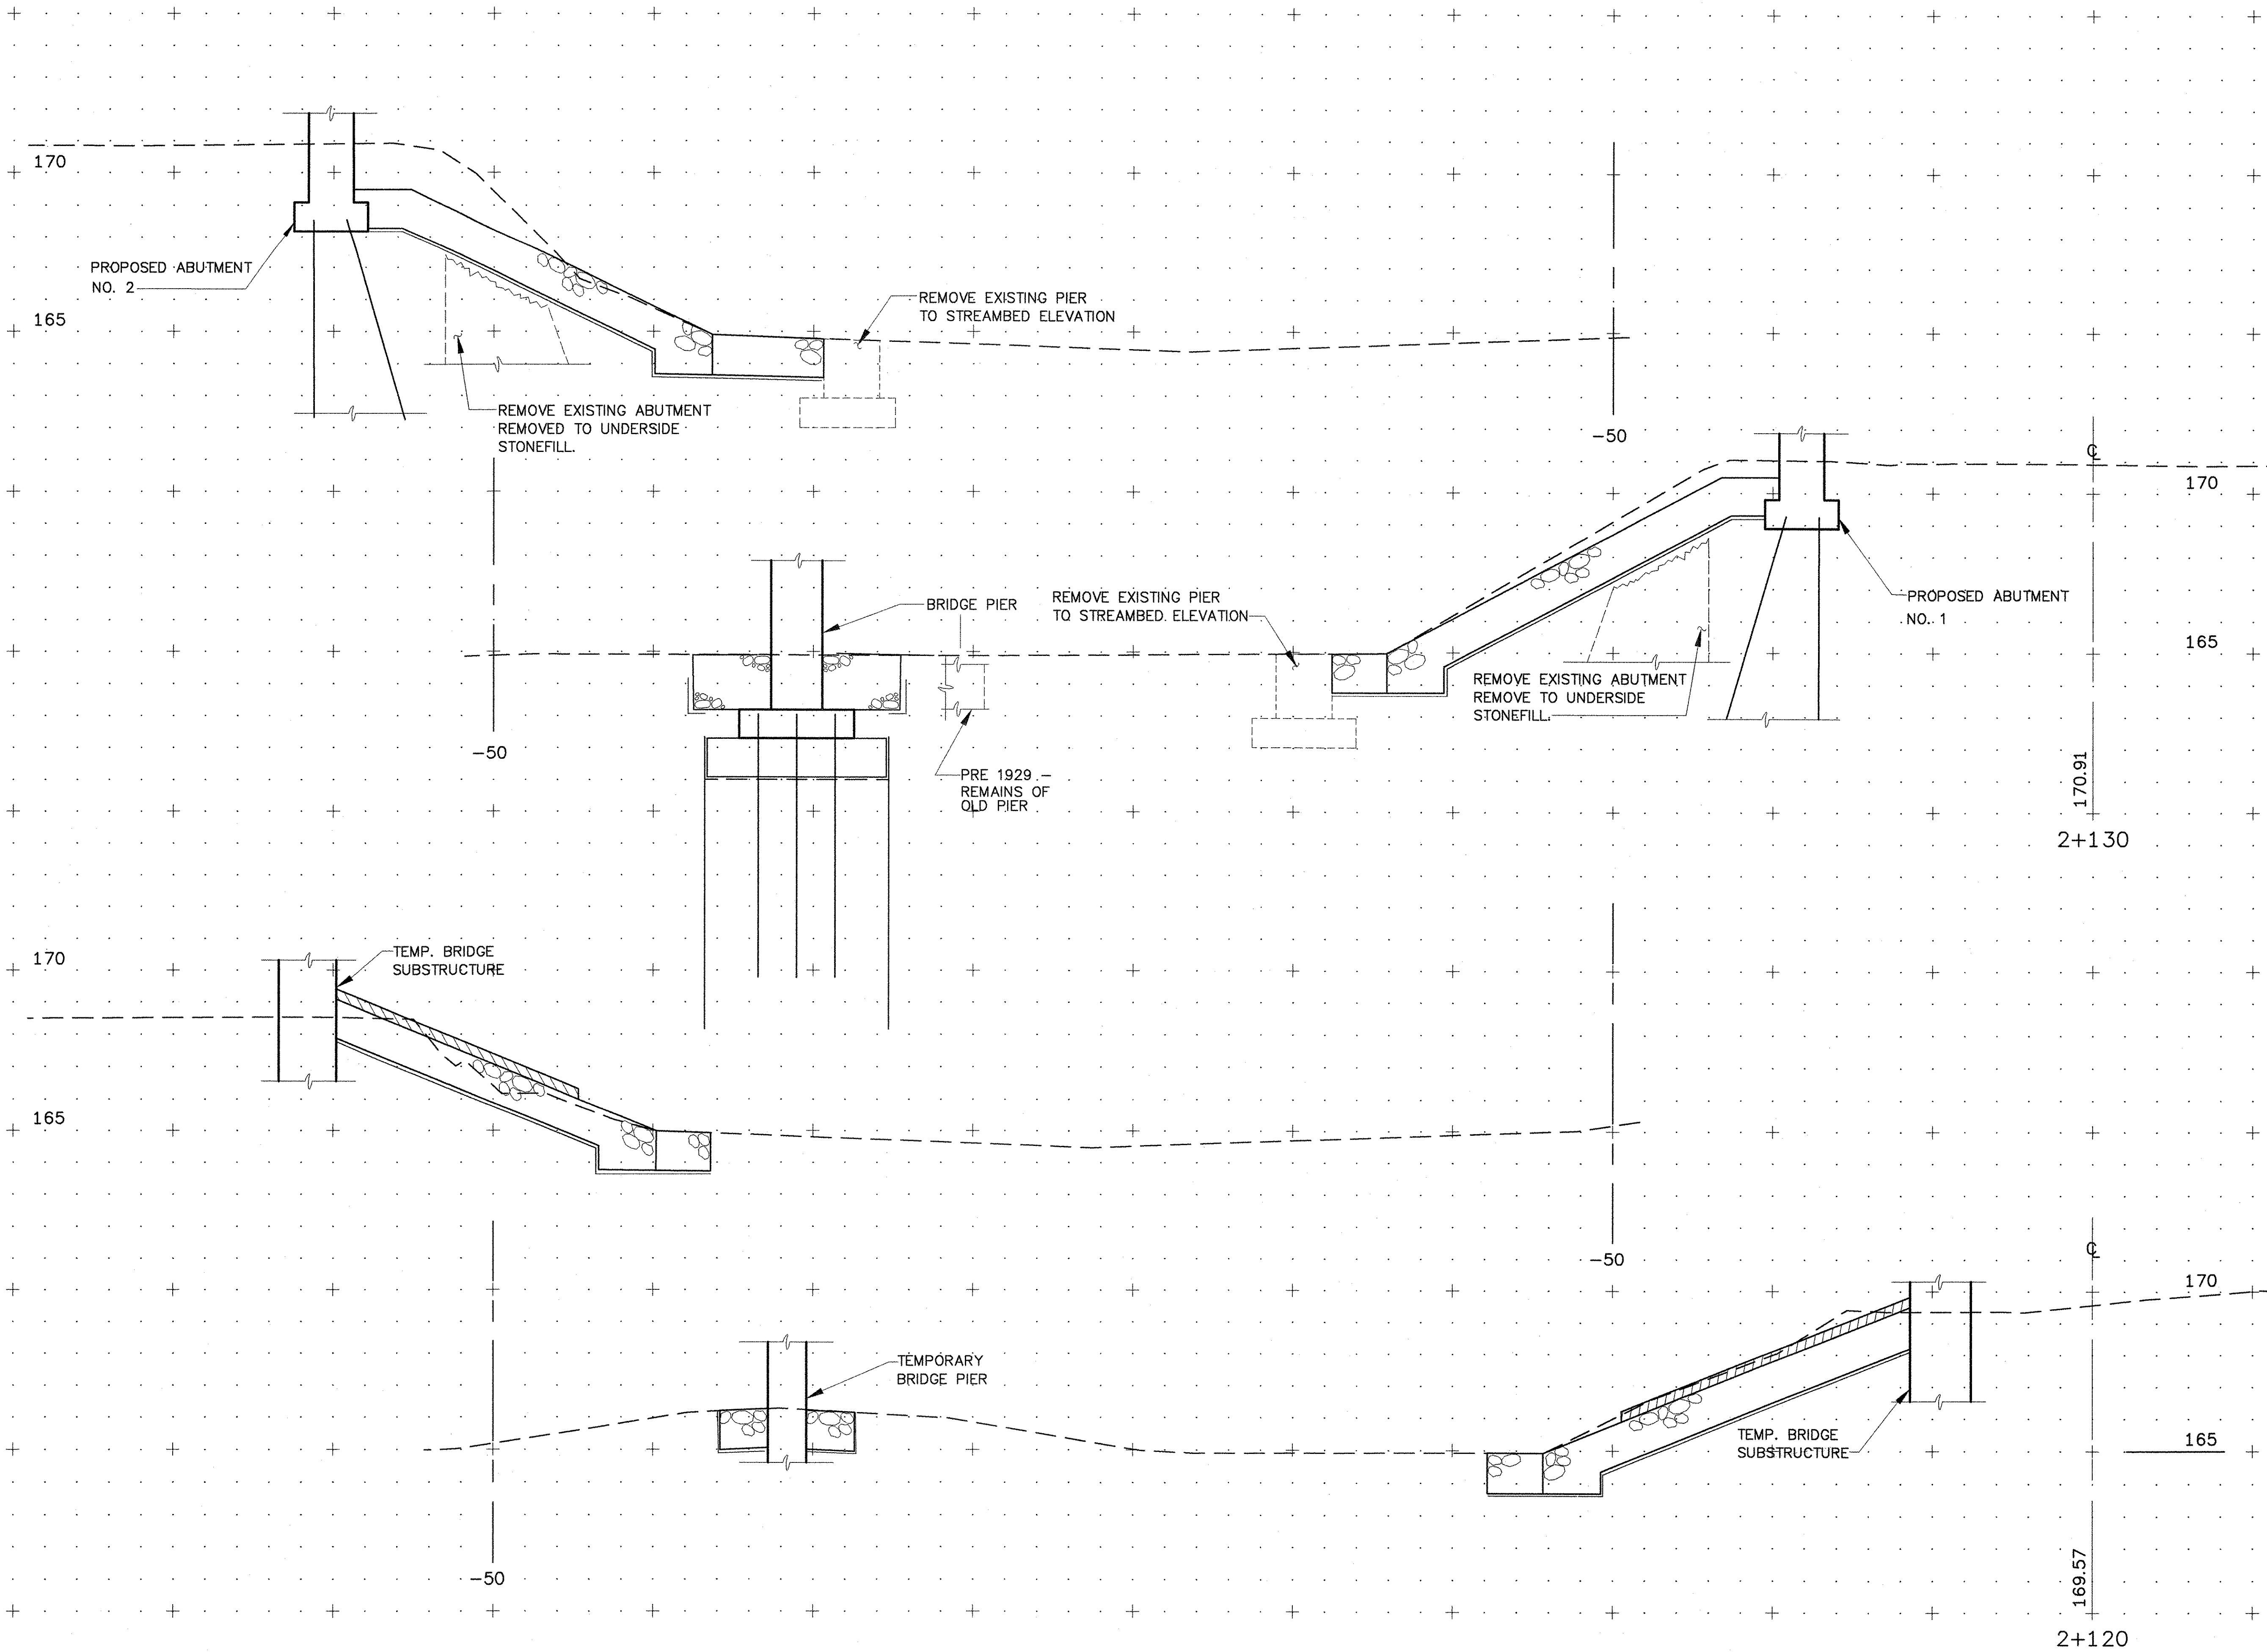

SCALE 5 m

FROM STA. 2+120 TO STA. 2+130
 PROJECT NAME JAMAICA CHANNEL LINE
 NO. BRF 013-1(B) PLOTTED 11/06/97
 SURVEYED BY CLD OCT. 1995
 SHEET 115 OF 116 SHEETS