
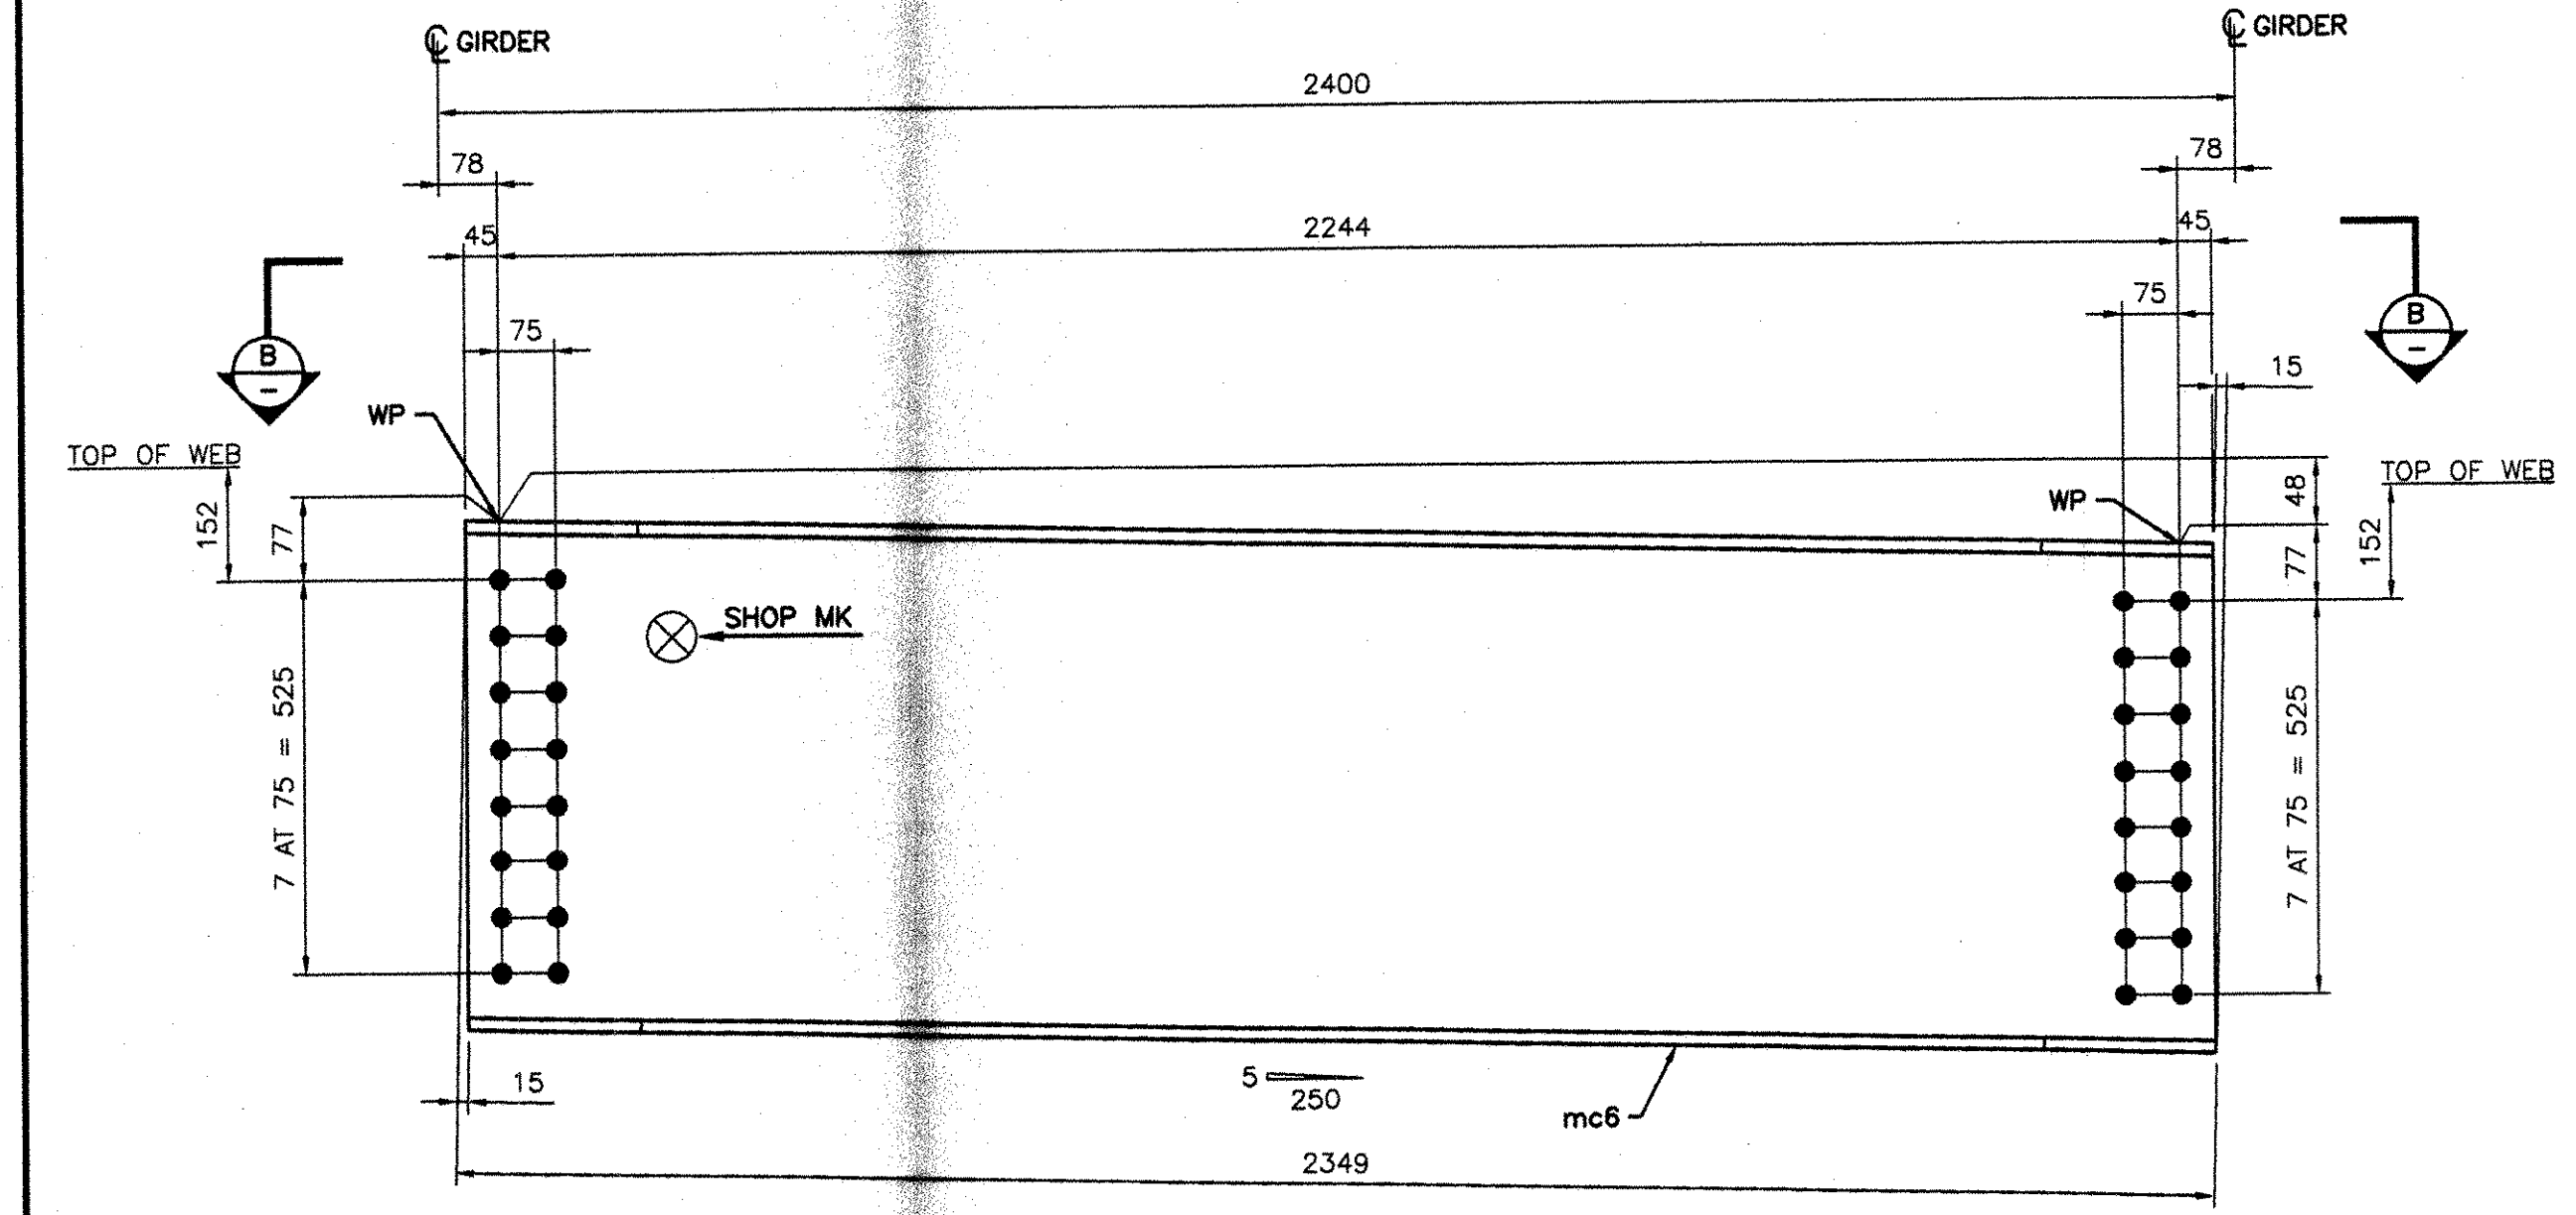
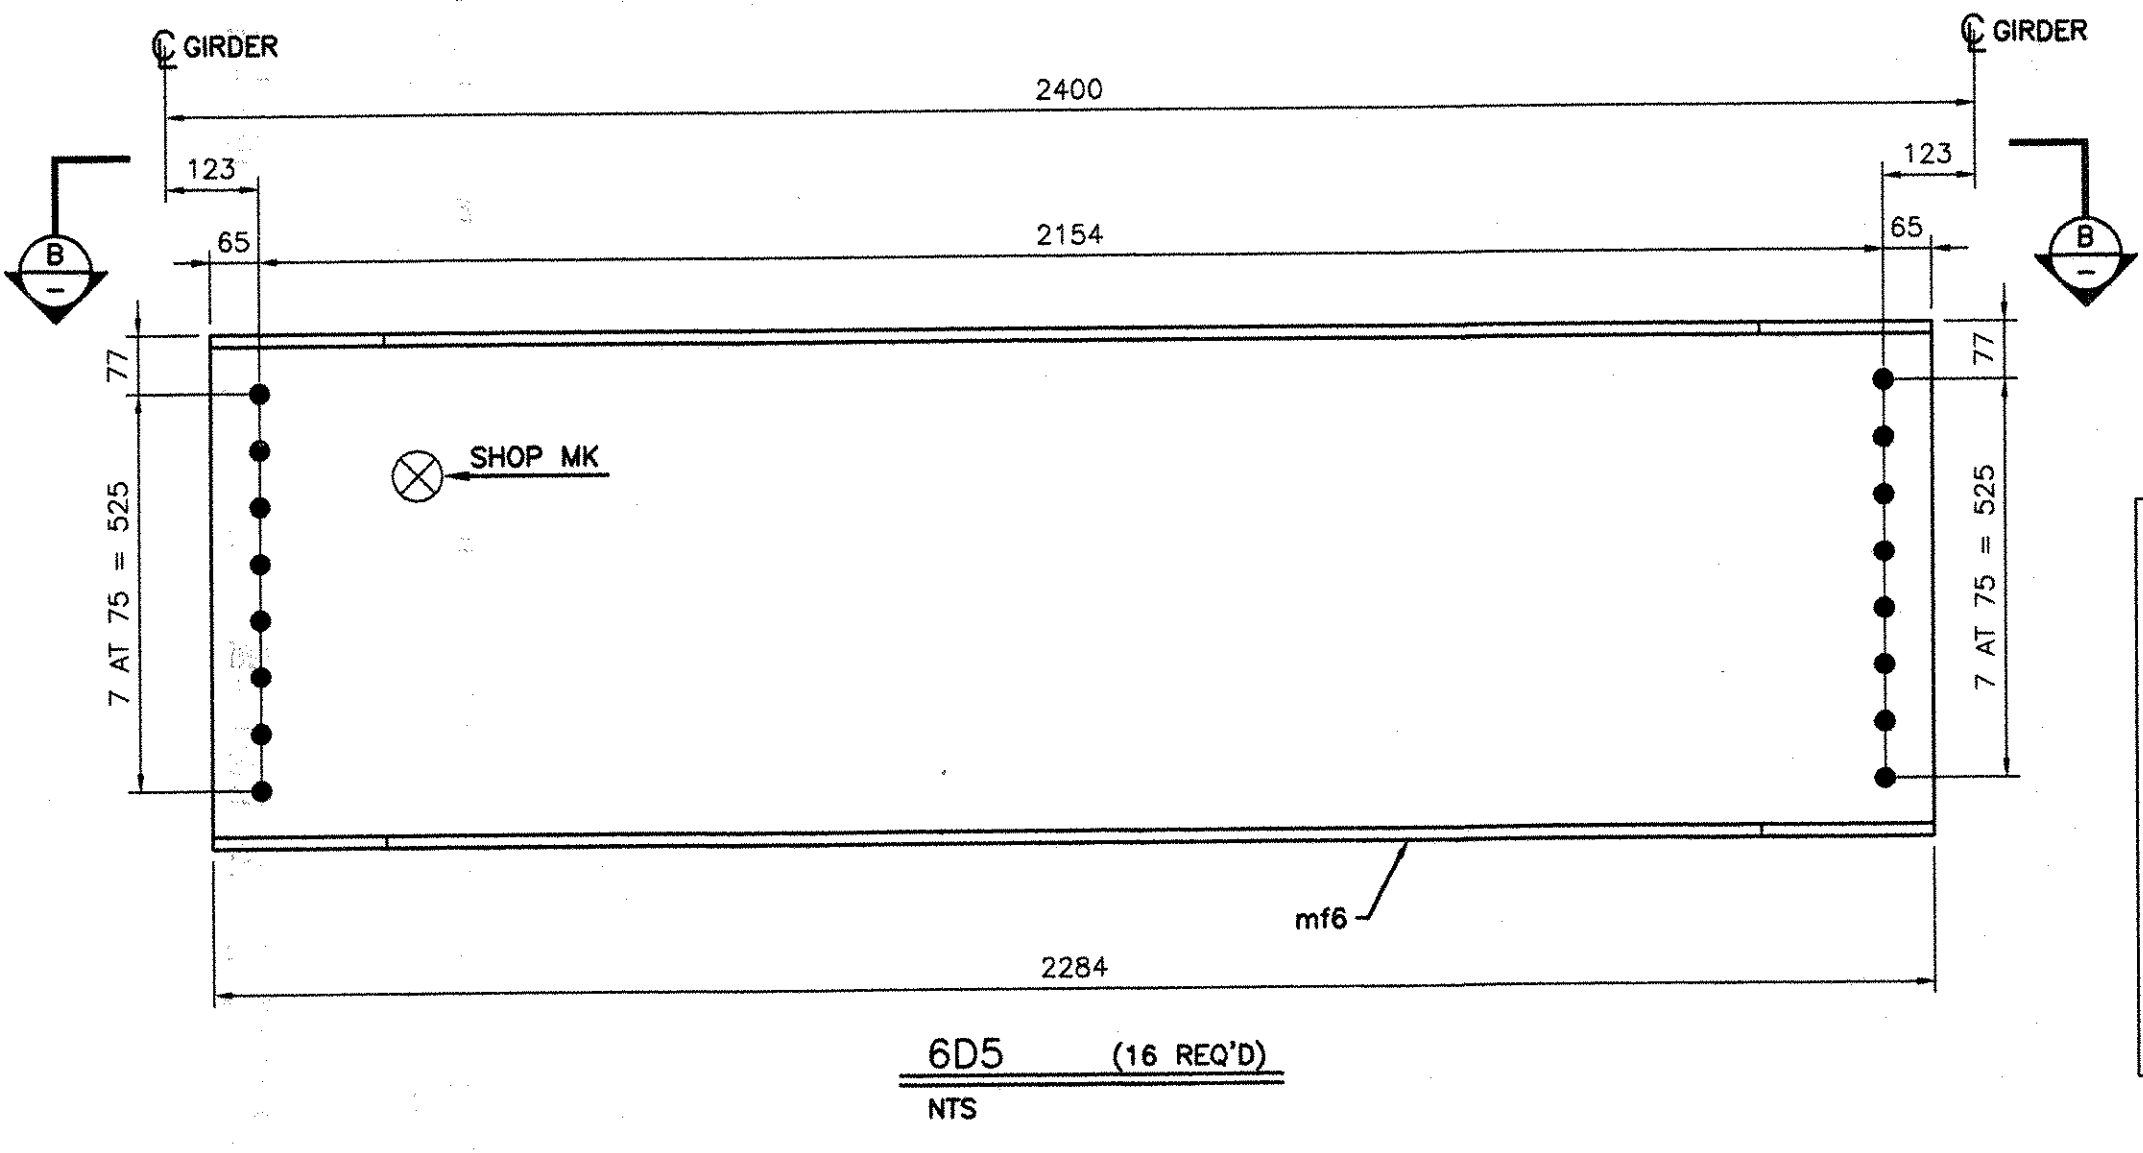
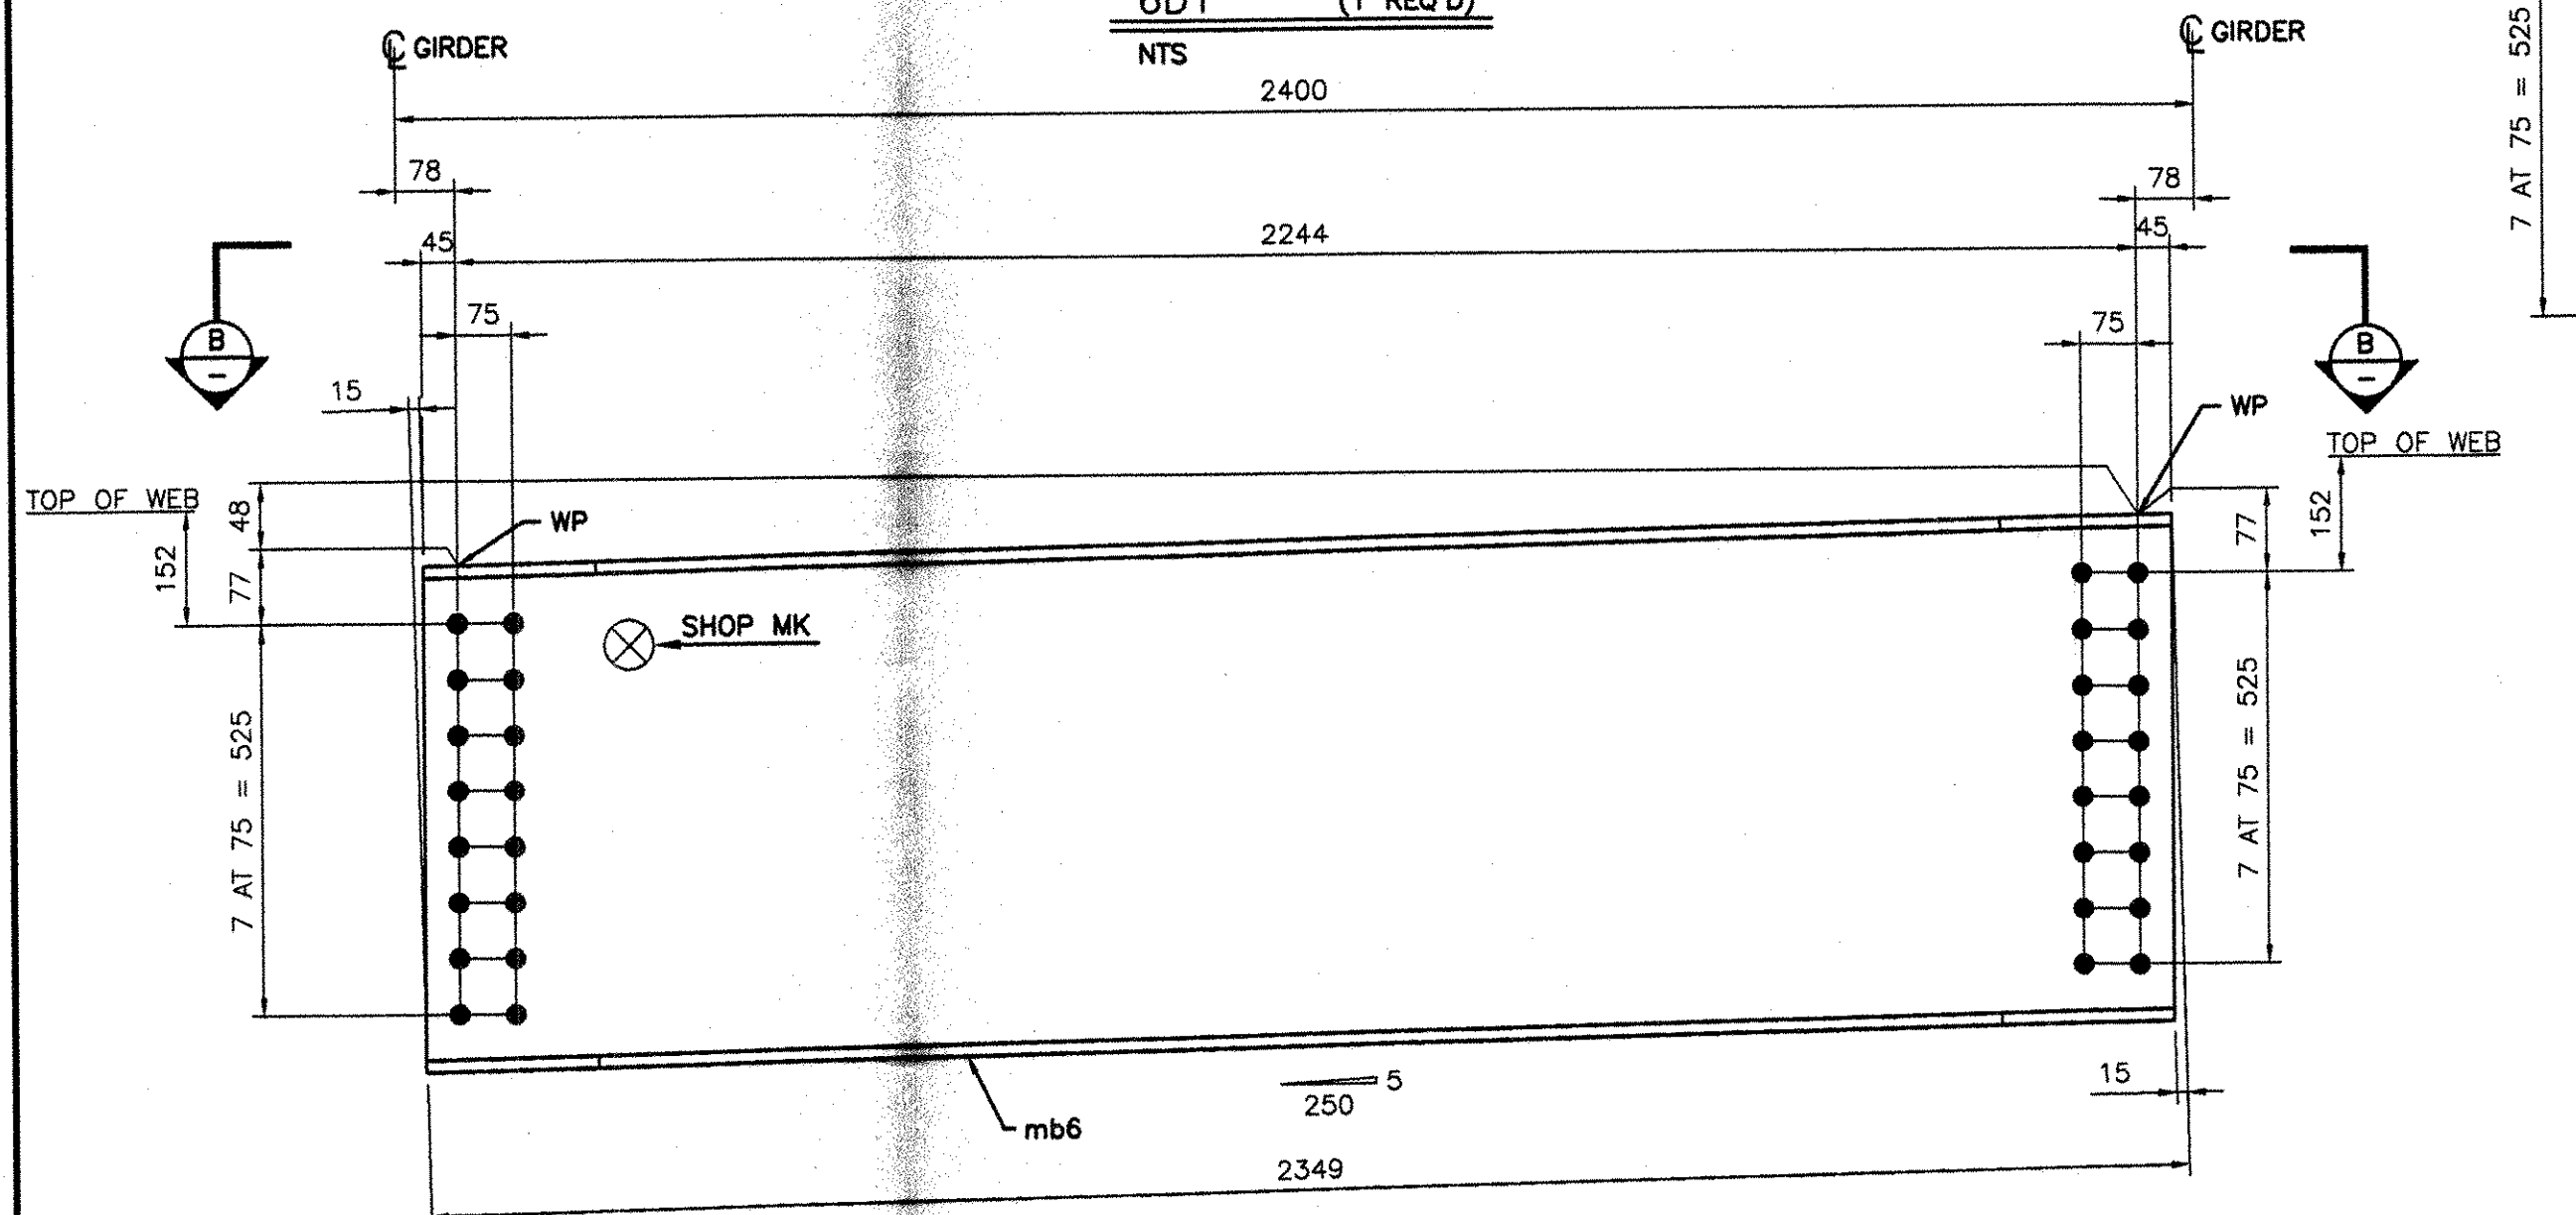
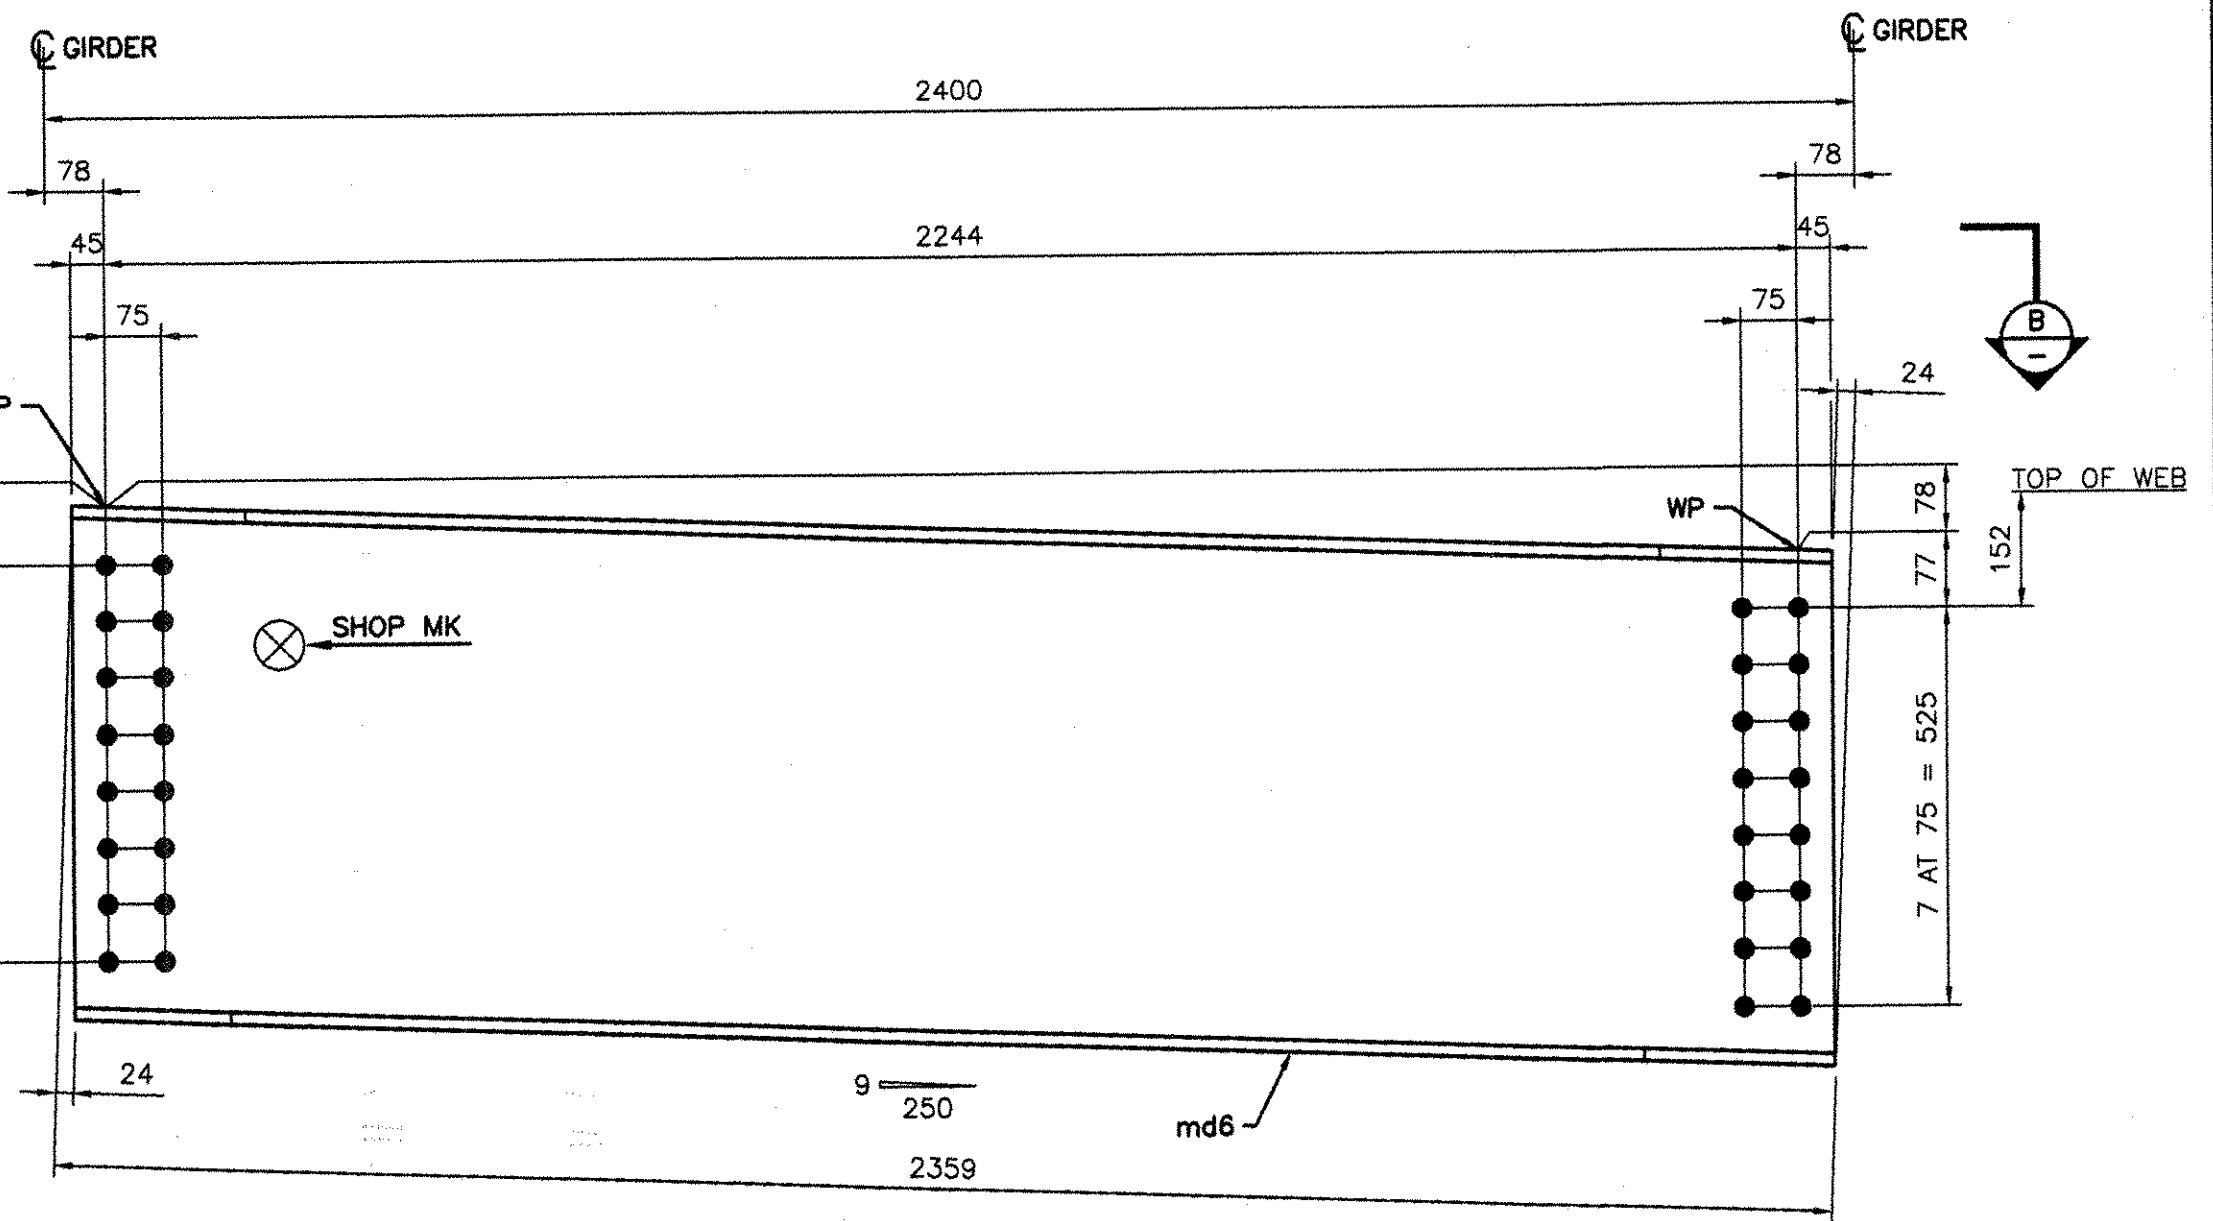
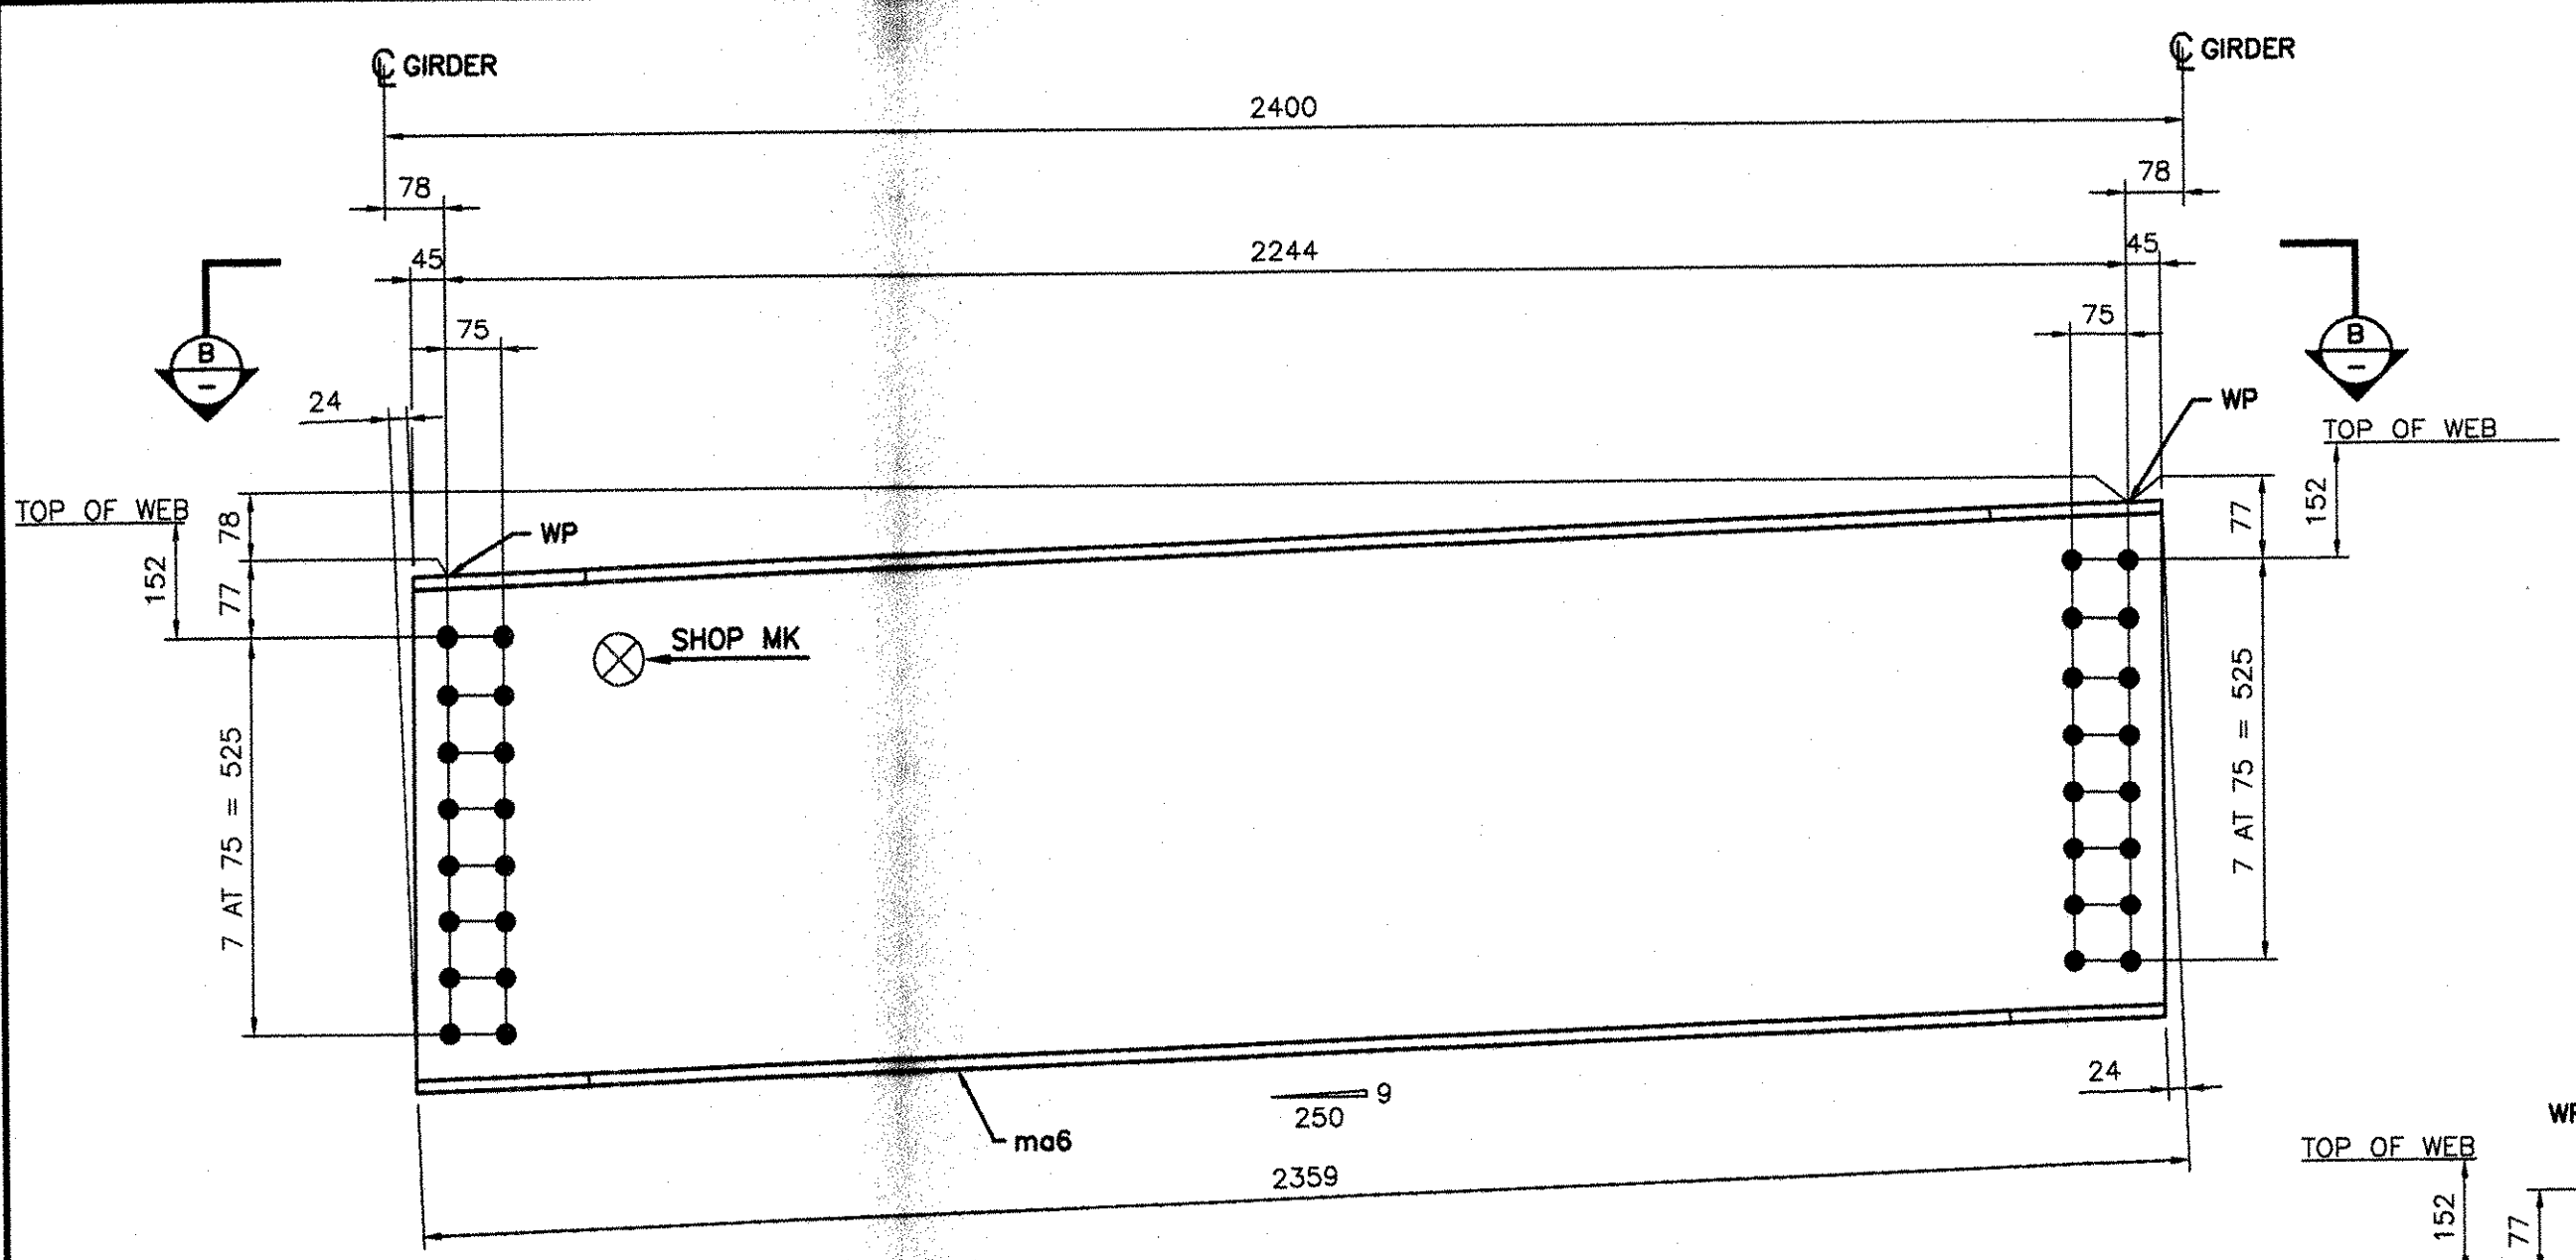


BILL OF MATERIAL

Drawing Number	Revision Number	Ship Mark	Piece Mark	Qty	Type of Material	Size of Material	Grade	Length	Finish	Notes
6		6D1	mc6		1 W Wide Flng	690x125	A709M-GR345W	2359		weight: 295 kg
6		6D2	mb6		1 W Wide Flng	690x125	A709M-GR345W	2349		weight: 294 kg
6		6D3	mc6		1 W Wide Flng	690x125	A709M-GR345W	2349		weight: 294 kg
6		6D4	md6		1 W Wide Flng	690x125	A709M-GR345W	2359		weight: 295 kg
6		6D5	mf6	16	W Wide Flng	690x125	A709M-GR345W	2284		weight: 4568 kg
6		6D6	mc6		1 W Wide Flng	690x125	A709M-GR345W	2359		weight: 295 kg
6		6D7	mb6		1 W Wide Flng	690x125	A709M-GR345W	2349		weight: 294 kg
6		6D8	mc6		1 W Wide Flng	690x125	A709M-GR345W	2349		weight: 294 kg
6		6D9	md6		1 W Wide Flng	690x125	A709M-GR345W	2359		weight: 295 kg

TOTAL WEIGHT	6924 kg
-CUTS	336 kg
+FIELD BOLTS	REFER TO 'E' DWG
+WELD	0
NET TOTAL	6588 kg

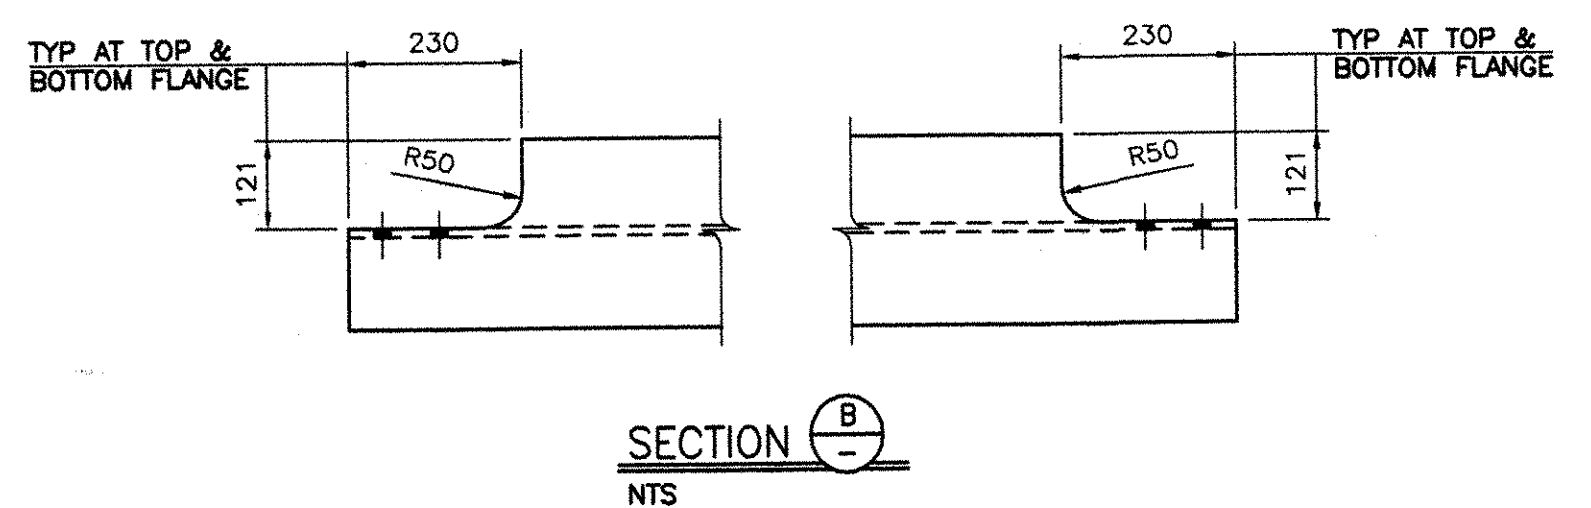


- NOTES:
- 1- GENERAL NOTES: SEE GN1
 - 2- PAINT: SEE GN1
 - 2- HOLES: 15/16" (24#) (U.N.O.)
 - 3- REF. SHOP DWG'S:

RESERVED FOR STAMPS

REV	DATE	DESCRIPTION	QTY	DATE	ISSUED TO	FOR

NOTICE
This drawing shall not be used or reproduced in any manner, nor shall any similar drawings or structures be made therefrom, nor shall the information thereon be used for any purpose other than that for which it is released without the written consent of an officer of EASTERN BRIDGE LLC.

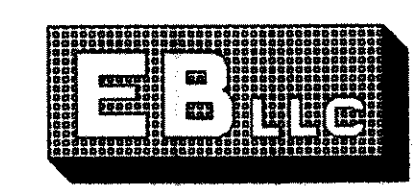

EASTERN BRIDGE LLC
RURAL RTE 2, BOX 302
CLAREMONT, NH 03743
603-542-5202

PROJECT: ROUTE 100 OVER THE WEST RIVER
LOCATION: TOWN OF JAMAICA
ENGINEER: CLD CONSULTING ENGINEERS
CUSTOMER: VERMONT A. O. T.
DRAWING TITLE: DIAPHRAGMS
DRAWN BY: BR 11/26/04 JOB
CHECKED BY: GG 11/30/04 NUMBER: 5075 SHEET NUMBER: 6