


BILL OF MATERIAL

Drawing Number	Revision Number	Ship Mark	Piece Mark	Qty	Type of Material	Size of Material	Grade	Length	Finish	Notes
103		103BC		2	C Channel	380x74	M270M-GR345	6991	CVN	13
103		103BC	ma103	2	C Channel	380x74	M270M-GR345	6991	CVN	13
103		103BC	mb103	2	C Channel	380x74	M270M-GR345	6991	CVN	13
103		103BC	x157pb	4	PL Plate	10x434	M270M-GR345	480		53
103		103BC	x157pc	16	PL Plate	10x280	M270M-GR345	434		54
103		103BC	x160pc	4	PL Plate	18x923	M270M-GR345	1193	CVN	67
103		103BC	x160pd	4	PL Plate	18x323	M270M-GR345	412	CVN	58
103		103BC	x160ph	2	PL Plate	10x84	M270M-GR345	1236	CVN	59
103		103BC	x161pb	2	PL Plate	12x434	M270M-GR345	6916	CVN	14

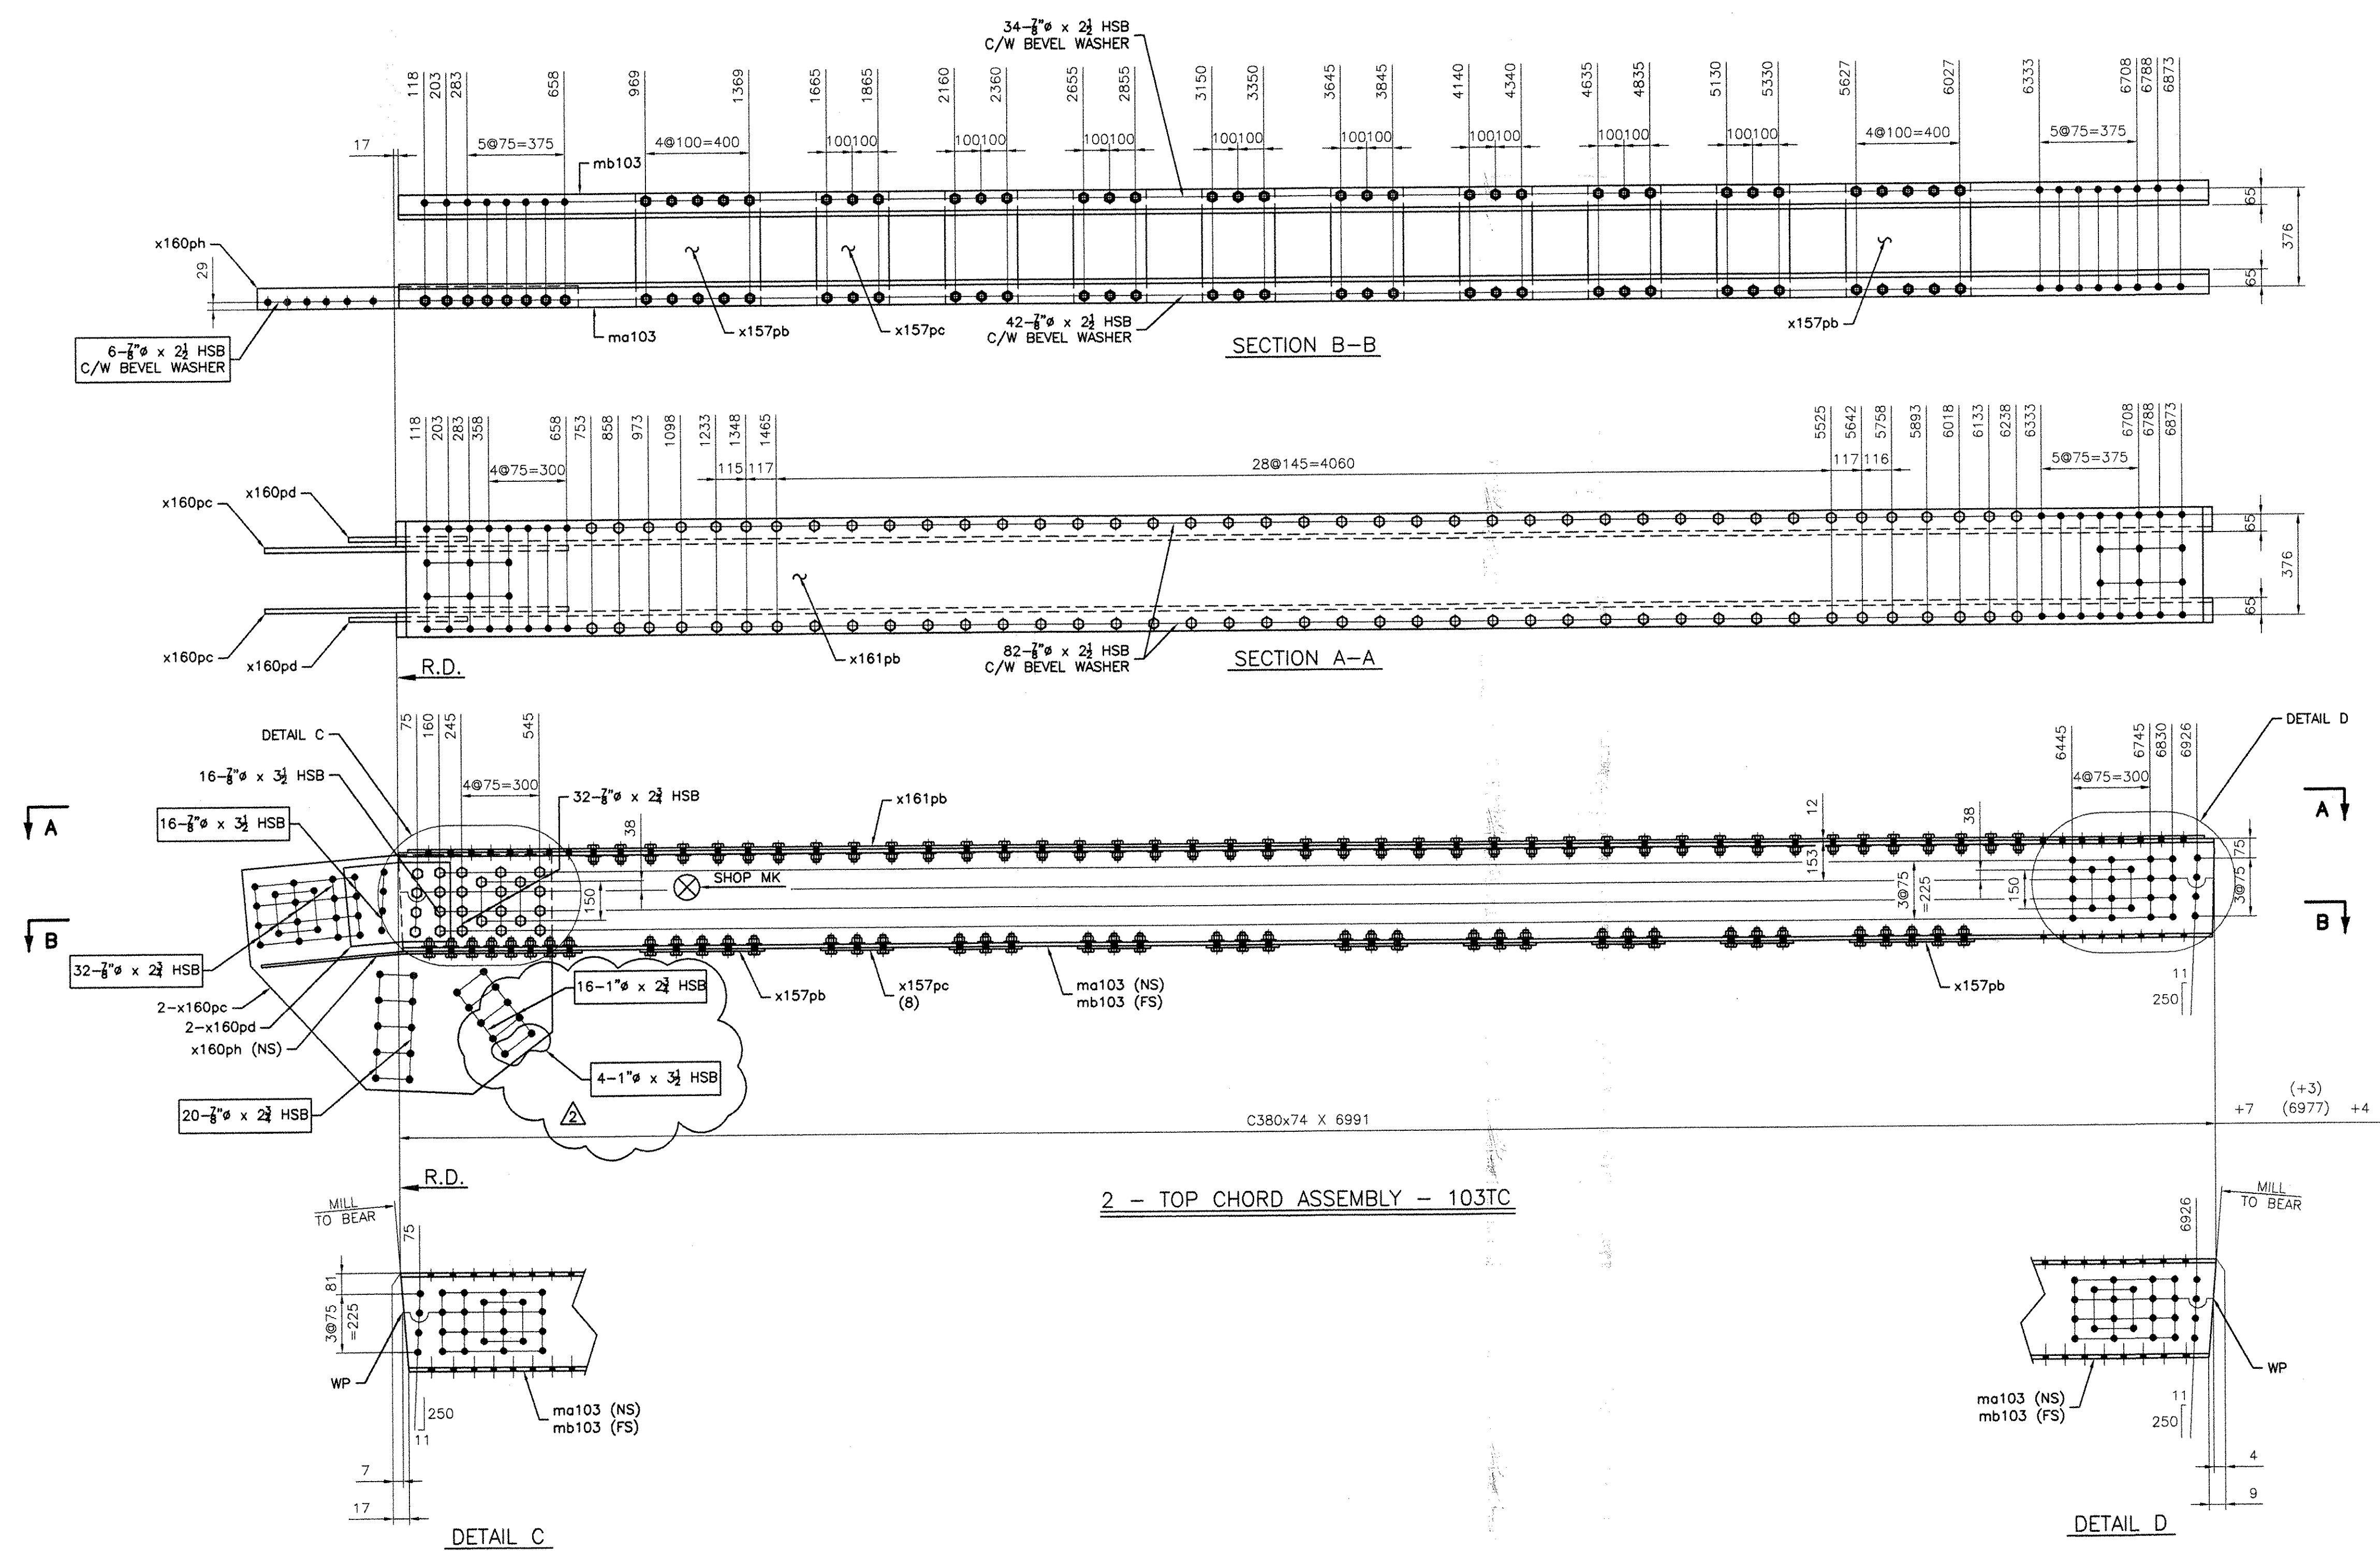

BOLTS LIST		
QTY	DESCRIPTION	LENGTH
SHOP BOLTS LIST		
316	7/8" HSB	2 1/2
64	7/8" HSB	2 3/4
32	7/8" HSB	3 1/2
316	BEVEL WASHER 7/8"	
FIELD BOLTS LIST		
12	7/8" HSB	2 1/2
104	7/8" HSB	2 3/4
32	7/8" HSB	3 1/2
32	1" HSB	2 3/4
8	1" HSB	3 1/2
12	BEVEL WASHER 7/8"	

- NOTES:
- 1- GENERAL NOTES: SEE GN101
 - 2- HOLES: 15/16" (24#) (UN)
 - 3- ALL HS BOLTS SHALL BE A325 TYPE 1 GALVANIZED C/W 1 NUT & 1 WASHER (UN)
 - 4- ALL STEEL SHALL BE GALVANIZED, SEE GN101
 - 5- ALL SHOP BOLTS SHALL BE HAND TIGHTEN
 - 6- ALL HOLES SHALL BE "CNC" DRILLED (UN)
 - 7- WIRE-BRUSH PREPARATION 3" OF OPEN HOLES FOR FAYING SURFACES PRIOR TO BOLTING

RECEIVED
 OK'D BY: *[Signature]*
 AUG 24 2005
 RESUBMIT: APPROVED:
 BY: *[Signature]* DATE: 9/23/05

RESERVED FOR STAMPS

REV	DATE	DESCRIPTION	ISSUED TO	FOR
8	8/22/05	F.W. Whitcomb		Approval
8	4/8/05	F.W. WHITCOMB CONSTRUCTION		APPROVAL

PROJECT: ROUTE 100 OVER THE WEST RIVER
 LOCATION: TOWN OF JAMAICA
 ENGINEER: CLD CONSULTING ENGINEERS
 CUSTOMER: VERMONT A. O. T.
 DRAWING TITLE: TOP CHORD ASSEMBLIES
 DRAWN BY: BR 03/04/05 JOB SHEET
 CHECKED BY: GG 03/29/05 NUMBER: 5075 NUMBER: 103

NOTICE
 This drawing shall not be used or reproduced in any manner, nor shall any similar drawings or structures be made therefrom, nor shall the information thereon be used for any purpose other than that for which it is released without the written consent of an officer of EASTERN BRIDGE LLC.

EASTERN BRIDGE LLC
 RURAL RTE 2, BOX 302
 CLAREMONT, NH 03743
 603-542-5202