
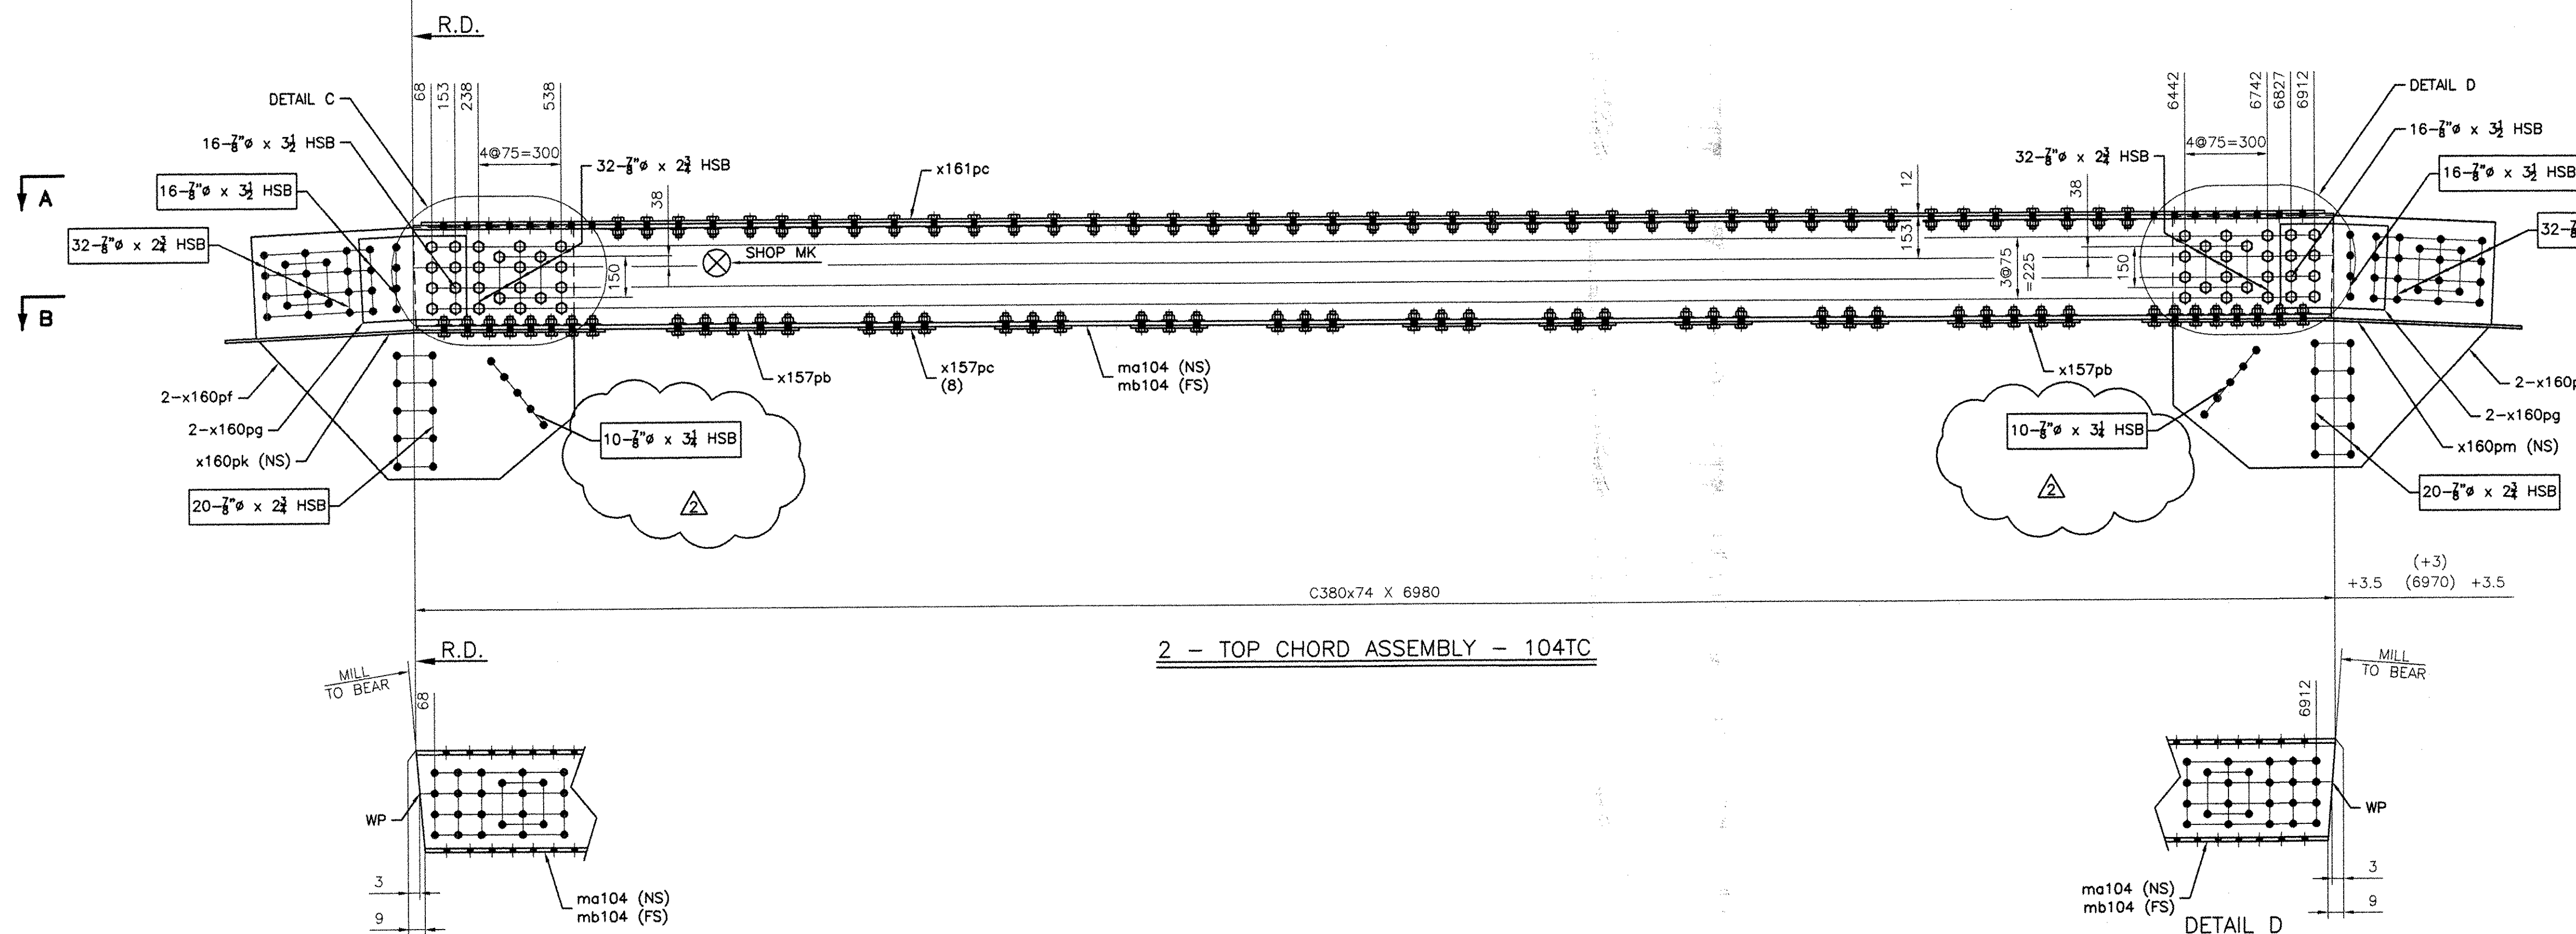
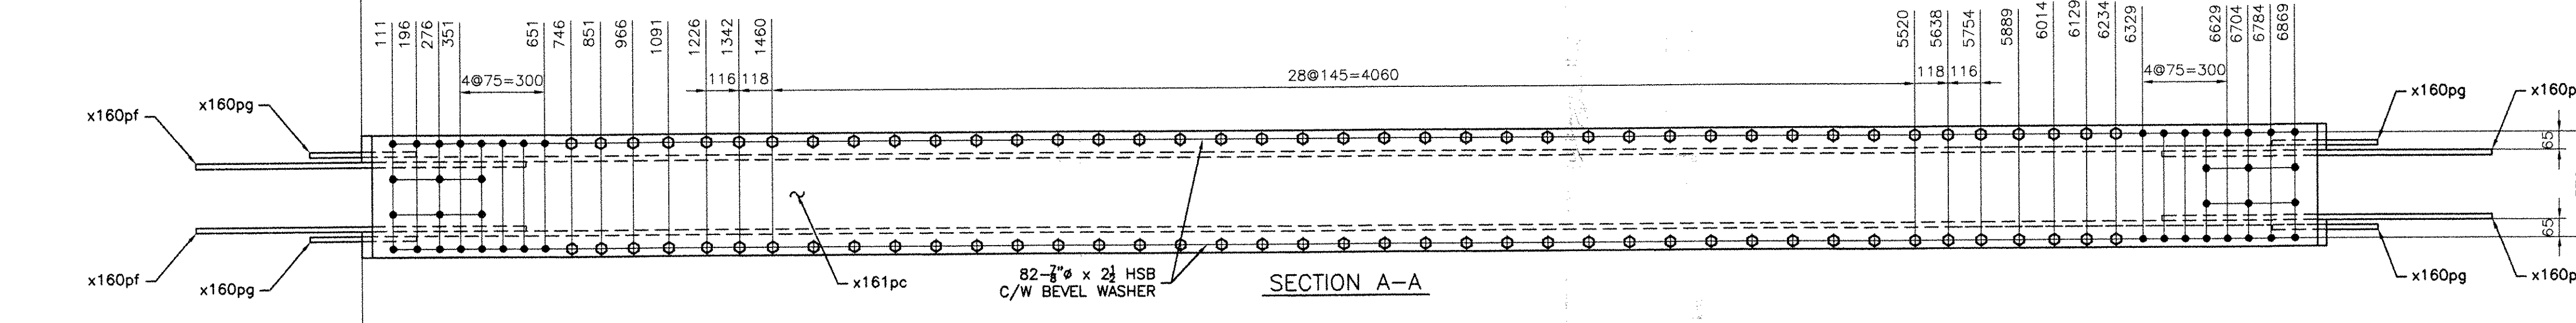


BILL OF MATERIAL

Drawing Number	Revision Number	Ship Mark	Piece Mark	Qty	Type of Material	Size of Material	Grade	Length	Finish	Notes
104		104BC	ma104	2	C Channel	380x74	M270M-GR345	6980	CVN	13
104		104BC	mb104	2	C Channel	380x74	M270M-GR345	6980	CVN	13
104		104BC	x157pb	4	PL Plate	10x434	M270M-GR345	480		53
104		104BC	x157pc	16	PL Plate	10x280	M270M-GR345	434		54
104		104BC	x160pf	8	PL Plate	18x910	M270M-GR345	1173	CVN	68
104		104BC	x160pg	8	PL Plate	18x314	M270M-GR345	391	CVN	58
104		104BC	x160pk	2	PL Plate	10x84	M270M-GR345	1381	CVN	59
104		104BC	x160pm	2	PL Plate	10x84	M270M-GR345	1381	CVN	59
104		104BC	x161pc	2	PL Plate	12x434	M270M-GR345	6918	CVN	14

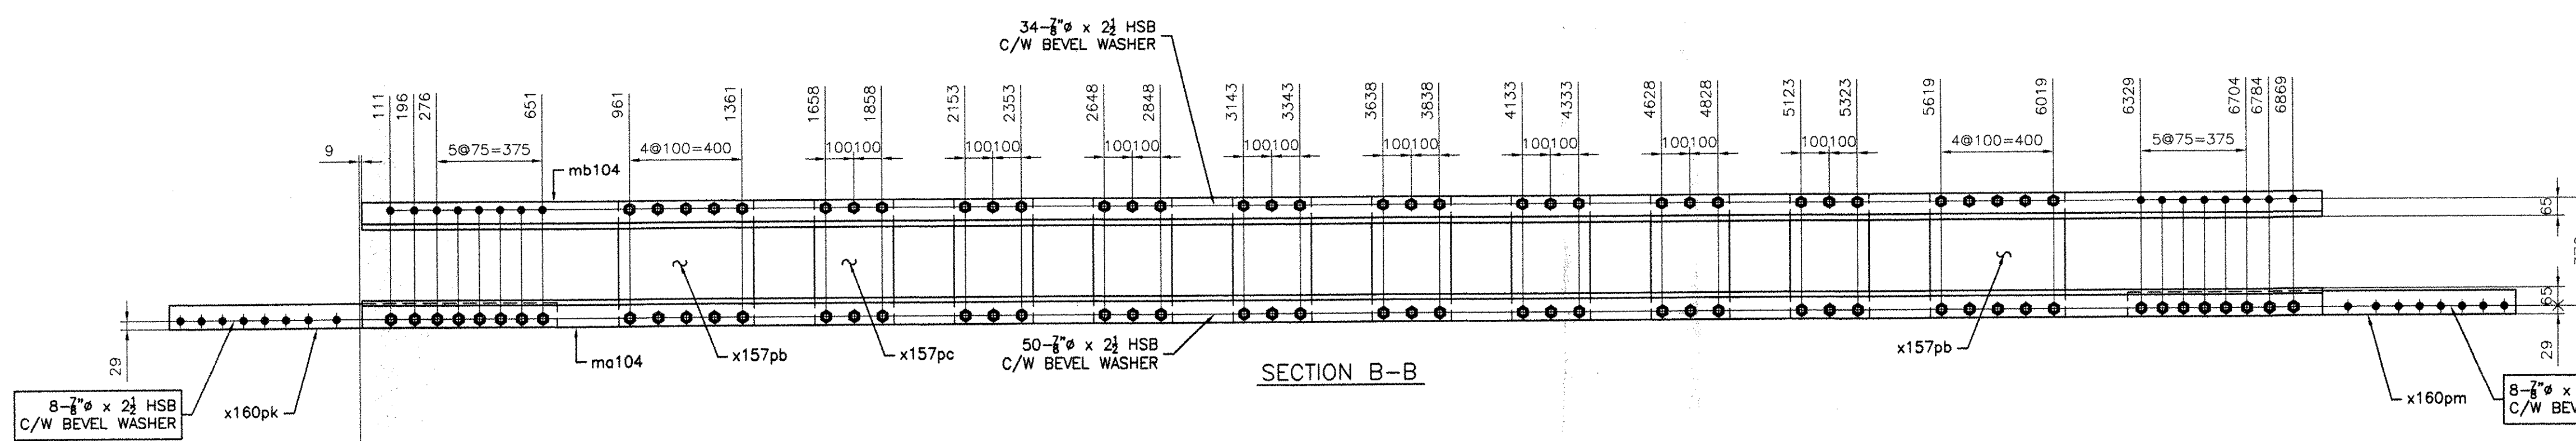

BOLTS LIST

QTY	DESCRIPTION	LENGTH
SHOP BOLTS LIST		
332	7/8" HSB	2 1/2
128	7/8" HSB	2 3/4
64	7/8" HSB	3 1/2
332	BEVEL WASHER 7/8"	
FIELD BOLTS LIST		
32	7/8" HSB	2 1/2
208	7/8" HSB	2 3/4
40	7/8" HSB	3 1/4
64	7/8" HSB	3 1/2
32	BEVEL WASHER 7/8"	

- NOTES:**
- 1- GENERAL NOTES: SEE GN101
 - 2- HOLES: 15/16" (24#) (UN)
 - 3- ALL HS BOLTS SHALL BE A325 TYPE 1 GALVANIZED C/W 1 NUT & 1 WASHER (UN)
 - 4- ALL STEEL SHALL BE GALVANIZED, SEE GN101
 - 5- ALL SHOP BOLTS SHALL BE HAND TIGHTEN
 - 6- ALL HOLES SHALL BE "CNC" DRILLED (UN)
 - 7- WIRE-BRUSH PREPARATION 3" OF OPEN HOLES FOR FAYING SURFACES PRIOR TO BOLTING

RESERVED FOR STAMPS

RECEIVED
 CK'D BY: _____ OK'D BY: *MGM*
 AUG 24 2005
 RESUBMIT _____ APPROVED _____
 BY: _____ DATE 9/23/05

REV	DATE	DESCRIPTION	QTY	DATE	ISSUED TO	FOR
8	8/22/05	F.W. Whitcomb				Approval
B	4/8/05	F.W. WHITCOMB CONSTRUCTION				APPROVAL

PROJECT: ROUTE 100 OVER THE WEST RIVER
 LOCATION: TOWN OF JAMAICA
 ENGINEER: CLD CONSULTING ENGINEERS
 CUSTOMER: VERMONT A. O. T.
 DRAWING TITLE: TOP CHORD ASSEMBLIES
 DRAWN BY: BR 03/04/05 JOB
 CHECKED BY: GG 03/29/05 NUMBER: 5075 SHEET NUMBER: 104

NOTICE
 This drawing shall not be used or reproduced in any manner, nor shall any similar drawings or structures be made therefrom, nor shall the information thereon be used for any purpose other than that for which it is released without the written consent of an officer of EASTERN BRIDGE LLC.