


BILL OF MATERIAL

Drawing Number	Revision Number	Ship Mark	Piece Mark	Qty	Type of Material	Size of Material	Grade	Length	Finish	Notes
105		105BC		2					3566 kg	
105		105BC	ma105	2	C Channel	380x74	M270M-GR345	6991	CVN	13
105		105BC	mb105	2	C Channel	380x74	M270M-GR345	6991	CVN	13
105		105BC	x157pb	4	PL Plate	10x434	M270M-GR345	480		53
105		105BC	x157pc	16	PL Plate	10x280	M270M-GR345	434		54
105		105BC	x160pc	4	PL Plate	18x923	M270M-GR345	1193	CVN	67
105		105BC	x160pd	4	PL Plate	18x323	M270M-GR345	412	CVN	58
105		105BC	x160pn	2	PL Plate	10x84	M270M-GR345	1236	CVN	59
105		105BC	x161pb	2	PL Plate	12x434	M270M-GR345	6916	CVN	14

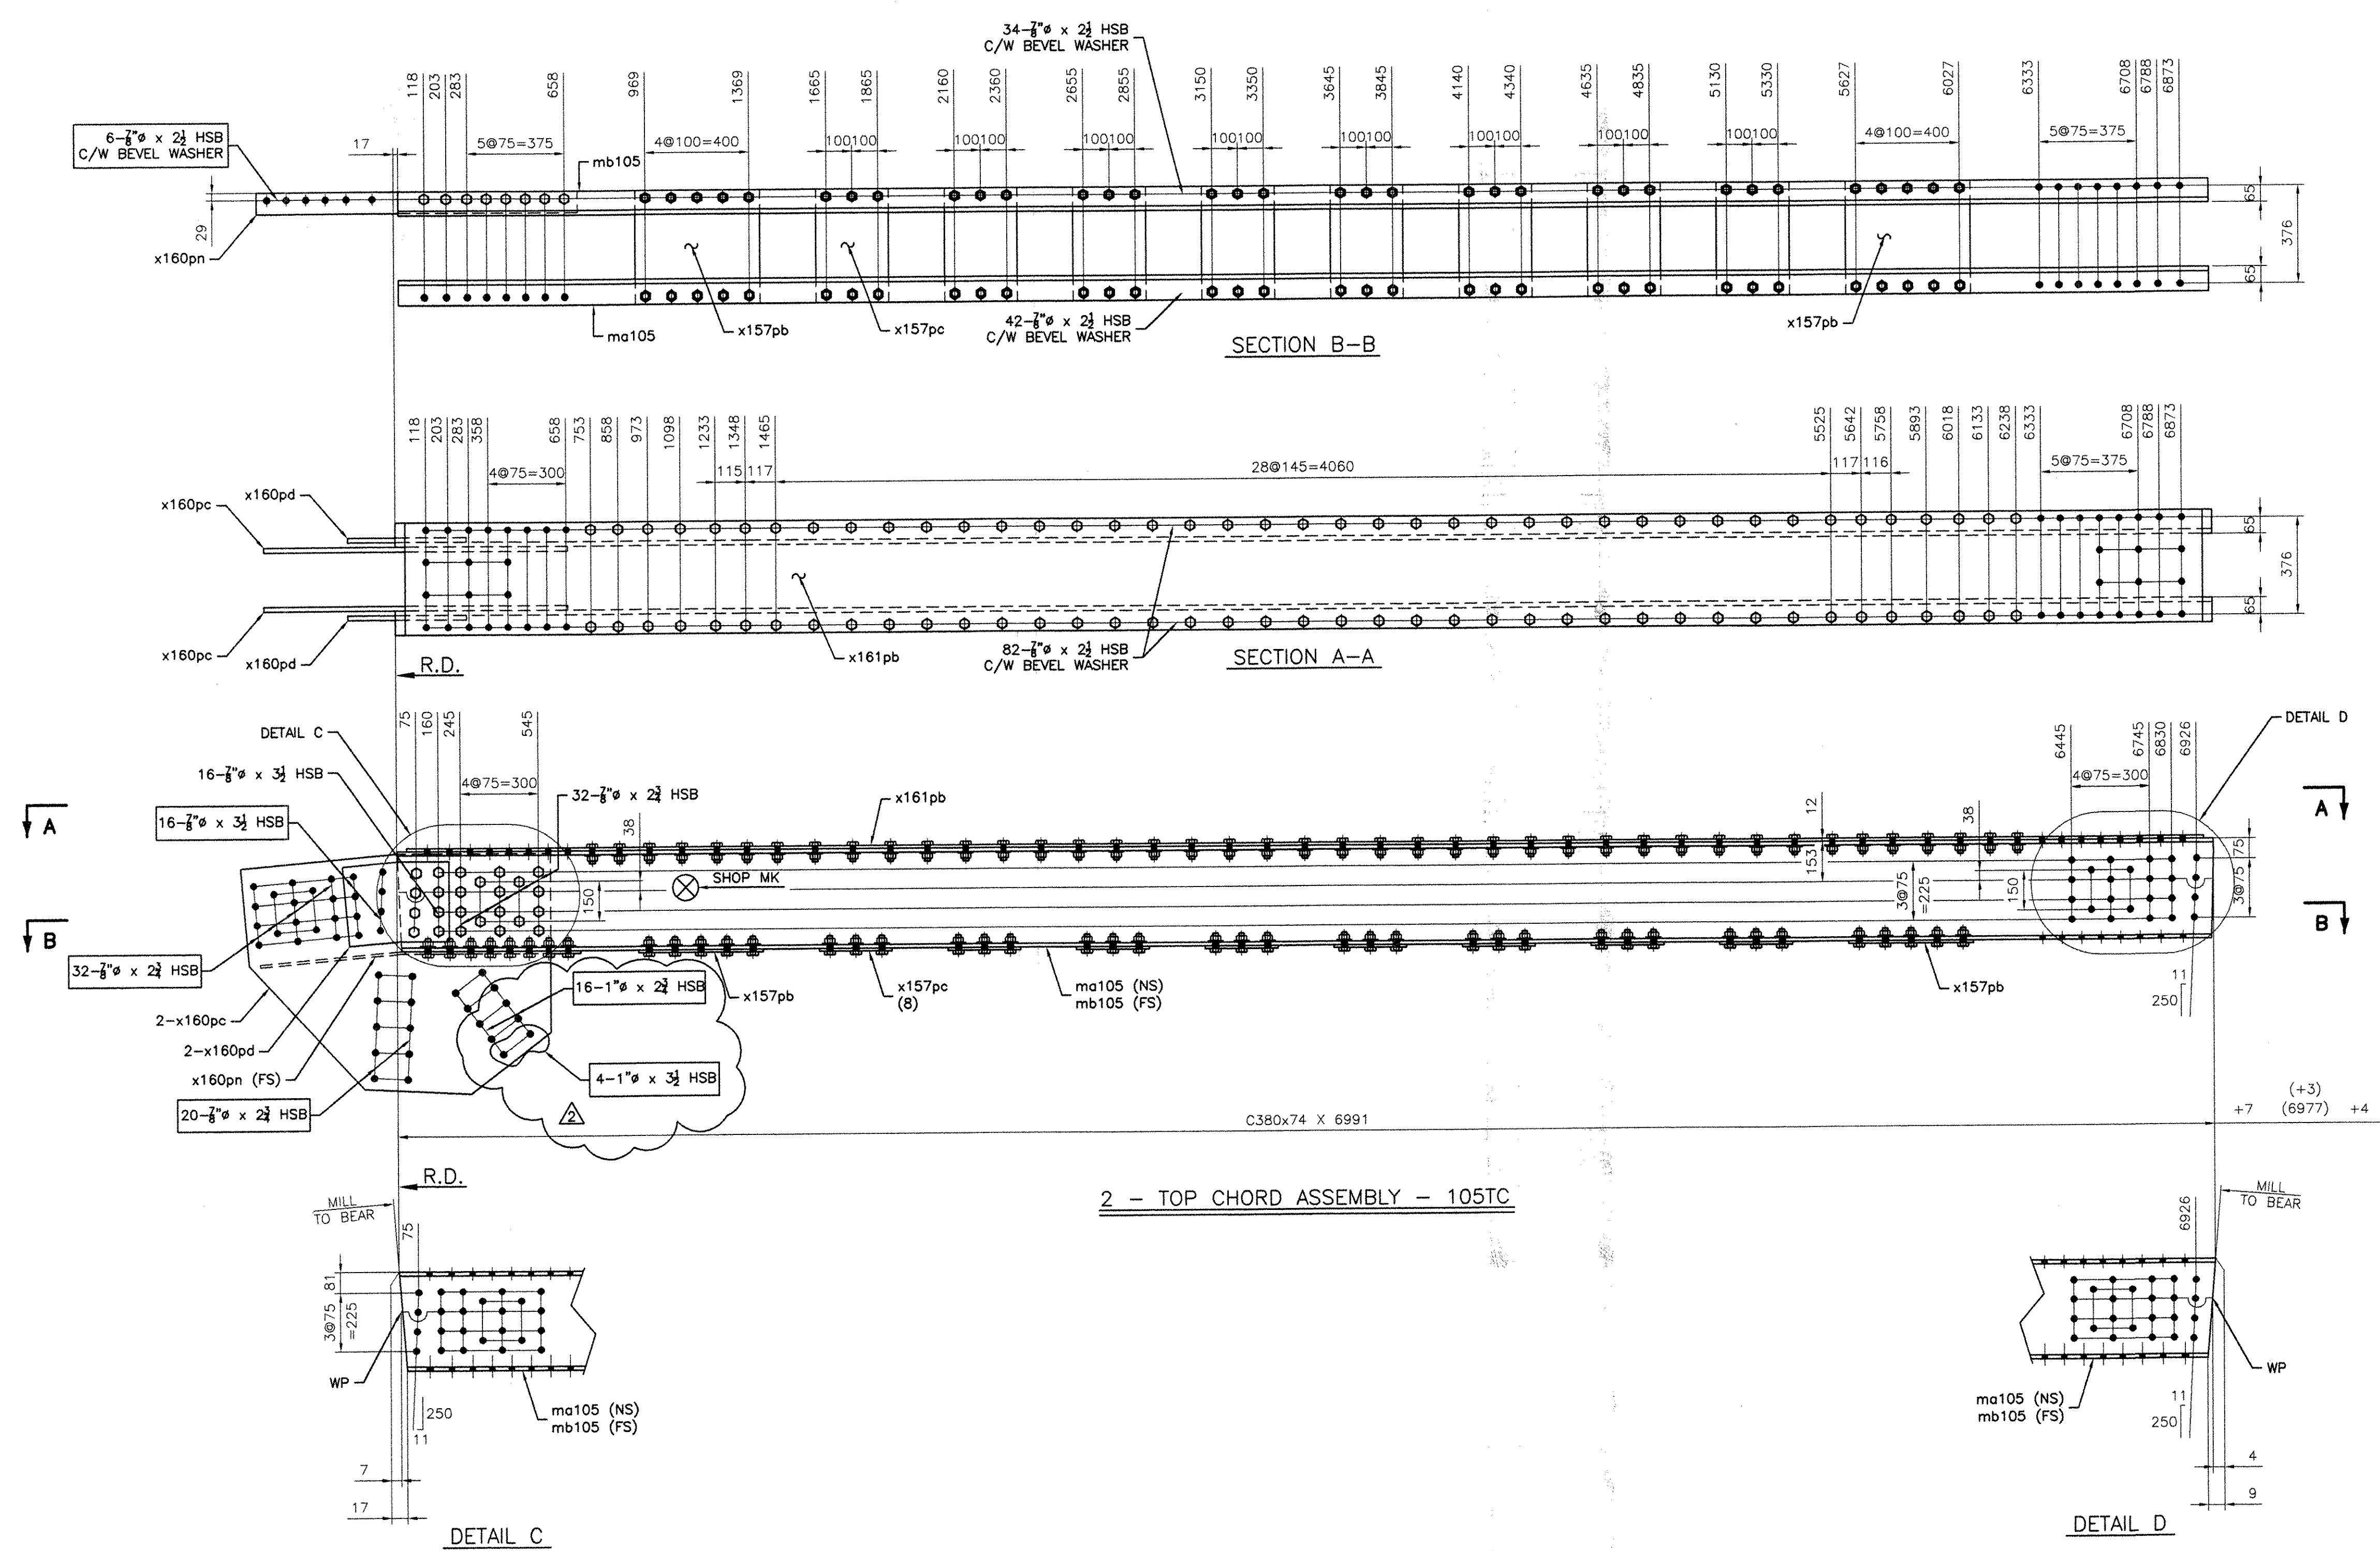

BOLTS LIST

QTY	DESCRIPTION	LENGTH
<u>SHOP BOLTS LIST</u>		
316	7/8" HSB	2 1/2
64	7/8" HSB	2 3/4
32	7/8" HSB	3 1/2
316	BEVEL WASHER 7/8"	
<u>FIELD BOLTS LIST</u>		
12	7/8" HSB	2 1/2
104	7/8" HSB	2 3/4
32	7/8" HSB	3 1/2
32	1" HSB	2 3/4
8	1" HSB	3 1/2
12	BEVEL WASHER 7/8"	

- NOTES:**
- 1- GENERAL NOTES: SEE GN101
 - 2- HOLES: 15/16" (24#) (UN)
 - 3- ALL HS BOLTS SHALL BE A325 TYPE 1 GALVANIZED C/W 1 NUT & 1 WASHER (UN)
 - 4- ALL STEEL SHALL BE GALVANIZED, SEE GN101
 - 5- ALL SHOP BOLTS SHALL BE HAND TIGHTEN
 - 6- ALL HOLES SHALL BE "CNC" DRILLED (UN)
 - 7- WIRE-BRUSH PREPARATION 3" OF OPEN HOLES FOR FAYING SURFACES PRIOR TO BOLTING

RESERVED FOR STAMPS

RECEIVED
 CR'D BY: _____ OK'D BY: *FW*
 AUG 24 2005
 RESUBMIT: _____ APPROVED: *FW*
 BY: _____ DATE: 9/23/05

REV	DATE	DESCRIPTION	QTY	DATE	ISSUED TO	FOR
8	8/22/05	F.W. Whitcomb				Approval
6	6/20/05	BEVEL WASHER		4/8/05	F.W. WHITCOMB CONSTRUCTION	APPROVAL

PROJECT: ROUTE 100 OVER THE WEST RIVER
 LOCATION: TOWN OF JAMAICA
 ENGINEER: CLD CONSULTING ENGINEERS
 CUSTOMER: VERMONT A. O. T.
 DRAWING TITLE: TOP CHORD ASSEMBLIES
 DRAWN BY: BR 03/04/05 JOB NUMBER: 5075 SHEET NUMBER: 105
 CHECKED BY: GG 03/29/05

NOTICE
 This drawing shall not be used or reproduced in any manner, nor shall any similar drawings or structures be made therefrom, nor shall the information thereon be used for any purpose other than that for which it is released without the written consent of an officer of EASTERN BRIDGE LLC.