


BOLTS LIST		
QTY	DESCRIPTION	LENGTH
SHOP BOLTS LIST		
264	7/8" HSB	2 1/2
116	7/8" HSB	2 3/4
264	BEVEL WASHER 7/8"	
FIELD BOLTS LIST		
108	7/8" HSB	2 3/4
164	7/8" HSB	3 1/4
8	7/8" HSB	4 1/4
80	1" HSB	2 3/4
56	1" HSB	3 1/4
16	1" HSB	3 1/2
76	BEVEL WASHER 7/8"	

BILL OF MATERIAL										
Drawing Number	Revision Number	Ship Mark	Piece Mark	Qty	Type of Material	Size of Material	Grade	Length	Finish	Notes
110		110BC	ma110	2	MC Channel	310x67	M270M-GR345	11436	CVN	10
110		110BC	mb110	2	MC Channel	310x67	M270M-GR345	11436	CVN	10
110		110BC	x157pk	12	PL Plate	10x446	M270M-GR345	480		51
110		110BC	x157pm	24	PL Plate	10x230	M270M-GR345	446		52
110		110BC	x158pa	2	PL Plate	18x990	M270M-GR345	1059	CVN	64
110		110BC	x158pb	2	PL Plate	18x859	M270M-GR345	990	CVN	64
110		110BC	x158pc	2	PL Plate	18x945	M270M-GR345	1059	CVN	65
110		110BC	x158pd	2	PL Plate	18x859	M270M-GR345	945	CVN	65

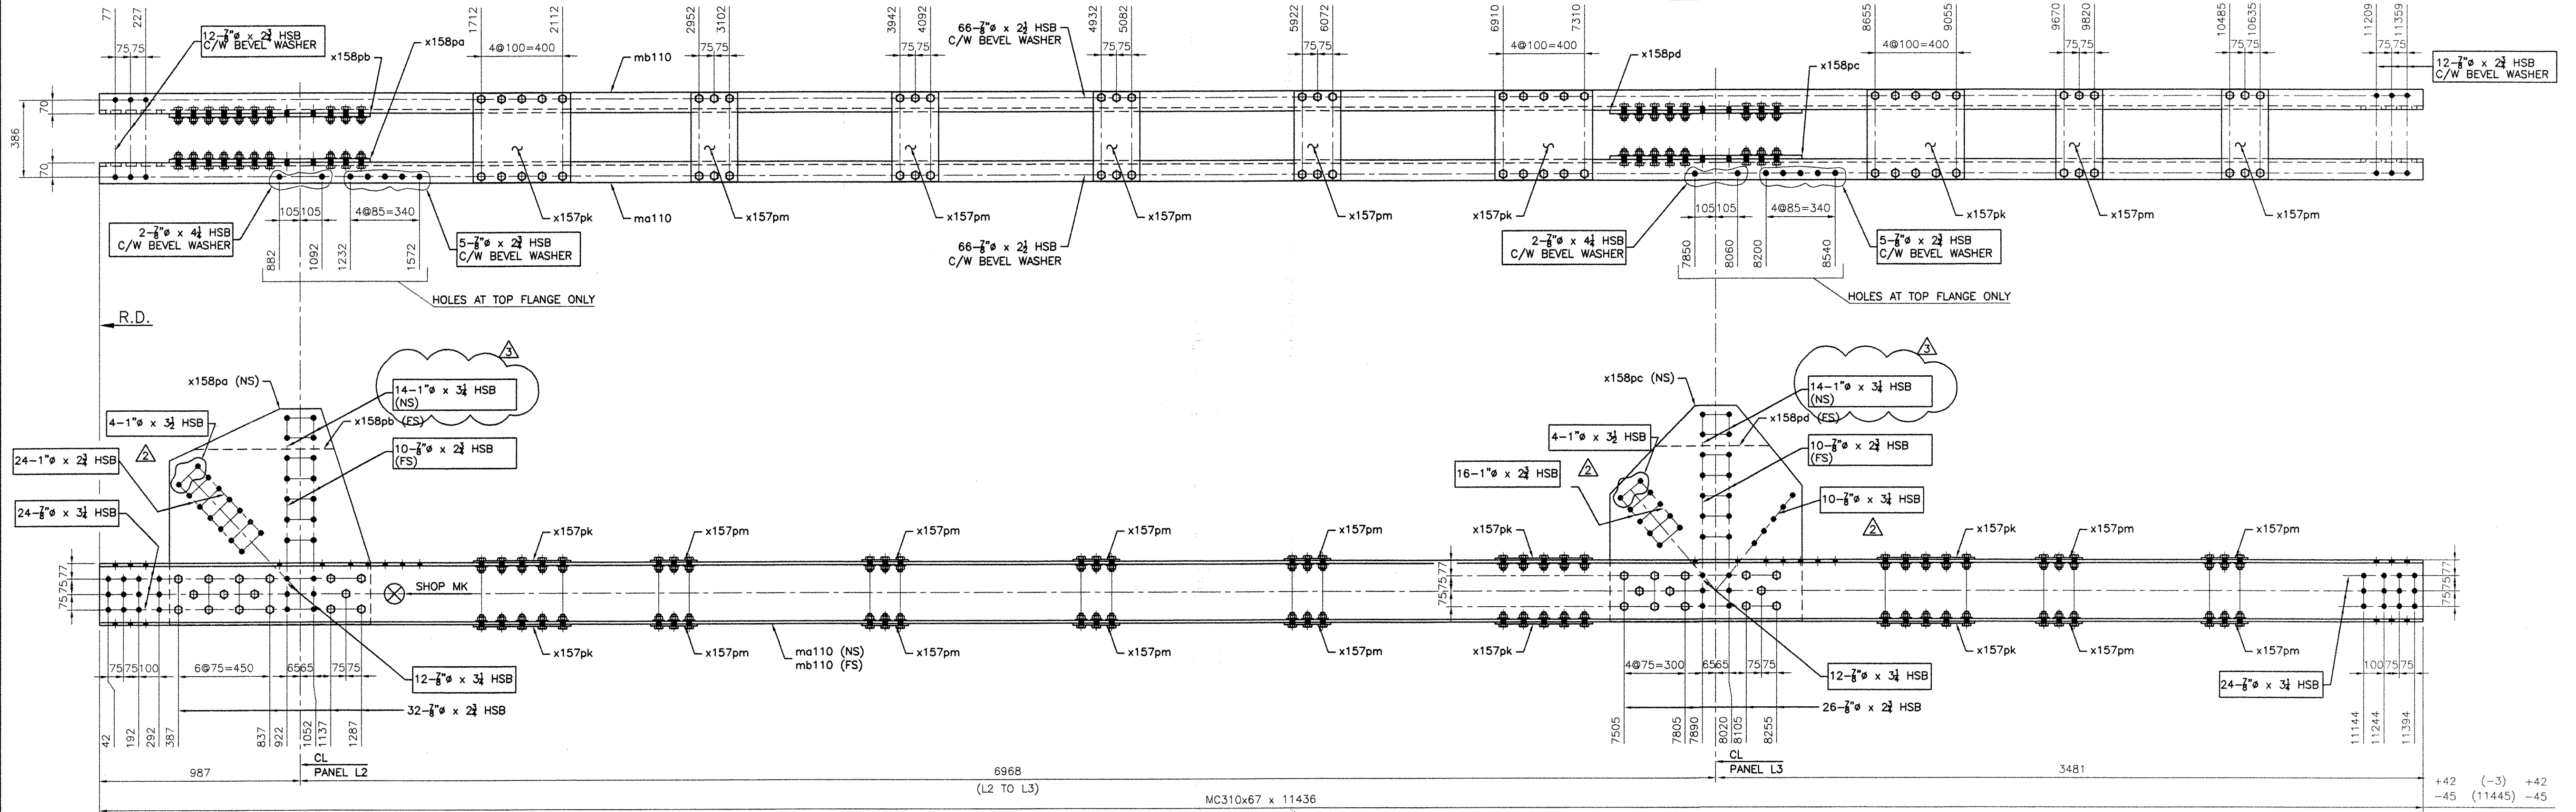


2 - BOTTOM CHORD ASSEMBLY - 110BC

- NOTES:
- 1- GENERAL NOTES: SEE GN101
 - 2- HOLES: 15/16" (24#) (UN)
 - 3- ALL HS BOLTS SHALL BE A325 TYPE 1 GALVANIZED C/W 1 NUT & 1 WASHER (UN)
 - 4- ALL STEEL SHALL BE GALVANIZED, SEE GN101
 - 5- ALL SHOP BOLTS SHALL BE HAND TIGHTEN
 - 6- ALL HOLES SHALL BE "CNC" DRILLED (UN)
 - 7- WIRE-BRUSH PREPARATION 3" OF OPEN HOLES FOR FAYING SURFACES PRIOR TO BOLTING

RECEIVED BY: *Man*
 OK'D BY: *Man*
 SEP 23 2005
 RESUBMIT APPROVED BY: *Man*
 DATE: 9/23/05
 RESERVED FOR STAMPS

REV	DATE	DESCRIPTION	QTY	DATE	ISSUED TO	APPROVAL
8	9/19/05	F.W. Whitcomb				APPROVAL
8	4/8/05	F.W. WHITCOMB CONSTRUCTION				APPROVAL
						FOR

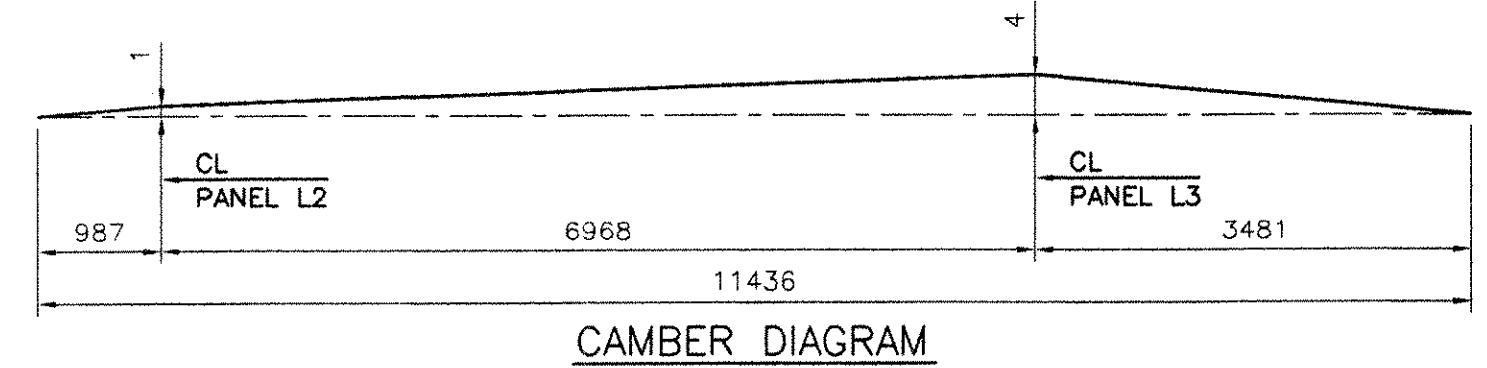

CAMBER DIAGRAM

NOTICE
 This drawing shall not be used or reproduced in any manner, nor shall any similar drawings or structures be made therefrom, nor shall the information thereon be used for any purpose other than that for which it is released without the written consent of an officer of EASTERN BRIDGE LLC.

Eastern Bridge LLC
 1010
 EASTERN BRIDGE LLC
 RURAL RTE 2, BOX 302
 CLAREMONT, NH 03743
 603-542-5202

PROJECT: ROUTE 100 OVER THE WEST RIVER
 LOCATION: TOWN OF JAMAICA
 ENGINEER: CLD CONSULTING ENGINEERS
 CUSTOMER: VERMONT A. O. T.
 DRAWING TITLE: BOTTOM CHORD ASSEMBLIES
 DRAWN BY: YT 03/16/05 JOB
 CHECKED BY: GG 03/25/05 NUMBER: 5075 SHEET NUMBER: 110