






GPS CONTROL POINTS

NOT SHOWN
ON PLANS


NOT SHOWN
ON PLANS

NOT SHOWN
ON PLANS

TRAVERSE TIES

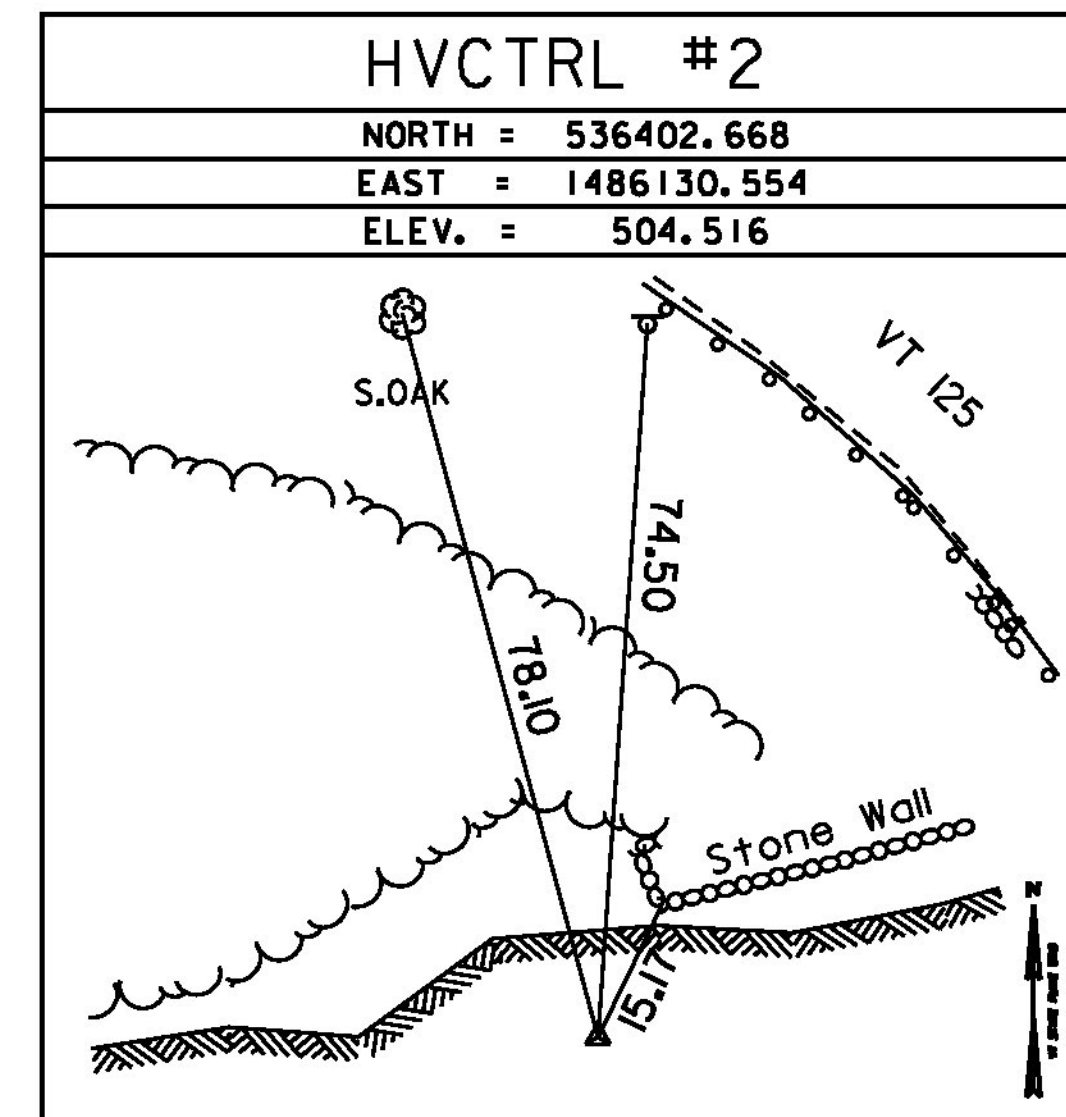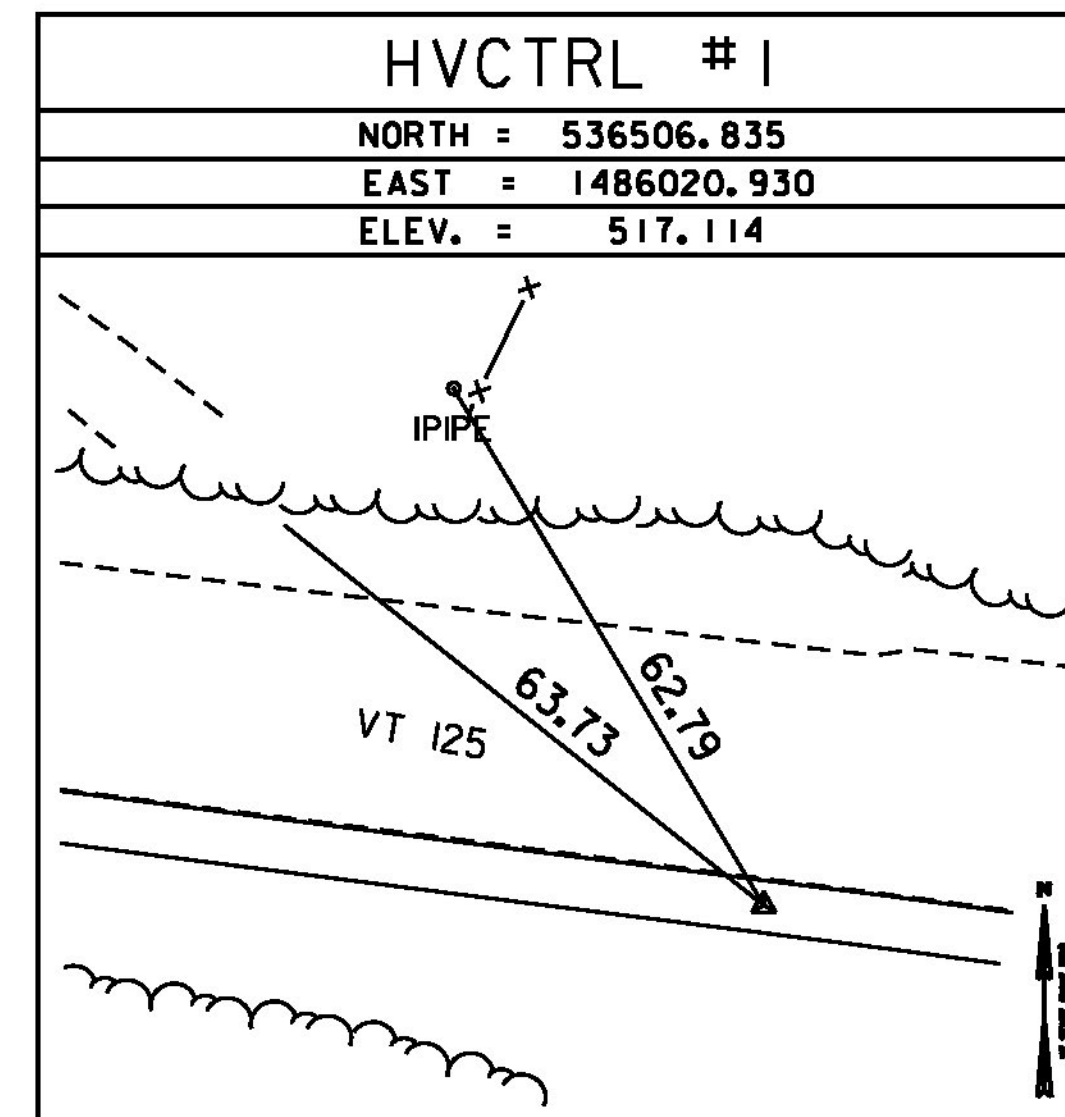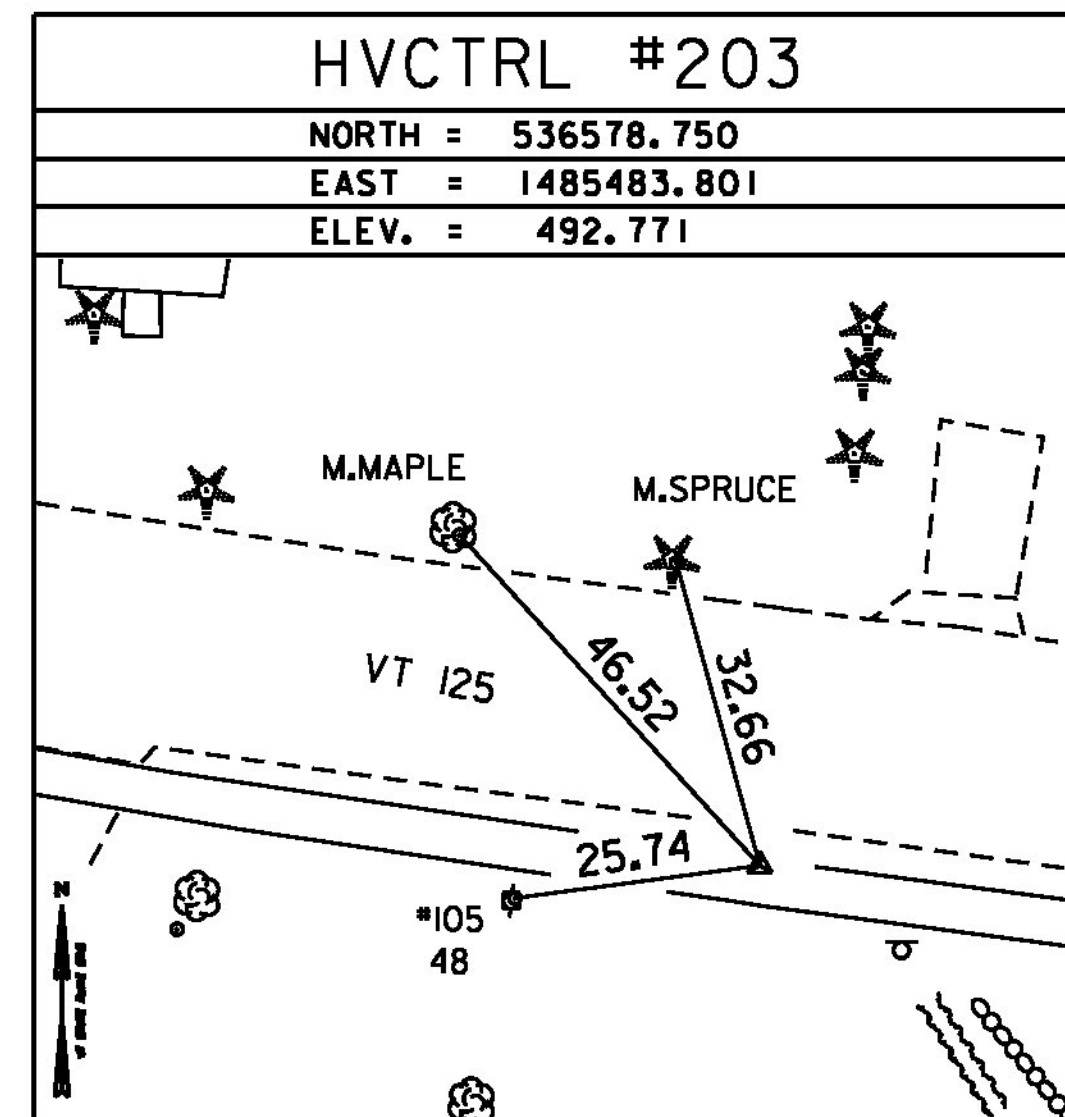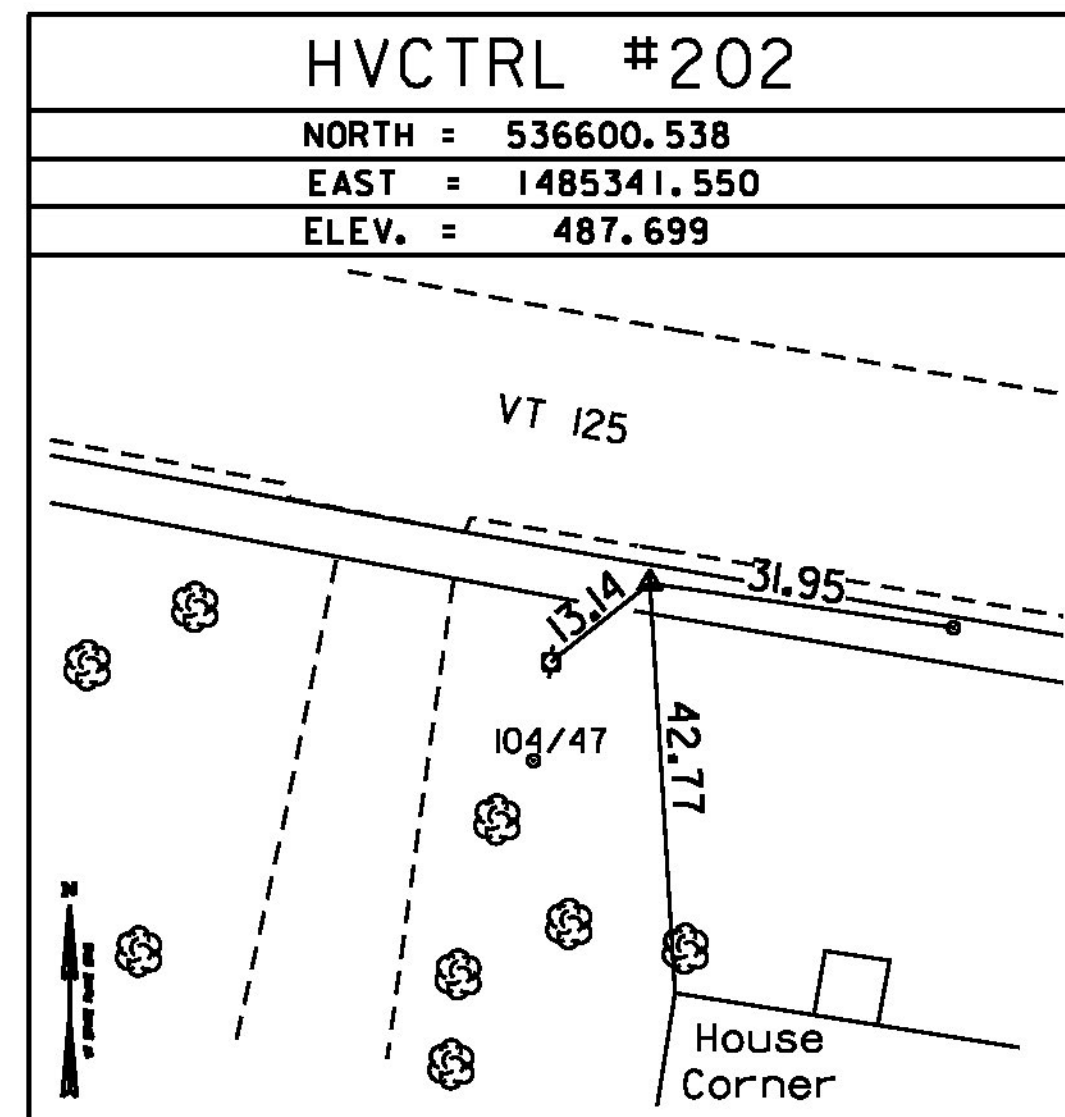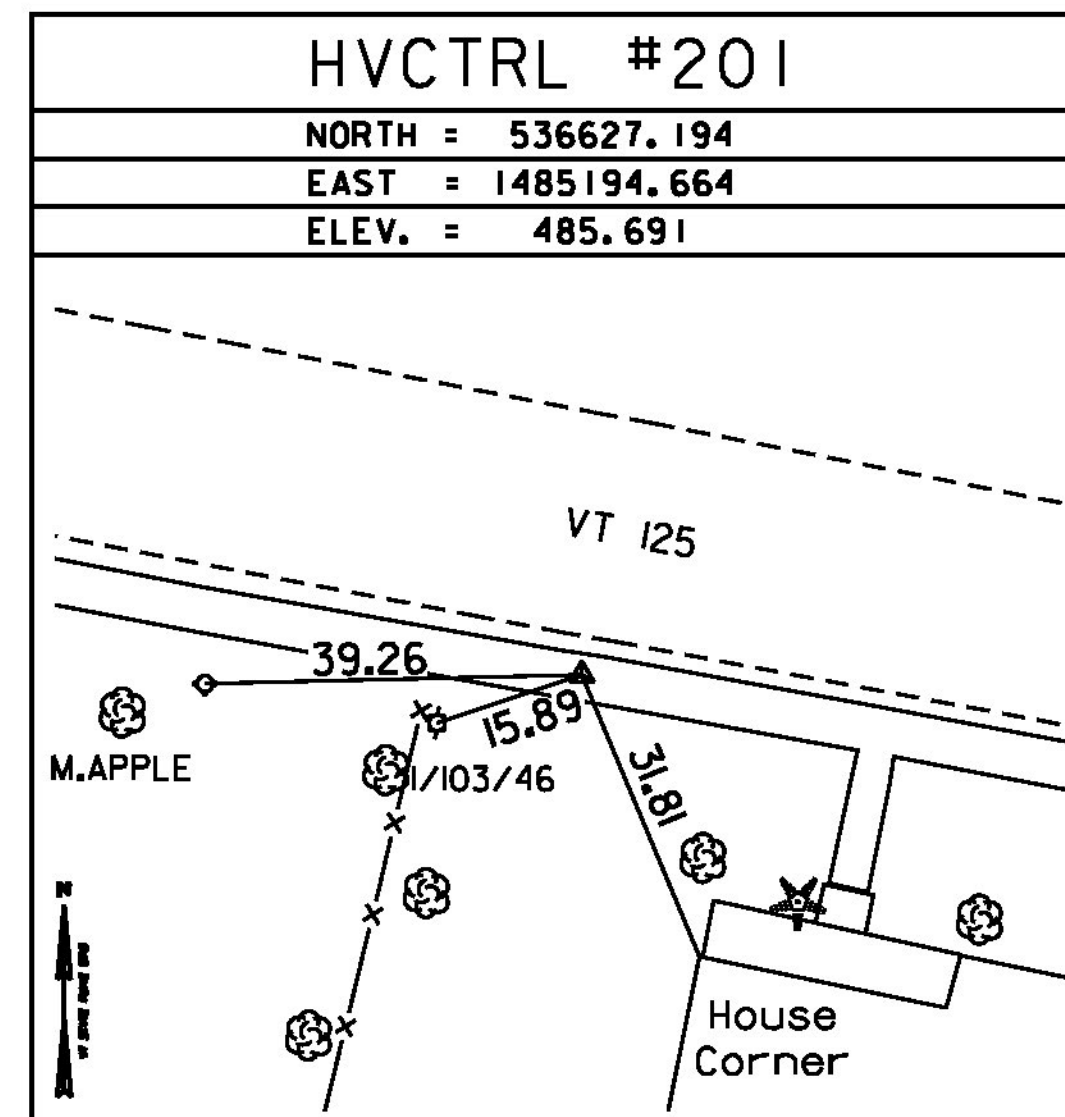

TRAVERSE TIES

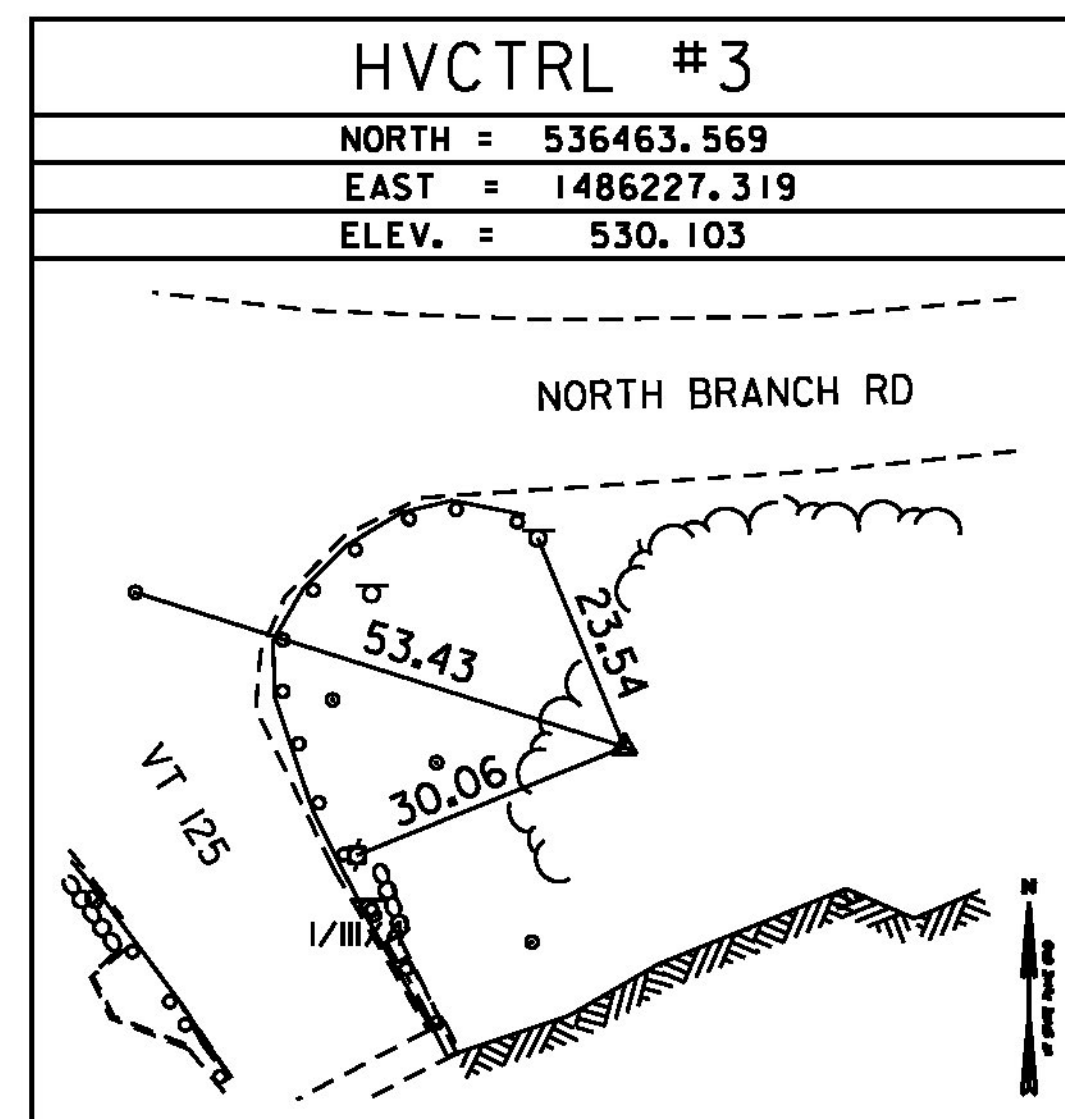

DATUM	
VERTICAL	NAVD 88
HORIZONTAL	NAD 83 (92)
ADJUSTMENT	-

PROJECT NAME:	MIDDLEBURY
PROJECT NUMBER:	RS 0174(8)
FILE NAME:	z78f2171e.dgn
PROJECT LEADER:	M.A. COLGAN
DESIGNED BY:	B.J. MASSE
TIE SHEET	
PLOT DATE:	8/27/2013
DRAWN BY:	B.J. MASSE
CHECKED BY:	G.S. GOODRICH
SHEET	15 OF 104

