



COLD PLANING, BITUMINOUS PAVEMENT
 STA 135+50 - STA 135+90, LT & RT

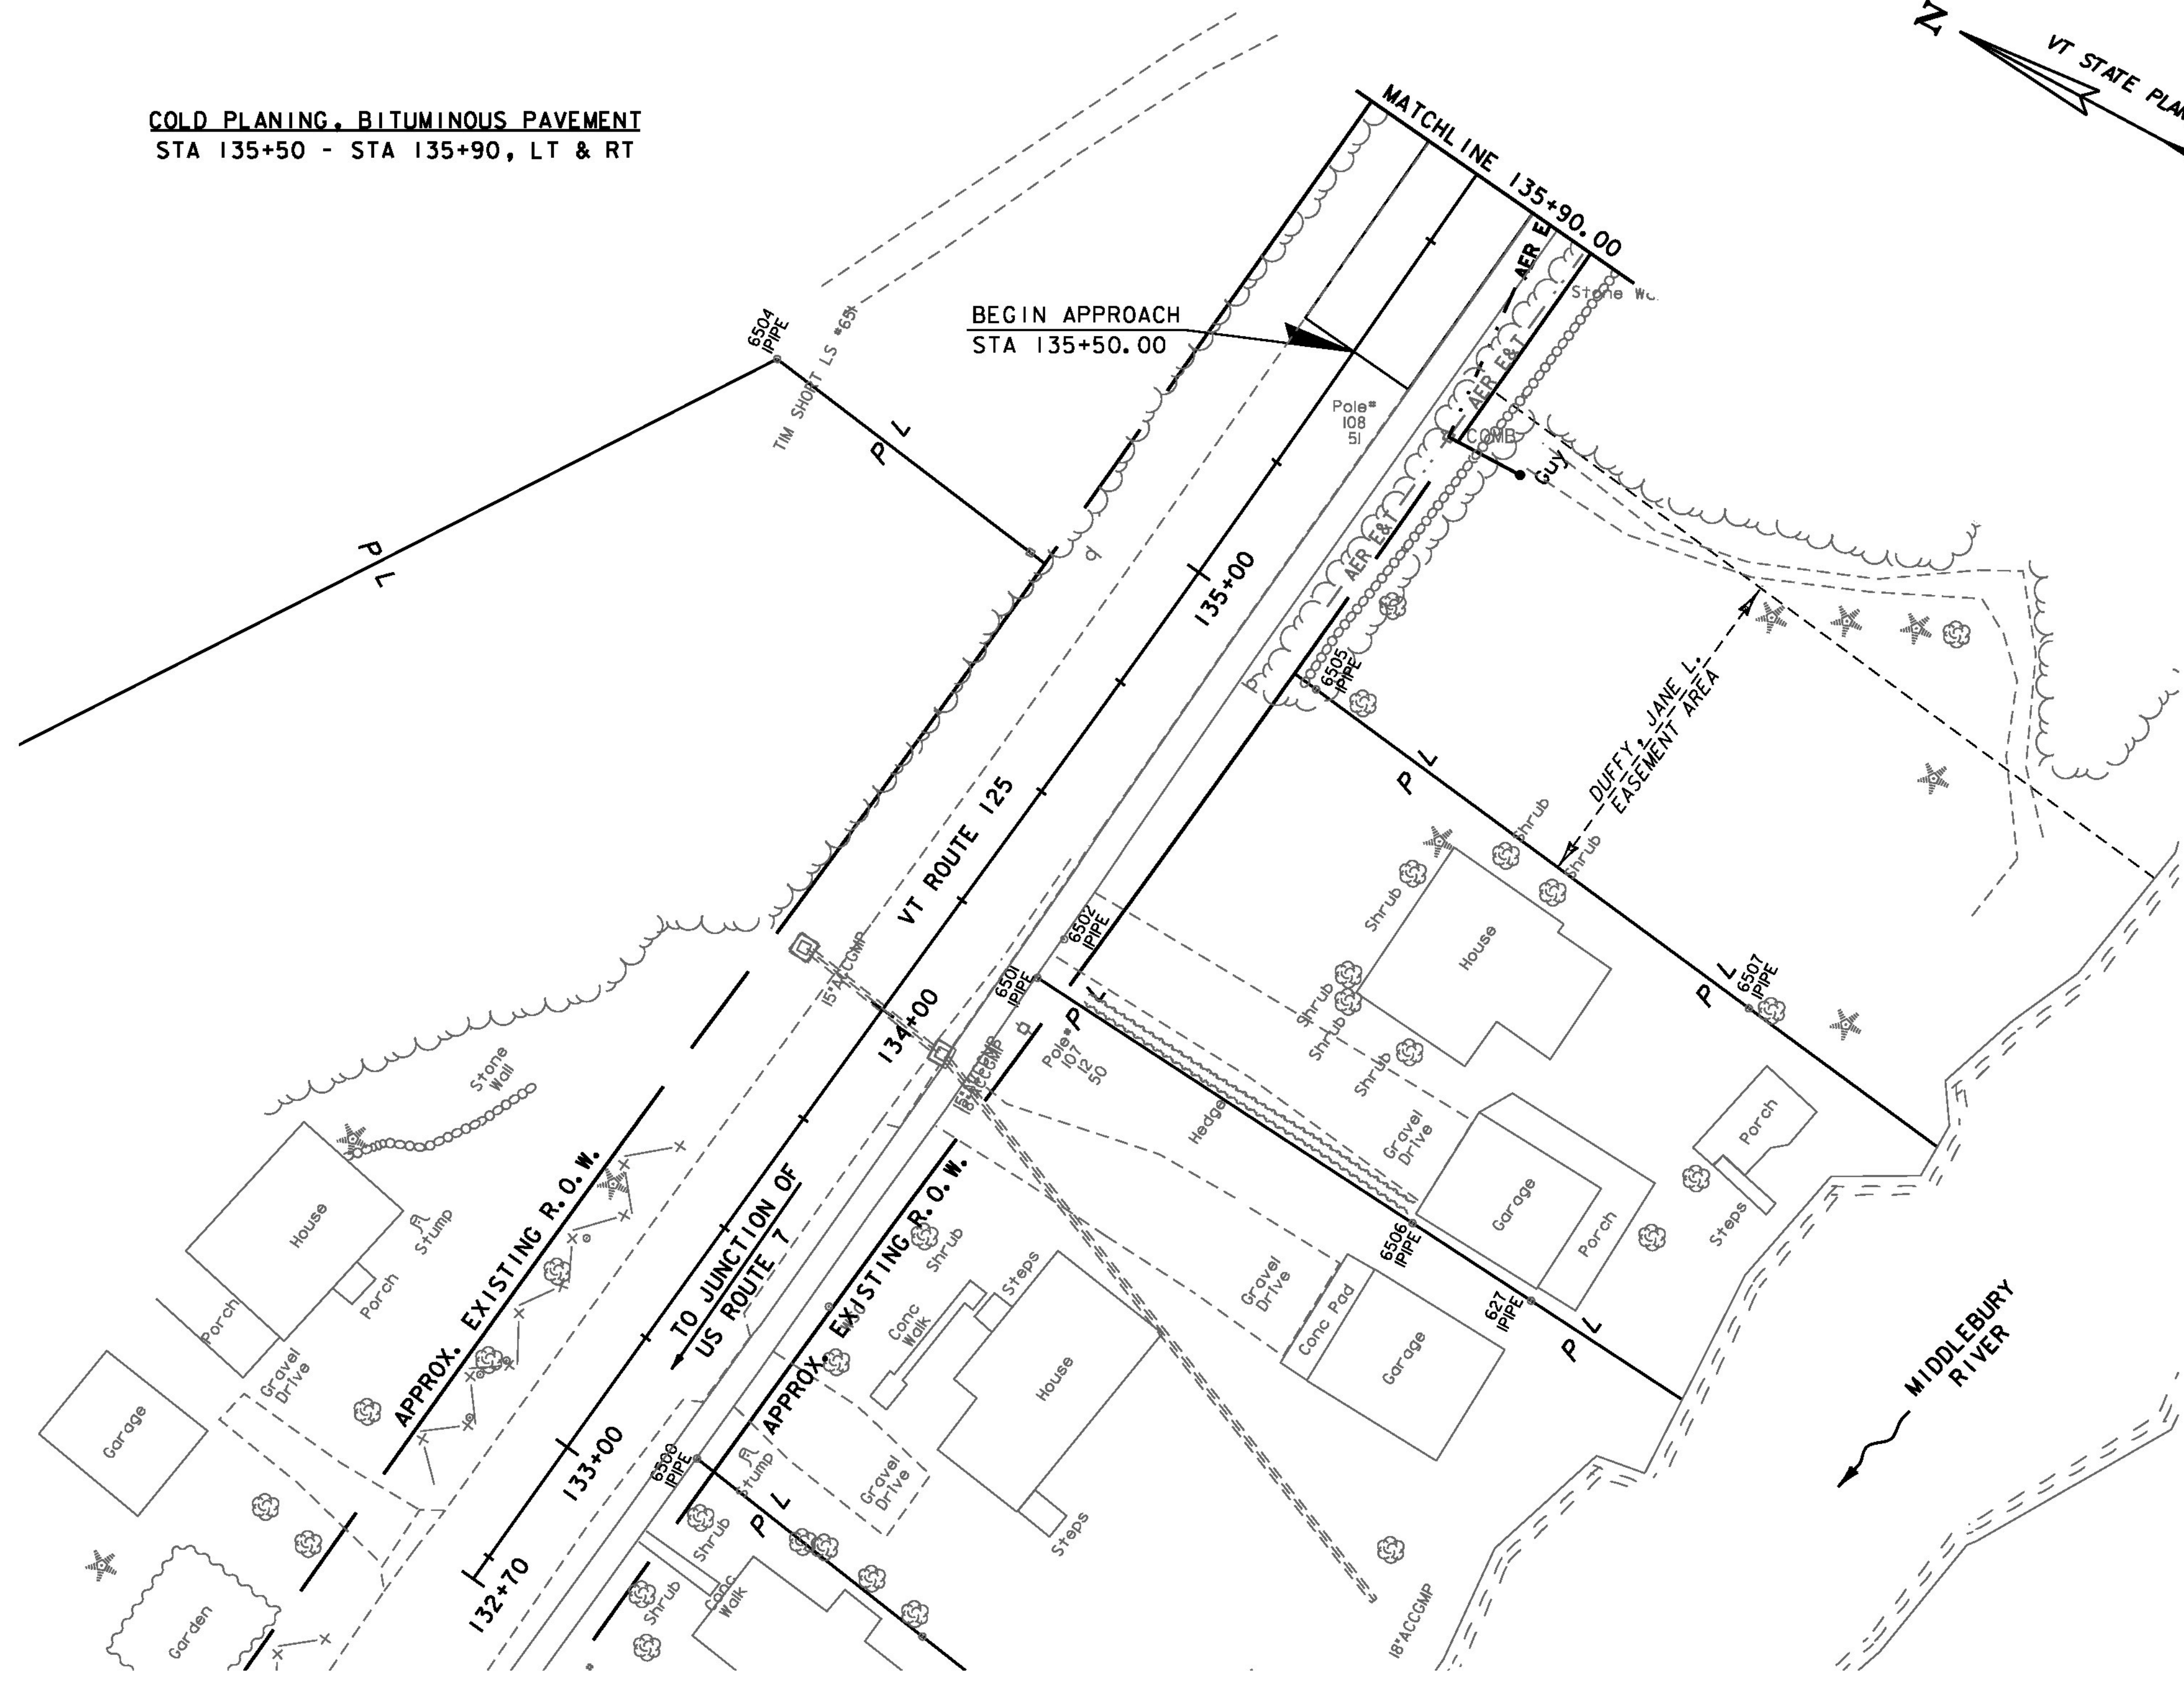

PLAN
 SCALE 1" = 20'-0"
 20 0 20

PROJECT NAME: MIDDLEBURY	
PROJECT NUMBER: RS 0174(8)	
FILE NAME: z78f217bdr_nul.dgn	PLOT DATE: 8/27/2013
PROJECT LEADER: M.A. COLGAN	DRAWN BY: B.J. MASSE
DESIGNED BY: D.M. PECK	CHECKED BY: G.L. BAKOS
LAYOUT SHEET (1 OF 3)	SHEET 17 OF 104

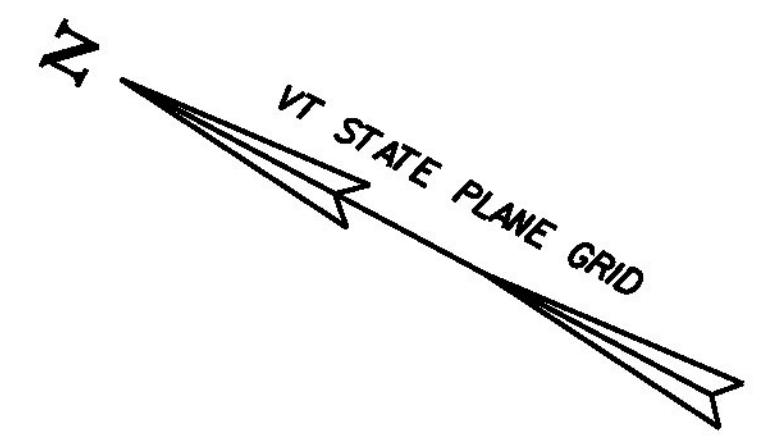