


THE GRADES SHOWN TO THE NEAREST TENTH ARE THE ORIGINAL GROUND ELEVATIONS ALONG THE PROPOSED ALIGNMENT.

THE GRADES SHOWN TO THE NEAREST HUNDREDTH ARE THE FINISH GRADES ALONG THE PROPOSED ALIGNMENT.

**VT 125 PROFILE**  
 SCALE 1" = 20' HORIZONTAL  
 1" = 10' VERTICAL

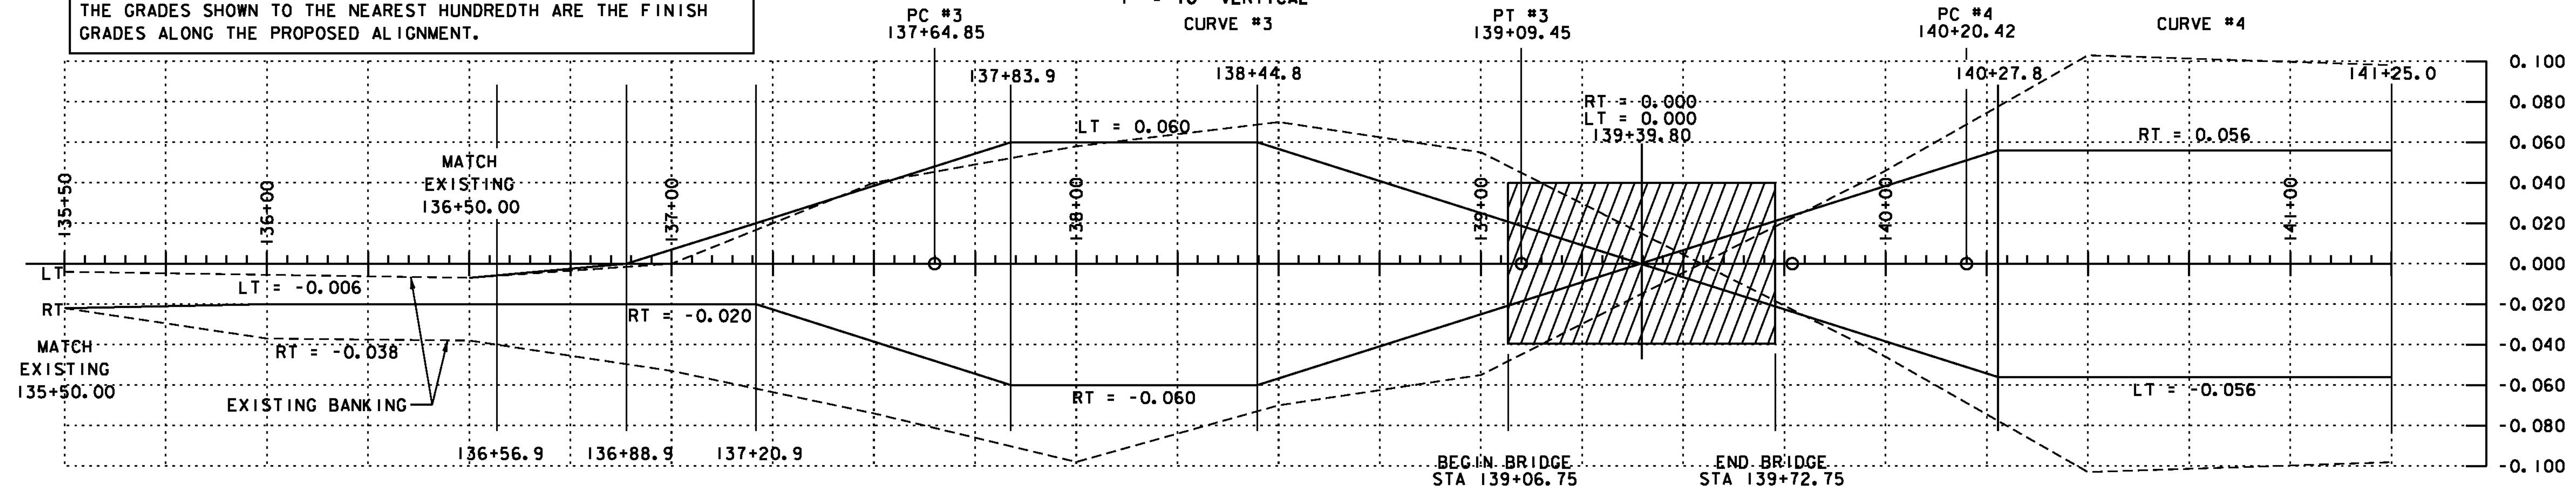

**BANKING DIAGRAM**  
 SCALE 1" = 20' HORIZONTAL  
 1" = 0.040 FT/FT VERTICAL



PROJECT NAME:	MIDDLEBURY
PROJECT NUMBER:	RS 0174(8)
FILE NAME:	z78f217Profiles.dgn
PROJECT LEADER:	M.A. COLGAN
DESIGNED BY:	D.M. PECK
PROFILE AND BANKING DIAGRAM (1 OF 2)	
PLOT DATE:	8/27/2013
DRAWN BY:	B.J. MASSE
CHECKED BY:	G.L. BAKOS
SHEET	20 OF 104