


VT 125 PROFILE
 SCALE 1" = 20' HORIZONTAL
 1" = 10' VERTICAL

THE GRADES SHOWN TO THE NEAREST TENTH ARE THE ORIGINAL GROUND ELEVATIONS ALONG THE PROPOSED ALIGNMENT.

THE GRADES SHOWN TO THE NEAREST HUNDREDTH ARE THE FINISH GRADES ALONG THE PROPOSED ALIGNMENT.

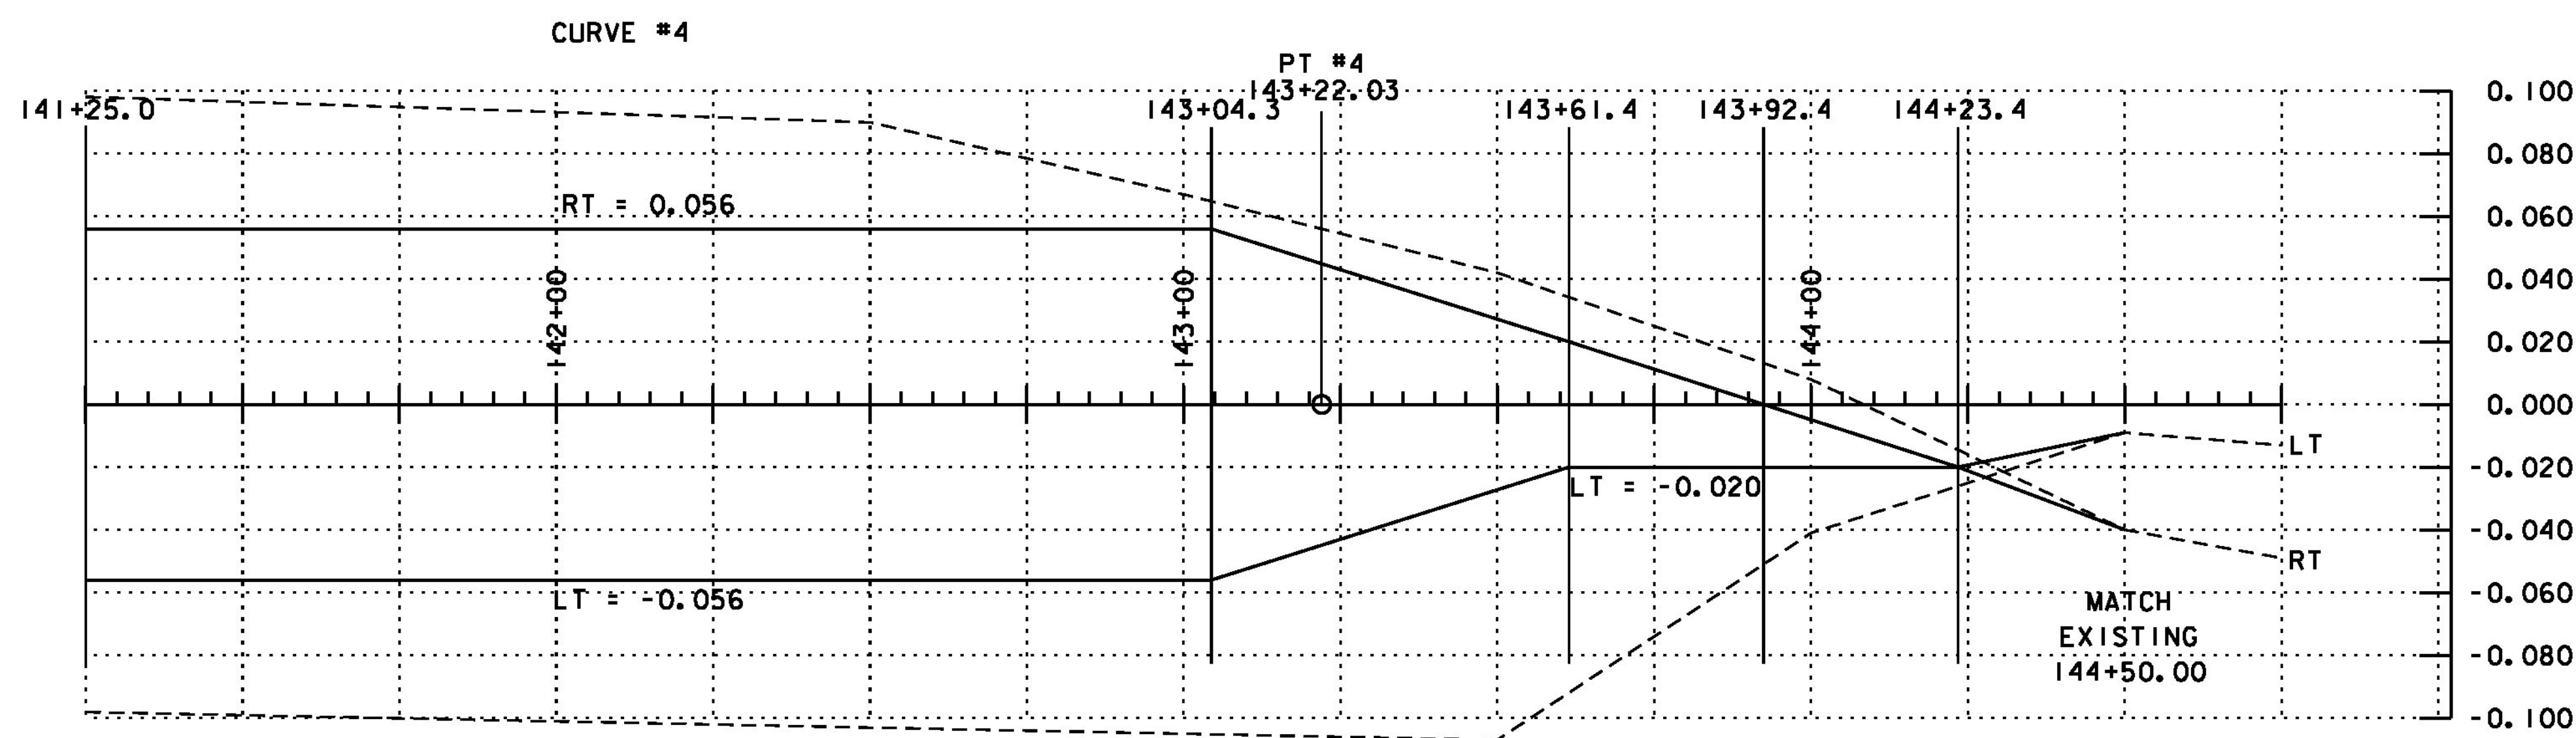

BANKING DIAGRAM
 SCALE 1" = 20' HORIZONTAL
 1" = 0.040 FT/FT VERTICAL

PROJECT NAME:	MIDDLEBURY	FILE NAME:	z78f217Profiles.dgn	PLOT DATE:	8/27/2013
PROJECT NUMBER:	RS 0174(8)	PROJECT LEADER:	M.A. COLGAN	DRAWN BY:	B.J. MASSE
		DESIGNED BY:	D.M. PECK	CHECKED BY:	G.L. BAKOS
		PROFILE AND BANKING DIAGRAM (2 OF 2)		SHEET	21 OF 104

