


WATER MAIN SECTION

SCALE 1/8" = 1'-0"

NOTES:

1. ALL WATER MAIN BETWEEN STATIONS 138+40-140+20 SHALL BE MJ x MJ PIPE.
2. EXTEND JOINTS AND ENGAGE RESTRAINTS FOR ALL FITTINGS AND CONNECTIONS PRIOR TO PLACING WATER MAIN IN SERVICE.

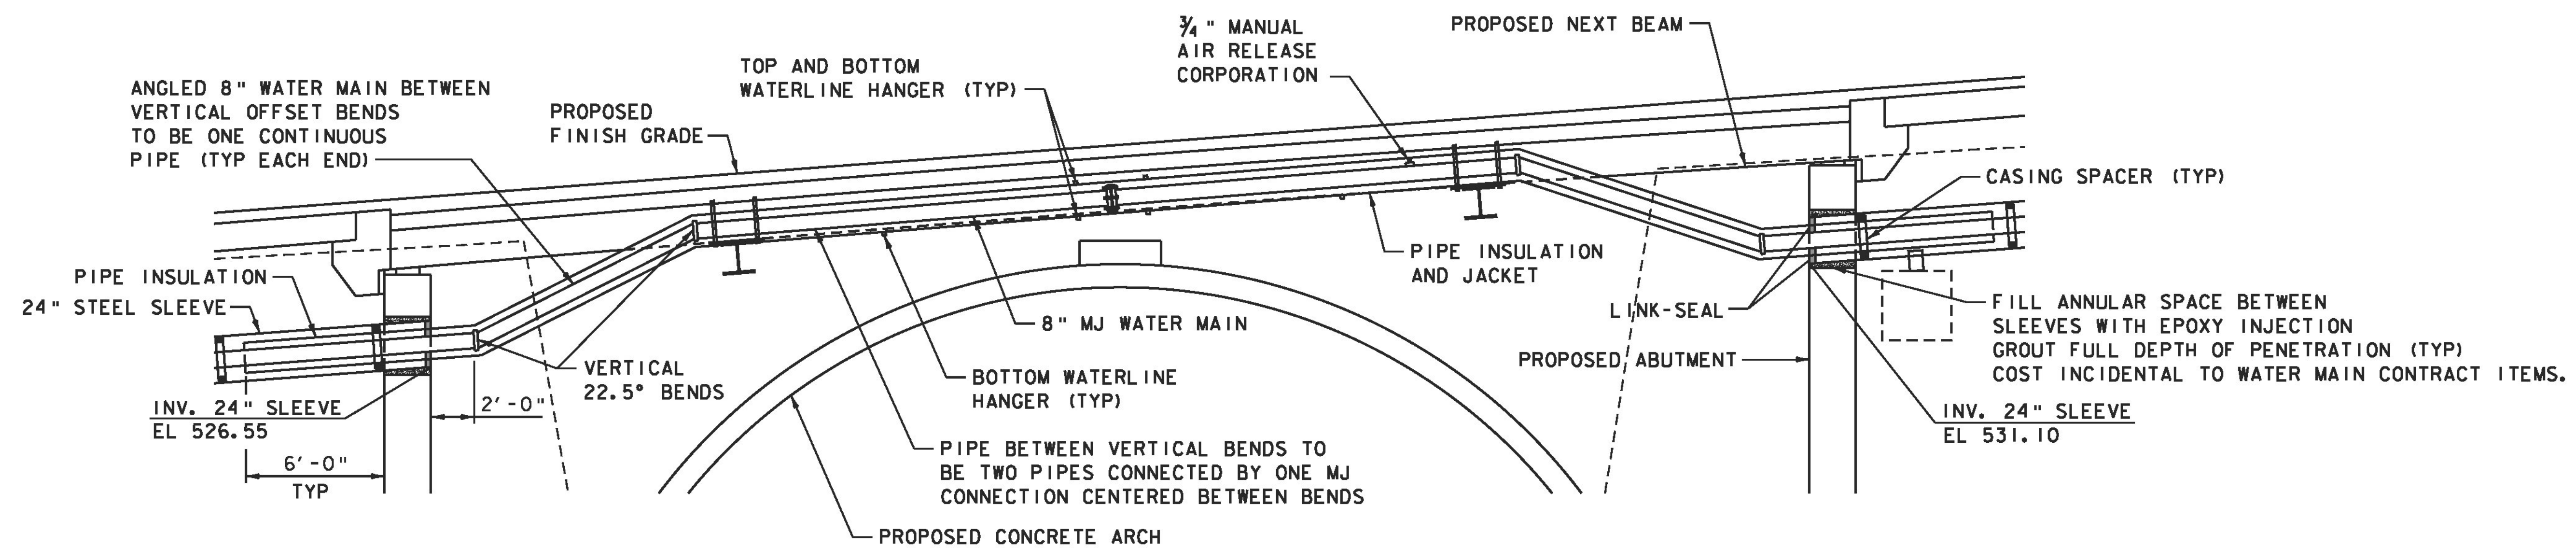

WATER MAIN BRIDGE CROSSING DETAIL

SCALE 1/4" = 1'-0"

PROJECT NAME: MIDDLEBURY

PROJECT NUMBER: RS 0174(8)

FILE NAME: z78f217_wtr.dgn
 PROJECT LEADER: M.A. COLGAN
 DESIGNED BY: T. GINGRAS
 WATERLINE DETAILS (1 OF 2)

PLOT DATE: 8/27/2013
 DRAWN BY: B.J. MASSE
 CHECKED BY: M.J. LEO
 SHEET 32 OF 104

