


PLAN
SCALE 1" = 10'-0"

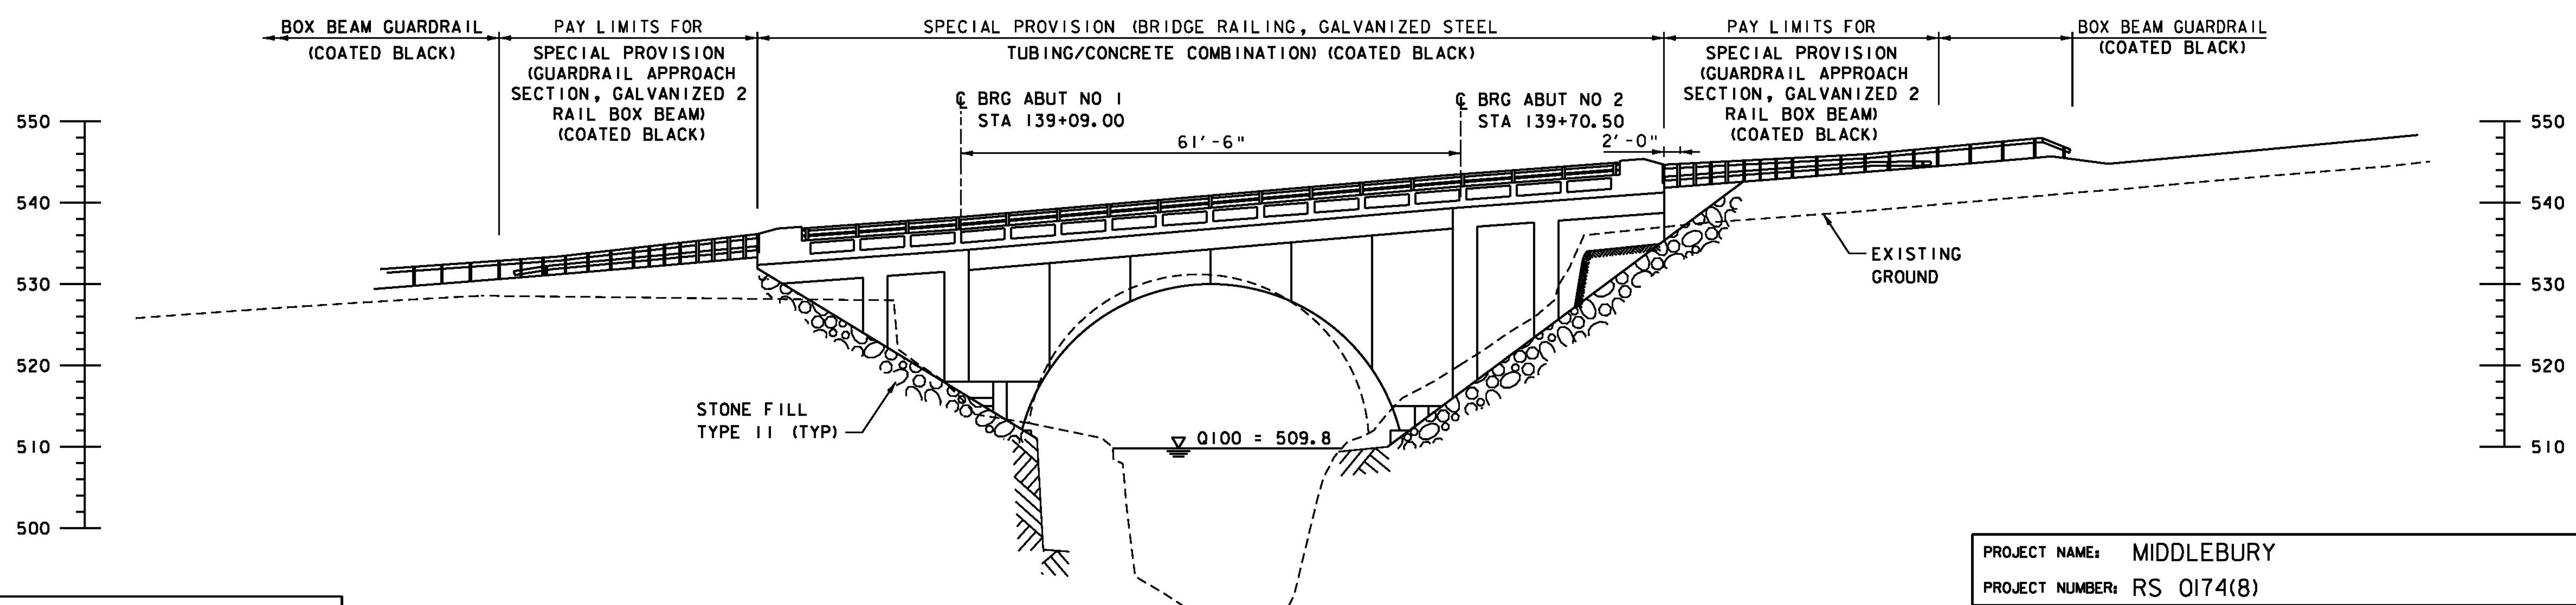

ELEVATION AT DOWNSTREAM FASCIA
SCALE 1" = 10'-0"

DATUM
VERTICAL NAVD 88
HORIZONTAL NAD 83 (92)



PROJECT NAME: MIDDLEBURY
PROJECT NUMBER: RS 0174(8)
FILE NAME: z78f217pe.dgn
PROJECT LEADER: M.A. COLGAN
DESIGNED BY: G.S. GOODRICH
PLAN AND ELEVATION (BRIDGE)
PLOT DATE: 8/27/2013
DRAWN BY: B.J. MASSE
CHECKED BY: G.S. GOODRICH
SHEET 46 OF 104