


FLANGE CONNECTION DETAILS
SCALE 1/2" = 1'-0"

= SPECIAL PROVISION
(HIGH PERFORMANCE CONCRETE, RAPID SET)

- * DIMENSIONS ARE TO KEY IN JOINT
** FOUR #4 BARS SHALL BE PLACED AS SHOWN ALONG
ENTIRE LENGTH OF JOINT. PAYMENT SHALL BE
INCIDENTAL TO SPECIAL PROVISION
(PRESTRESSED CONCRETE NEXT D BEAMS) (NEXT 28D)

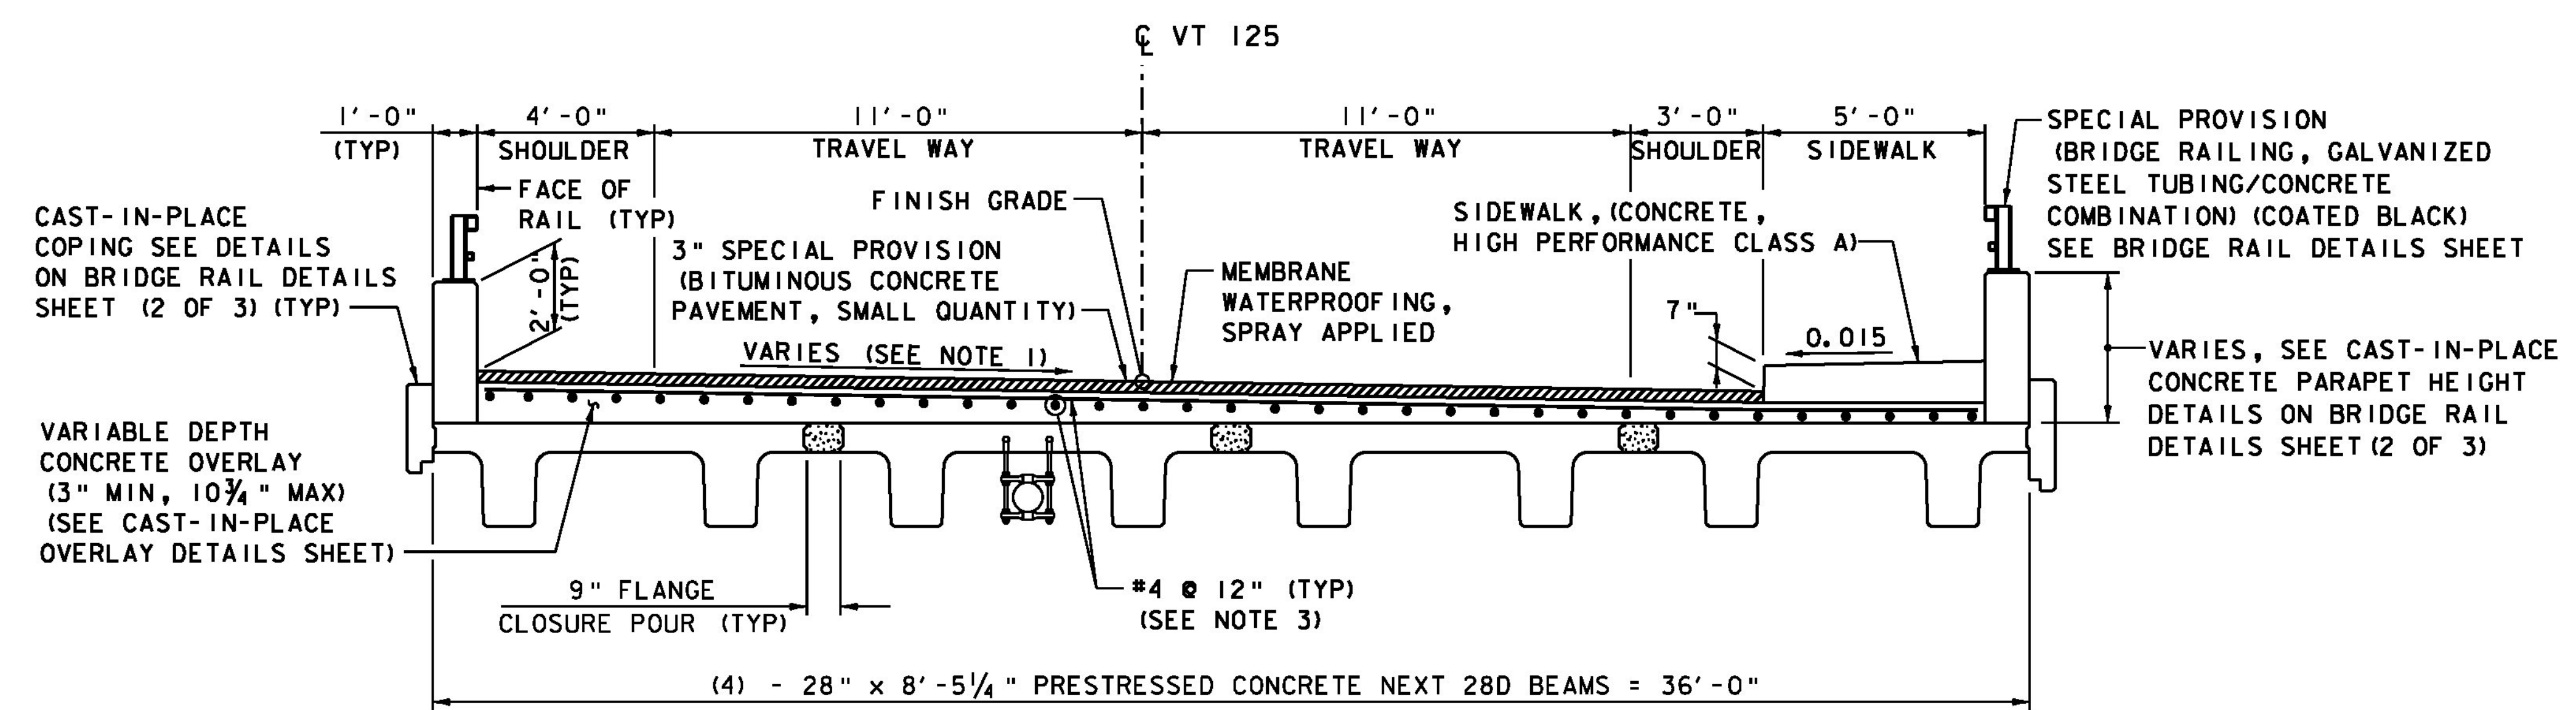

- NOTES:**
- CROSS SLOPE VARIES, SEE BANKING DIAGRAM ON
PROFILE AND BANKING DIAGRAM SHEET (1 OF 2).
 - SEE TYPICAL BRIDGE SECTION SHEET FOR
ADDITIONAL DIMENSIONING.
 - REINFORCING IN CAST-IN-PLACE OVERLAY SHALL FOLLOW
THE SUPERELEVATION OF THE BRIDGE.

PROJECT NAME: MIDDLEBURY	PLOT DATE: 8/27/2013
PROJECT NUMBER: RS 0174(8)	DRAWN BY: B.J. MASSE
FILE NAME: z78f217sup.dgn	CHECKED BY: G.S. GOODRICH
PROJECT LEADER: M.A. COLGAN	SHEET 47 OF 104
DESIGNED BY: K.G. KRETSCH	
FRAMING PLAN	

