



NOTE: TYPICAL REINFORCING BARS IN FLANGE OMITTED FOR CLARITY
ADDITIONAL END BEAM REINFORCING
LONGITUDINAL SECTION
 SCALE 1/2" = 1'-0"

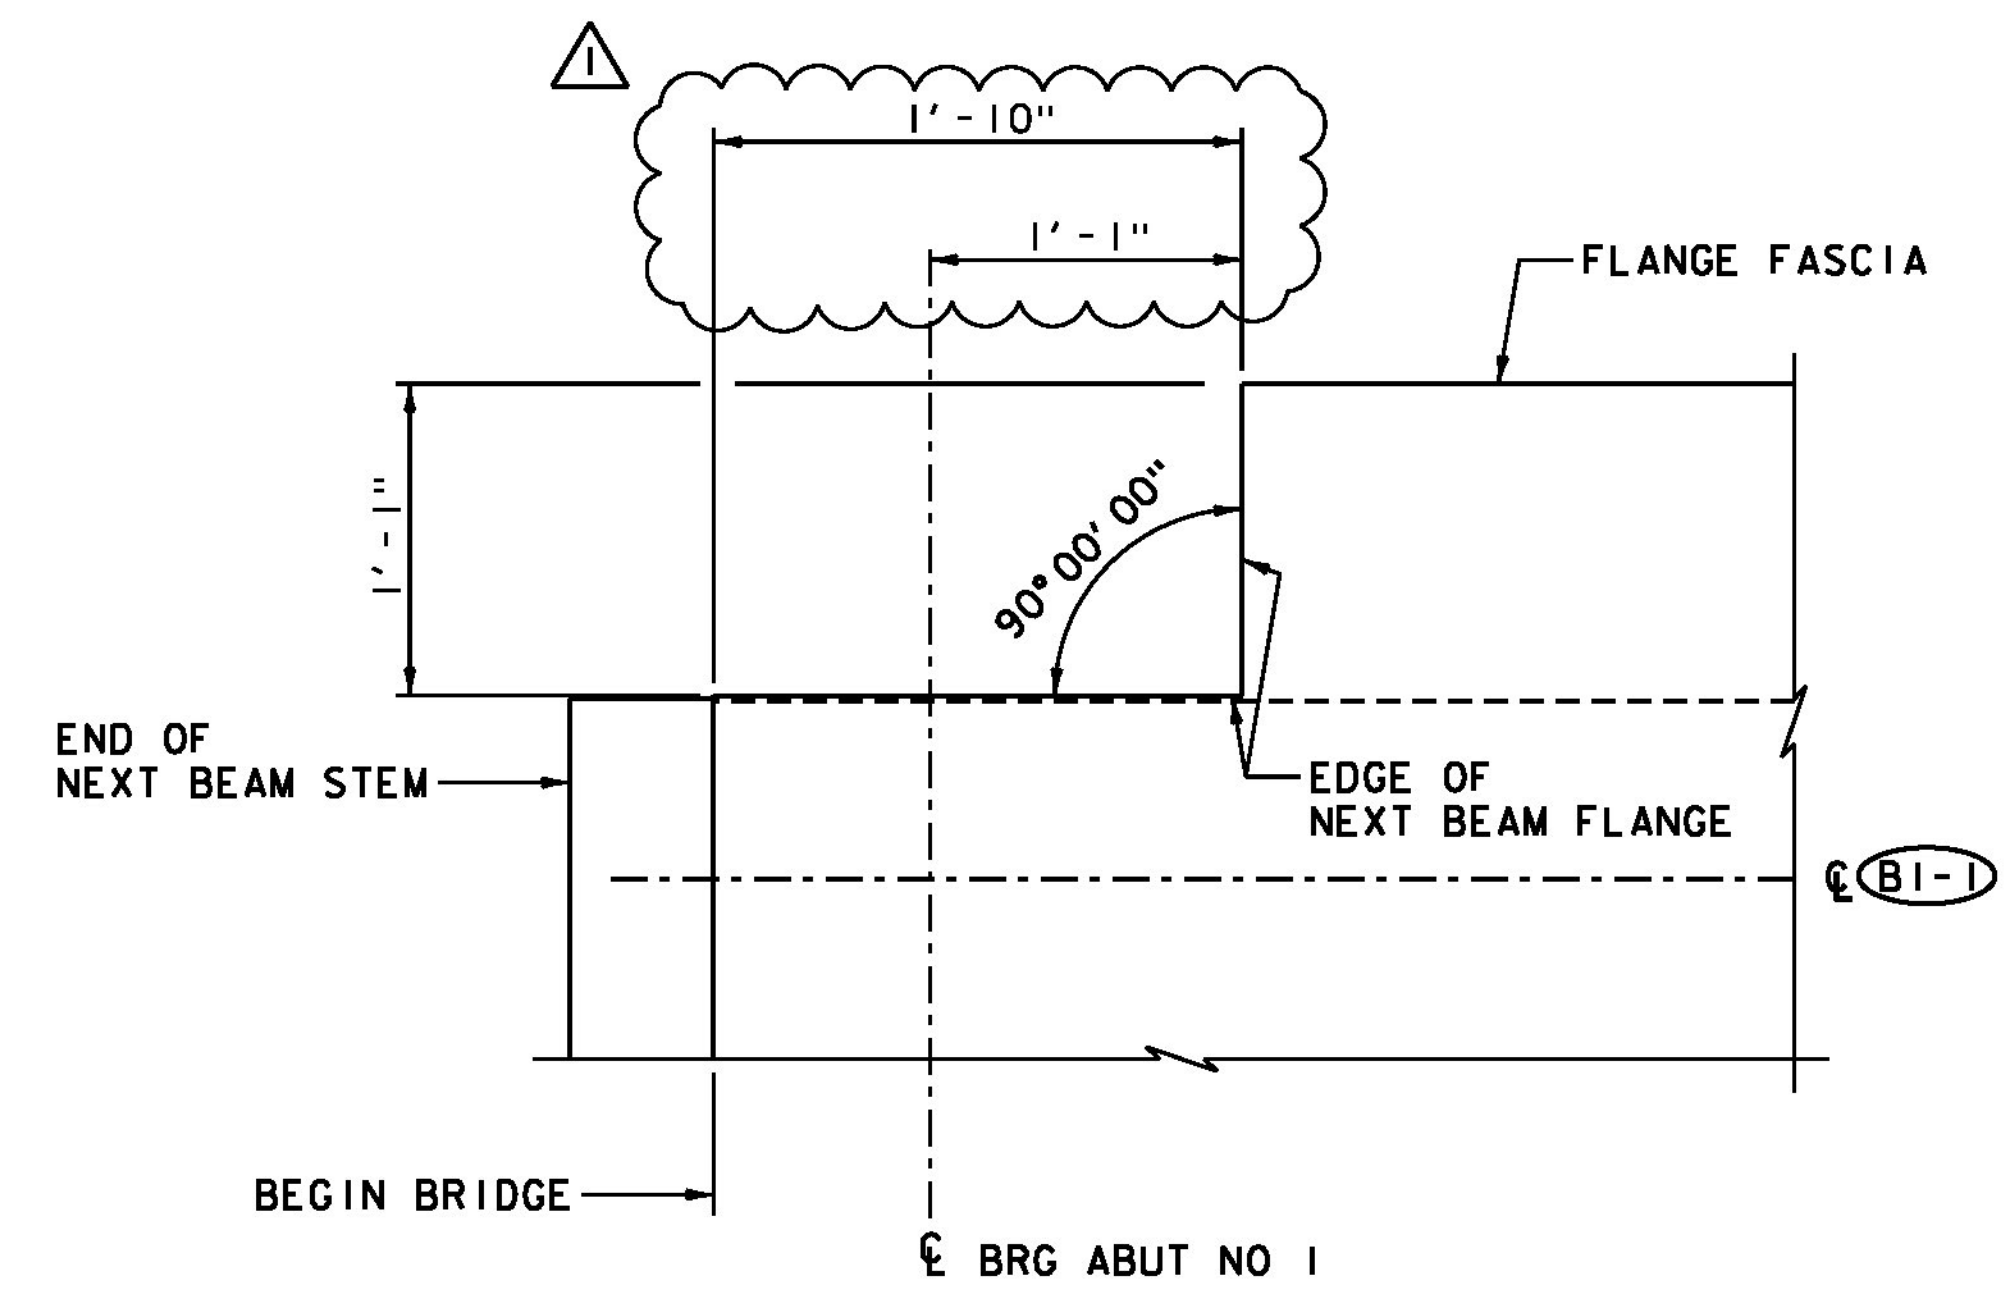

FLANGE CLIP DETAIL A
 (NEXT BEAM 1 AT ABUTMENT NO 1 SHOWN,
 NEXT BEAM 1 AT ABUTMENT NO 2 AND NEXT BEAM 4 AT ABUTMENT NO 2 SIMILAR)
 SCALE 1/2" = 1'-0"

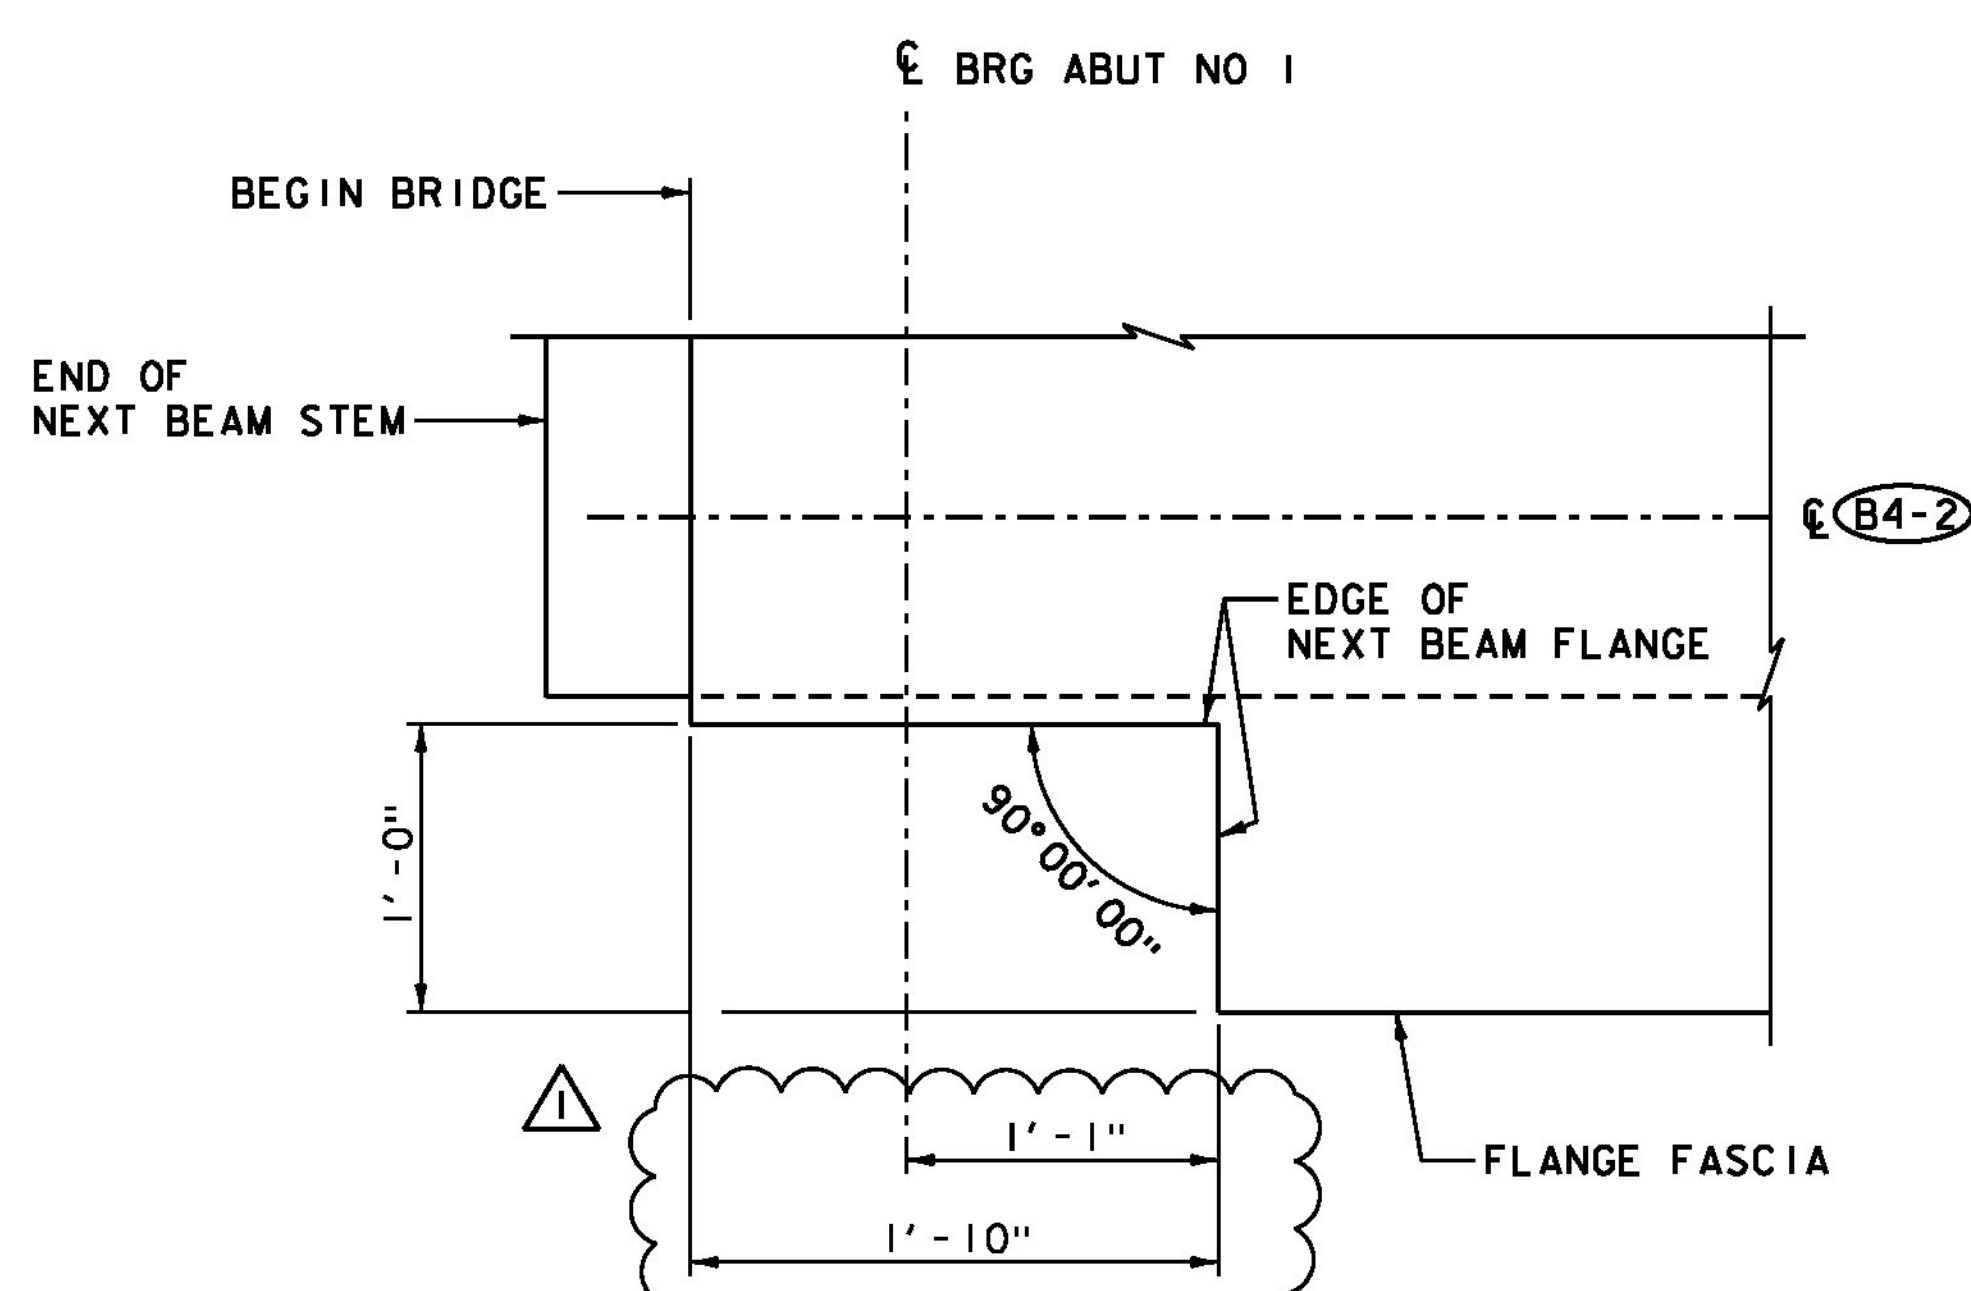

FLANGE CLIP DETAIL B
 (NEXT BEAM 4 AT ABUTMENT NO 1)
 SCALE 1/2" = 1'-0"

REVISION: EDGE OF NEXT BEAM FLANGE DIMENSION, NOVEMBER 4, 2013

PROJECT NAME:	MIDDLEBURY
PROJECT NUMBER:	RS 0174(8)
FILE NAME:	z78f217sup.dgn
PROJECT LEADER:	M.A. COLGAN
DESIGNED BY:	K.G. KRETSCH
NEXT BEAM DETAILS (2 OF 3)	
PLOT DATE:	11/4/2013
DRAWN BY:	K.D. WENTWORTH
CHECKED BY:	G.S. GOODRICH
SHEET	49 OF 104

