


**PRECAST CONCRETE CURTAIN WALL
REINFORCING TYPICAL**

SCALE 1 1/2" = 1'-0"


■ = LIMITS OF PRECAST CONCRETE CURTAIN WALL

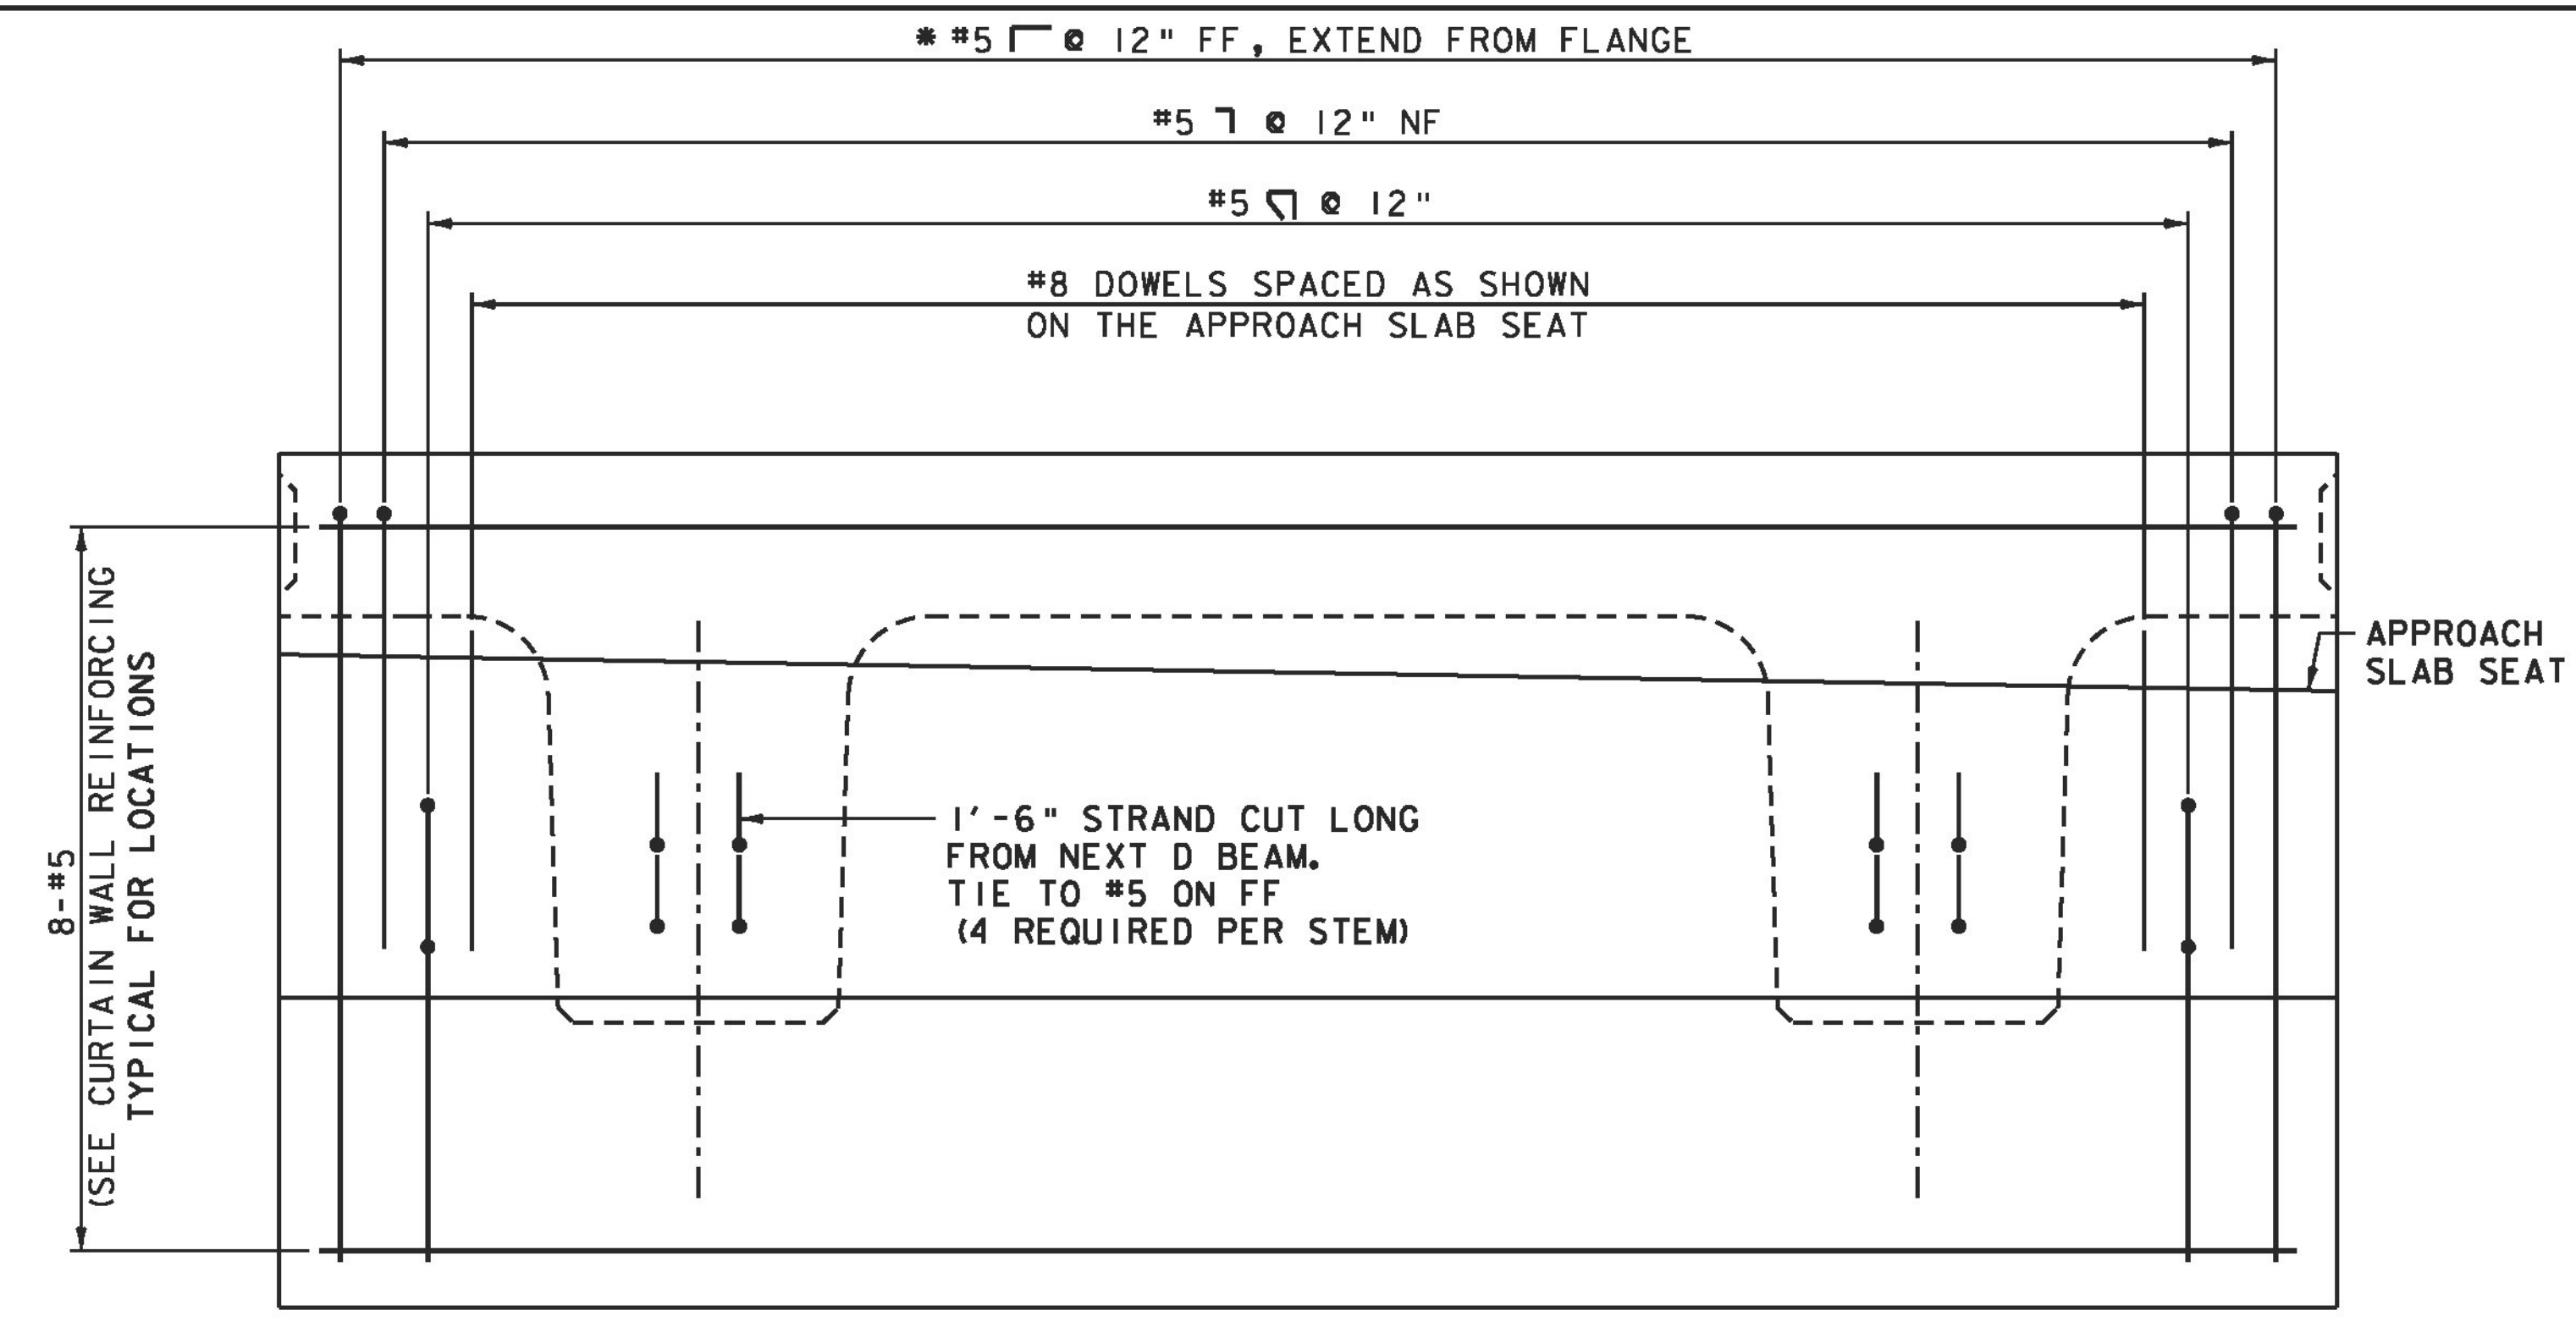

**PRECAST CONCRETE CURTAIN WALL
REINFORCING ELEVATION**

SCALE 1 1/2" = 1'-0"

* 12 ADDITIONAL BARS SHALL BE USED AT THE JOINT LOCATIONS. PAYMENT SHALL BE INCIDENTAL TO ITEM 900.640 SPECIAL PROVISION (PRESTRESSED CONCRETE NEXT D BEAMS) (NEXT 28D).

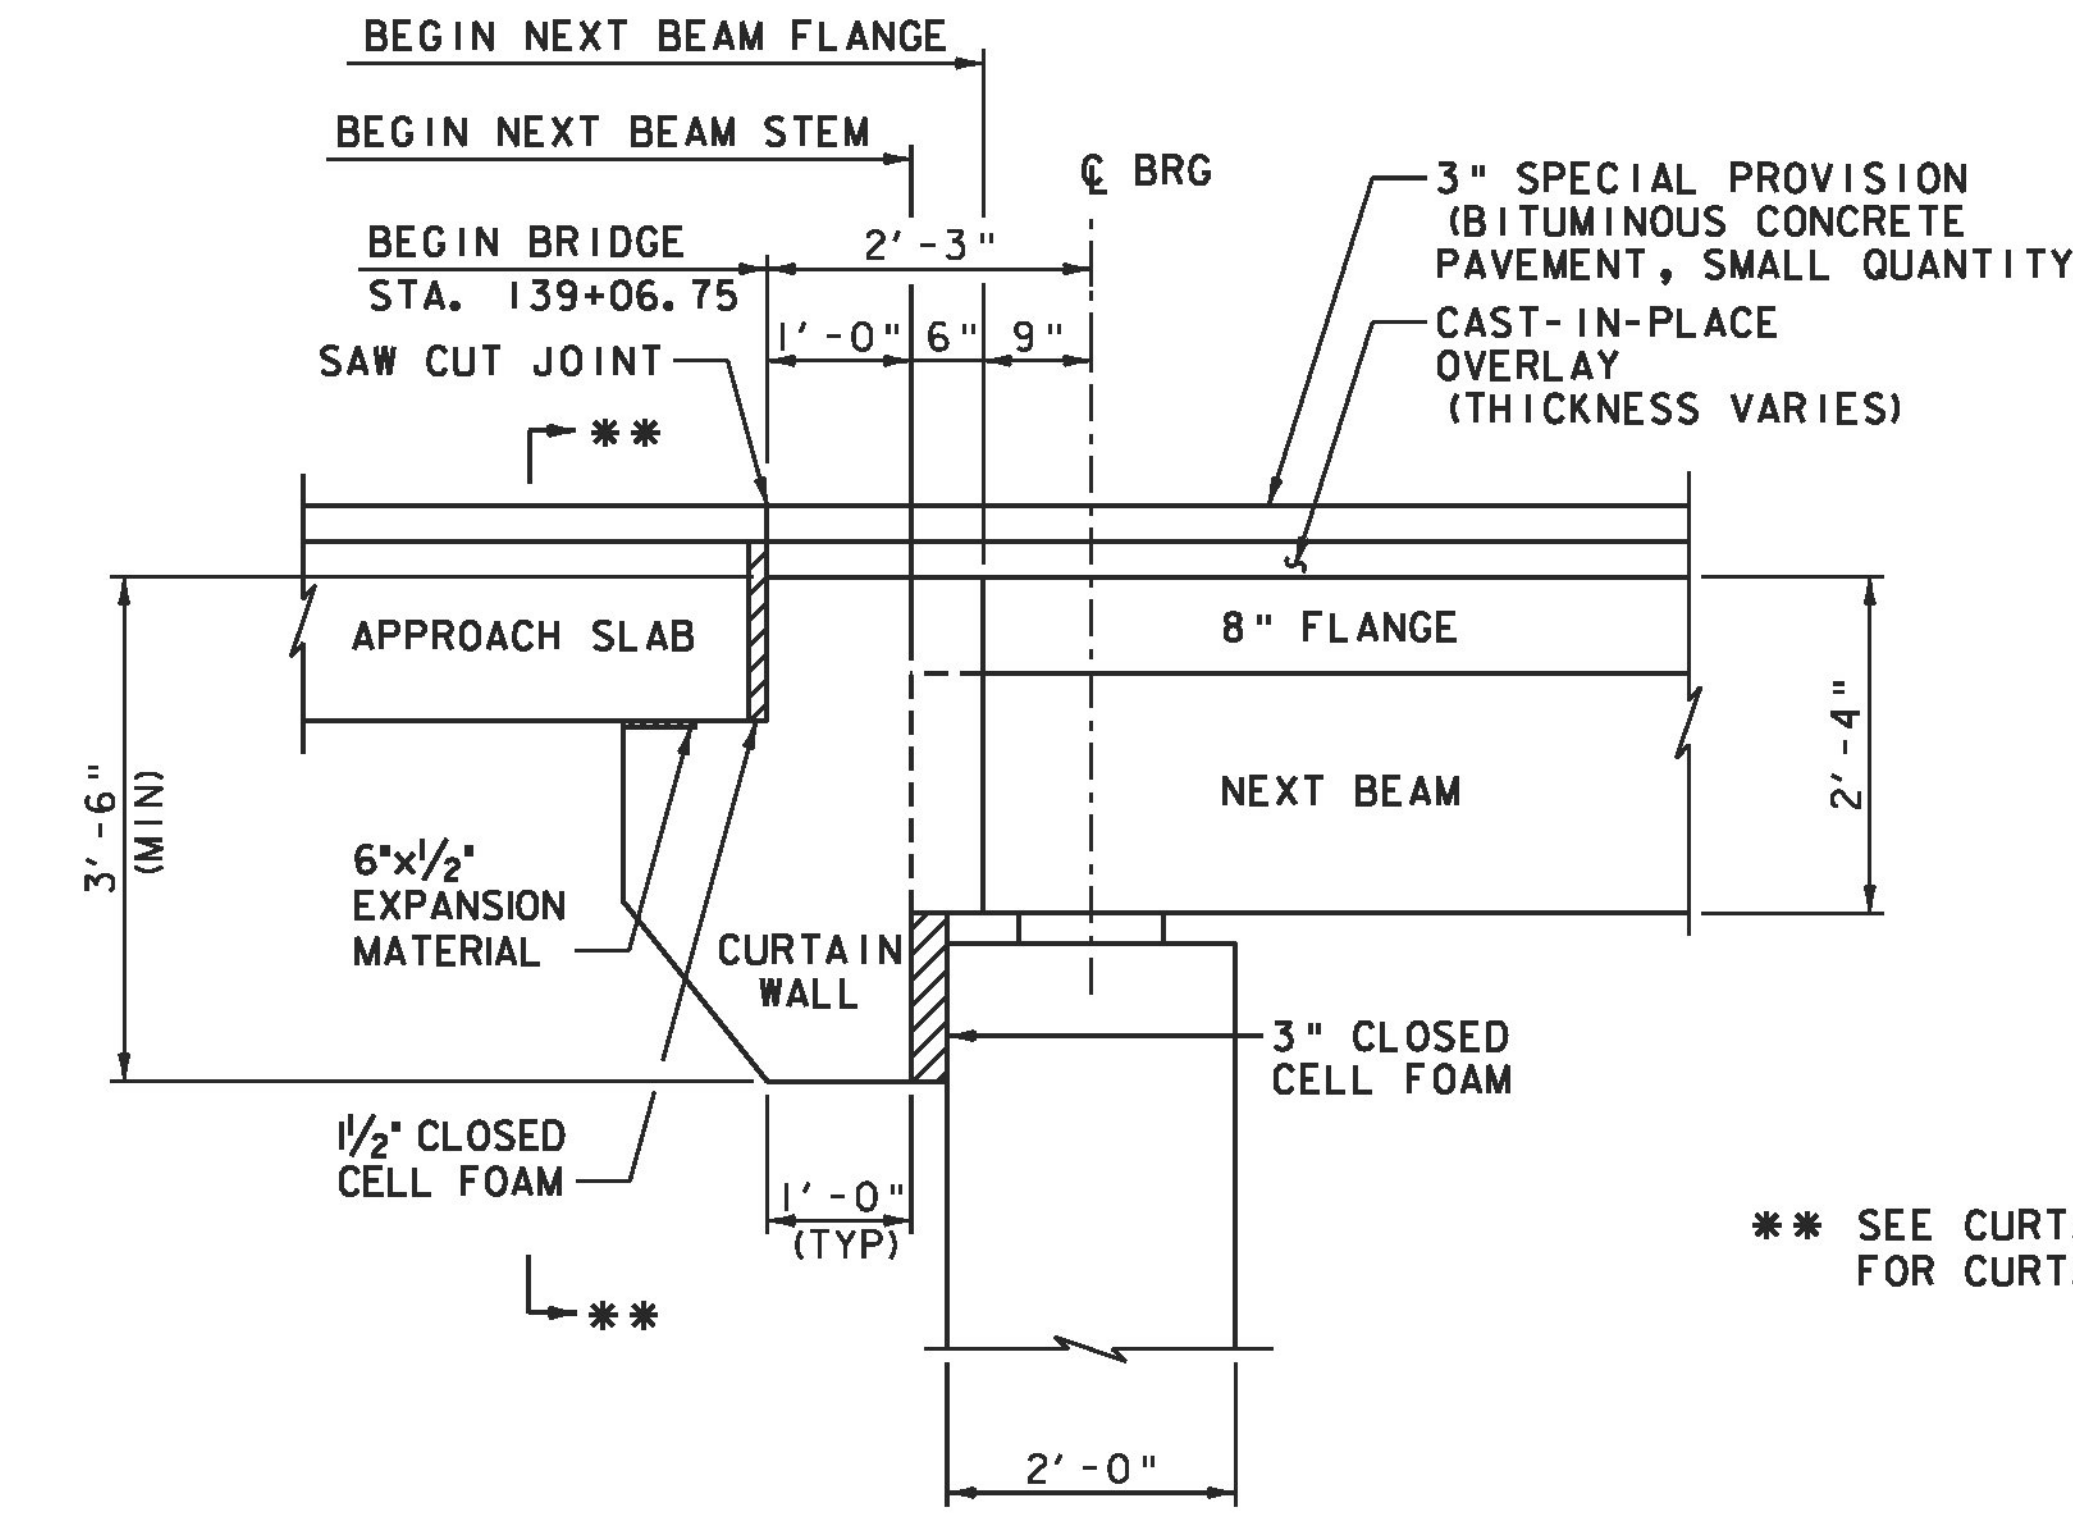

BRIDGE END DETAIL

(ABUT NO 1 SHOWN, ABUT NO 2 SIMILAR, OPPOSITE HAND)

SCALE 3/4" = 1'-0"

** SEE CURTAIN WALL DETAILS SHEET (2 OF 2) FOR CURTAIN WALL END VIEWS

NOTE:
 NF = NEAR FACE
 FF = FAR FACE
 EF = EACH FACE
 ▲ = CUT TO FIT IN FIELD
 3" CLEAR, UNLESS OTHERWISE SPECIFIED ON THE PLANS.
 2'-2" BAR LAP UNLESS OTHERWISE SPECIFIED ON THE PLANS.

| | |
|----------------------------|----------------|
| PROJECT NAME: | MIDDLEBURY |
| PROJECT NUMBER: | RS 0174(8) |
| FILE NAME: | z78f217sub.dgn |
| PROJECT LEADER: | M.A. COLGAN |
| DESIGNED BY: | K.G. KRETSCH |
| NEXT BEAM DETAILS (3 OF 3) | |
| PLOT DATE: | 8/27/2013 |
| DRAWN BY: | K.D. WENTWORTH |
| CHECKED BY: | G.S. GOODRICH |
| SHEET | 50 OF 104 |

