




**ABUTMENT NO 1, NEXT 1**  
SCALE 3/4" = 1'-0"

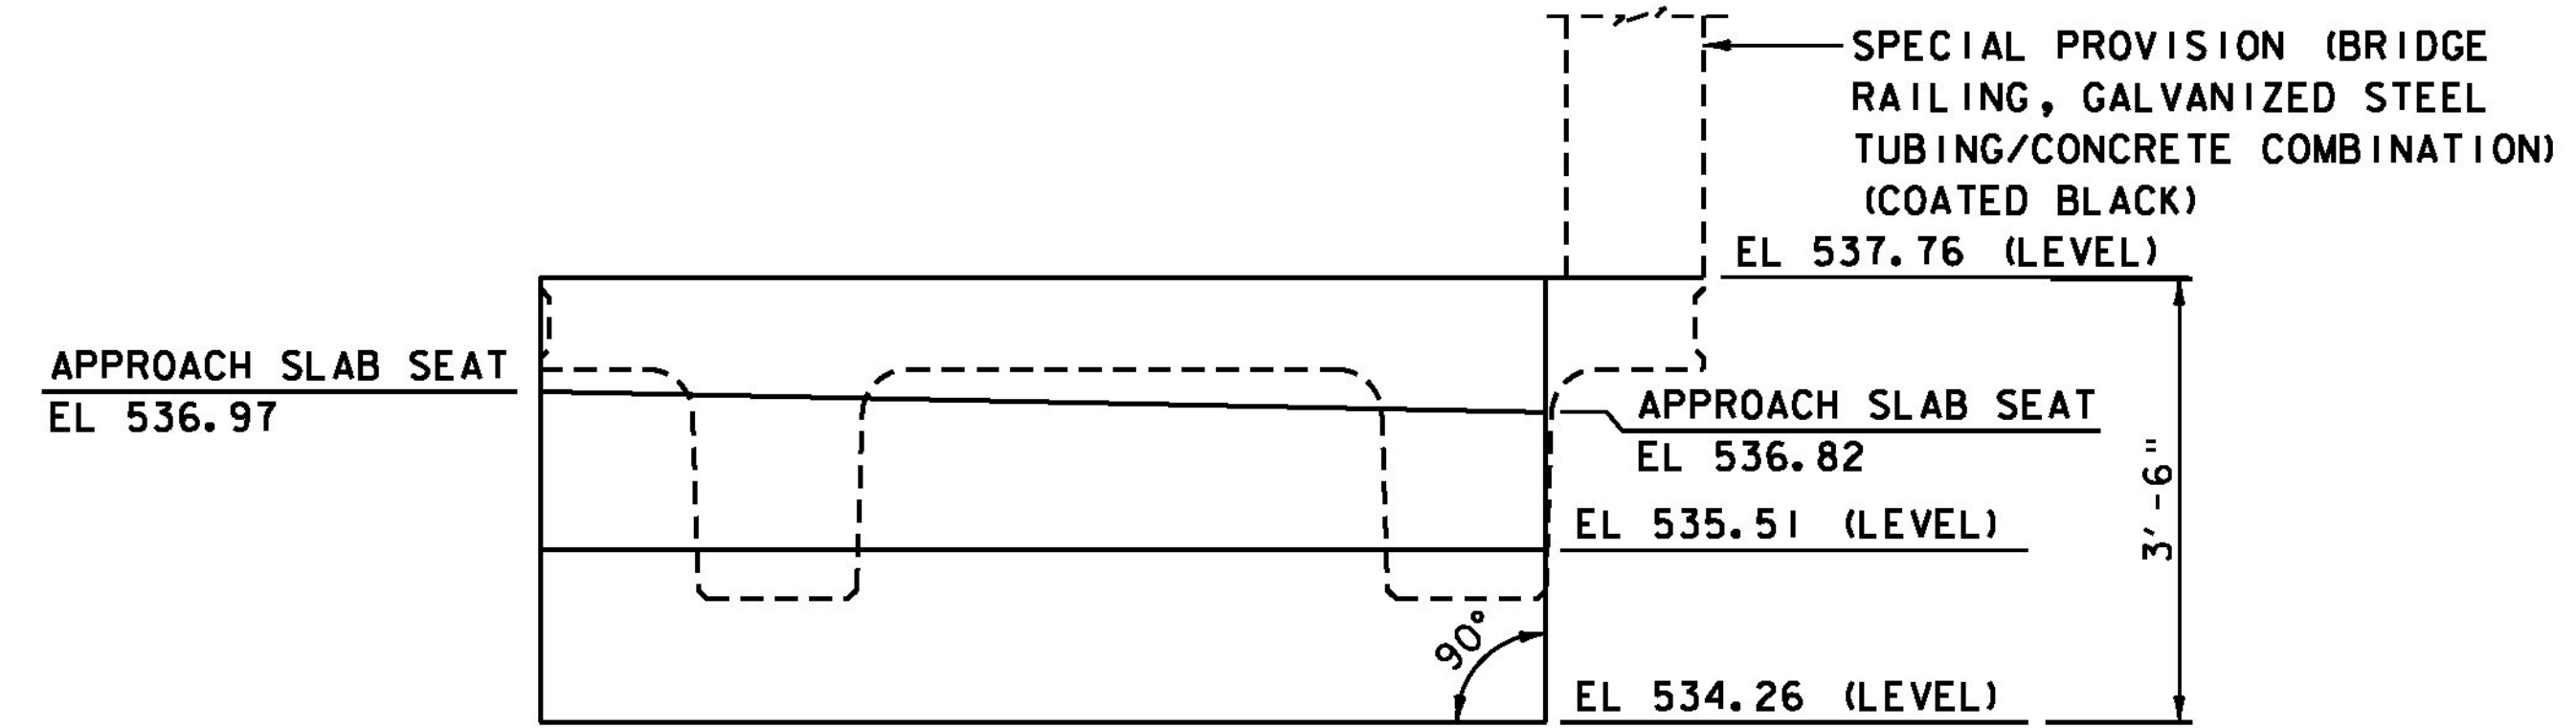


**ABUTMENT NO 2, NEXT 1**  
SCALE 3/4" = 1'-0"

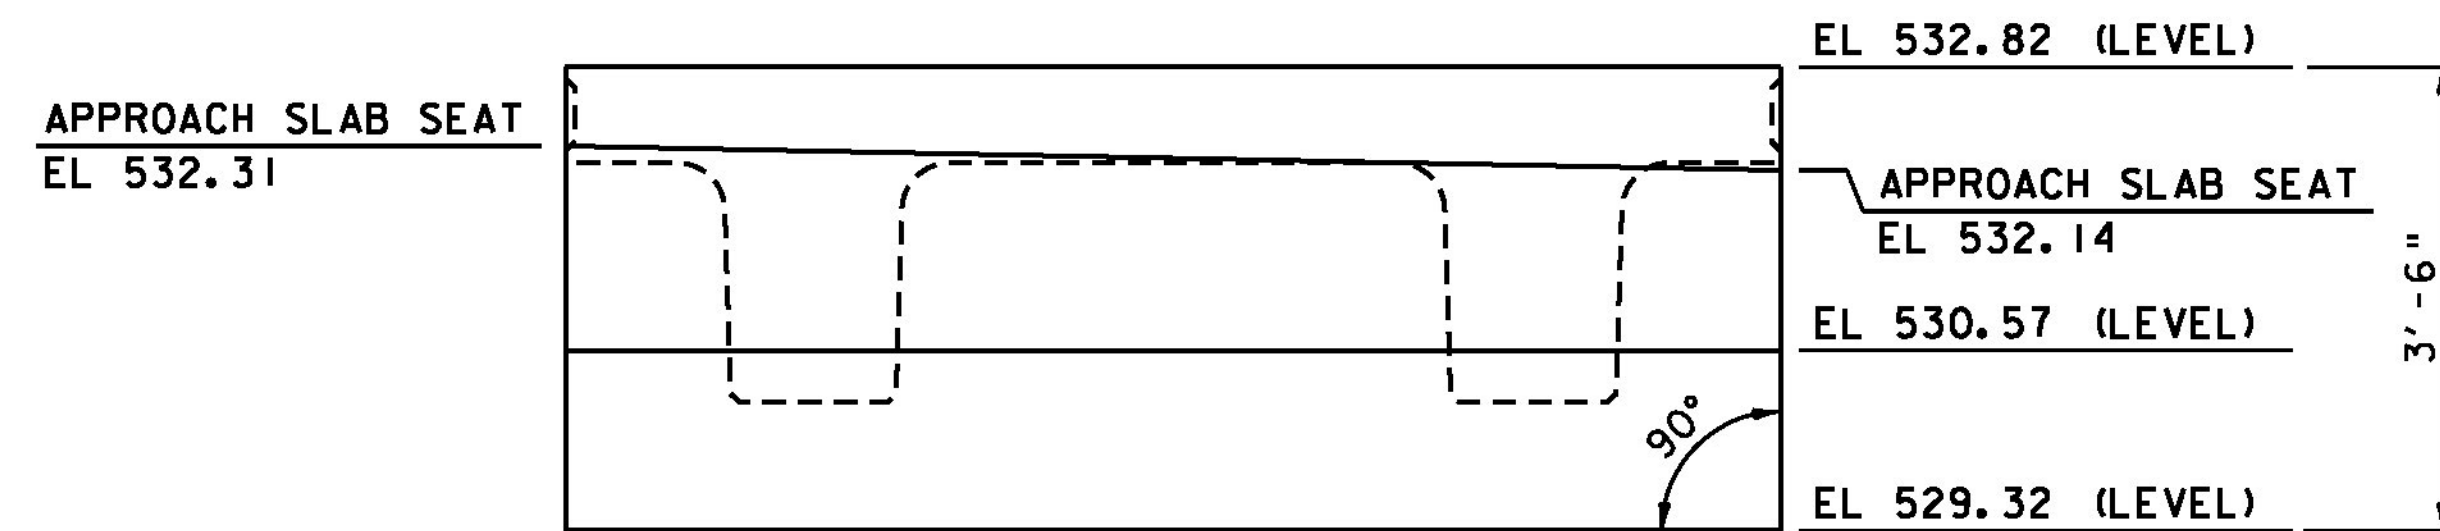


**ABUTMENT NO 1, NEXT 2**  
SCALE 3/4" = 1'-0"

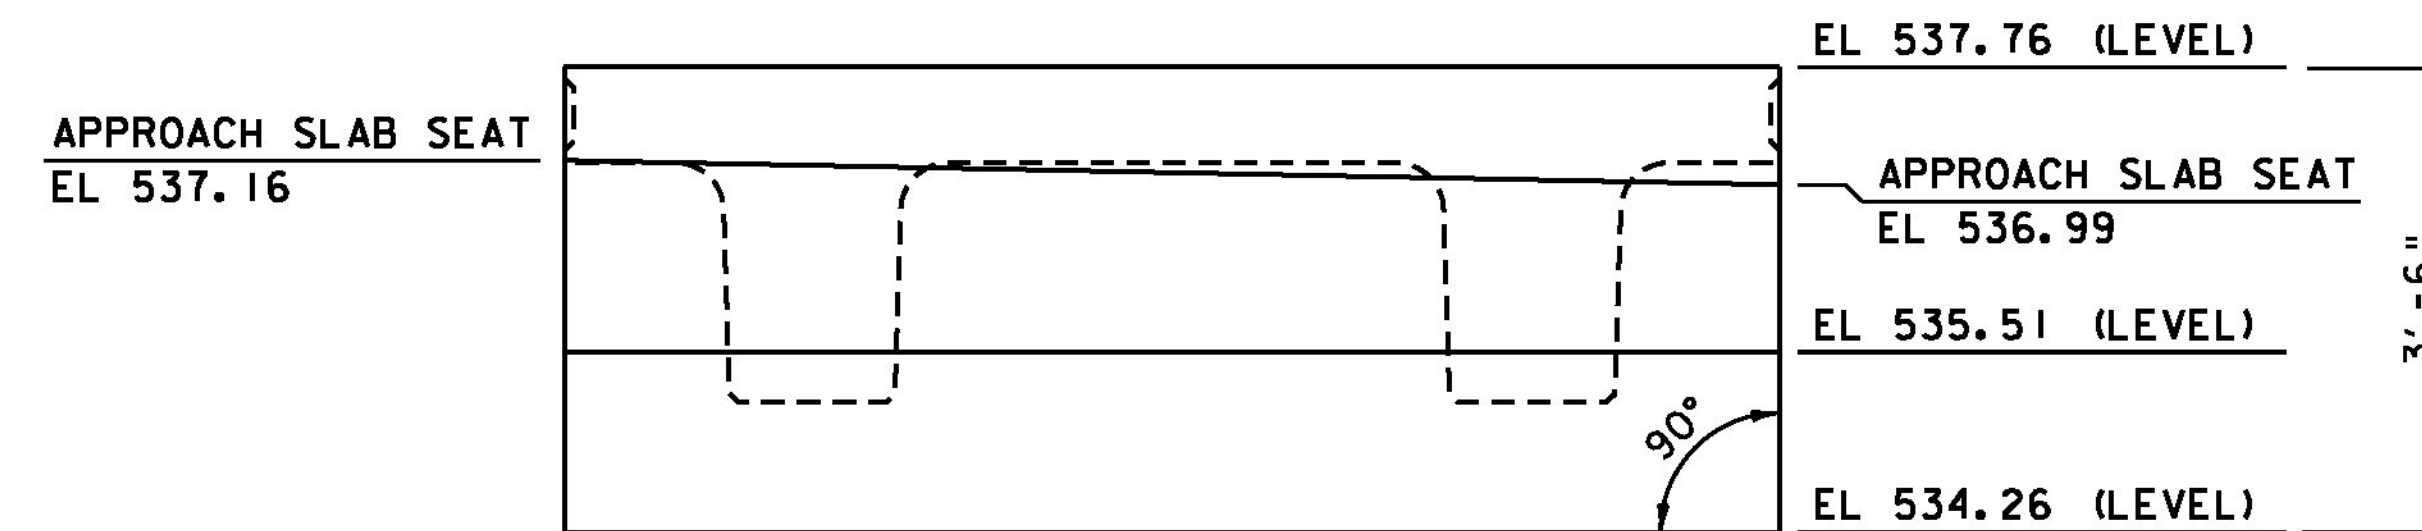


**ABUTMENT NO 2, NEXT 2**  
SCALE 3/4" = 1'-0"

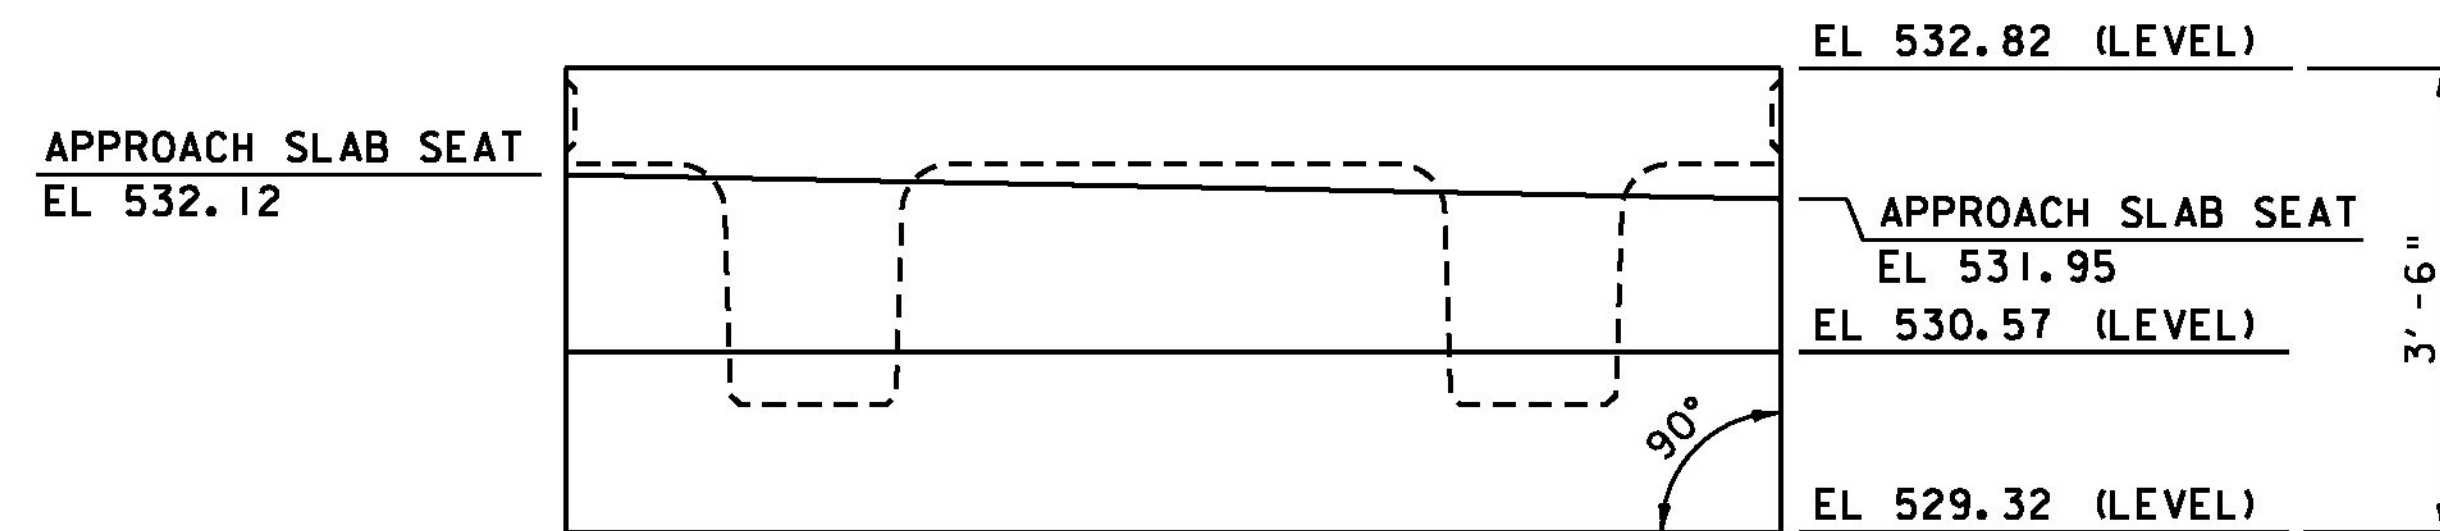


**ABUTMENT NO 1, NEXT 3**  
SCALE 3/4" = 1'-0"

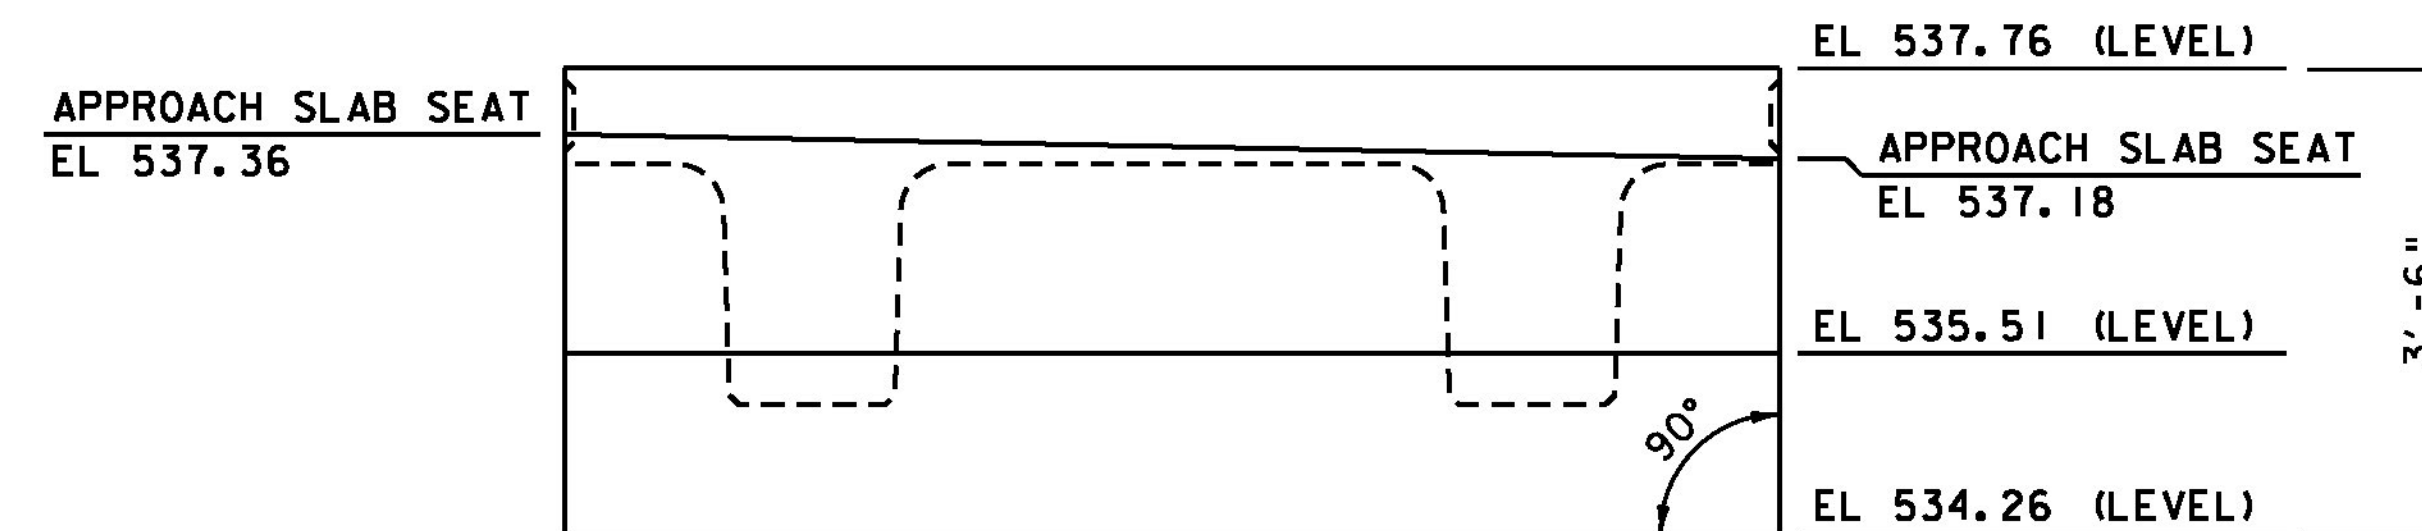

**ABUTMENT NO 2, NEXT 3**  
SCALE 3/4" = 1'-0"

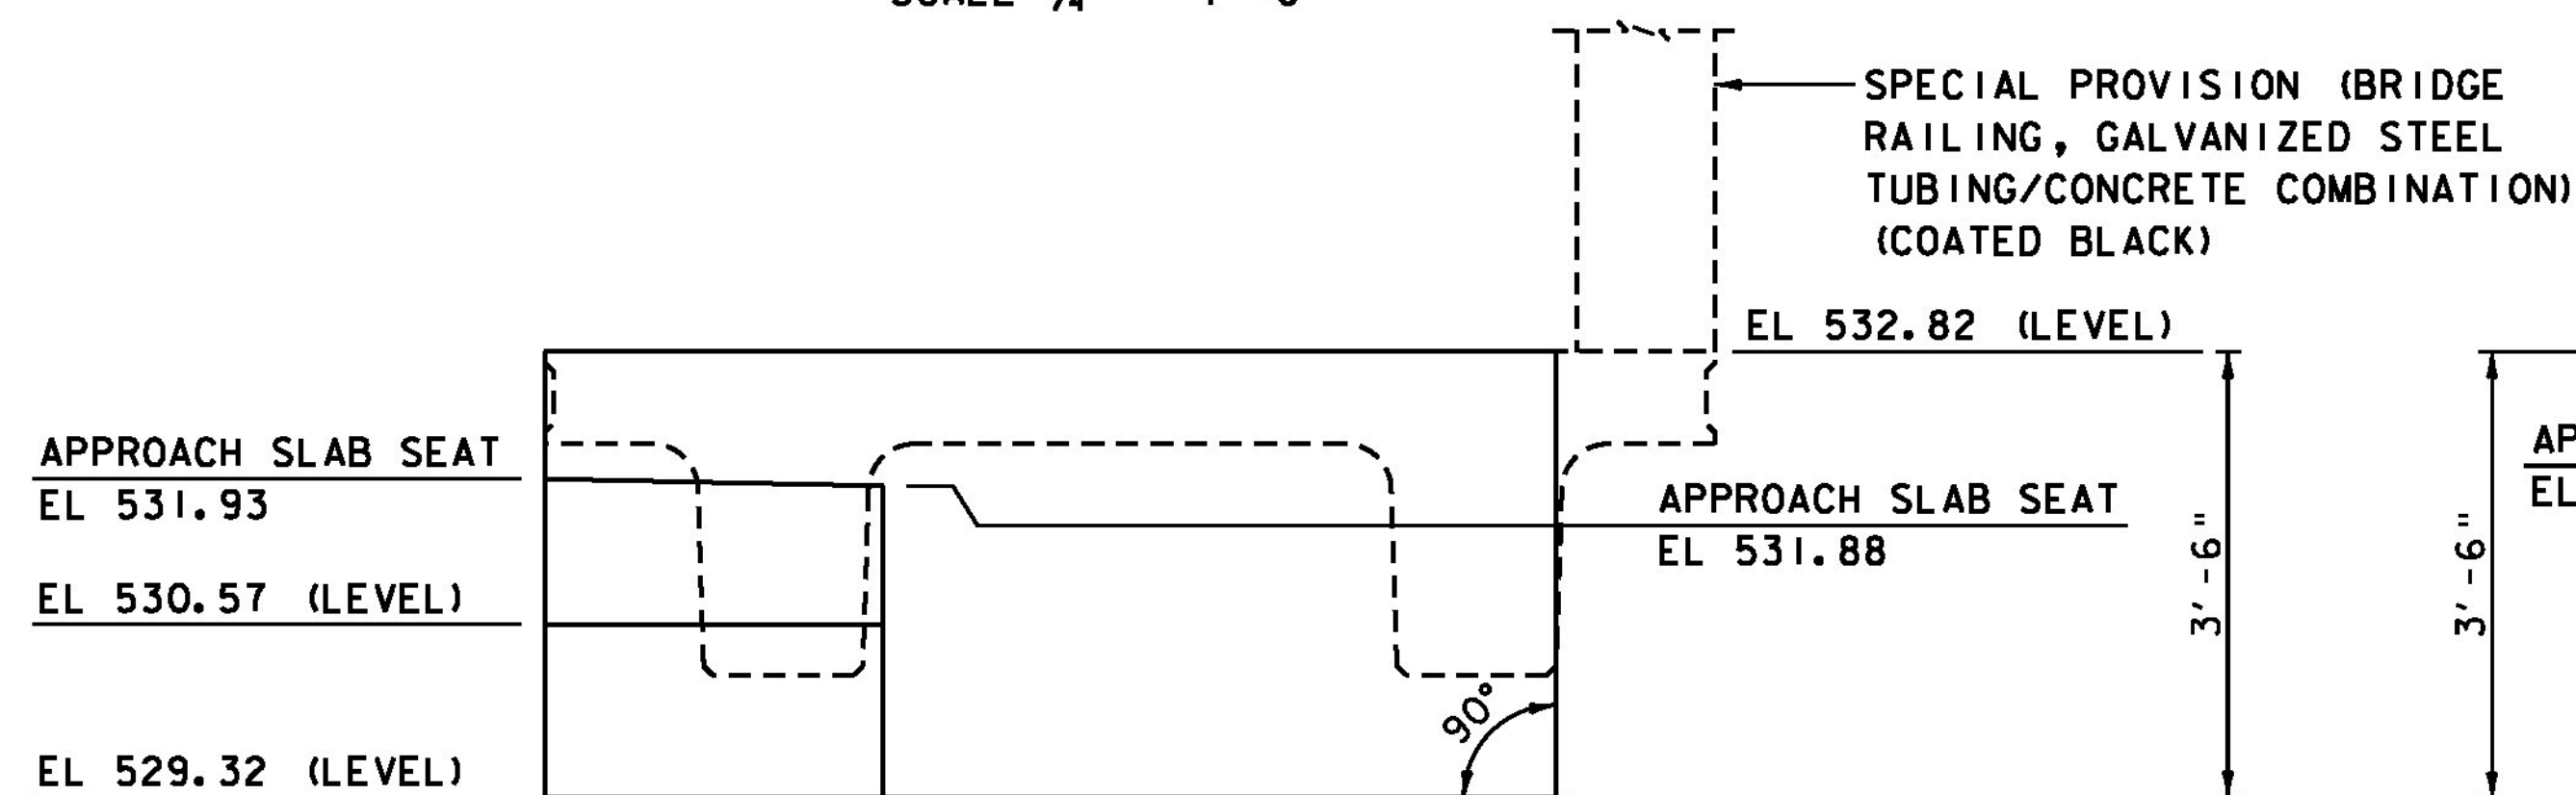

**ABUTMENT NO 1, NEXT 4**  
SCALE 3/4" = 1'-0"

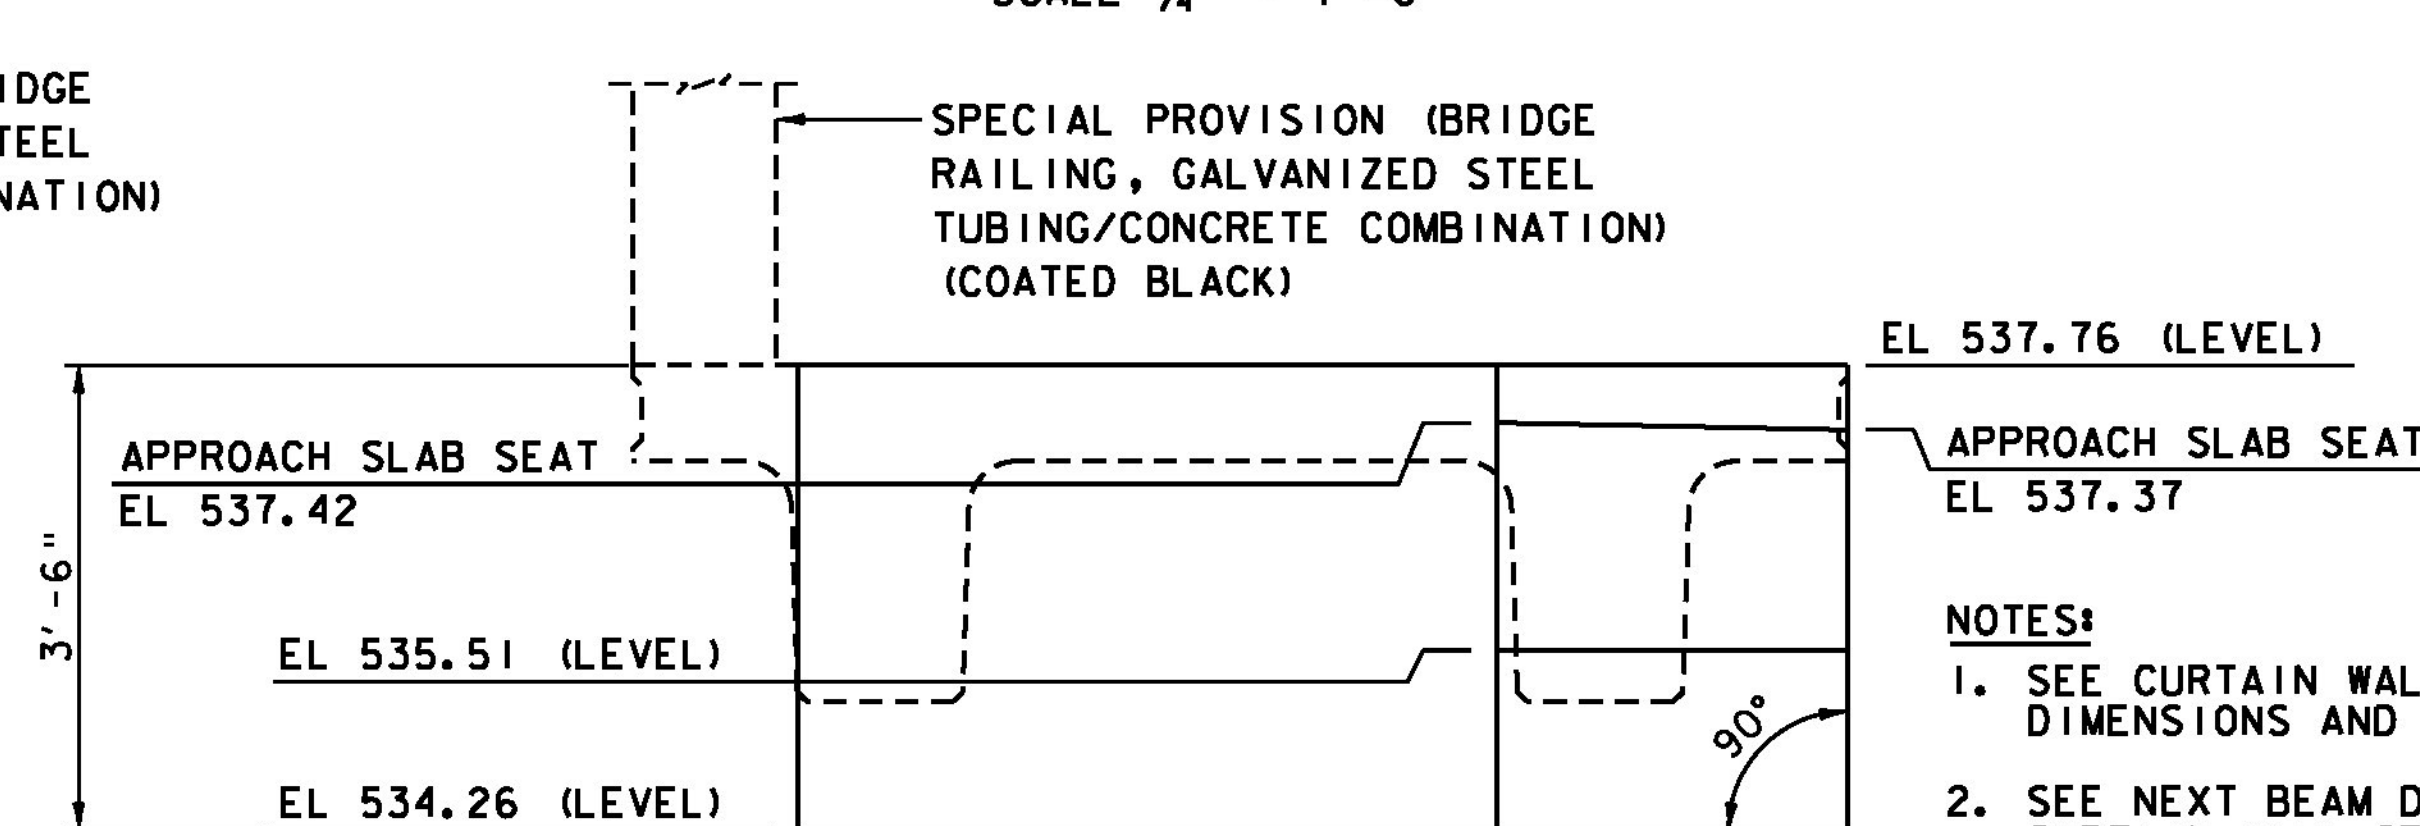

**ABUTMENT NO 2, NEXT 4**  
SCALE 3/4" = 1'-0"

**NOTES:**

1. SEE CURTAIN WALL DETAIL SHEET (1 OF 2) FOR HORIZONTAL DIMENSIONS AND CURTAIN WALL LIMITS.
2. SEE NEXT BEAM DETAILS SHEET (3 OF 3) FOR PRECAST CURTAIN WALL SECTION AND REINFORCING INFORMATION.

PROJECT NAME: MIDDLEBURY

PROJECT NUMBER: RS 0174(8)

FILE NAME: z78f217sup.dgn

PROJECT LEADER: M.A. COLGAN

DESIGNED BY: K.G. KRETSCH

CURTAIN WALL DETAILS (2 OF 2)

PLOT DATE: 8/27/2013

DRAWN BY: K.D. WENTWORTH

CHECKED BY: G.S. GOODRICH

SHEET 52 OF 104