
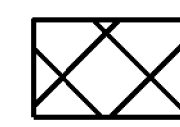


DETAIL A
PRECAST ARCHITECTURAL PANEL
ELEVATION DETAIL AT ARCH FOOTING

(WEST ELEVATION AT ARCH FOOTING NO 1 SHOWN, ALL OTHER FOOTING CORNERS SIMILAR)
 SCALE 1" = 1'-0"

 = LIMITS OF CAST-IN-PLACE PANEL CLOSURE. THICKNESS OF CLOSURE TO MATCH THICKNESS OF ARCHITECTURAL PANELS.

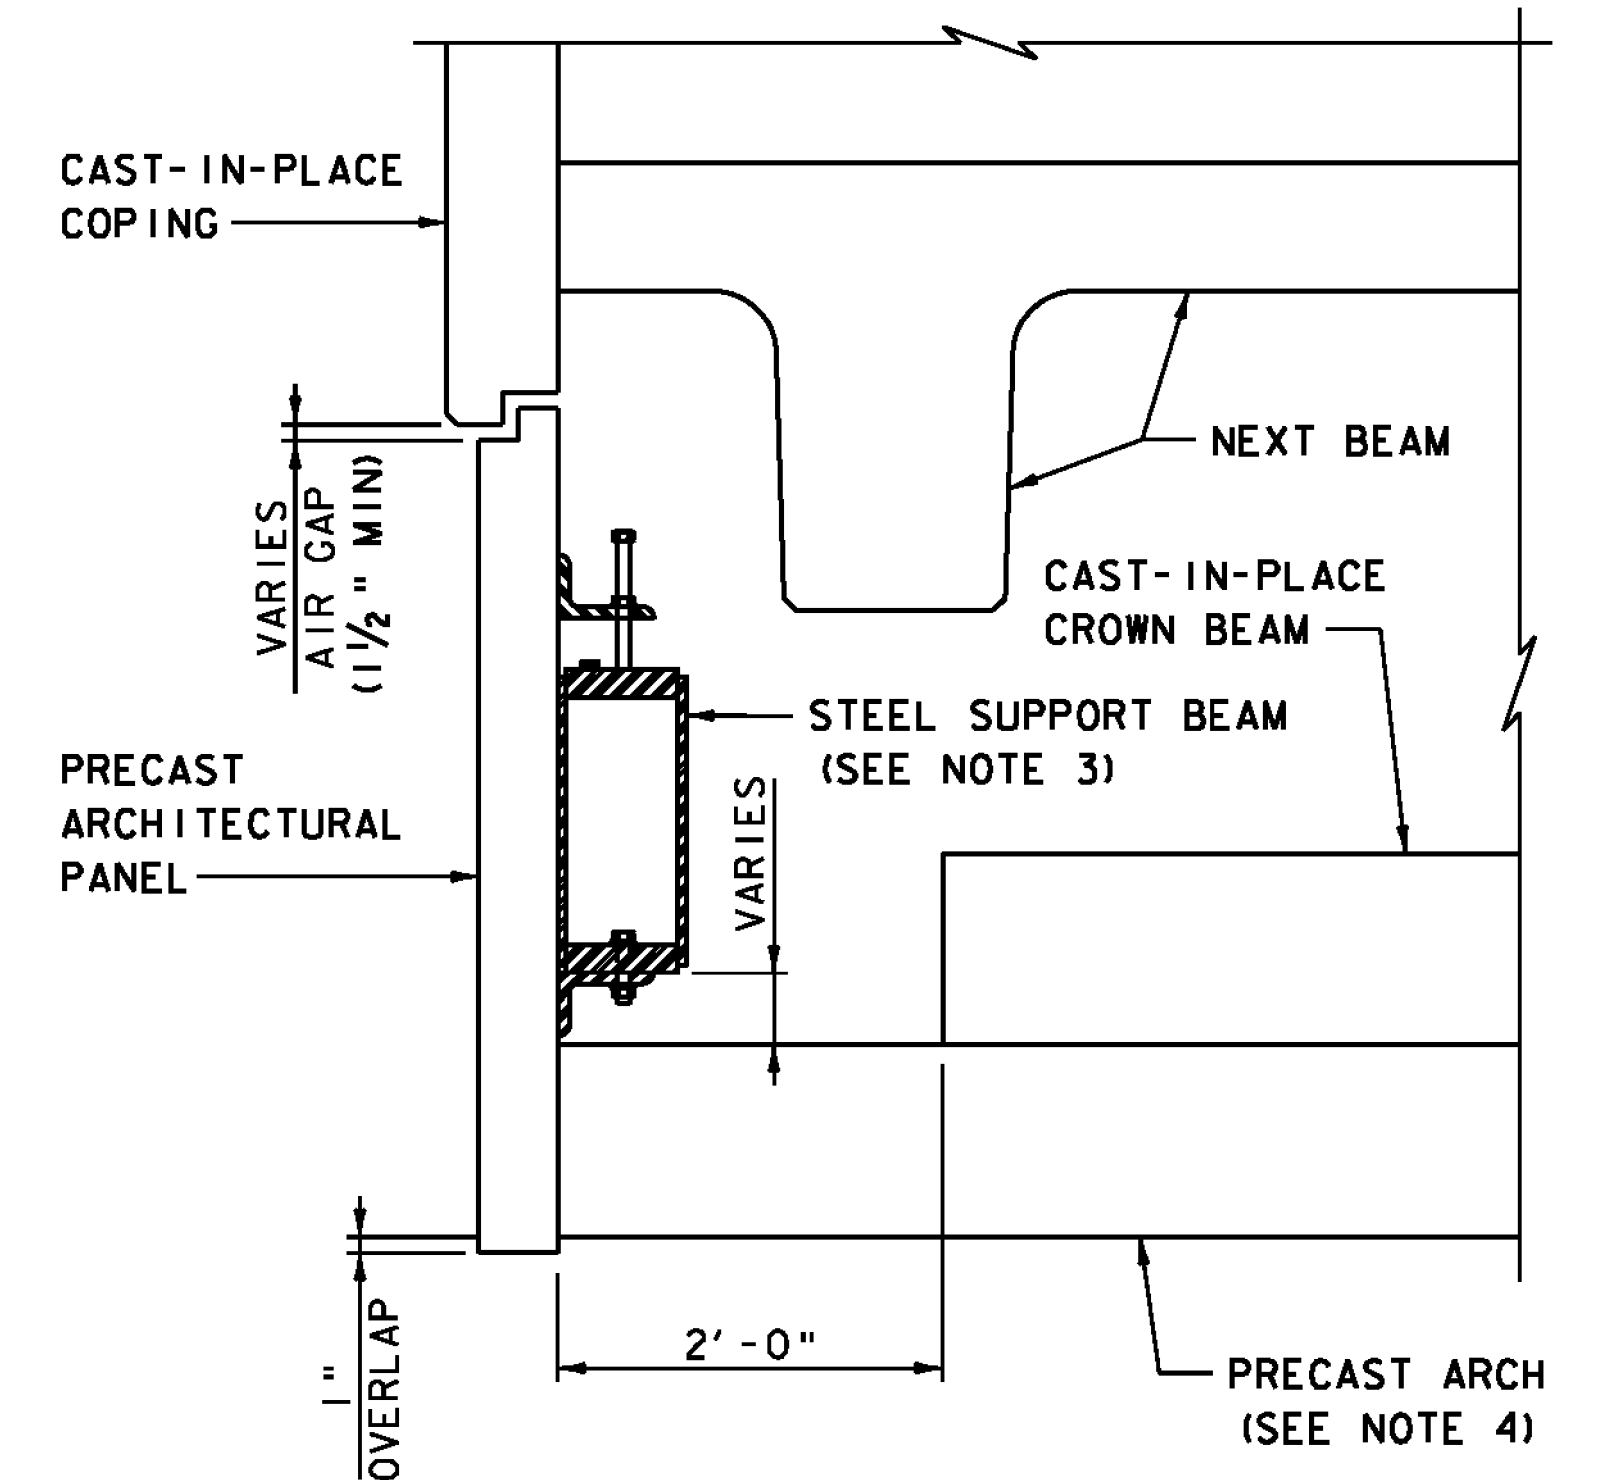

SECTION A-A

(RAILING AND OVERLAY NOT SHOWN FOR CLARITY)
 (REINFORCING STEEL NOT SHOWN FOR CLARITY)
 SCALE 1" = 1'-0"

NOTES:

1. 1" PLASTIC DRAIN TUBES SHALL BE ENCLOSED WITH SCREENS TO PREVENT ACCESS OF VERMIN AND BIRDS. COST FOR DRAIN TUBES WITH SCREENS SHALL BE INCLUDED IN ITEM 501.34, CONCRETE, HIGH PERFORMANCE CLASS B.
2. SEE PRECAST ARCHITECTURAL PANEL DETAILS SHEET (1 OF 2) FOR ADDITIONAL INFORMATION.
3. SEE SUPPORT BEAM DETAILS FOR ADDITIONAL INFORMATION.
4. SEE PRECAST ARCH DETAILS FOR ADDITIONAL INFORMATION.
5. CAST-IN-PLACE PANEL CLOSURE SHALL BE ITEM 501.33 "CONCRETE HIGH PERFORMANCE CLASS A (FPO)".

PROJECT NAME: MIDDLEBURY

PROJECT NUMBER: RS 0174(8)

FILE NAME: z78f217panel.dgn

PLOT DATE: 8/27/2013

PROJECT LEADER: M.A. COLGAN

DRAWN BY: B.J. MASSE

DESIGNED BY: K.G. KRETSCH

CHECKED BY: G.S. GOODRICH

PRECAST ARCHITECTURAL PANEL DETAILS (2 OF 2) SHEET 75 OF 104

