




136+00

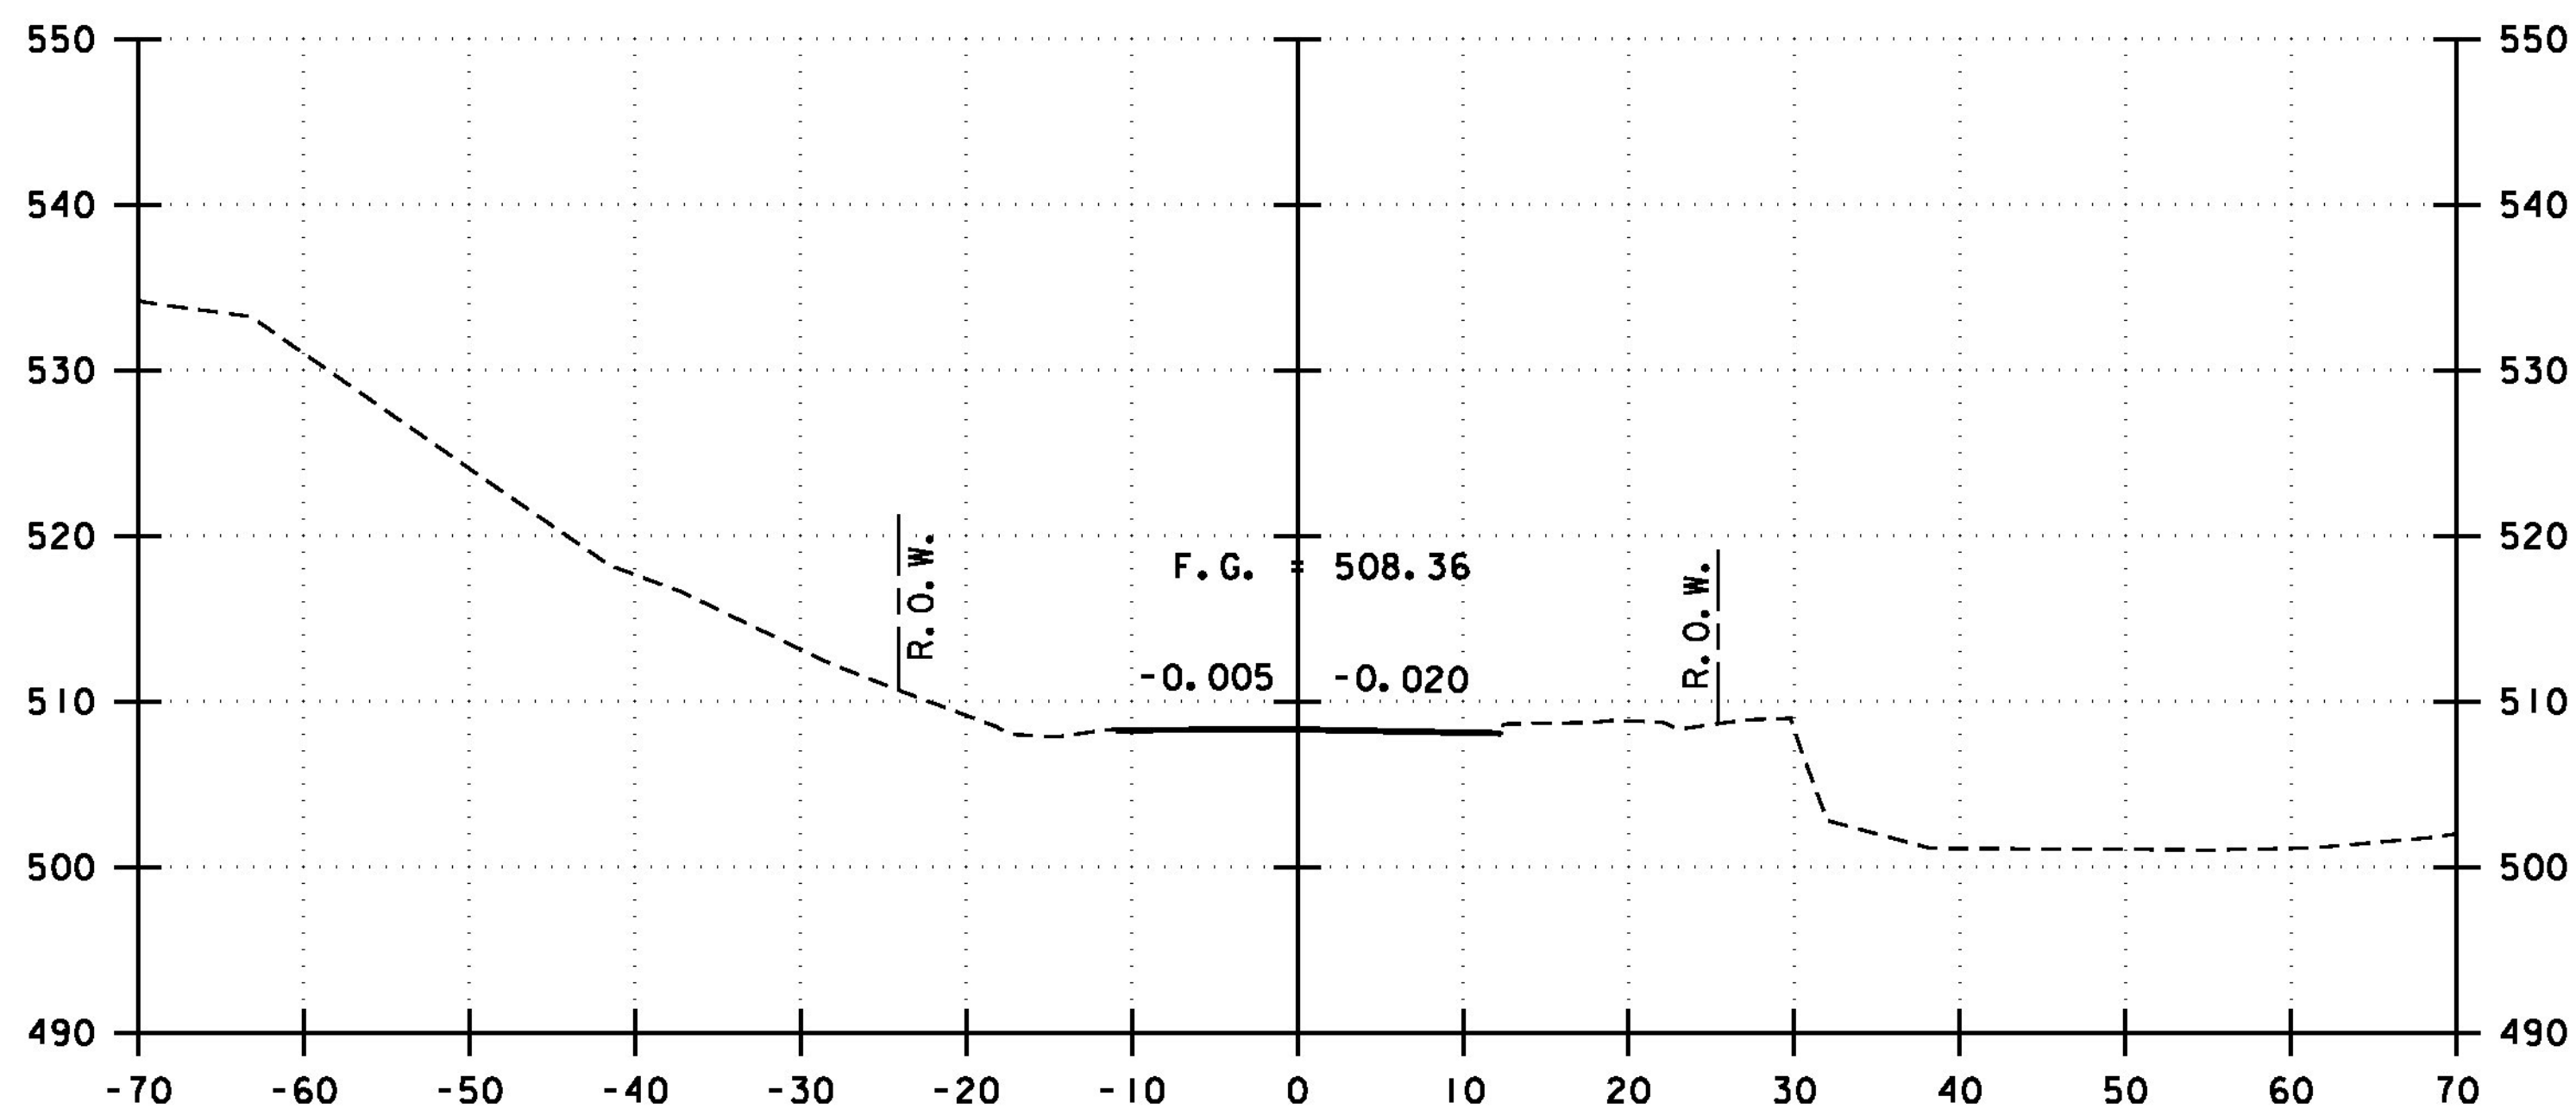

135+50  
BEGIN APPROACH  
STA 135+50.00

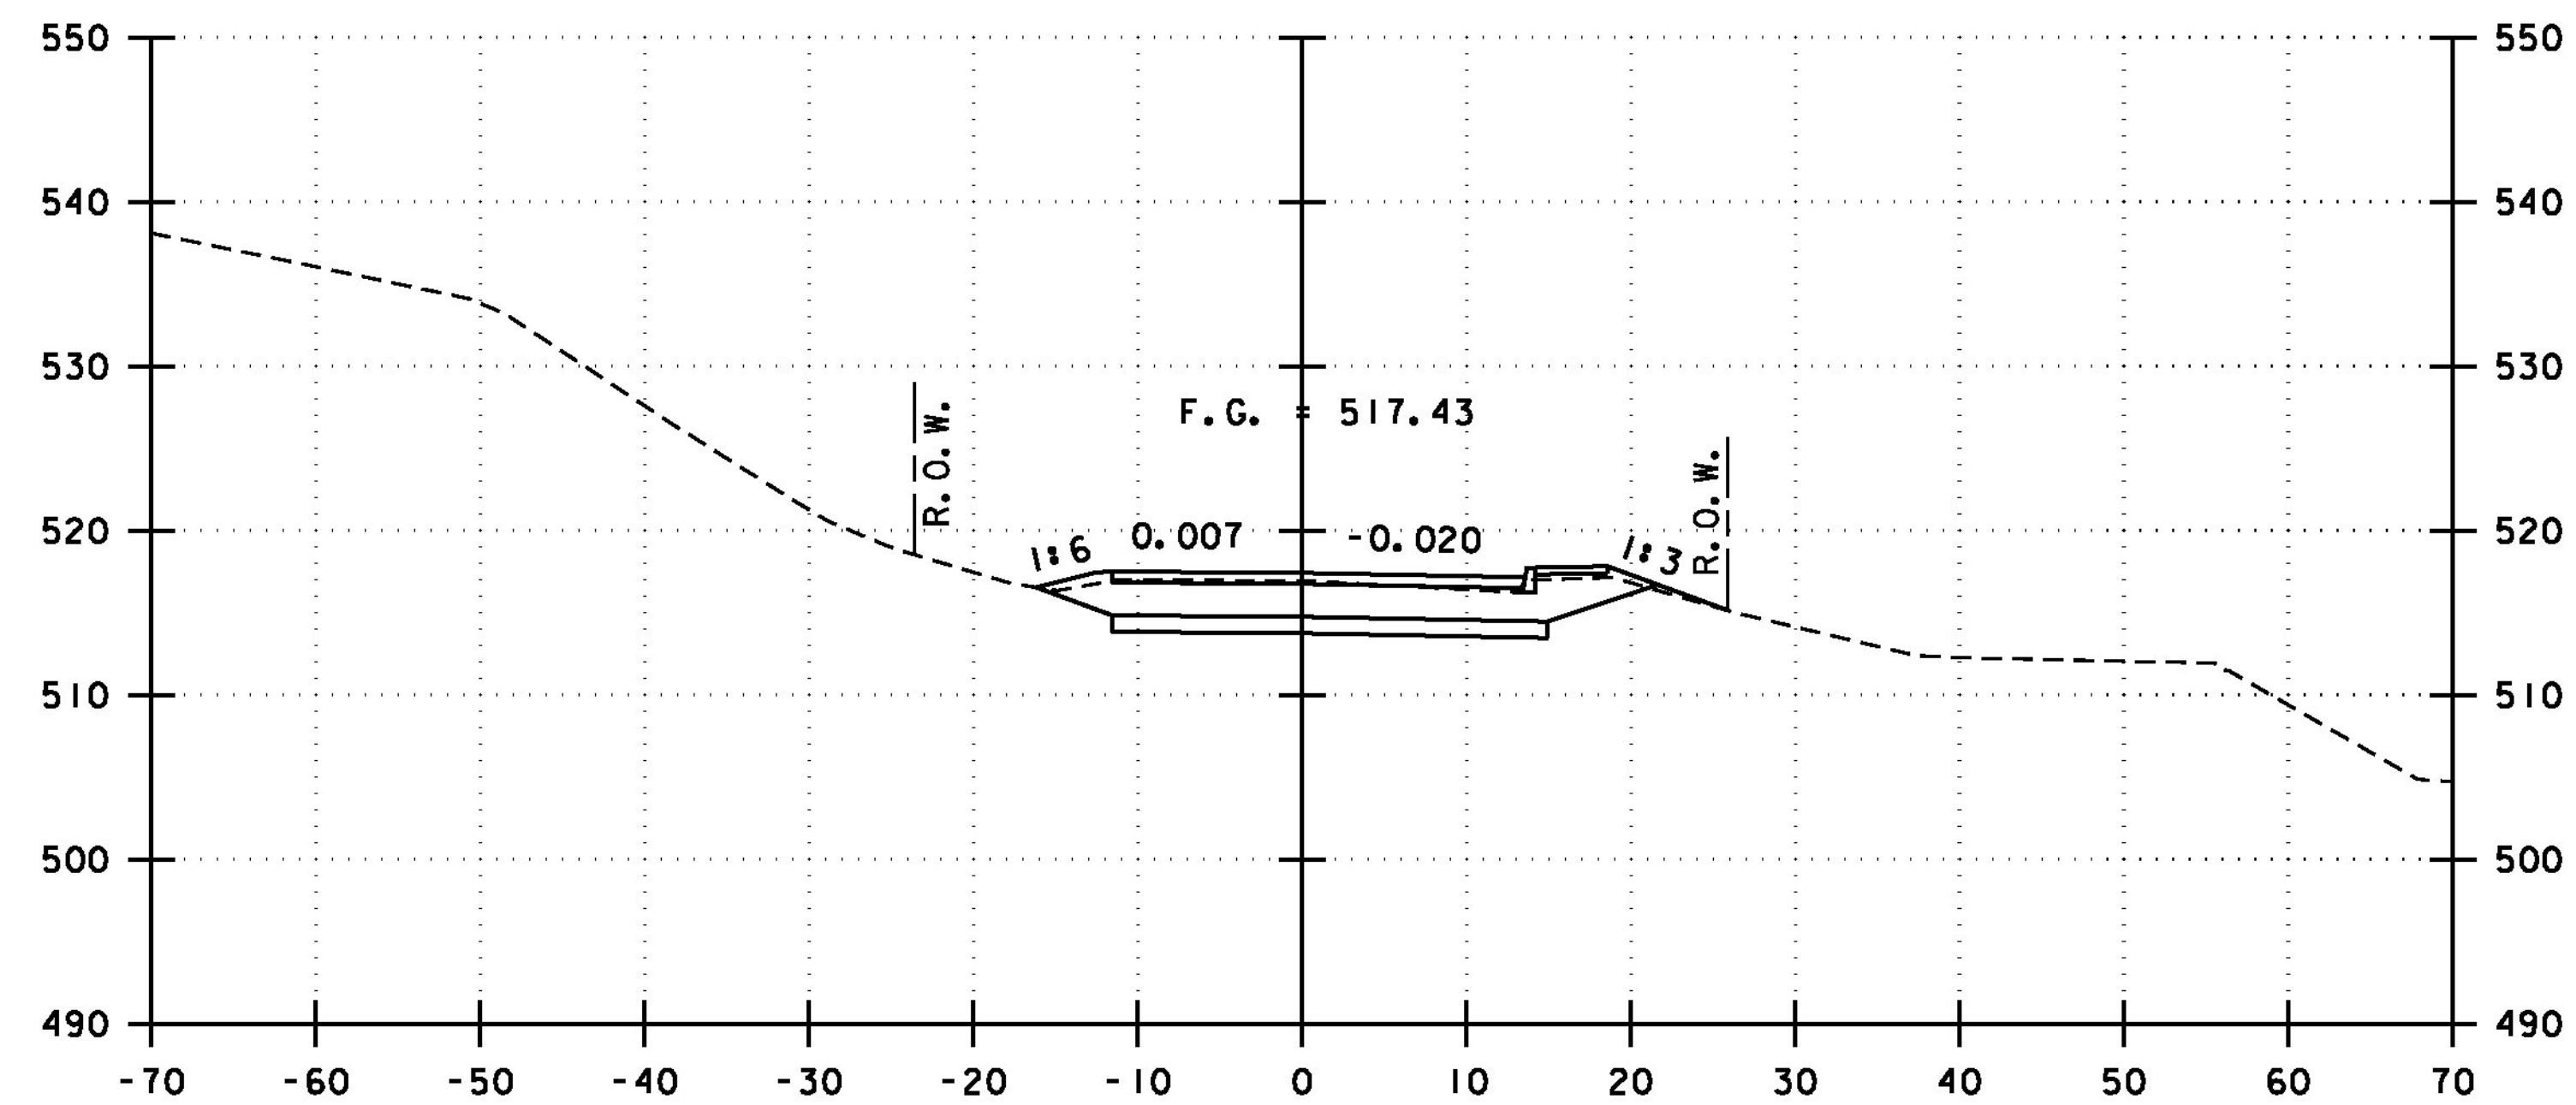

137+00

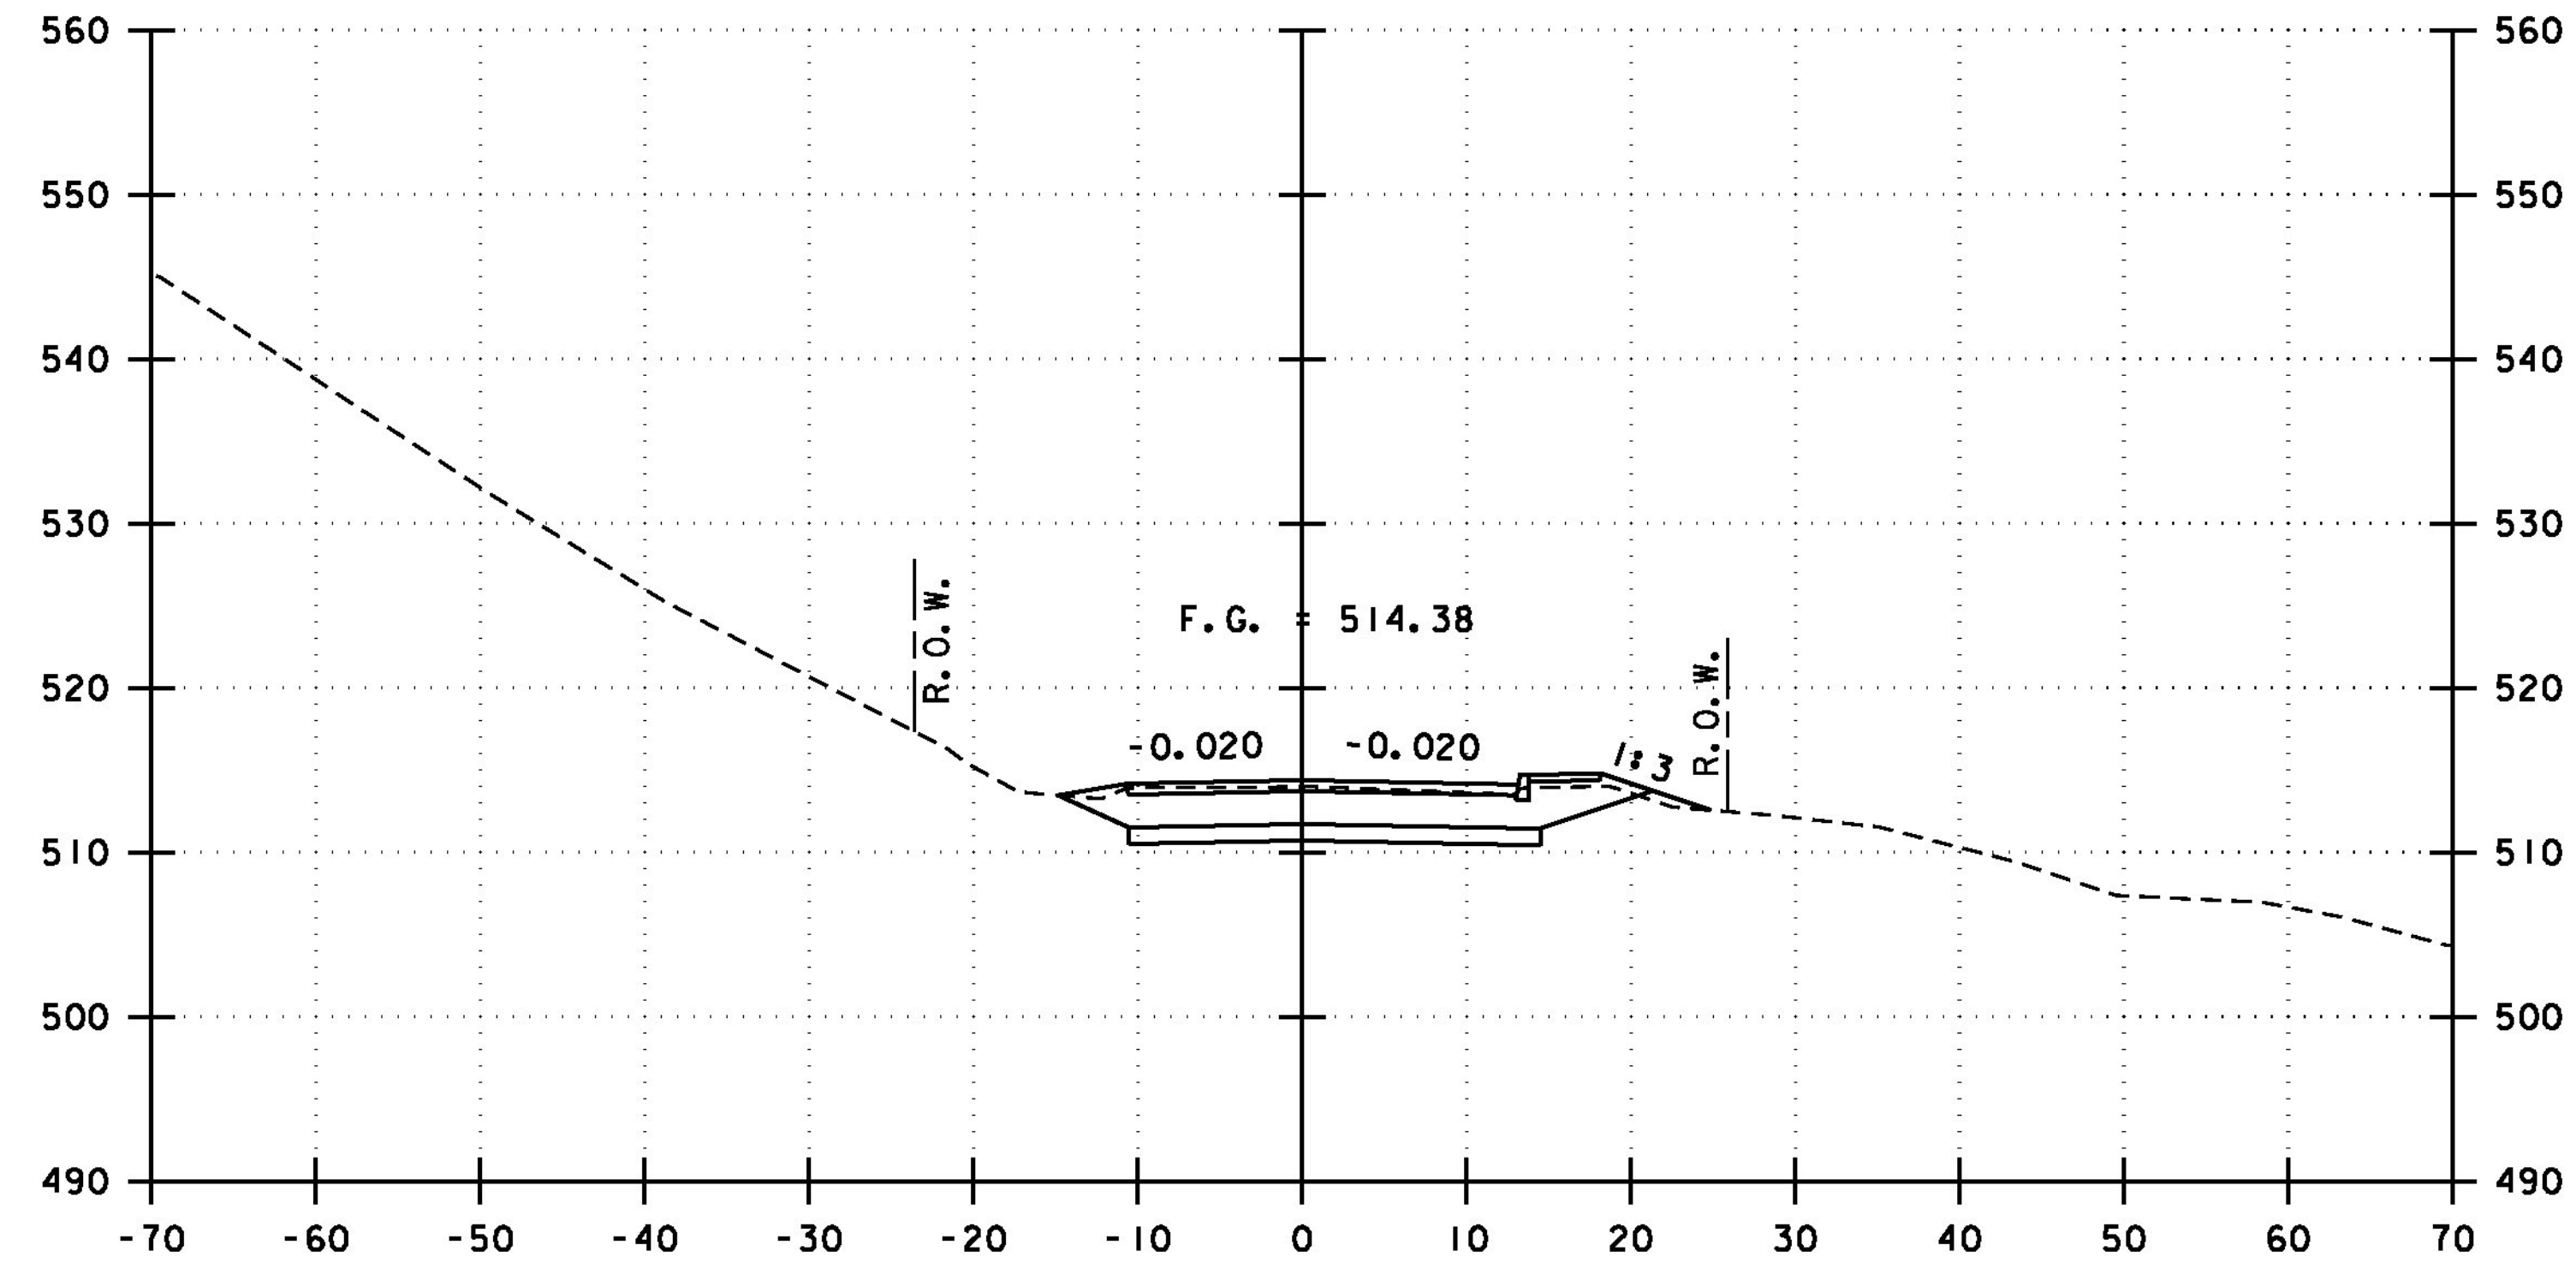

136+50  
BEGIN PROJECT  
STA 136+50.00

VT 125 CROSS SECTIONS

STA 135+50 TO STA 137+00



PROJECT NAME:	MIDDLEBURY
PROJECT NUMBER:	RS 0174(8)
FILE NAME:	z78f217xsl.dgn
PROJECT LEADER:	M.A. COLGAN
DESIGNED BY:	D.M. PECK
ROADWAY CROSS SECTION (1 OF 6)	
PLOT DATE:	8/27/2013
DRAWN BY:	B.J. MASSE
CHECKED BY:	G.L. BAKOS
SHEET	82 OF 104