




141+50

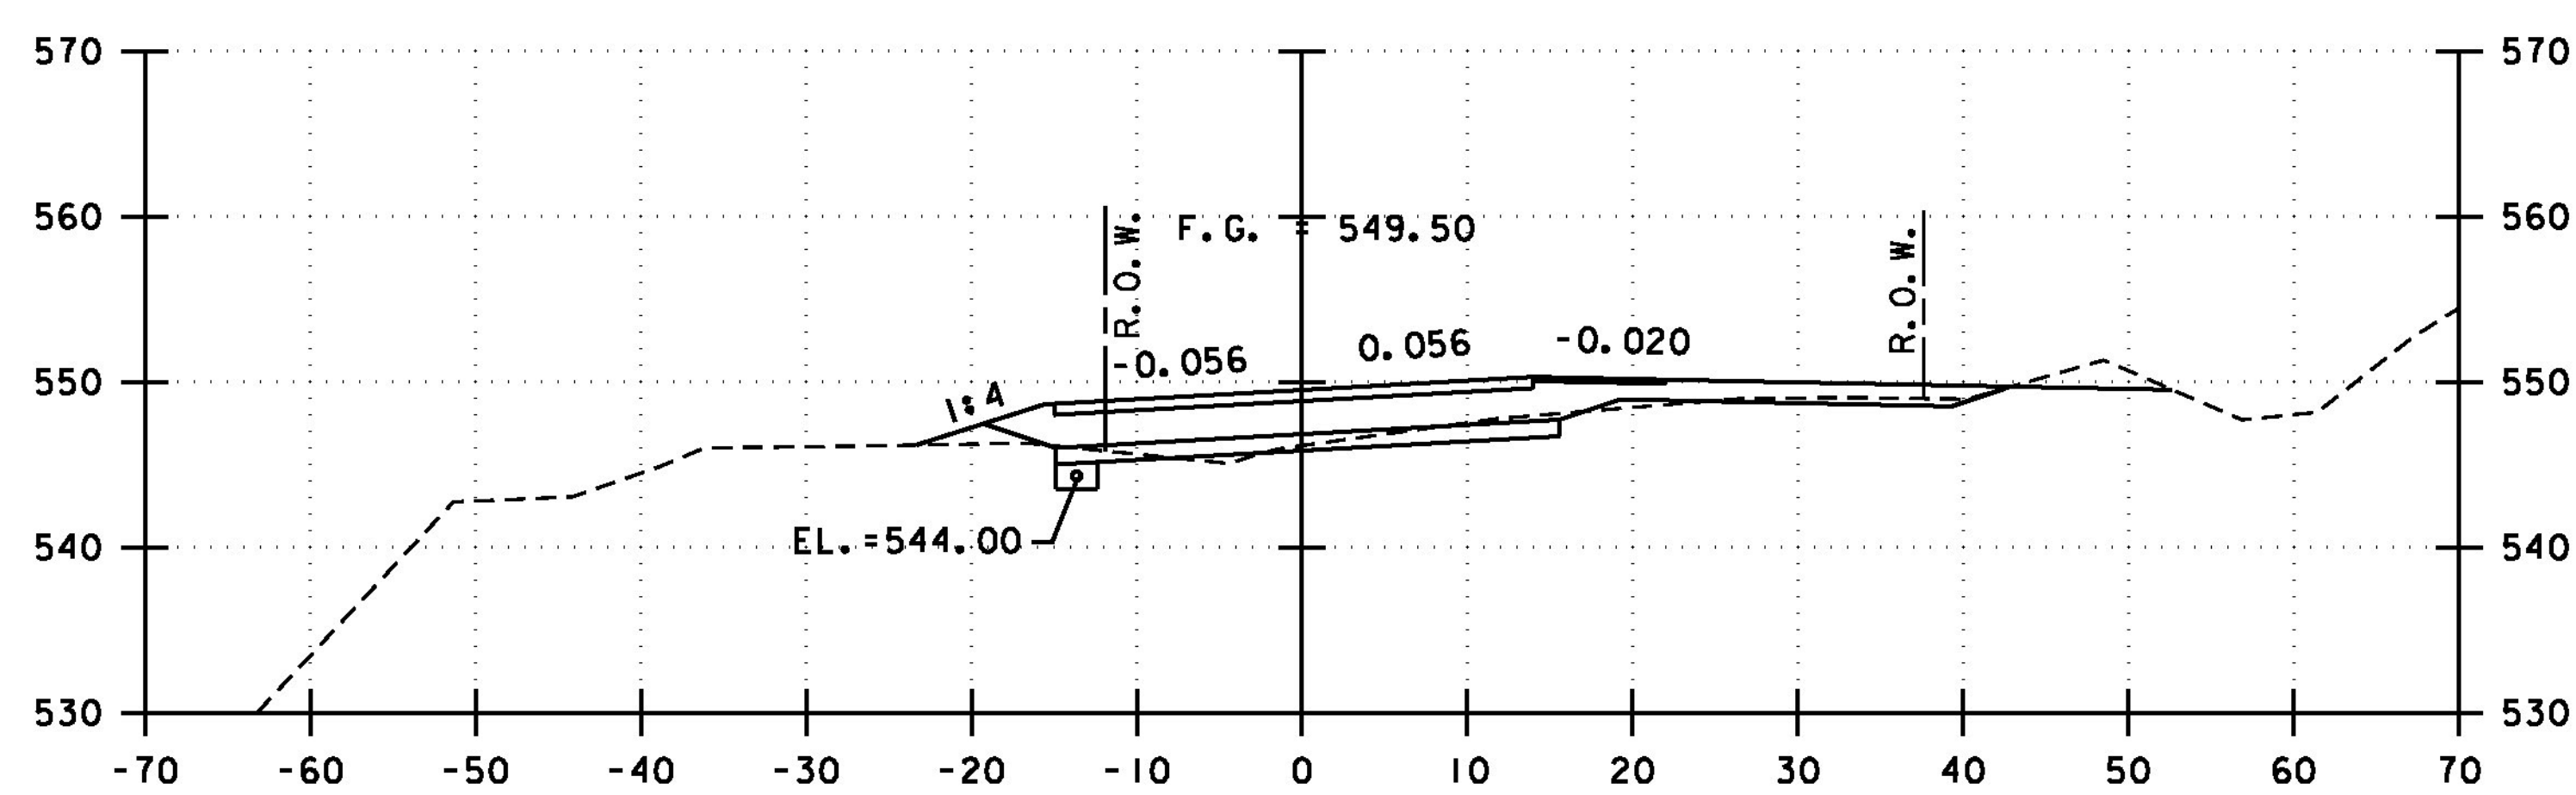

141+00

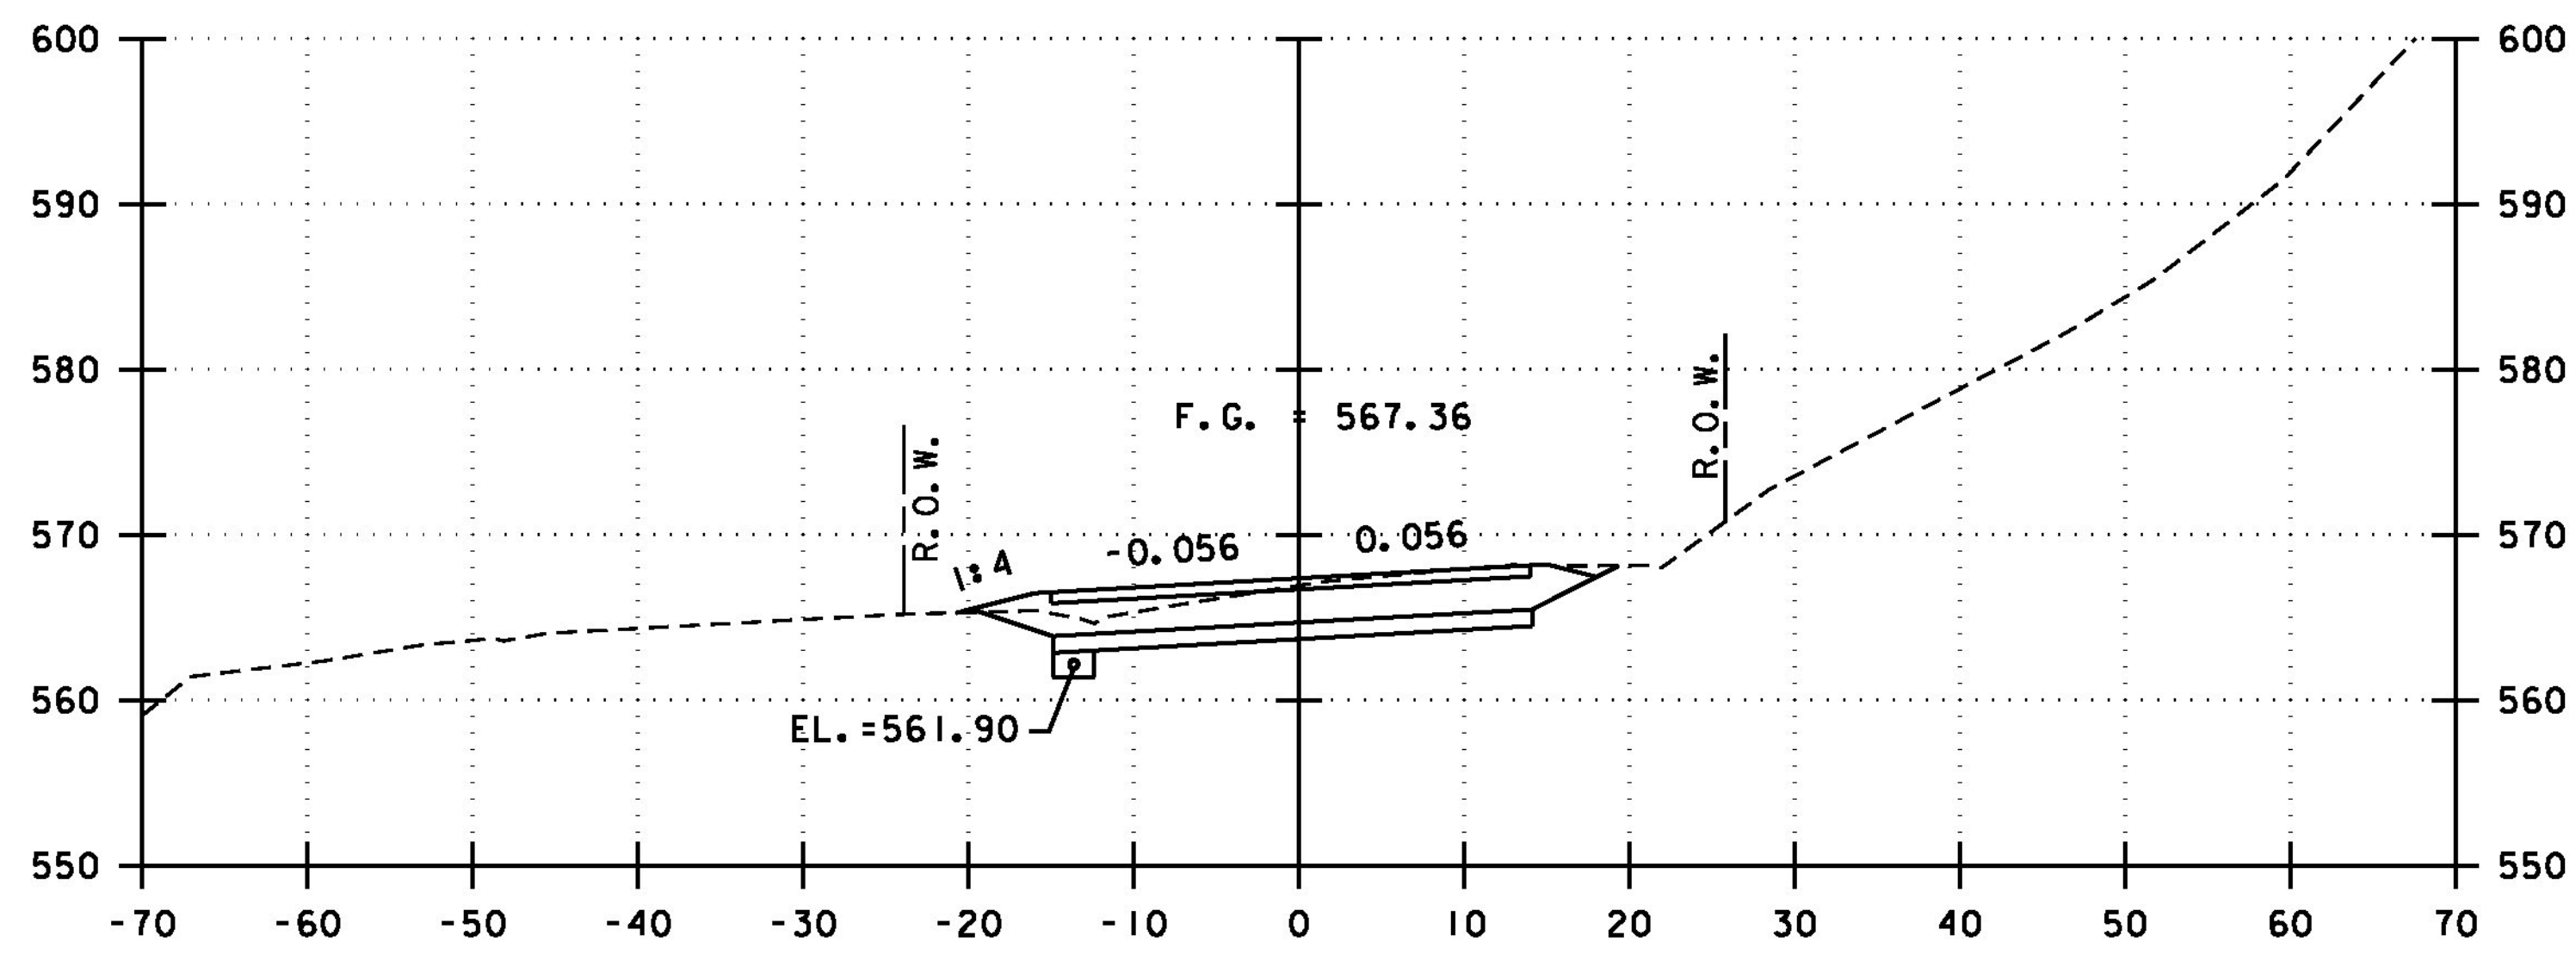

142+50

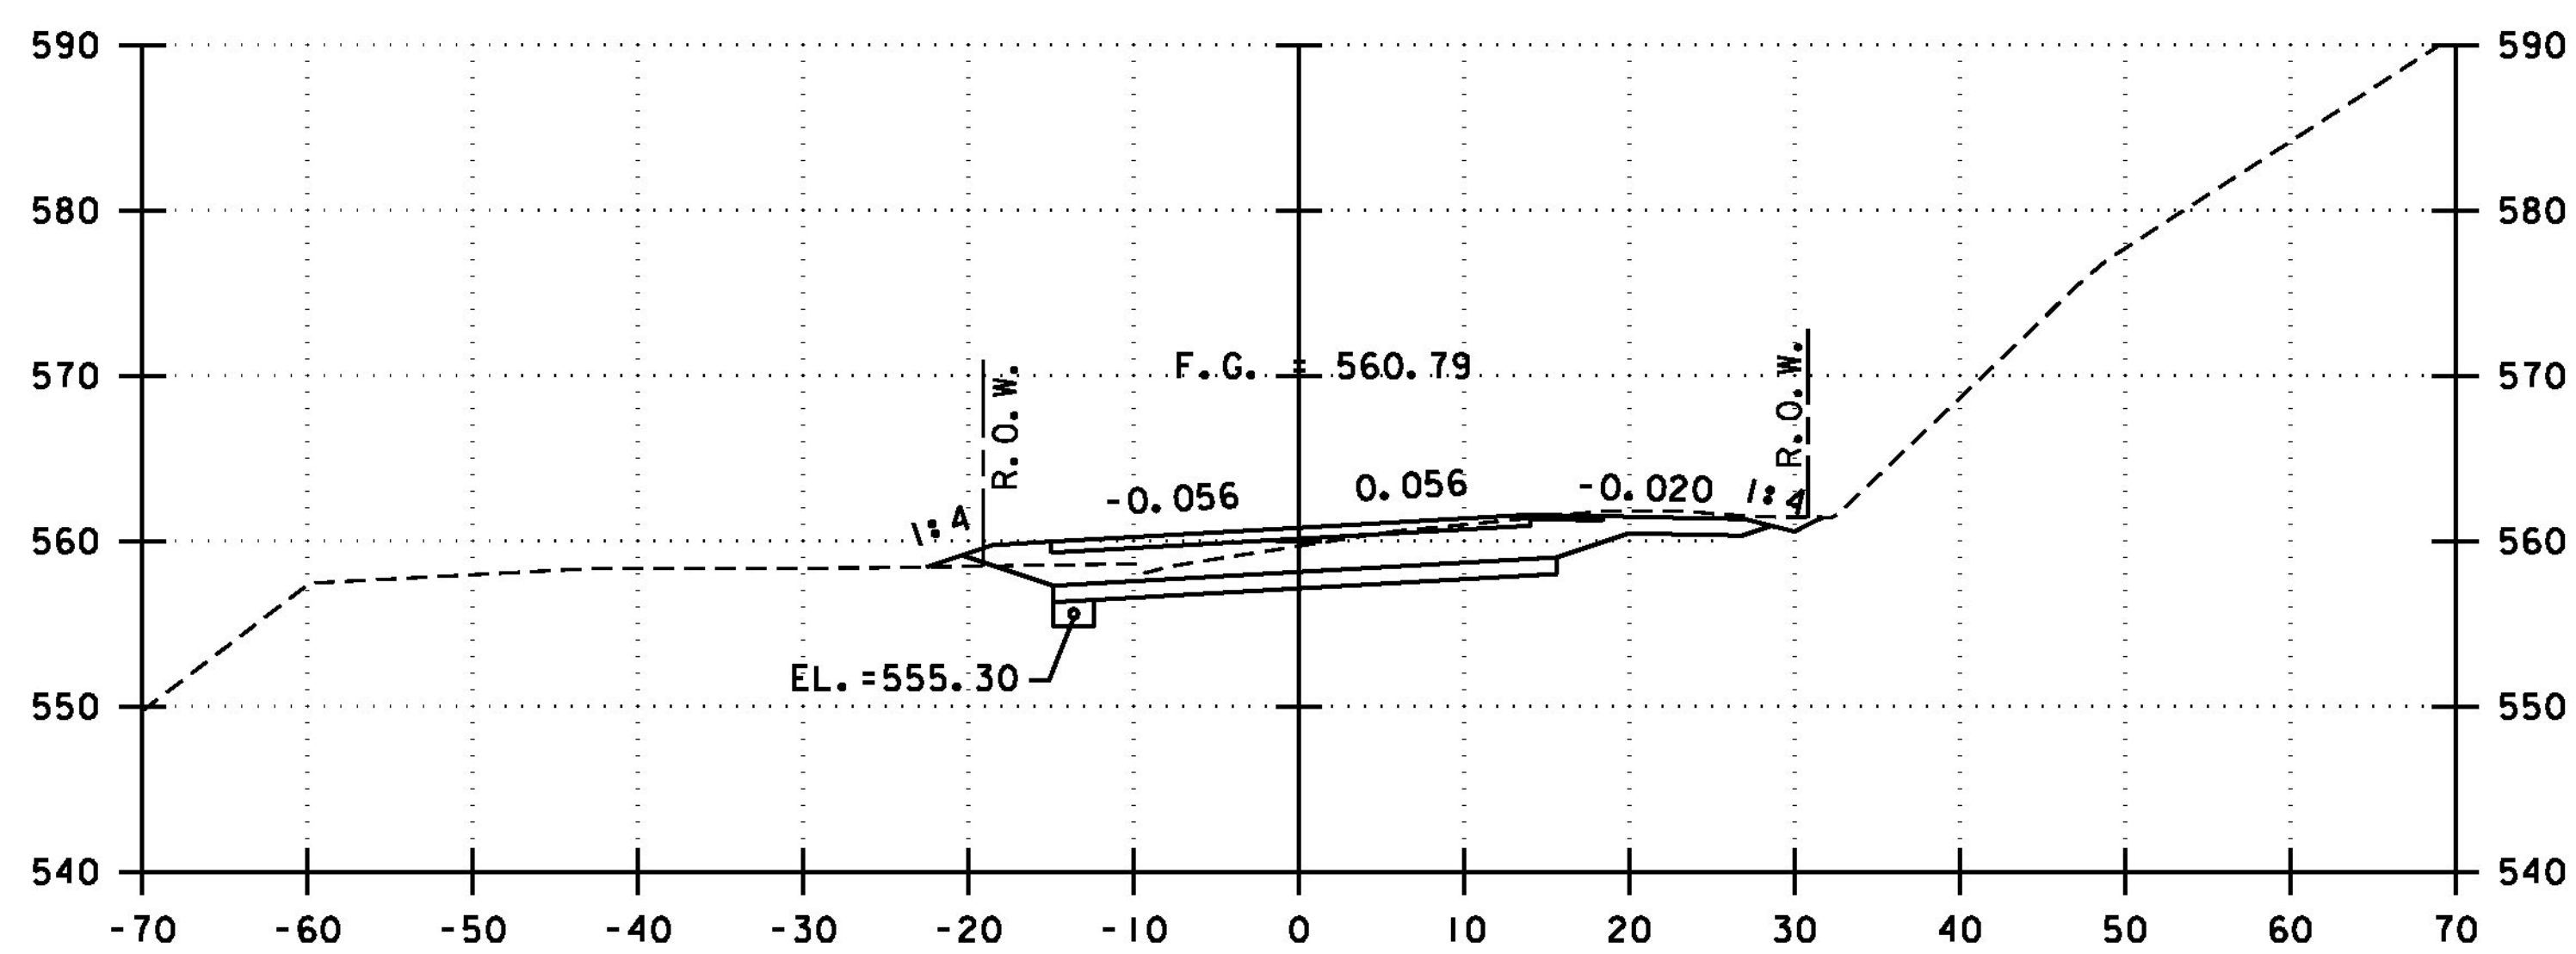

142+00

VT 125 CROSS SECTIONS

STA 141+00 TO STA 142+50



PROJECT NAME: MIDDLEBURY	
PROJECT NUMBER: RS 0174(8)	
FILE NAME: z78f217xsl.dgn	PLOT DATE: 8/27/2013
PROJECT LEADER: M.A. COLGAN	DRAWN BY: B.J. MASSE
DESIGNED BY: D.M. PECK	CHECKED BY: G.L. BAKOS
ROADWAY CROSS SECTION (4 OF 6)	SHEET 85 OF 104