


143+00

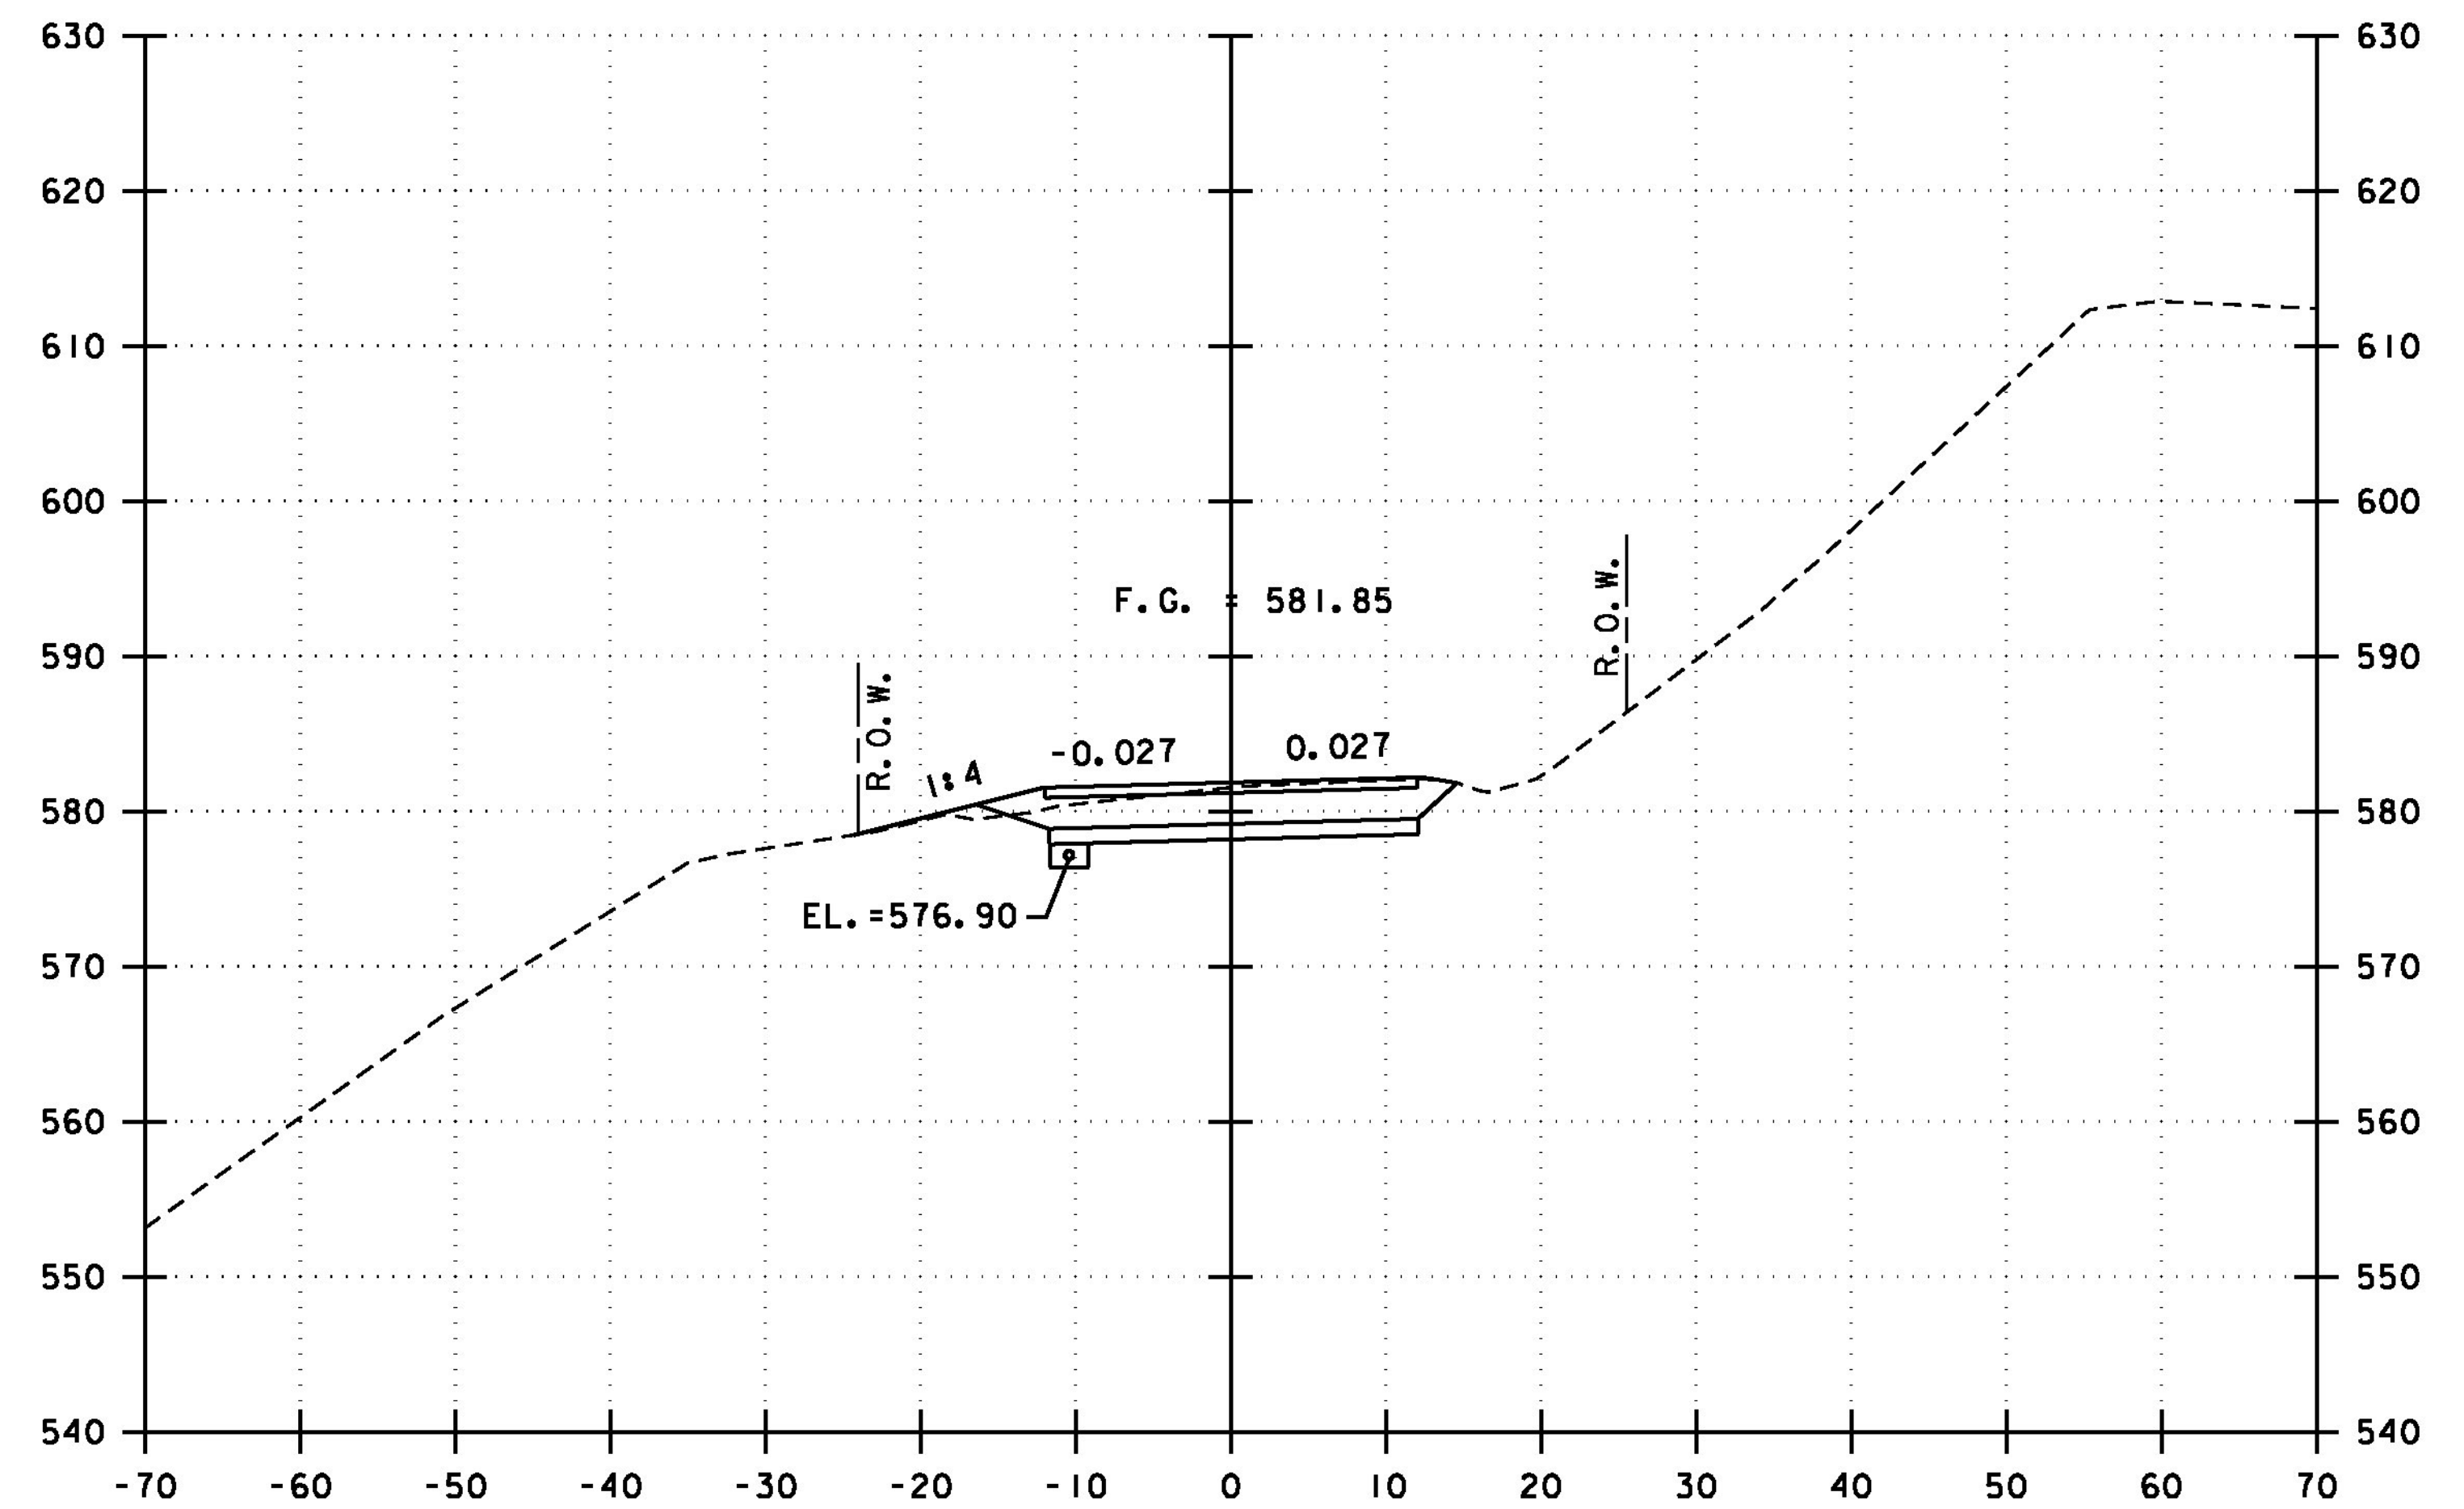

143+50

END PROJECT  
STA 143+50.00

VT 125 CROSS SECTIONS

STA 143+00 TO STA 143+50



PROJECT NAME: MIDDLEBURY	
PROJECT NUMBER: RS 0174(8)	
FILE NAME: z78f217xsl.dgn	PLOT DATE: 8/27/2013
PROJECT LEADER: M.A. COLGAN	DRAWN BY: B.J. MASSE
DESIGNED BY: D.M. PECK	CHECKED BY: G.L. BAKOS
ROADWAY CROSS SECTION (5 OF 6)	SHEET 86 OF 104