




50+25

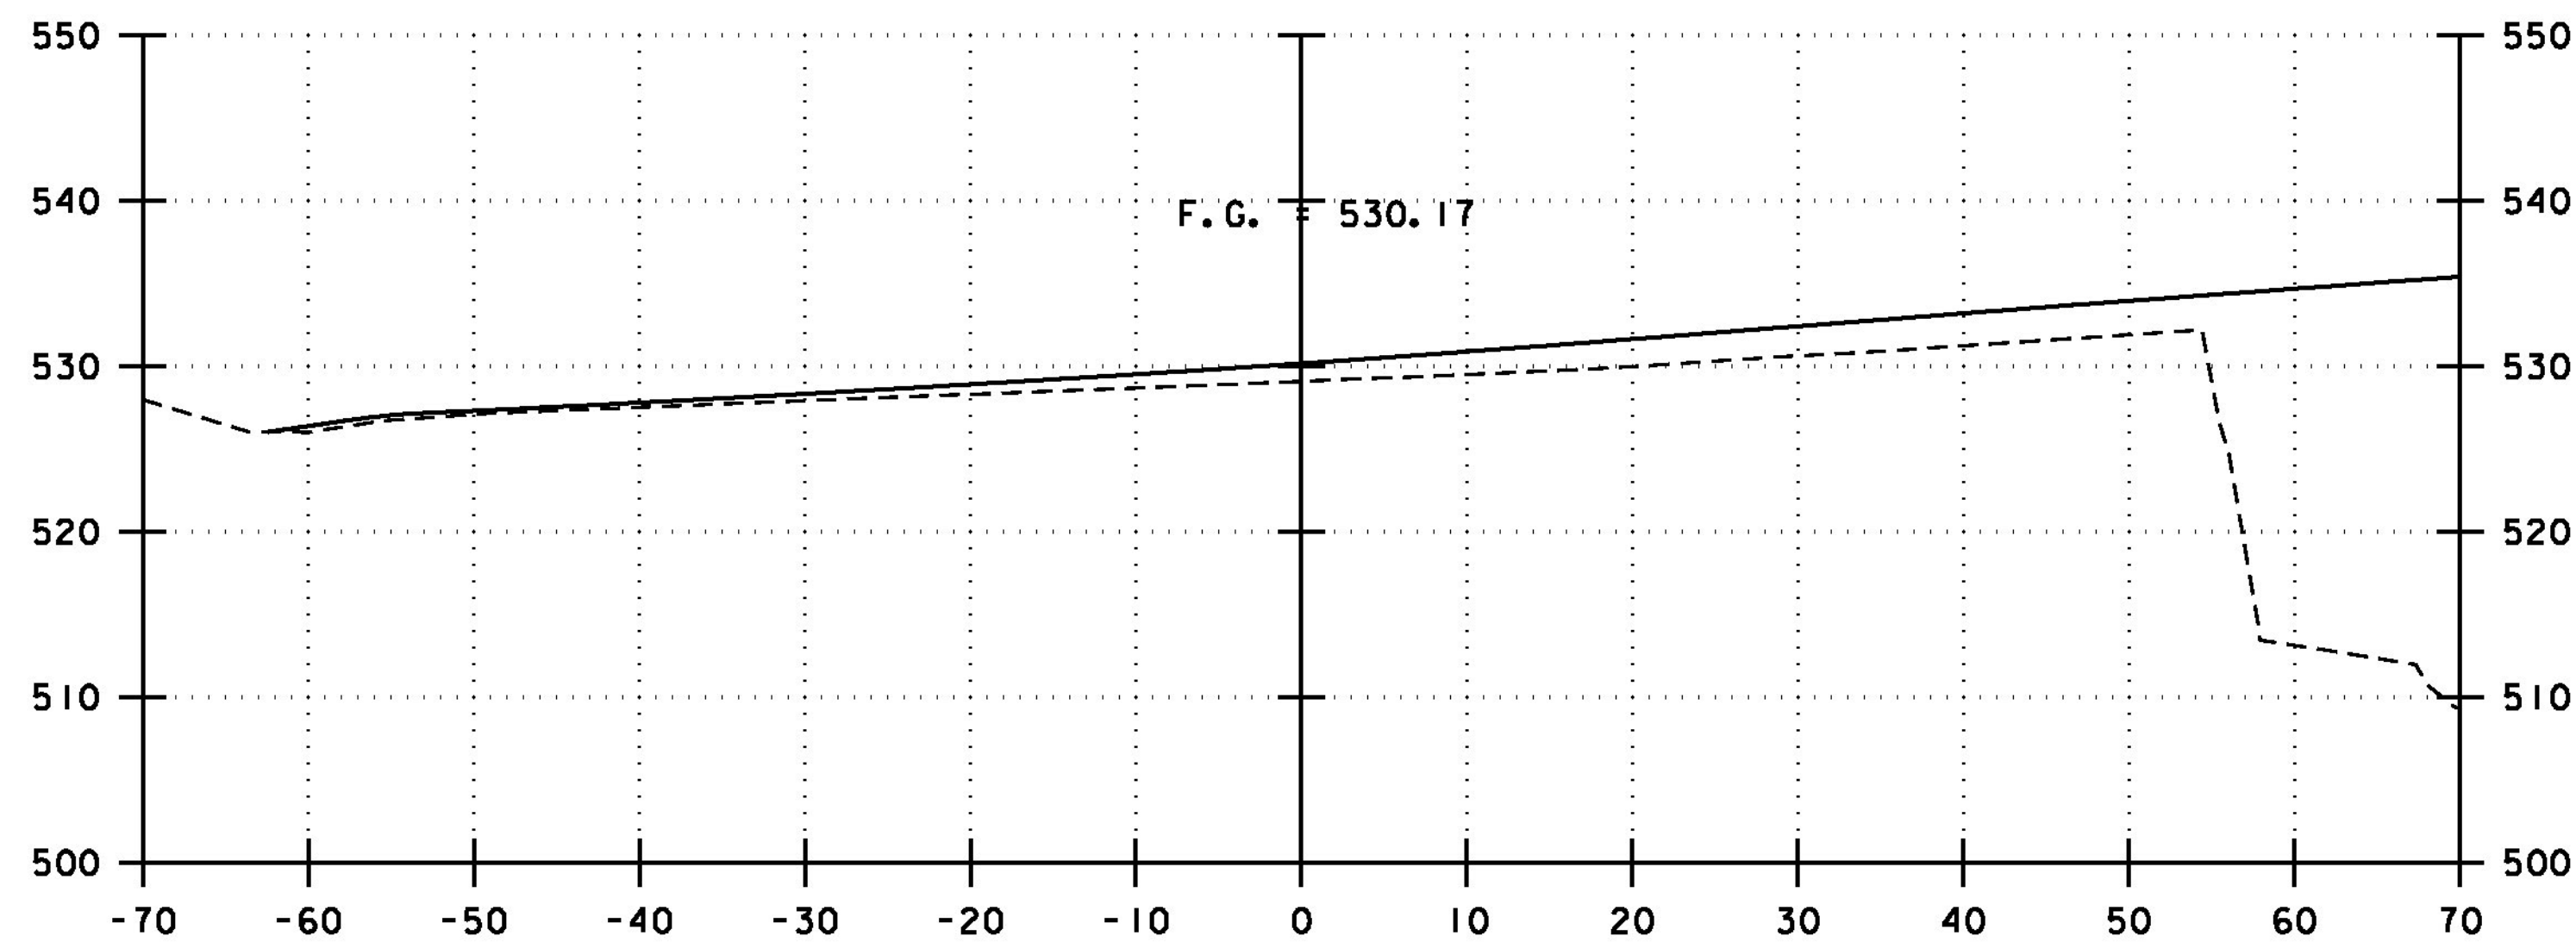

50+00

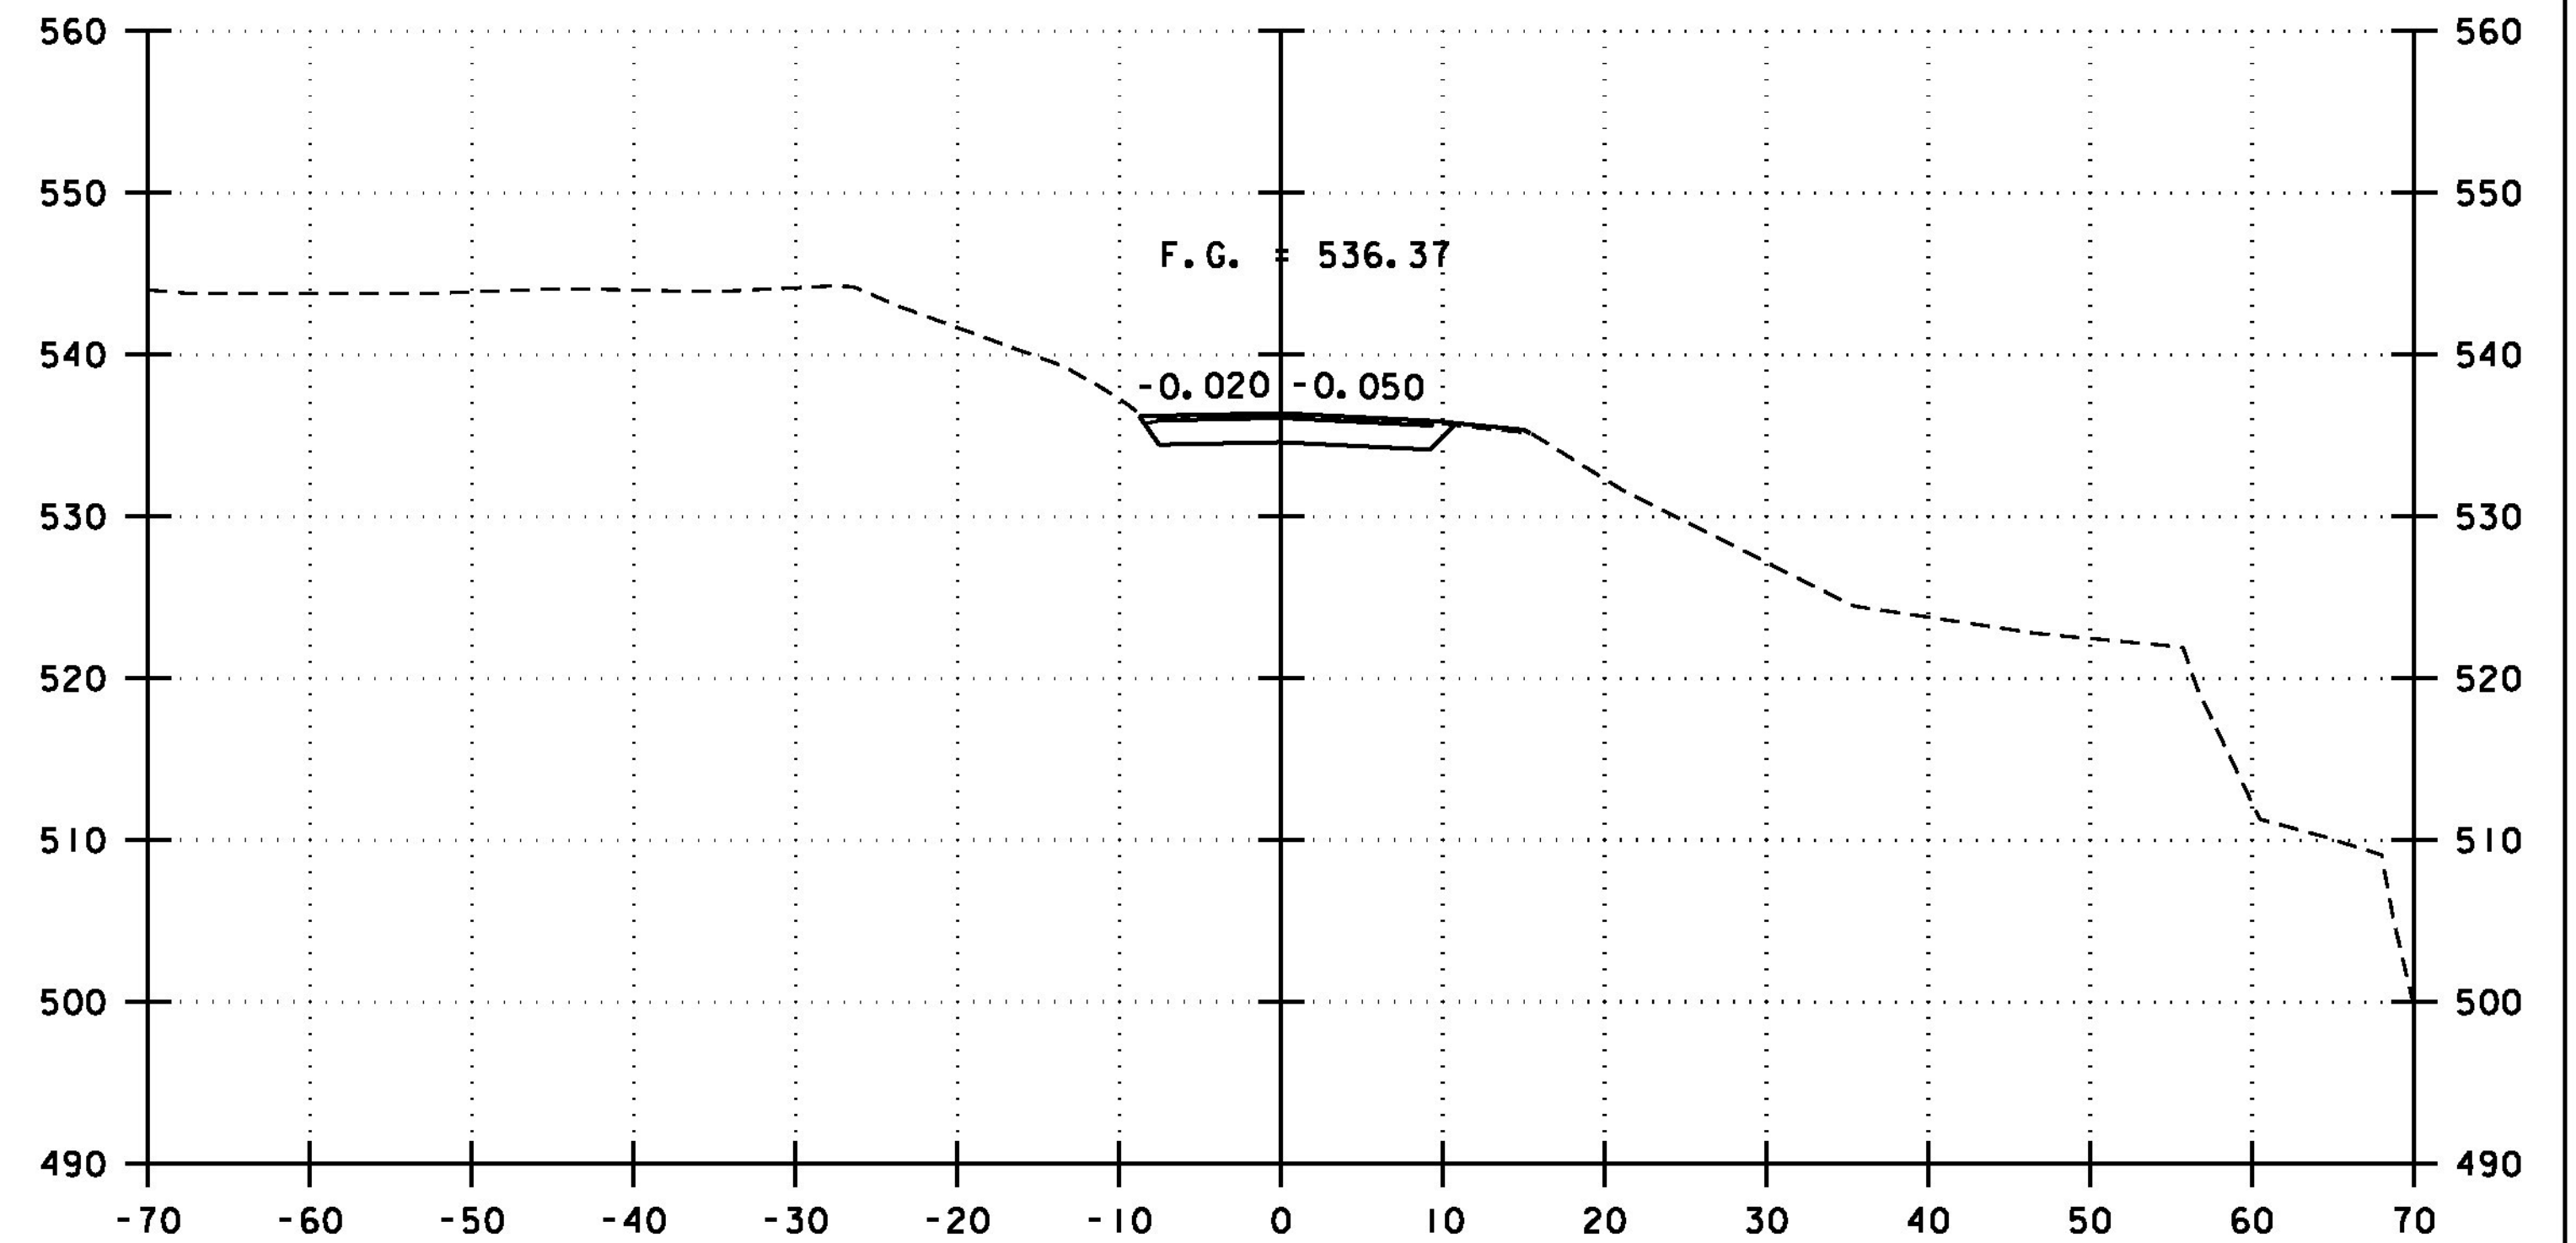

50+75

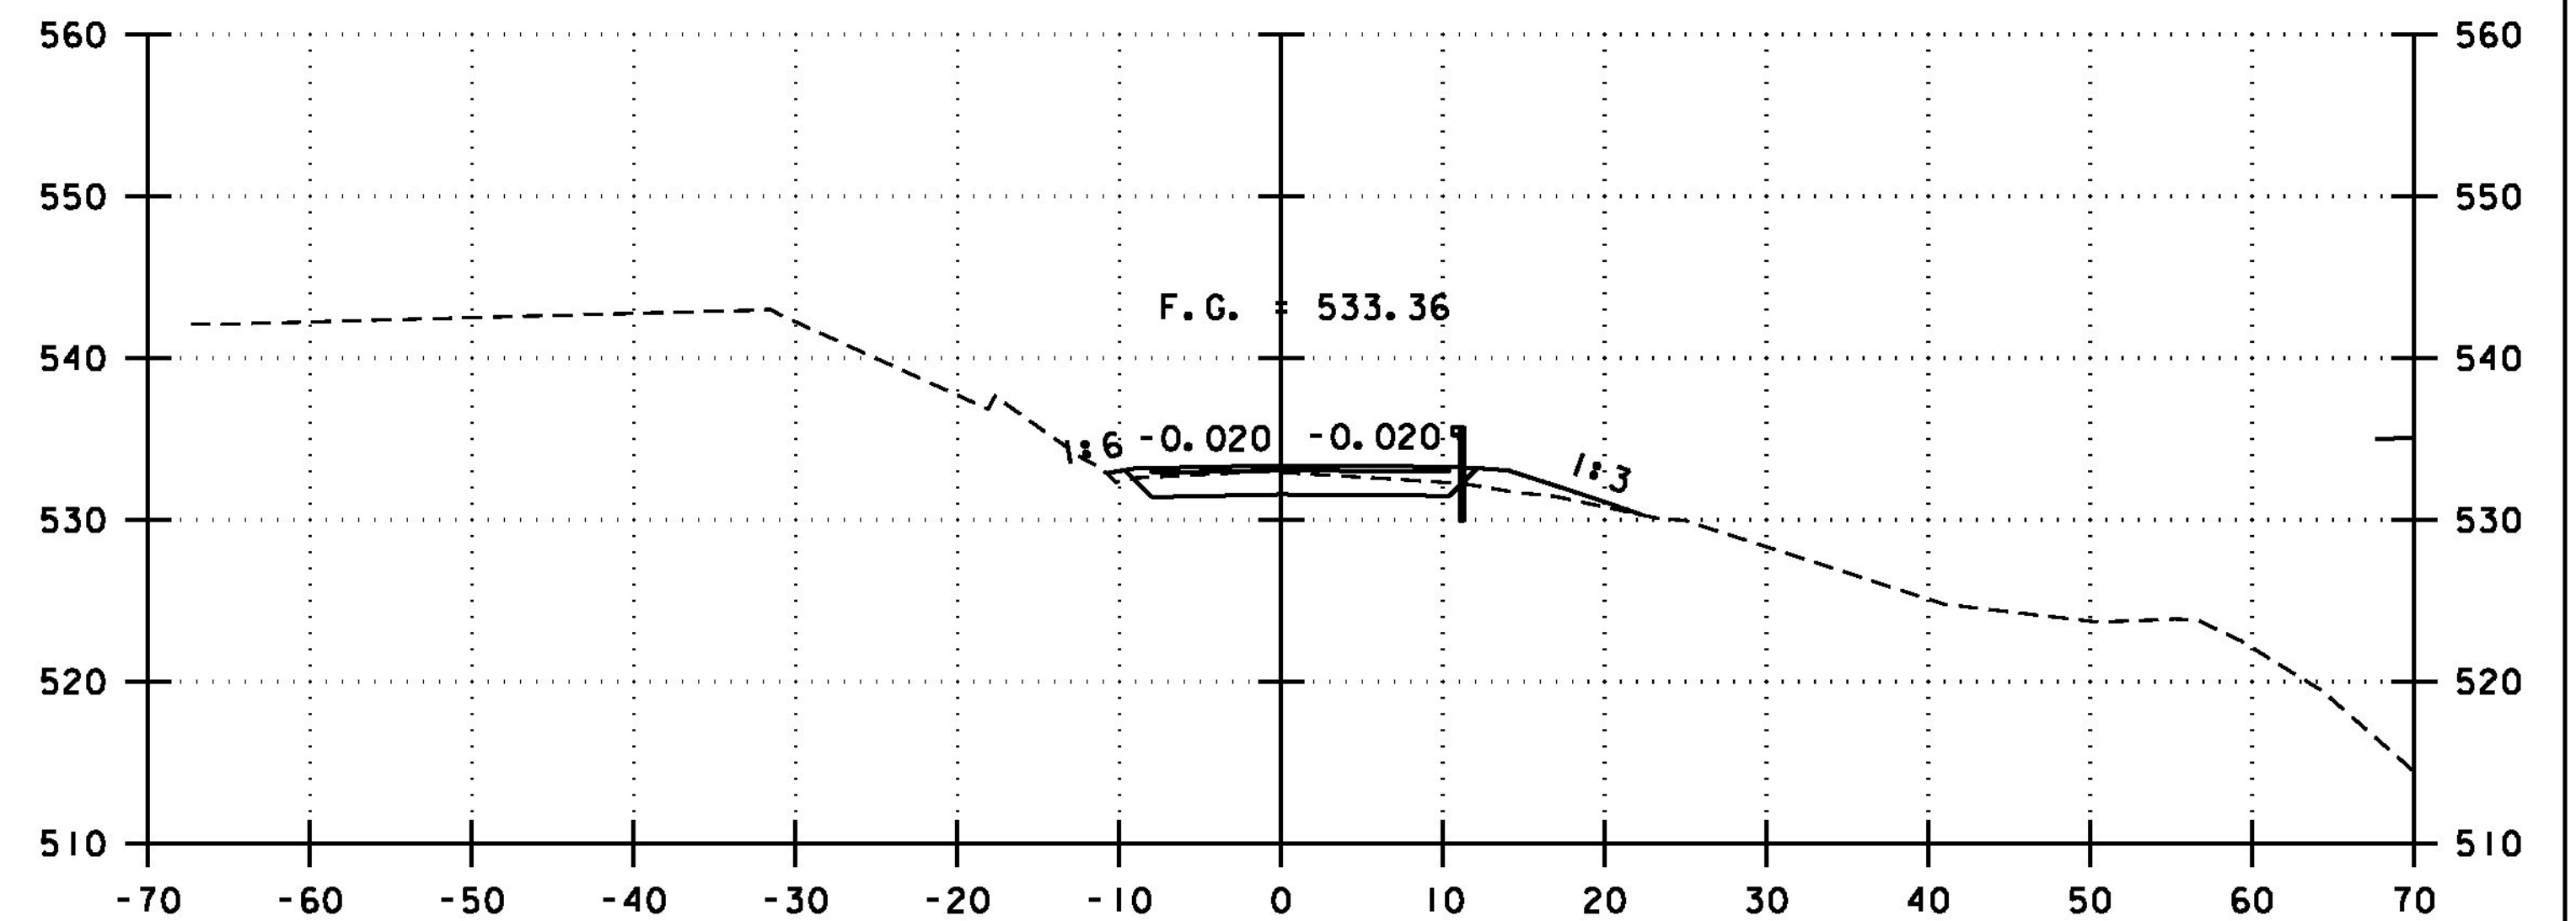

50+50

NORTH BRANCH ROAD CROSS SECTIONS

STA 50+00 TO STA 50+75



PROJECT NAME: MIDDLEBURY	
PROJECT NUMBER: RS 0174(8)	
FILE NAME: z78f217xsl.dgn	PLOT DATE: 8/27/2013
PROJECT LEADER: M.A. COLGAN	DRAWN BY: B.J. MASSE
DESIGNED BY: D.M. PECK	CHECKED BY: G.L. BAKOS
NORTH BRANCH RD CROSS SECTION (1 OF 2) SHEET 88 OF 104	