



10+25


STA 10+11, RT  
 BEGIN COMMON EXCAVATION FOR STONE FILL  
 GEOTEXTILE UNDER STONE FILL  
 STONE FILL, TYPE II  
 GRUBBING MATERIAL

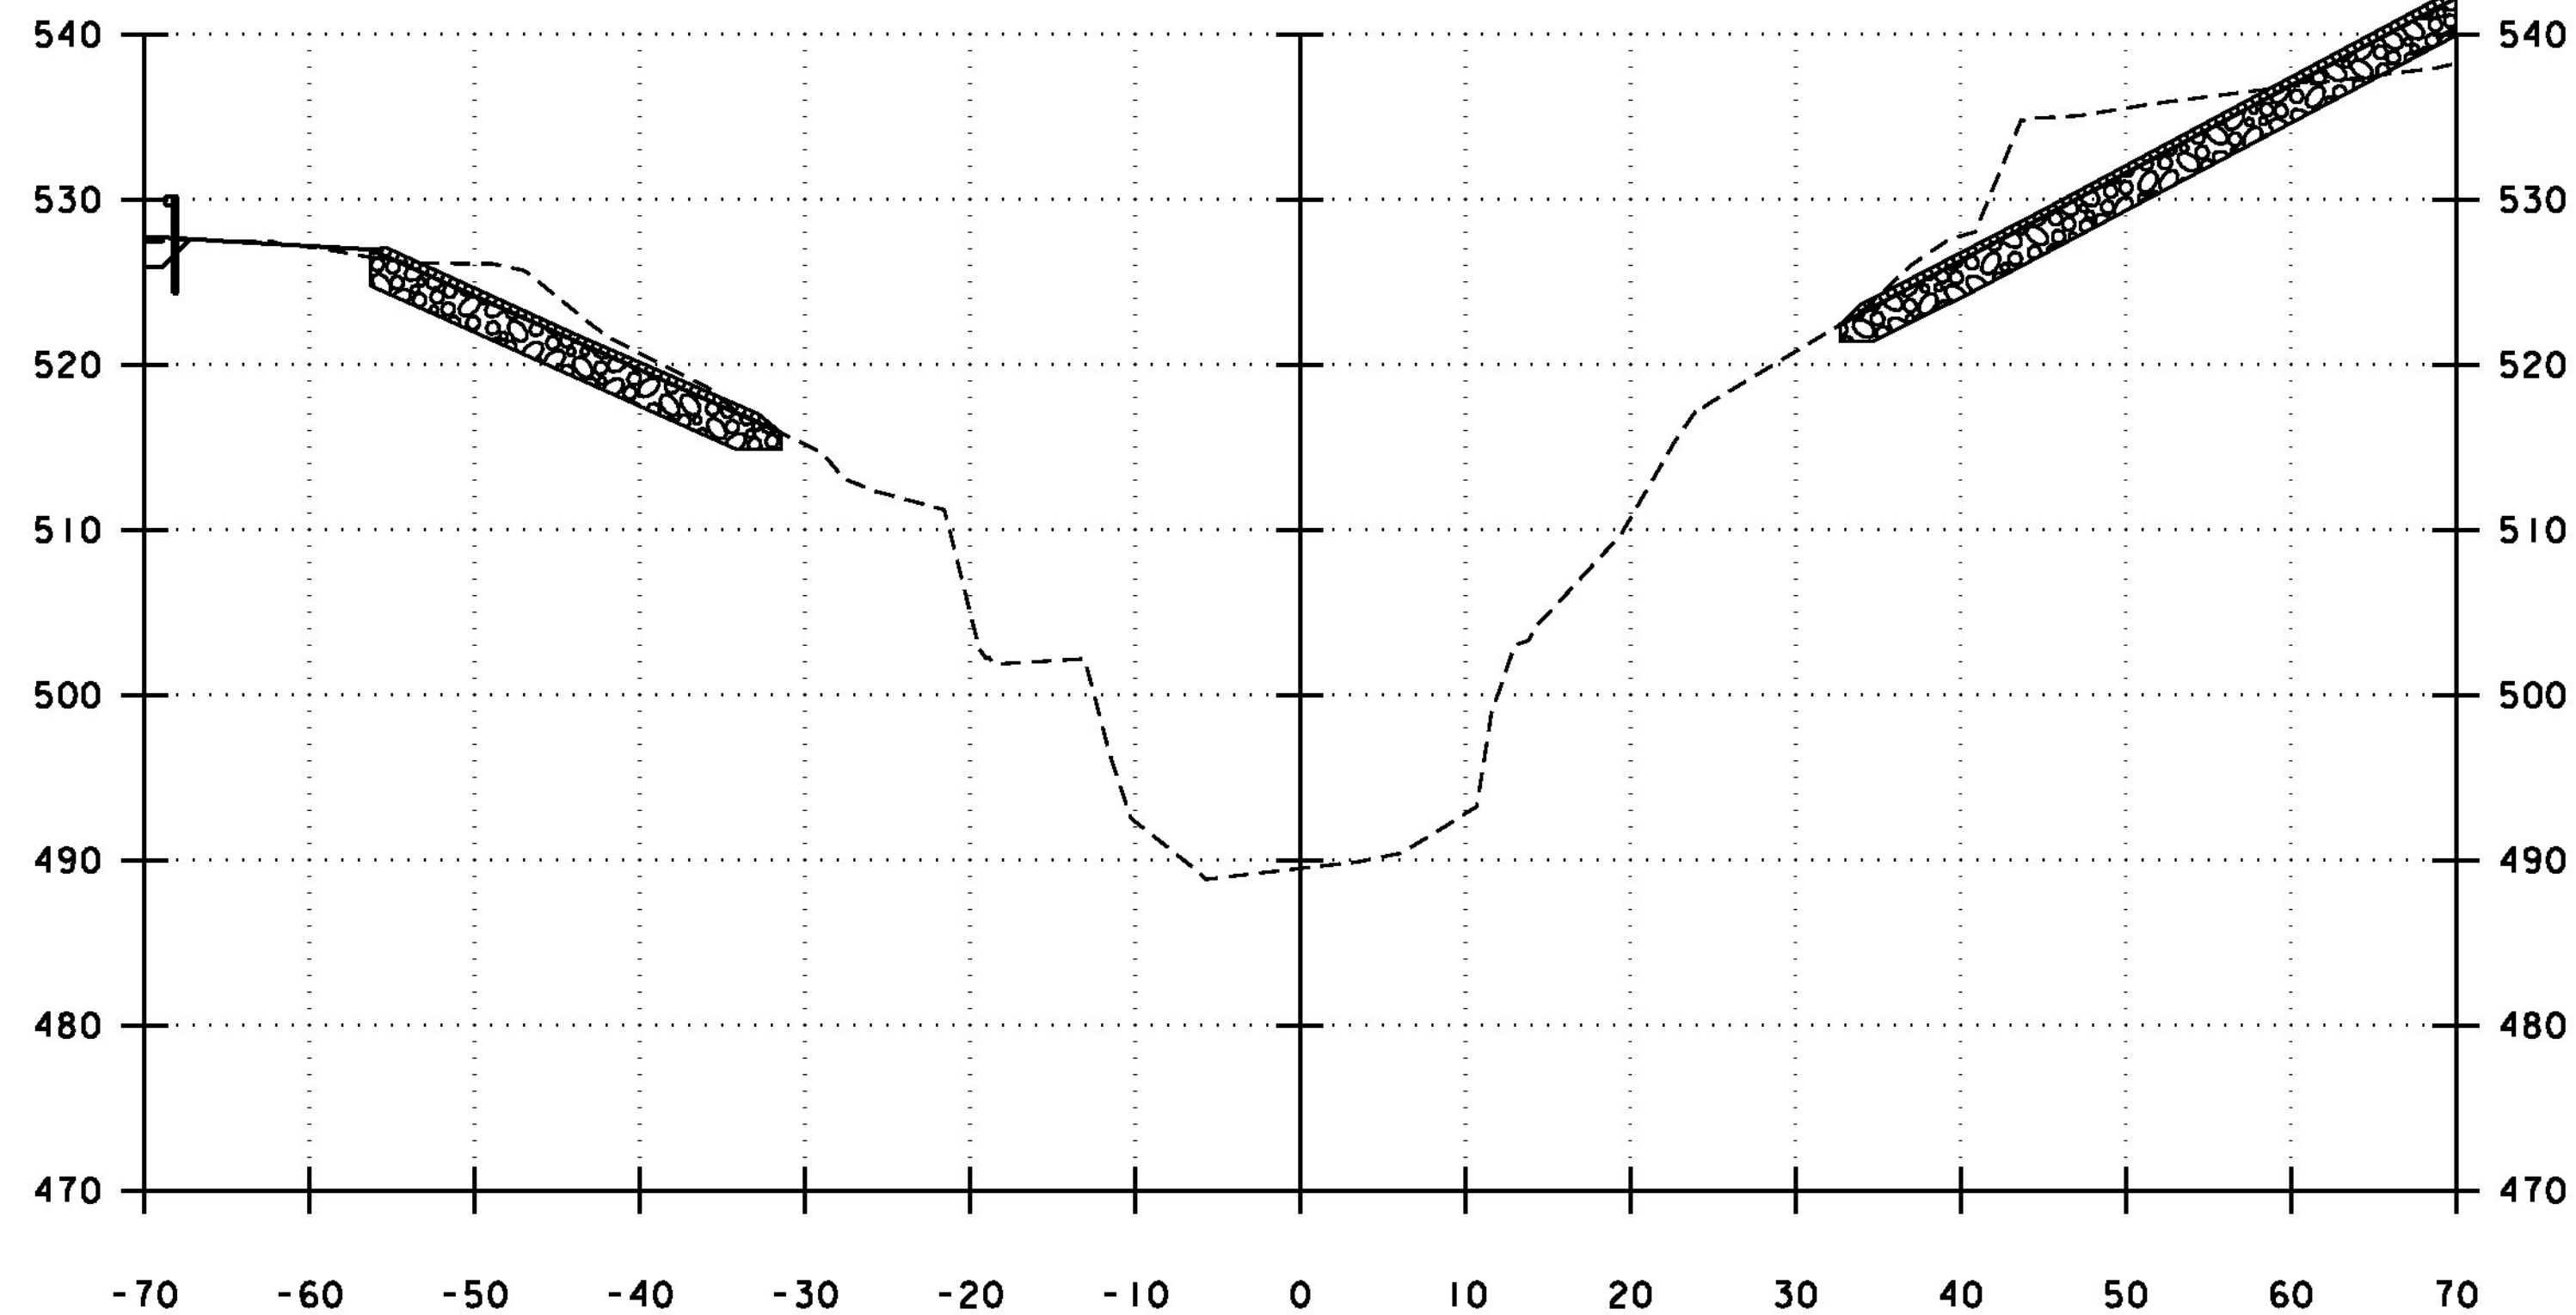

10+75

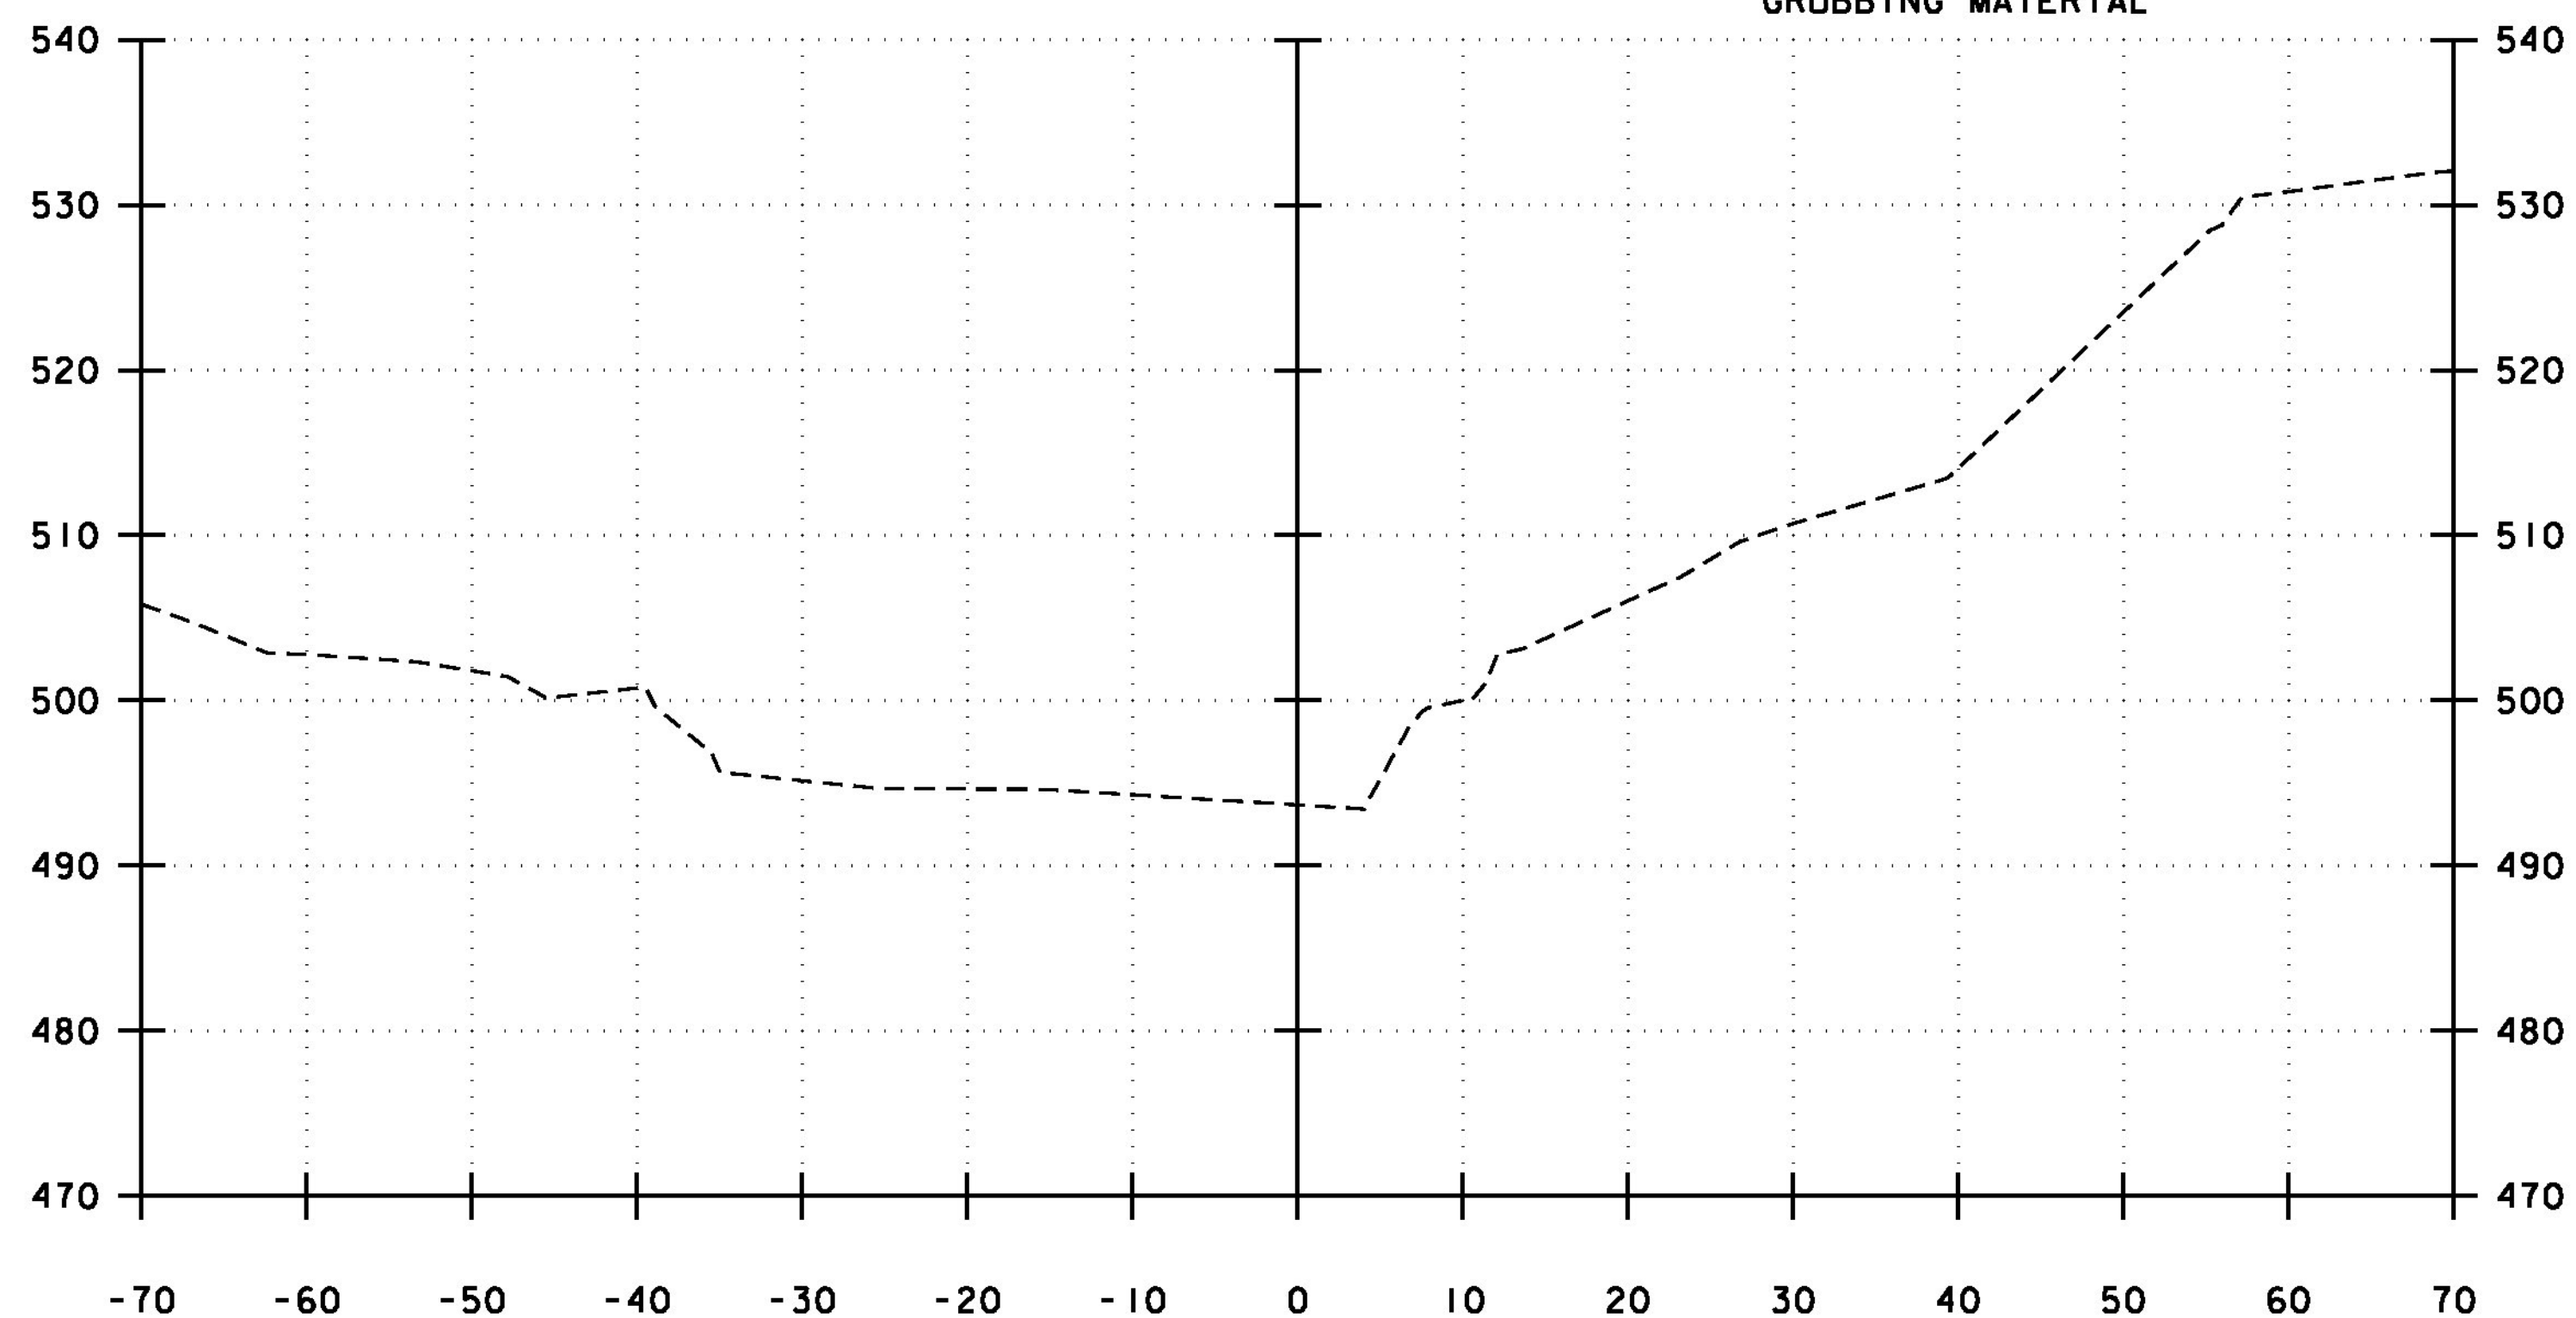

10+00

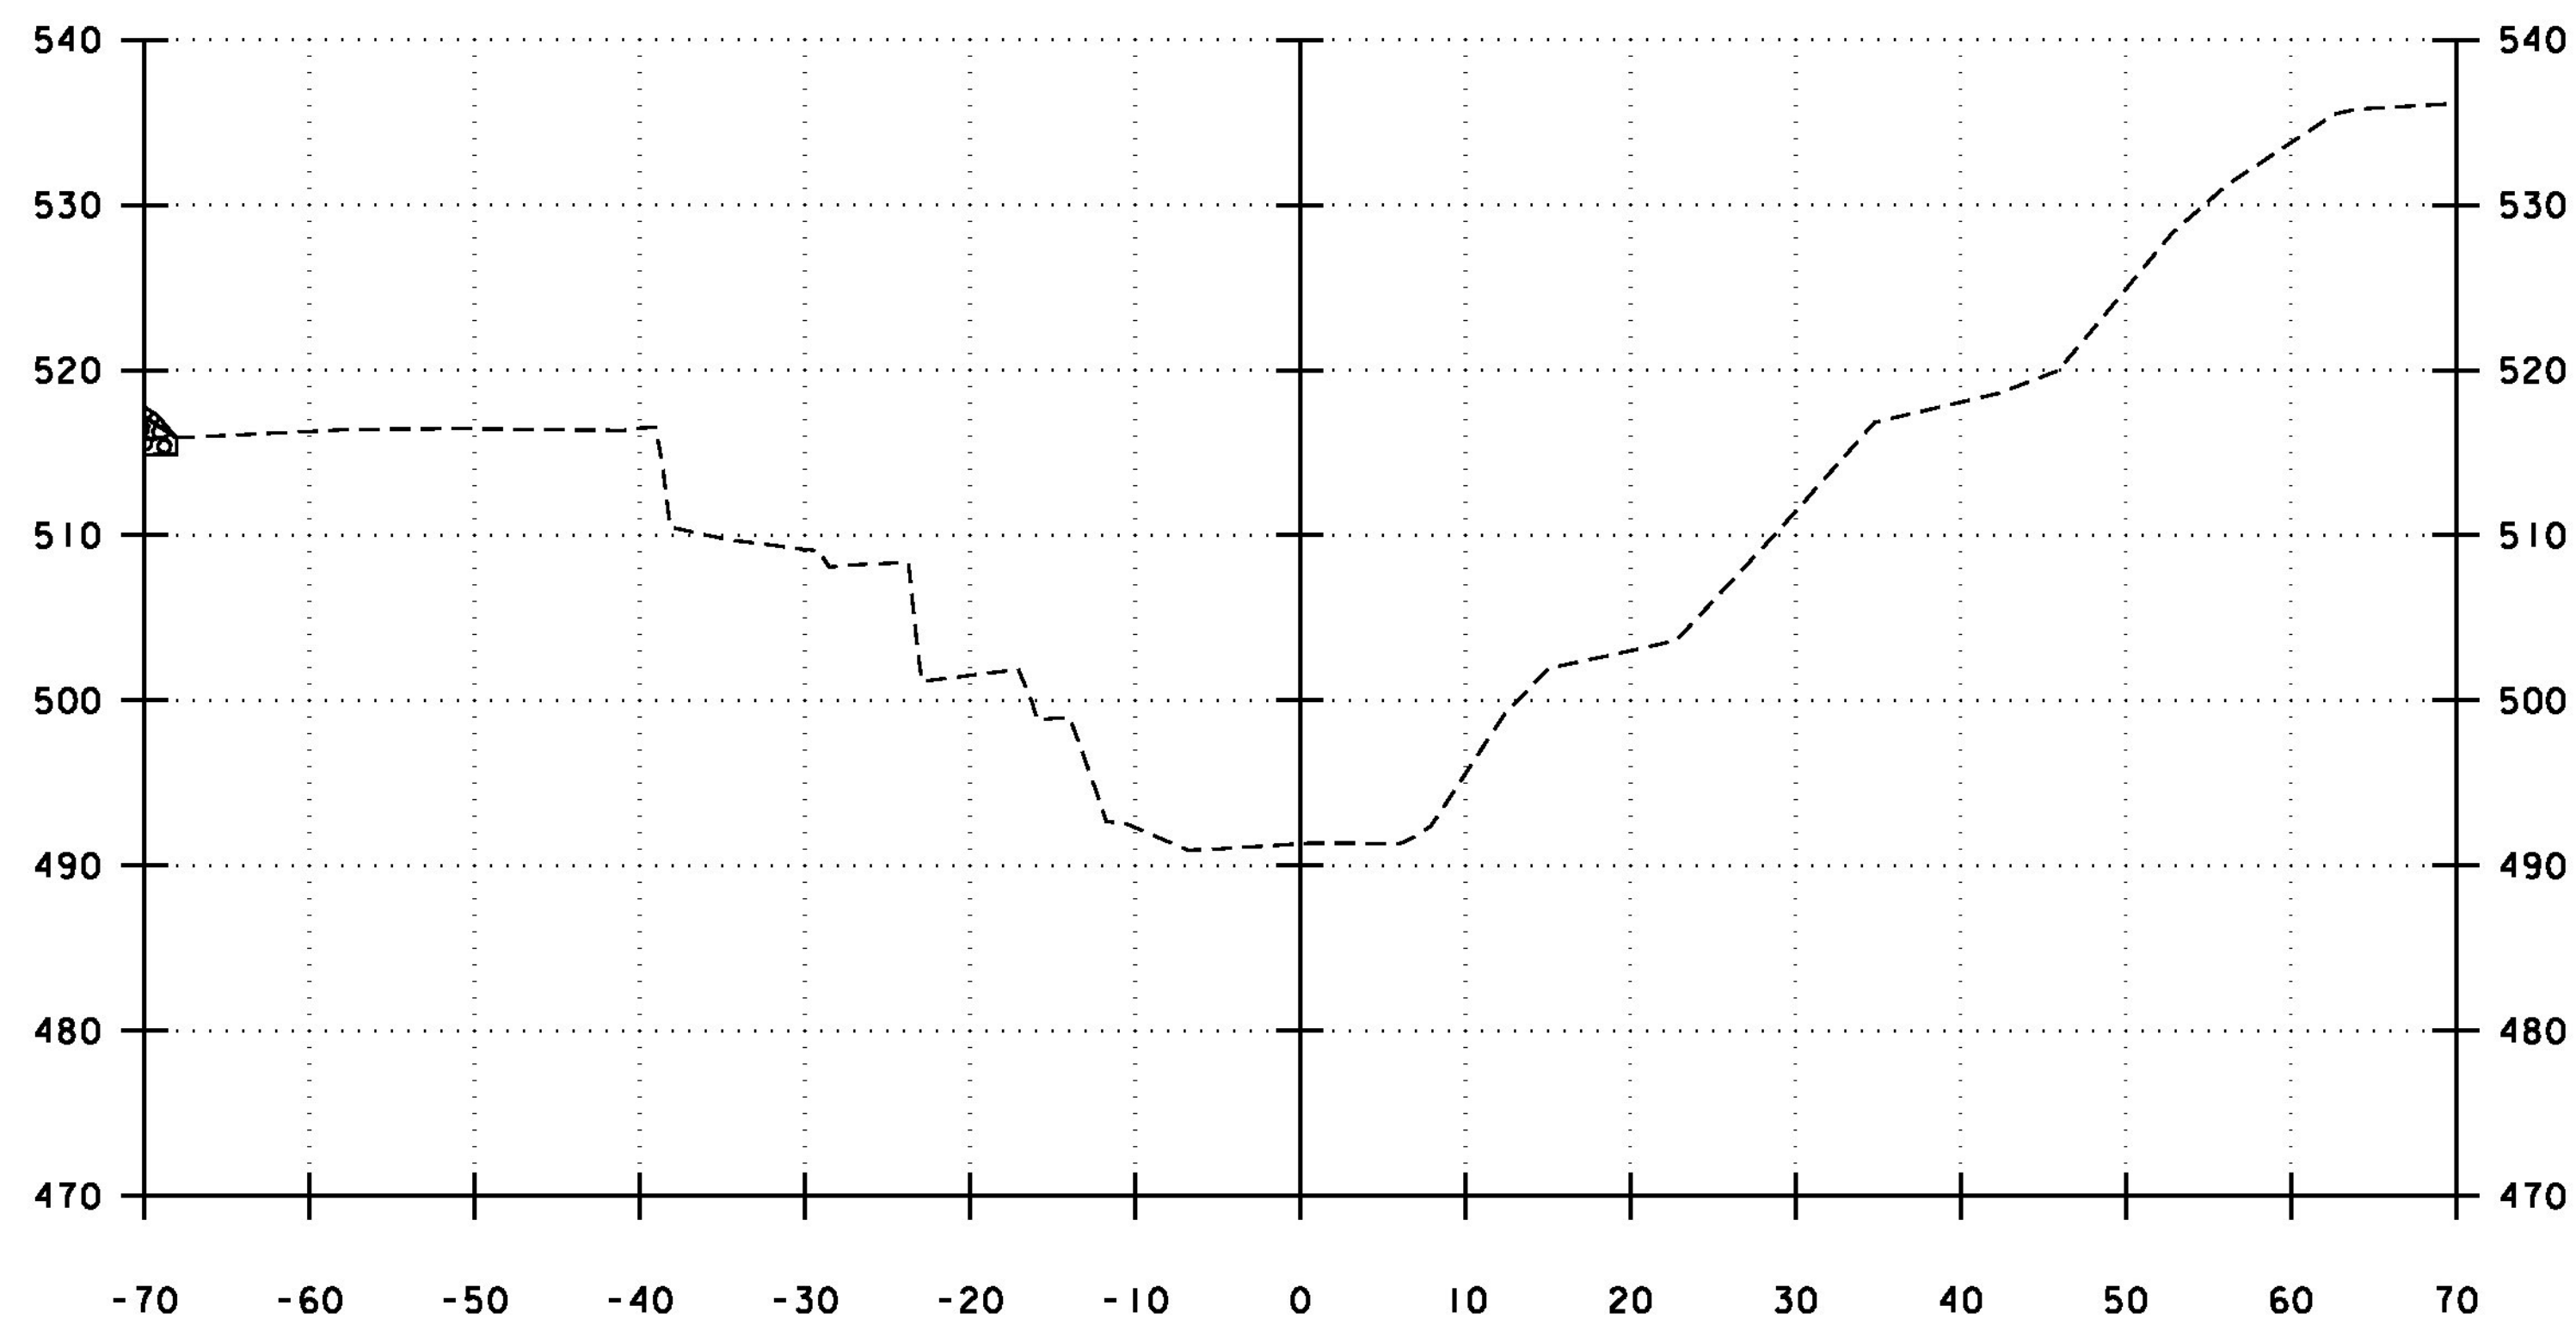

10+50

STA 10+33, LT  
 BEGIN COMMON EXCAVATION FOR STONE FILL  
 GEOTEXTILE UNDER STONE FILL  
 STONE FILL, TYPE II  
 GRUBBING MATERIAL

CHANNEL CROSS SECTIONS

STA 10+00 TO STA 10+75



PROJECT NAME:	MIDDLEBURY	PLOT DATE:	8/27/2013
PROJECT NUMBER:	RS 0174(8)	DRAWN BY:	B.J. MASSE
FILE NAME:	z78f217xsc.dgn	CHECKED BY:	G.L. BAKOS
PROJECT LEADER:	M.A. COLGAN	SHEET	90 OF 104
DESIGNED BY:	D.M. PECK	CHANNEL CROSS SECTION (1 OF 3)	