




10+90

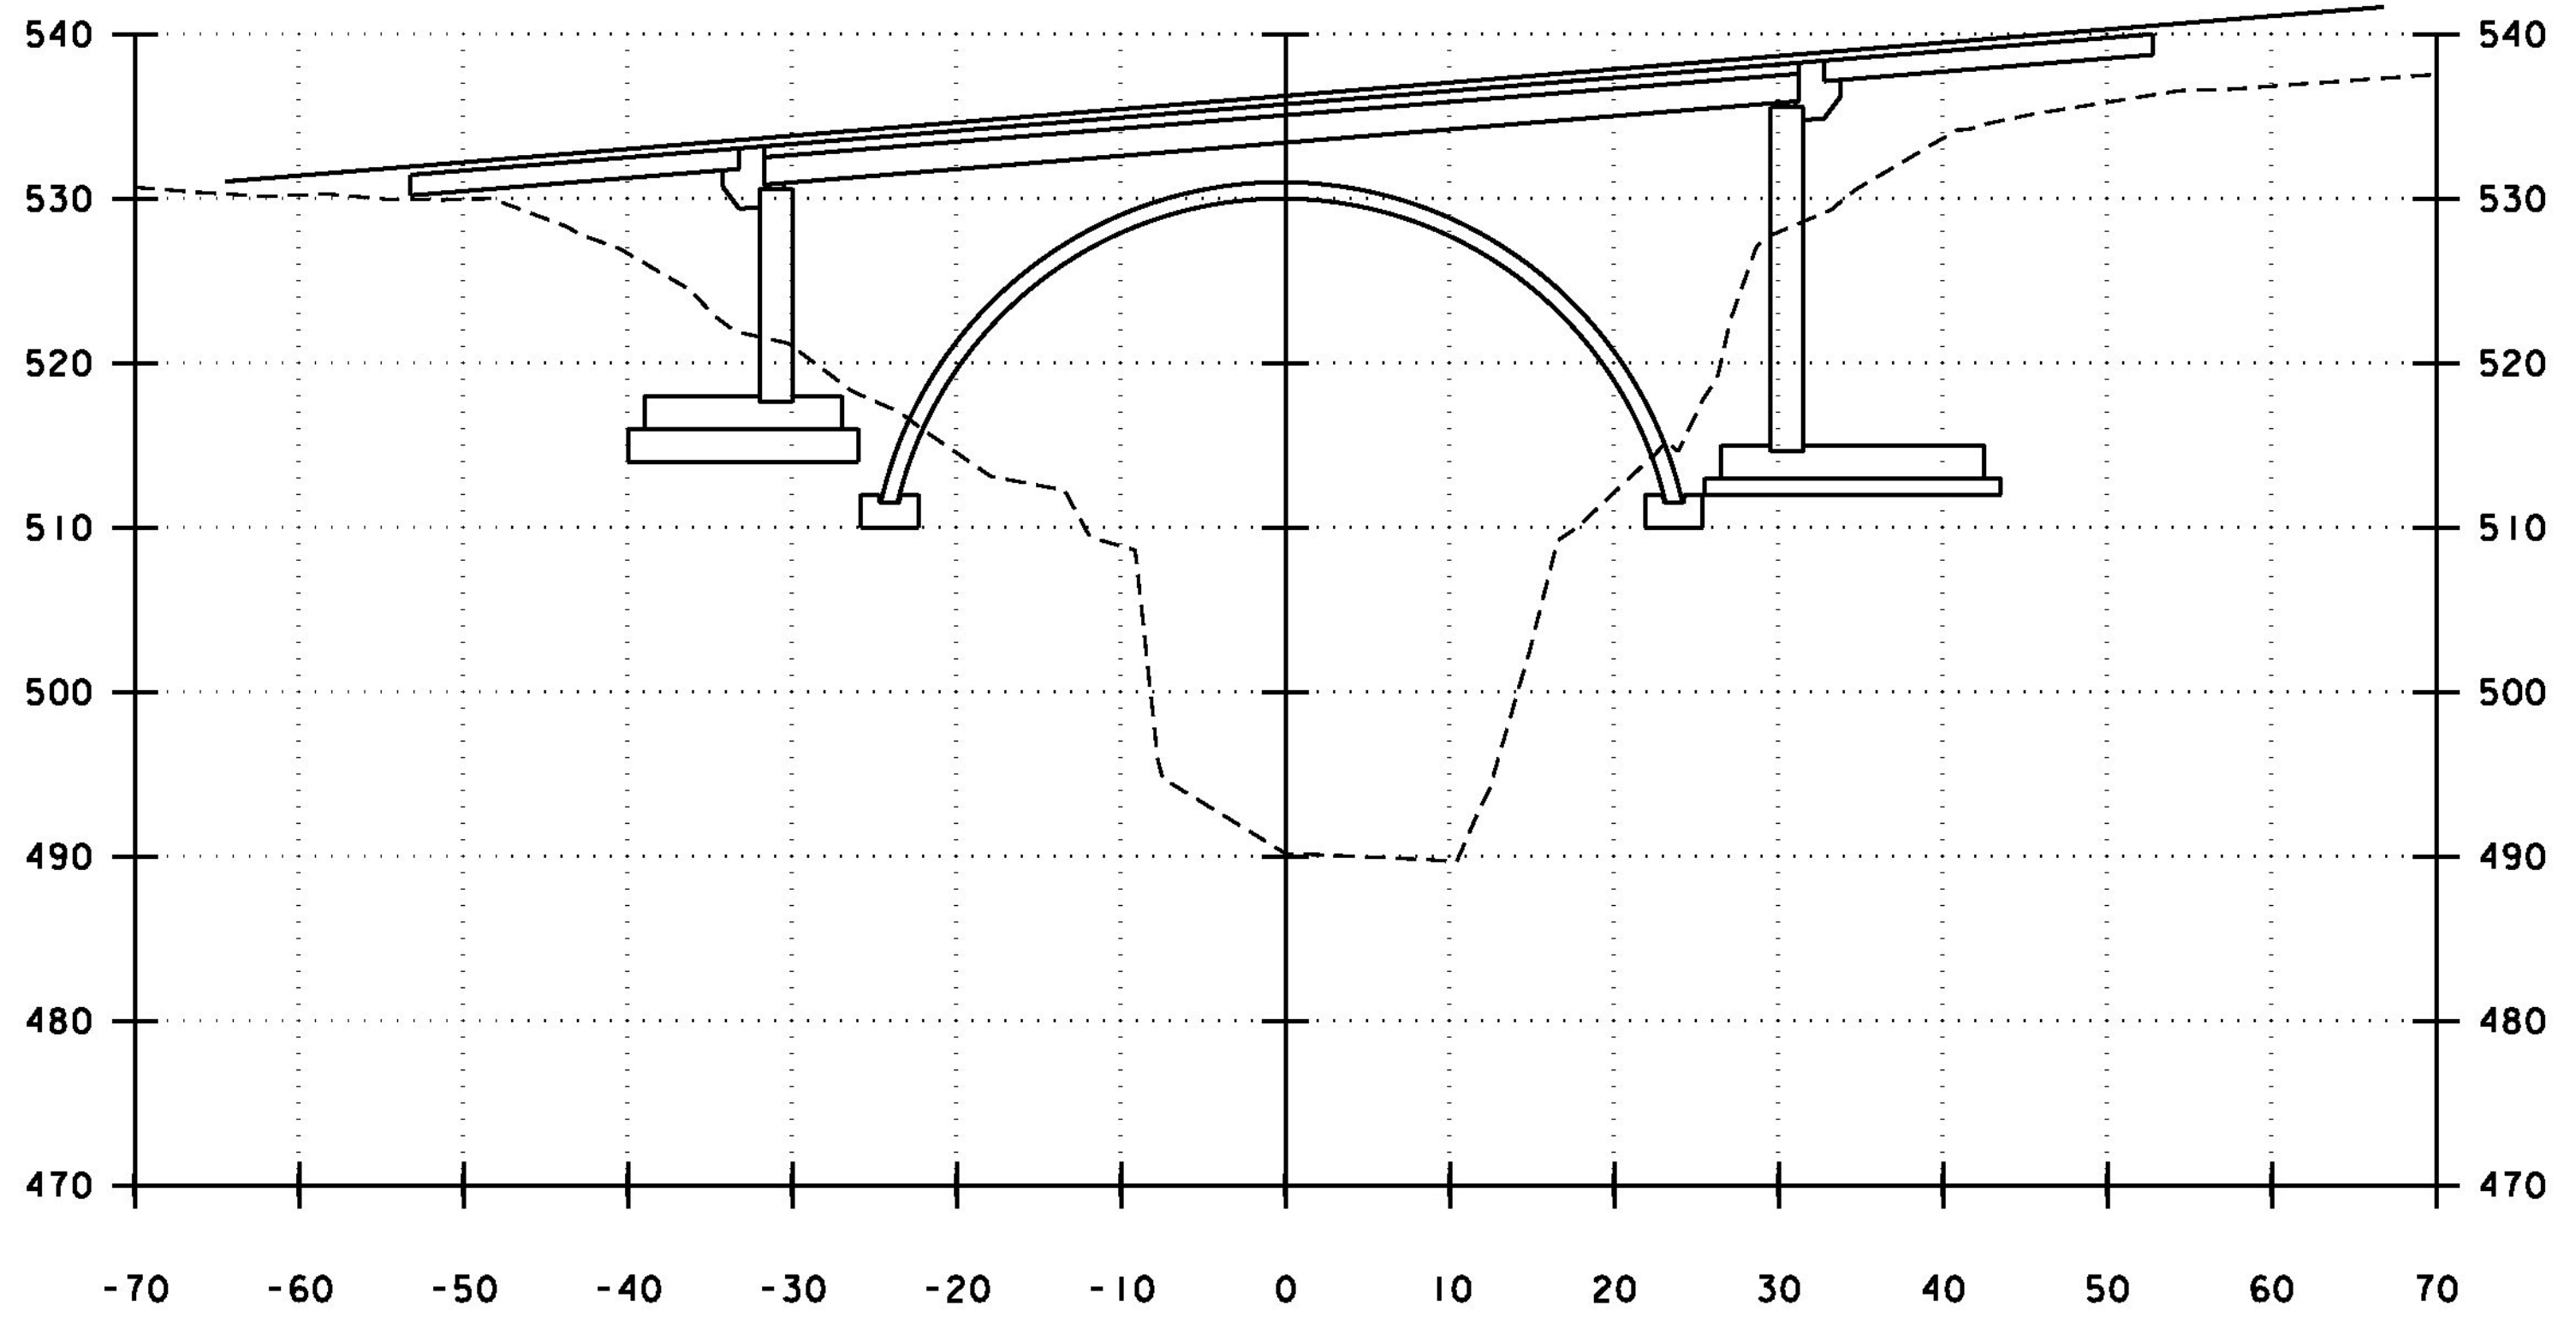

11+10

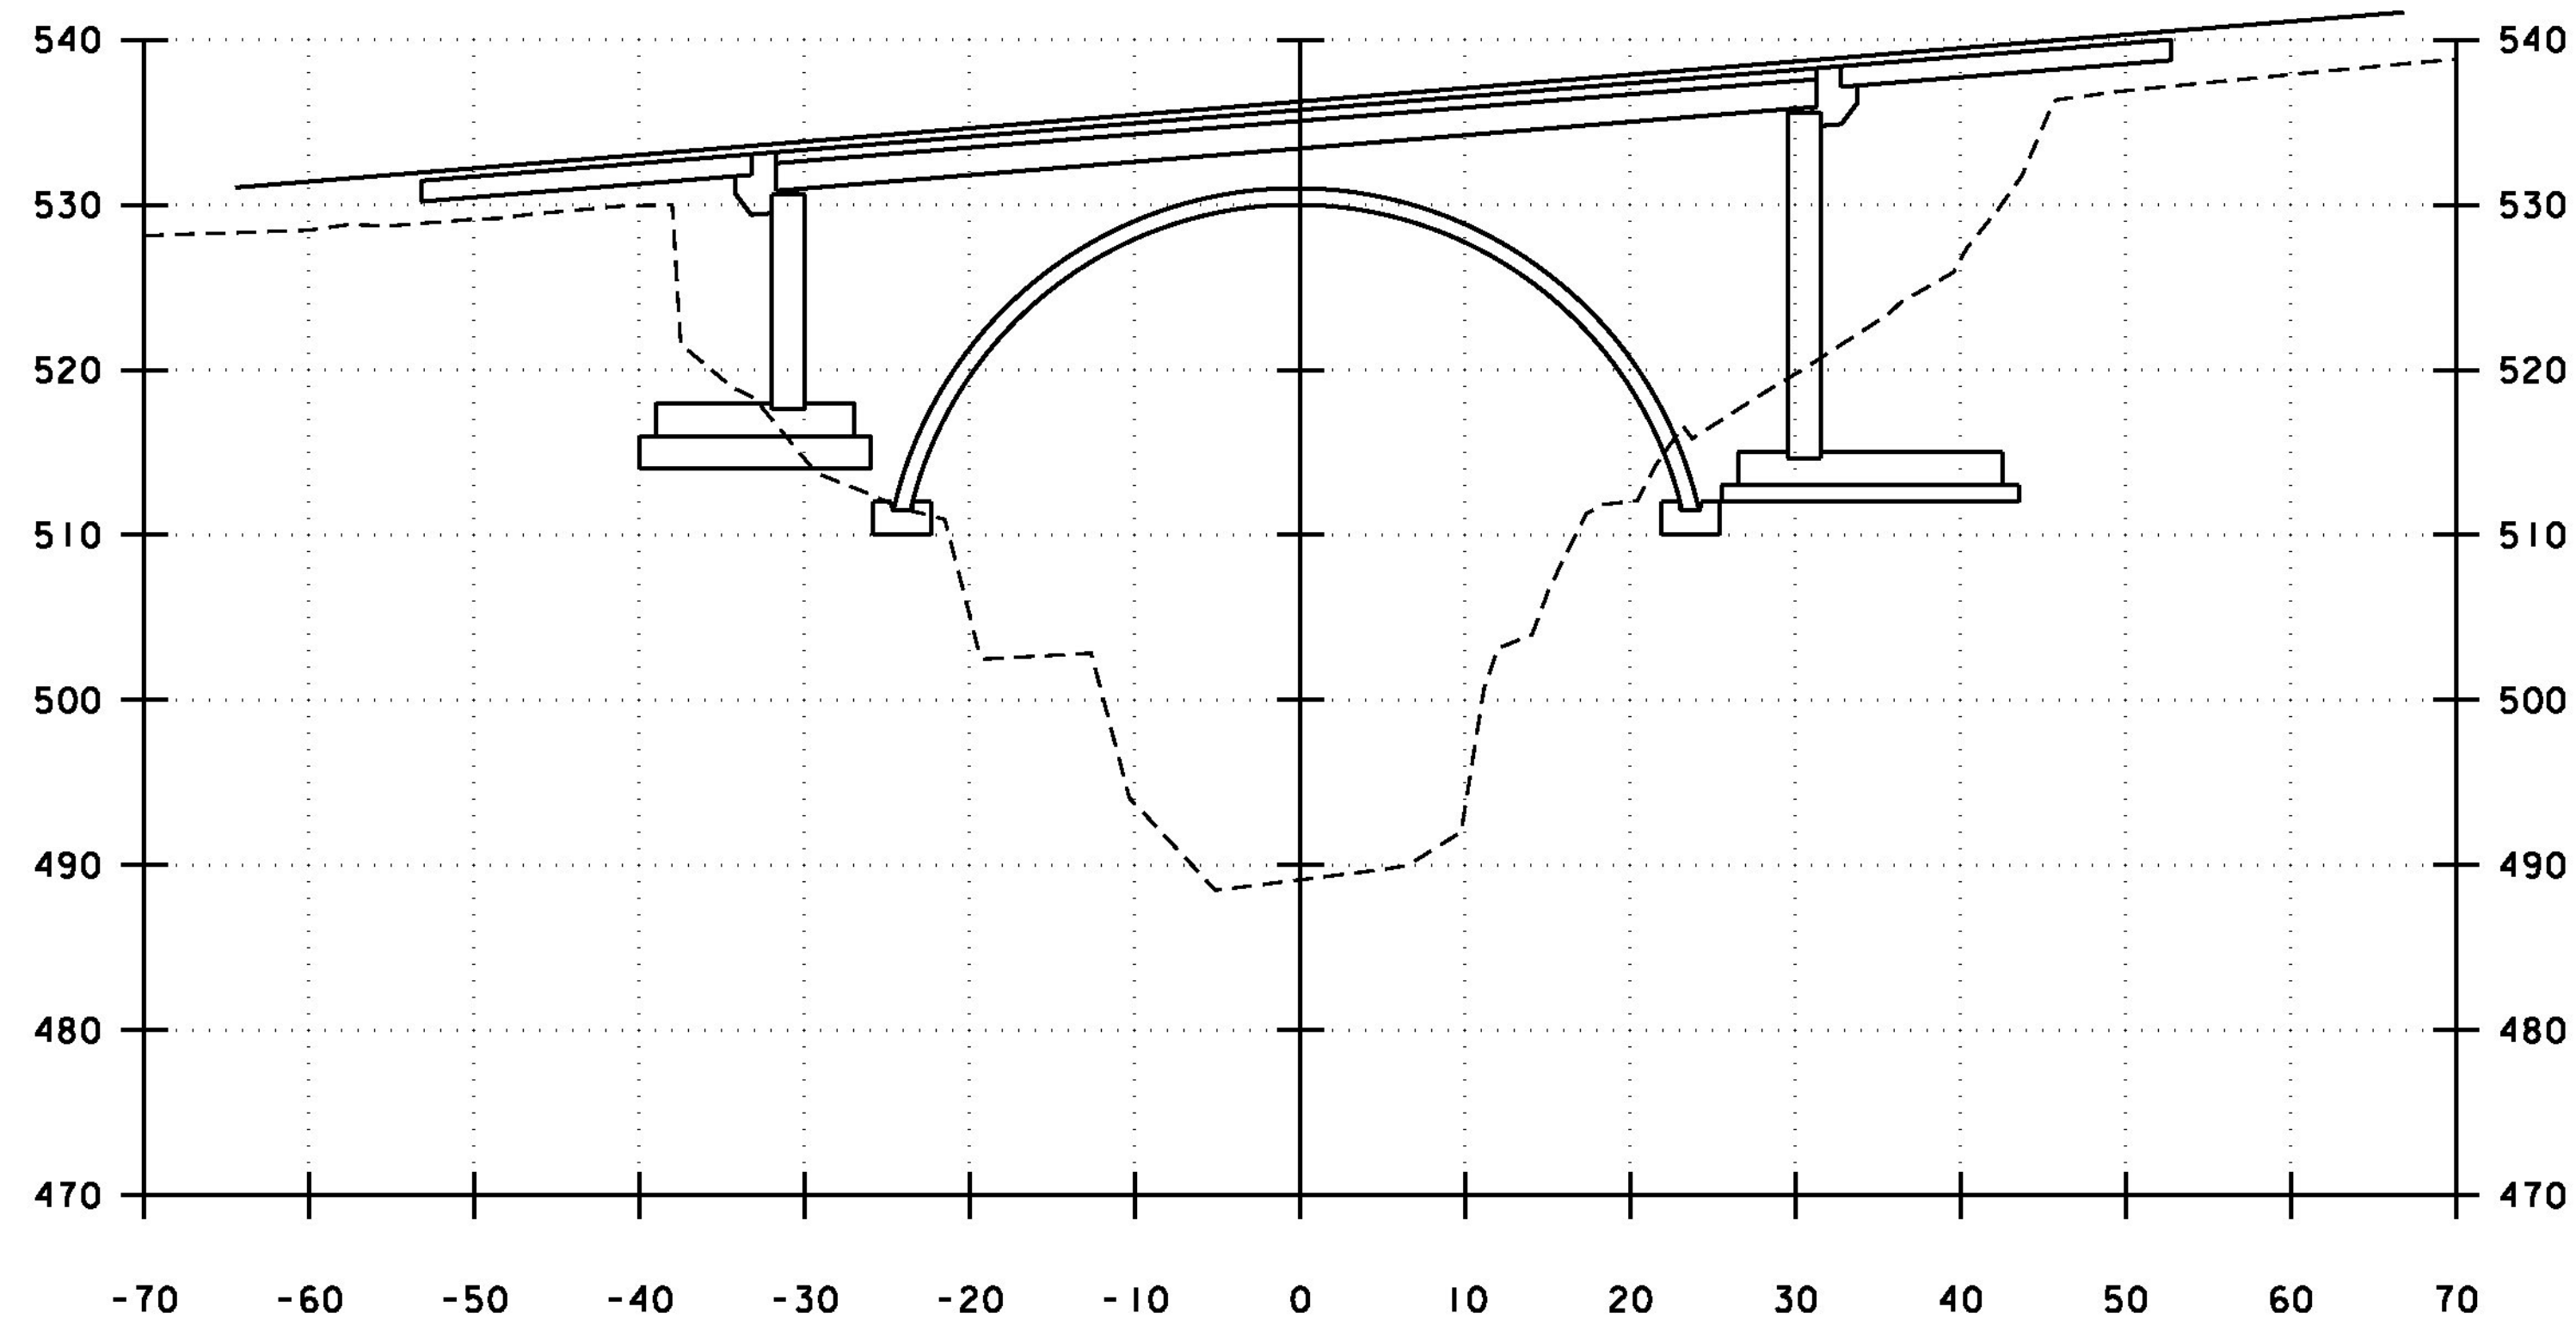

10+80

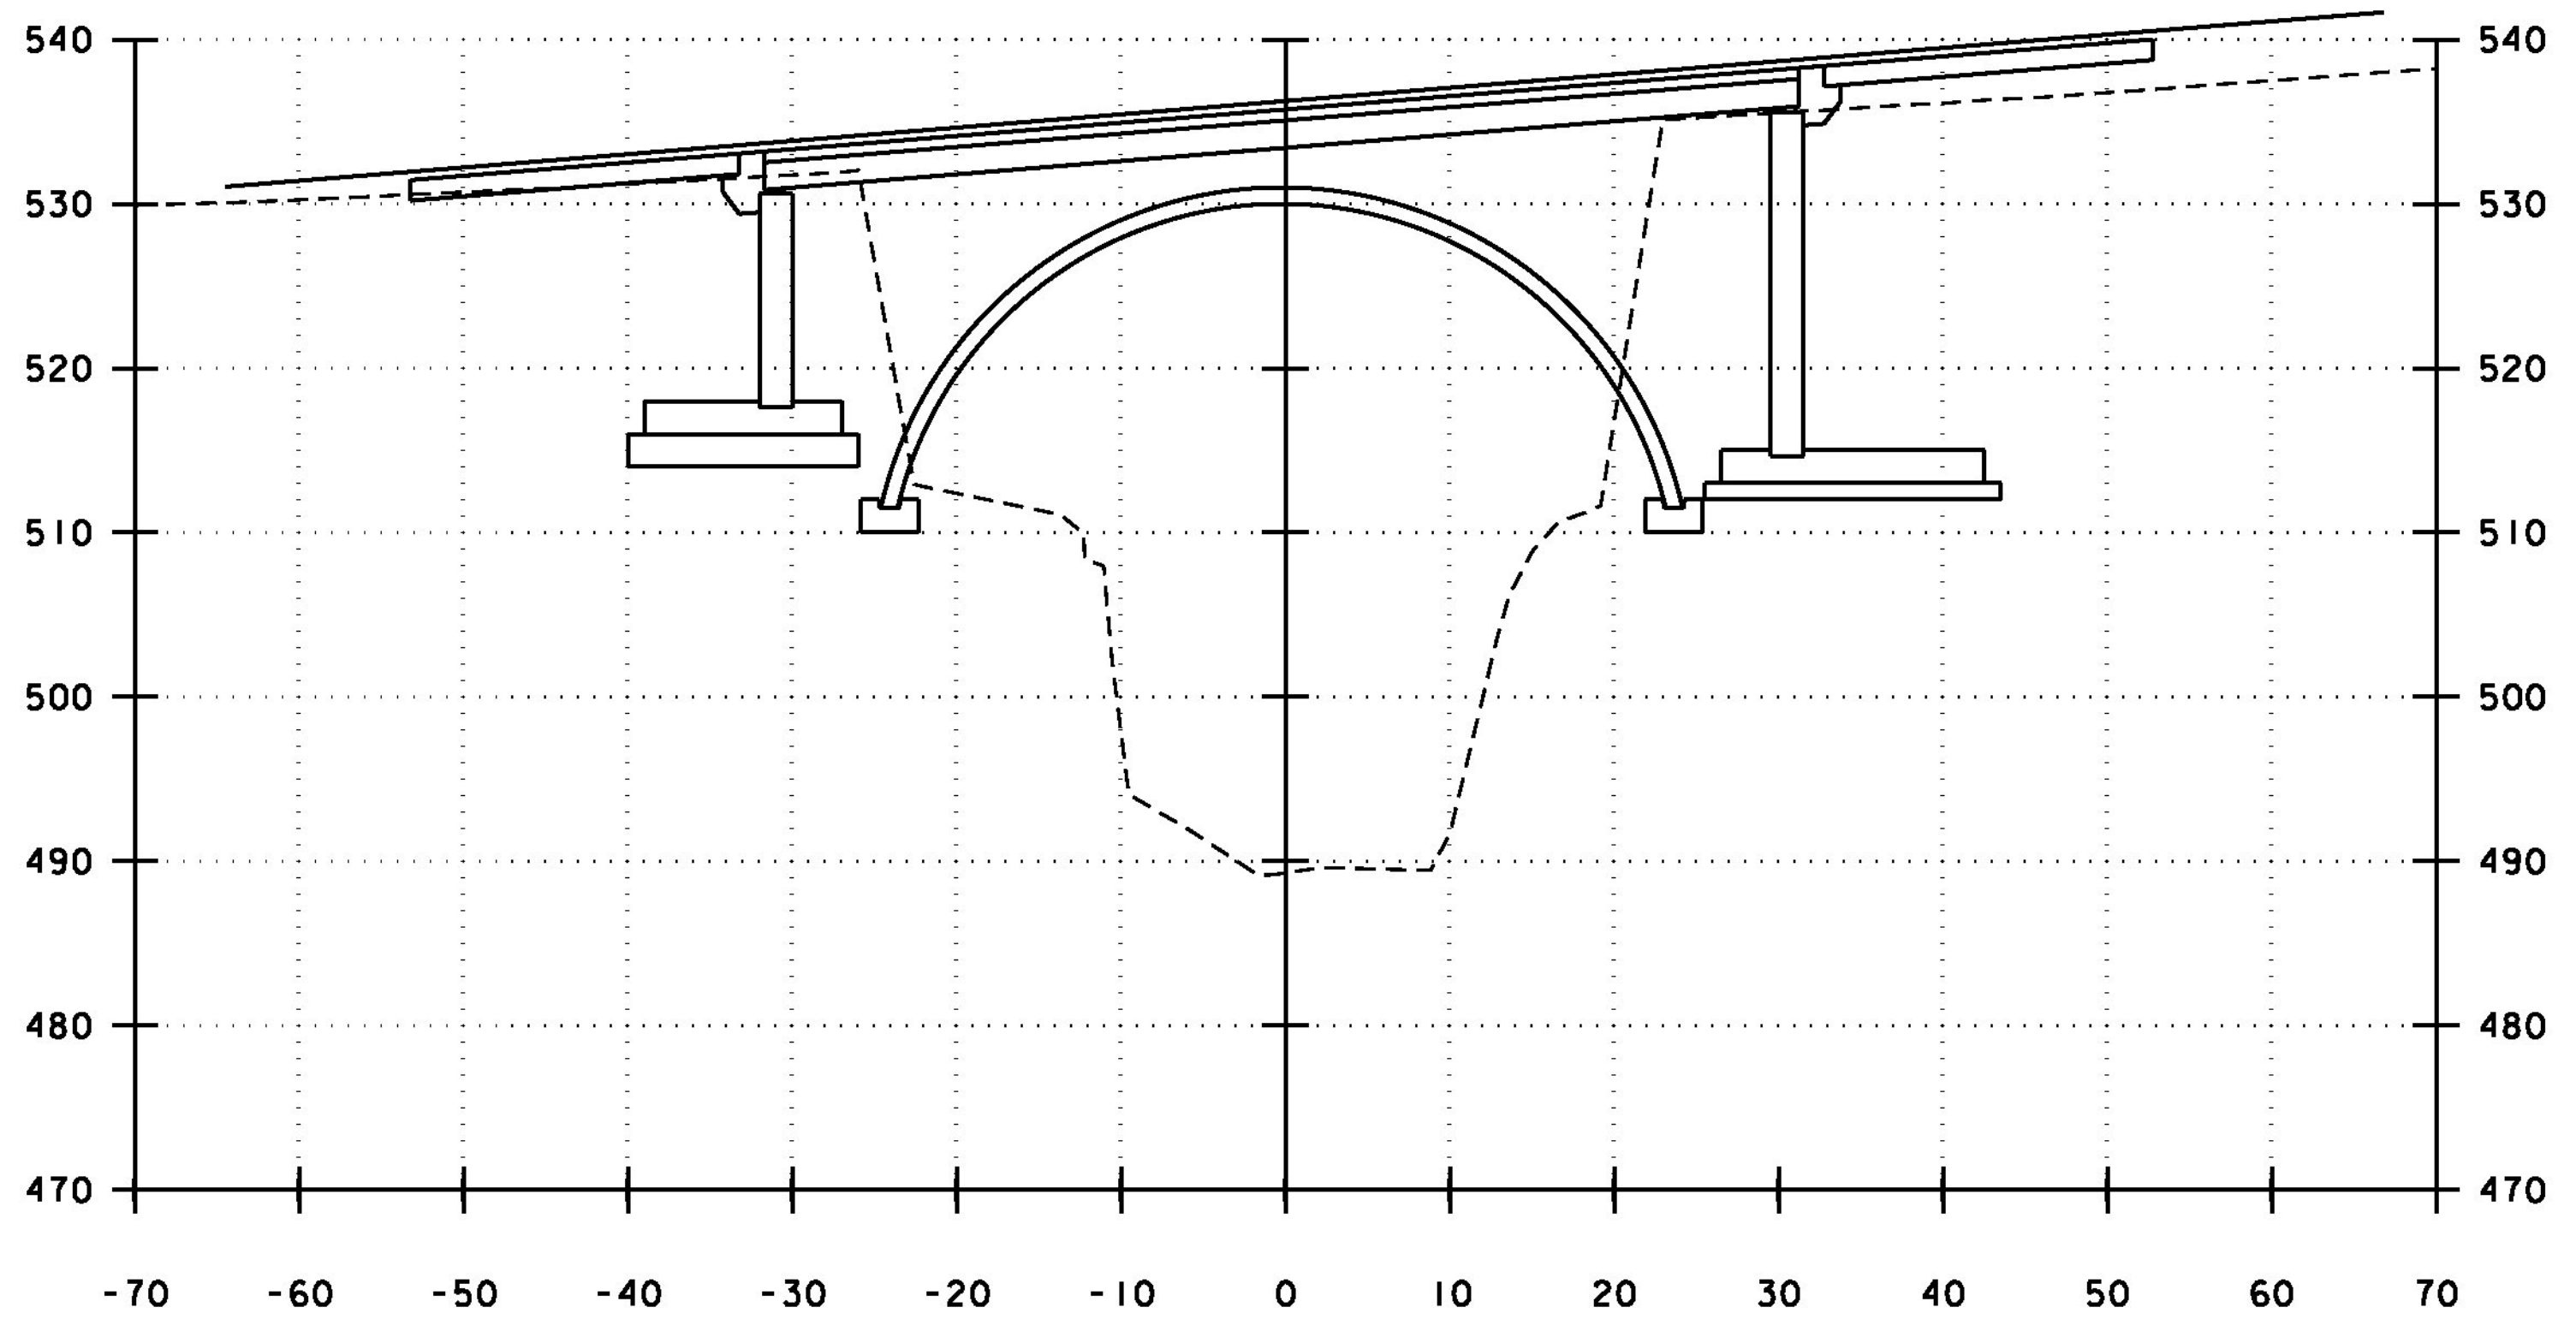

11+00

STA 10+79, LT
 END COMMON EXCAVATION FOR STONE FILL
 GEOTEXTILE UNDER STONE FILL
 STONE FILL, TYPE II
 GRUBBING MATERIAL

STA 10+79, RT
 END COMMON EXCAVATION FOR STONE FILL
 GEOTEXTILE UNDER STONE FILL
 STONE FILL, TYPE II
 GRUBBING MATERIAL

CHANNEL CROSS SECTIONS

STA 10+80 TO STA 11+10



PROJECT NAME:	MIDDLEBURY	PLOT DATE:	8/27/2013
PROJECT NUMBER:	RS 0174(8)	DRAWN BY:	B.J. MASSE
FILE NAME:	z78f217xsc.dgn	DESIGNED BY:	D.M. PECK
PROJECT LEADER:	M.A. COLGAN	CHECKED BY:	G.L. BAKOS
CHANNEL CROSS SECTION (2 OF 3)		SHEET	91 OF 104