


STA 11+32, LT
 END COMMON EXCAVATION FOR STONE FILL
 GEOTEXTILE UNDER STONE FILL
 STONE FILL, TYPE II
 GRUBBING MATERIAL

11+50

STA 11+37, RT
 END COMMON EXCAVATION FOR STONE FILL
 GEOTEXTILE UNDER STONE FILL
 STONE FILL, TYPE II
 GRUBBING MATERIAL

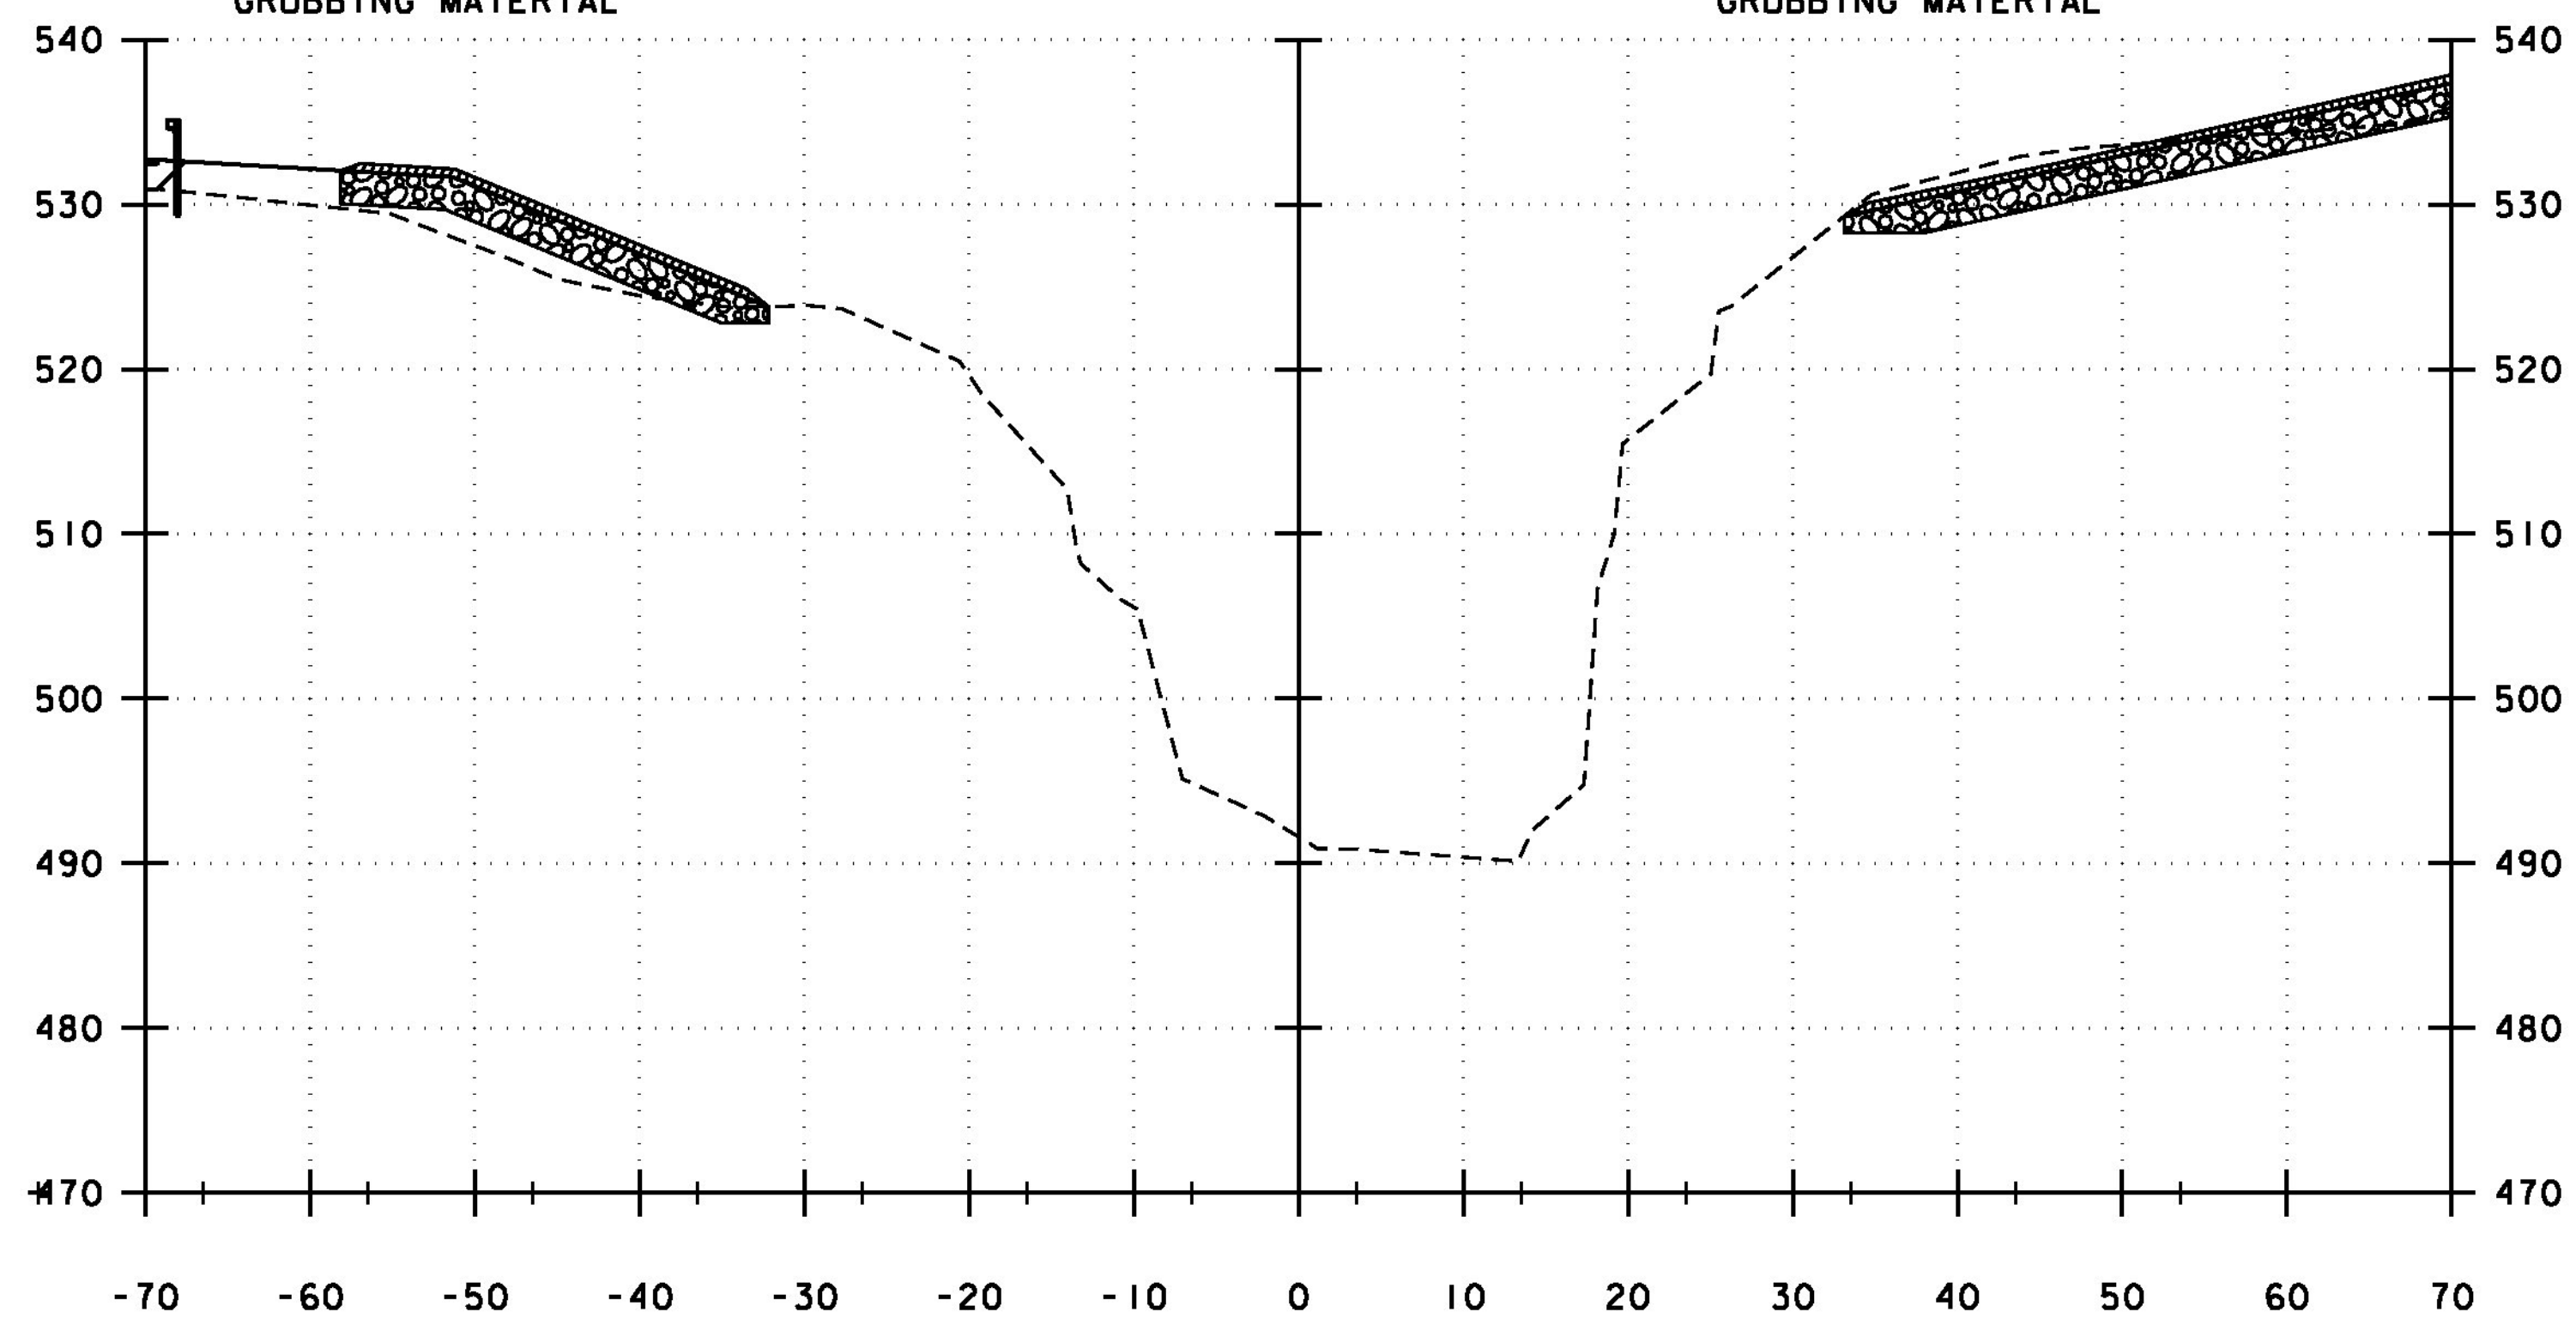

STA 11+16, LT
 BEGIN COMMON EXCAVATION FOR STONE FILL
 GEOTEXTILE UNDER STONE FILL
 STONE FILL, TYPE II
 GRUBBING MATERIAL

11+25

STA 11+16, RT
 BEGIN COMMON EXCAVATION FOR STONE FILL
 GEOTEXTILE UNDER STONE FILL
 STONE FILL, TYPE II
 GRUBBING MATERIAL

CHANNEL CROSS SECTIONS

STA 11+25 TO STA 11+50



PROJECT NAME: MIDDLEBURY	
PROJECT NUMBER: RS 0174(8)	
FILE NAME: z78f217xsc.dgn	PLOT DATE: 8/27/2013
PROJECT LEADER: M.A. COLGAN	DRAWN BY: B.J. MASSE
DESIGNED BY: D.M. PECK	CHECKED BY: G.L. BAKOS
CHANNEL CROSS SECTION (3 OF 3)	SHEET 92 OF 104