




1 PLAN VIEW - ABUMENT - 1
1/4" = 1'-0"

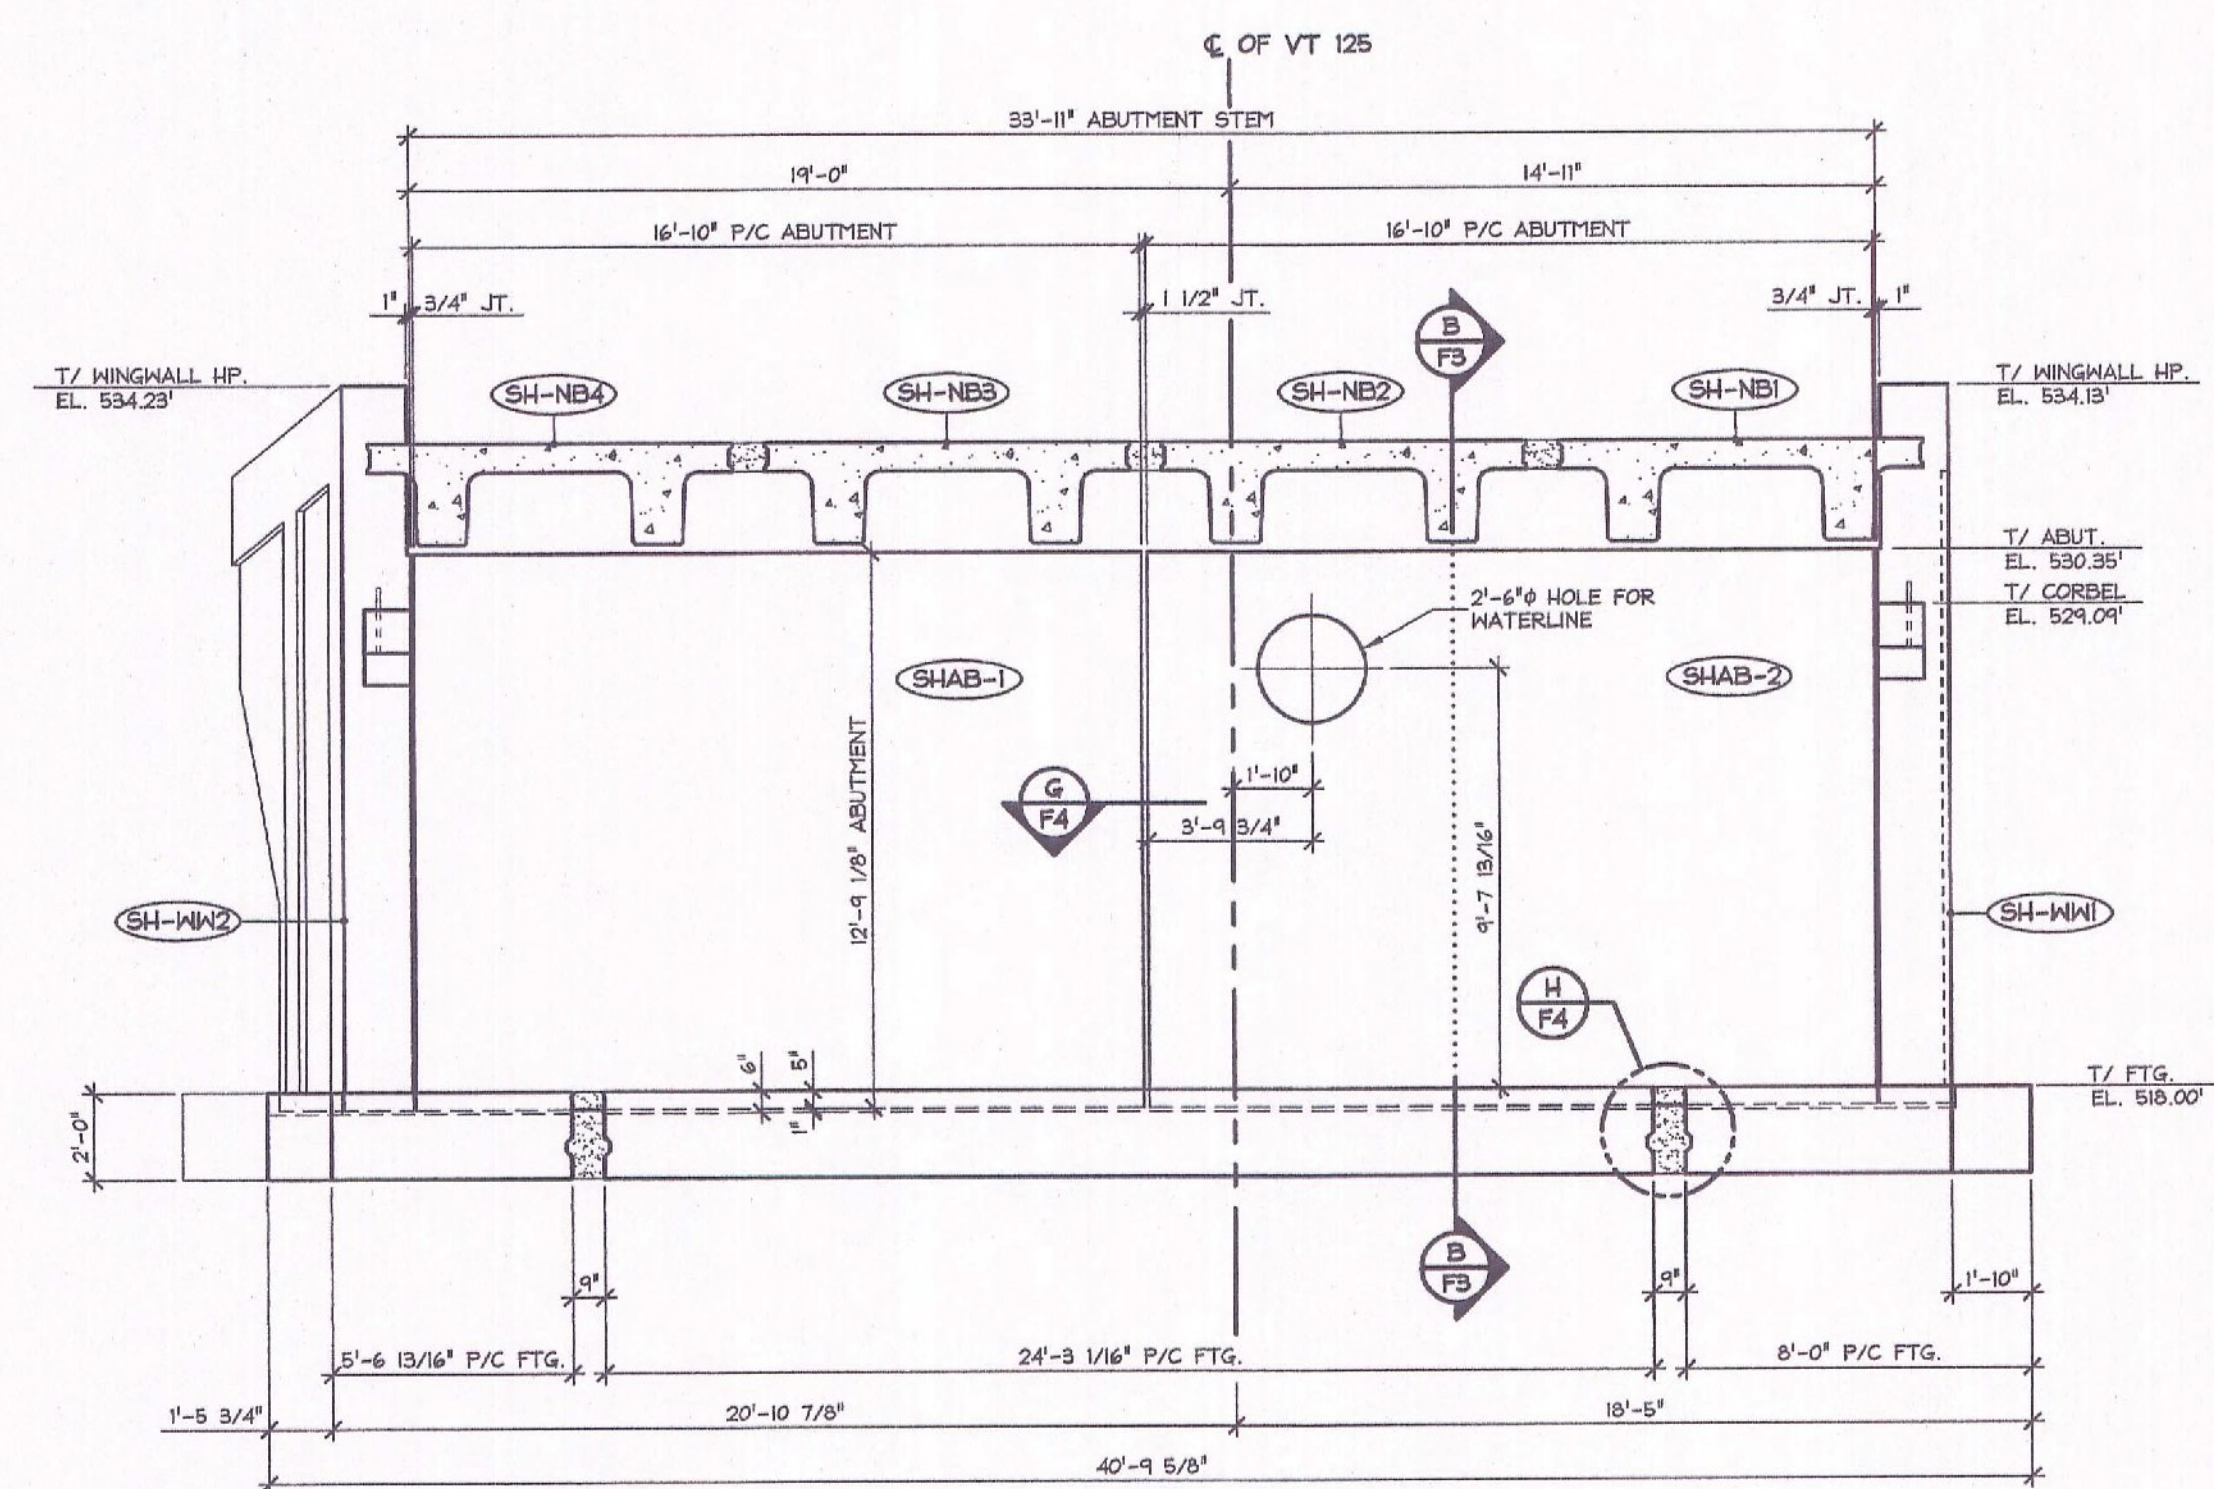

2 SOUTH ELEVATION - ABUMENT - 1
1/4" = 1'-0"

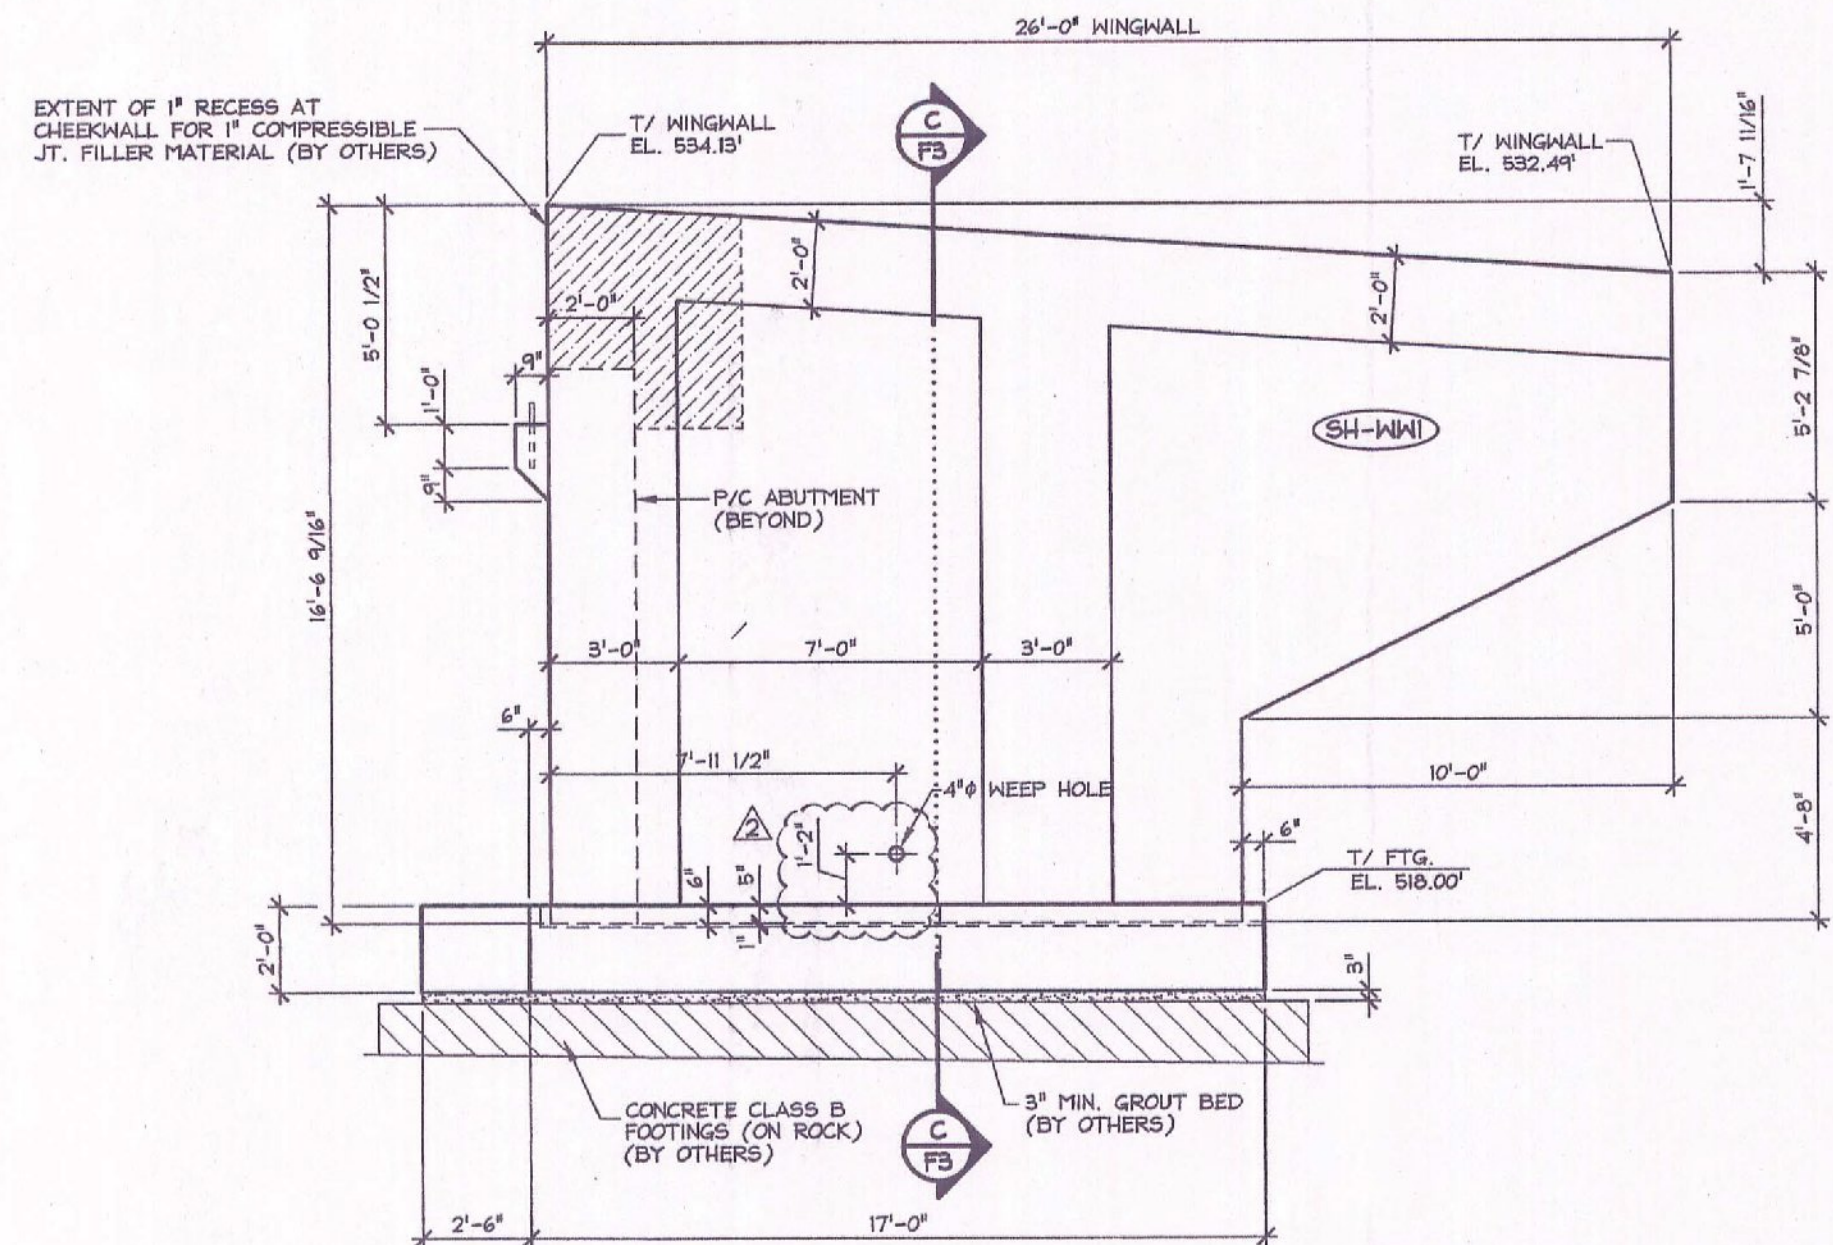

3 EAST ELEVATION - WINGWALL - 1
1/4" = 1'-0"

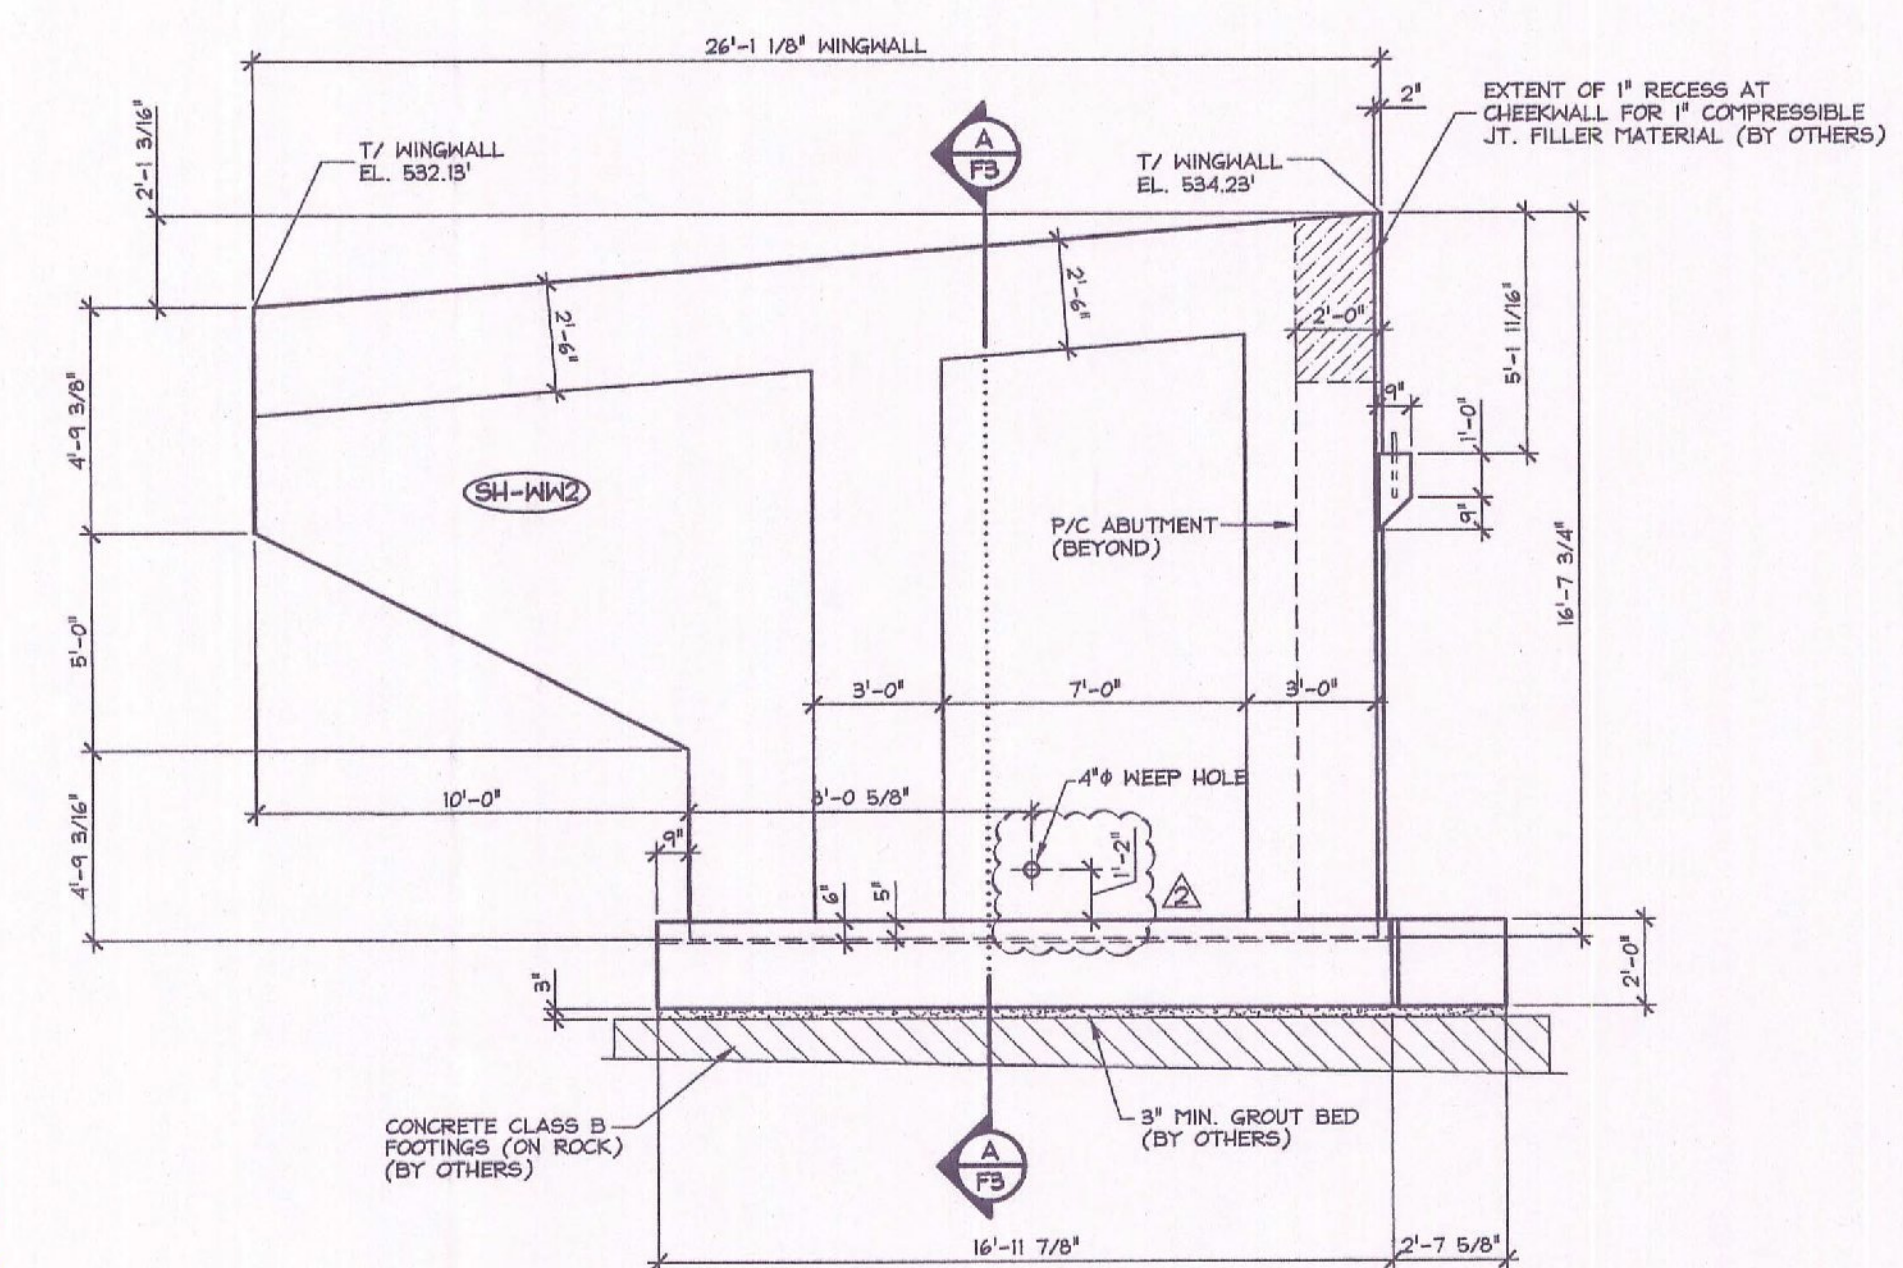

4 WEST ELEVATION - WINGWALL - 2
1/4" = 1'-0"

Vermont Agency of Transportation
RECEIVED
 ON: February 3, 2014
 and Checked for
CONFORMANCE
 BY: Jennifer Fitch DATE: 02/04/2014

SHOP DRAWING REVIEW

REVIEWED AS REQUIRED BY THE CONSTRUCTION CONTRACT DOCUMENTS AND APPROVED, BUT ONLY FOR CONFORMANCE TO THE DESIGN CONCEPT OF THE WORK, AND SUBJECT TO FURTHER LIMITATIONS AND REQUIREMENTS CONTAINED IN THE CONSTRUCTION CONTRACT DOCUMENTS.

REJECTED REVISE AND RESUBMIT FURNISH AS CORRECTED

CORRECTIONS OR COMMENTS MADE ON THE SHOP DRAWINGS DURING THE REVIEW DO NOT RELIEVE CONTRACTOR FROM COMPLIANCE WITH REQUIREMENTS OF THE SPECIFICATIONS AND SPECIFICATIONS. THIS CHECK IS ONLY FOR REVIEW OF GENERAL CONFORMANCE WITH THE DESIGN CONCEPT OF THE PROJECT AND GENERAL COMPLIANCE WITH THE INFORMATION GIVEN IN THE CONTRACT DOCUMENTS. THE CONTRACTOR IS RESPONSIBLE FOR CORRECTING AND CORRELATING ALL QUANTITIES AND DIMENSIONS, SELECTING FABRICATION PROCESSES AND TECHNIQUES OF CONSTRUCTION, COORDINATING HIS WORK WITH THAT OF ALL OTHER TRADES, AND PERFORMING HIS WORK IN A SAFE AND SATISFACTORY MANNER.

VHB Job Number: 57432
 Reviewed By: M.J. Mozer
 Date: 2.3.2014
 Vermont Hanger Brackets, Inc.

APPROVAL STAMP:

| | |
|--|---|
| J.P. CARRARA & SONS INC. Precast & Prestress Manufacturer 244 ONE ST. MIDDLEBURY, VERMONT 05753 Phone: (802)388-6261 Fax: (802)388-2010 | T. BUCK CONSTRUCTION CONTRACTOR AUBURN, MAINE |
| | DATE: OCT. 9, 2013 SCALE: NOTED CHKD: DFTM: T.D. JOB NO: 23411-013 |
| STATE OF VERMONT AGENCY OF TRANSPORTATION COUNTY OF ADDISON | |
| TOWN OF MIDDLEBURY ROUTE NO. VT 125, EAST MIDDLEBURY GORGE BRIDGE NO. 13 PROJECT NO. RS 0174(8) | |
| ABUTMENT 1 LAYOUT & DETAILS | |
| DWG. NO: F2 | |

SUBMITTED
 JAN 31 2014
 J. P. CARRARA & SONS, INC.
 MIDDLEBURY, VT 05753