


SH-AB001
2x4 BENT BAR
BLACK
(N) REVD.

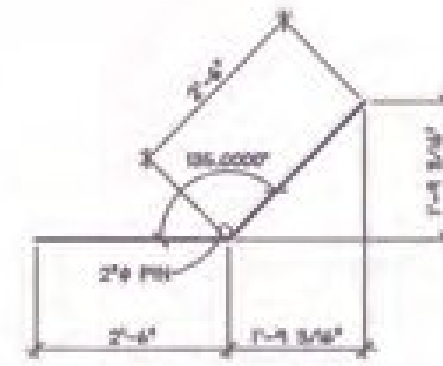

SH-AB002
2x4 BENT BAR
BLACK
(A) REVD.

MISCELLANEOUS MATERIALS				
ITEM	MARK	QTY.	DESCRIPTION	REMARKS
1		02	95 x 4'-0" (BLACK)	
2		34	95 x 12'-0" (BLACK)	
3		02	95 x 18'-0" (BLACK)	
4		126	95 x 10'-7 3/4" (BLACK)	
5		34	95 x 12'-0 1/2" (BLACK)	
6		46	95 x 12'-0" (BLACK)	
7		42	95 x 12'-0" (BLACK)	
8				
9	SH-AB001	60	95 BENT BAR (BLACK)	SEE DETAIL THIS SHEET
10	SH-AB002	4	95 BENT BAR (BLACK)	SEE DETAIL THIS SHEET
11				
12		30	20T x 1/4 3/4" SHFT LIFT ANCHOR W/ RECESS PLUG (BLACK)	
13				
14		25	DAYTON 5/16" F-42 INSERT (GALV.)	
15		60	95-X 95B SPLICE SLEEVE (BLACK)	
16		46	95-X 95B SPLICE SLEEVE (BLACK)	
17		42	95-X 95B SPLICE SLEEVE (BLACK)	
18				
19				
20				

Vermont Agency of Transportation
RECEIVED
 ON: January 28, 2014
 and Checked for
CONFORMANCE
 BY: Jennifer Fitch DATE: 02/04/2014

SUBMITTED
 JAN 27 2014
 J. P. Carrara & Sons, Inc.
 Manchester, VT 05753

SHOP DRAWING REVIEW

REVIEWED AS REQUIRED BY THE CONSTRUCTION CONTRACT DOCUMENTS AND APPROVED, BUT ONLY FOR CONFORMANCE TO THE DESIGN CONCEPT OF THE WORK, AND SUBJECT TO FURTHER LIMITATIONS AND REQUIREMENTS CONTAINED IN THE CONSTRUCTION CONTRACT DOCUMENTS.

ALIASED CHANGED AND REVISIONS NUMBER OF COMMENTS

CONTRACTOR SHALL BE RESPONSIBLE FOR THE SHOP DRAWING CONTENT AND ACCURACY. REVIEW CONTRACTOR FROM CONTRACT AND REQUIREMENTS OF THE DRAWINGS AND SPECIFICATIONS. REVISIONS SHALL BE PROVIDED OR DENIAL, COMPATIBLE WITH THE DESIGN CONCEPT OF THE PROJECT AND ORIGINAL, DOWN-LOADED FROM THE INFORMATION SYSTEM BY THE CONTRACT DOCUMENTS. THE CONTRACTOR IS RESPONSIBLE FOR THE CONTRACTOR AND REVIEWER'S SIGNATURE AND APPROVAL. SIGNATURES SHALL BE PROVIDED TO THE CONTRACTOR AND APPROVED. SIGNATURES SHALL BE PROVIDED TO THE CONTRACTOR AND APPROVED. SIGNATURES SHALL BE PROVIDED TO THE CONTRACTOR AND APPROVED. SIGNATURES SHALL BE PROVIDED TO THE CONTRACTOR AND APPROVED.

VHB Job Number: 57438
 Prepared By: M.S. Mozer
 Date: 1-31-2014

1/27/14 GENERAL REVISION T.D.

APPROVAL STAMP:	J.P. CARRARA & SONS INC. Precast & Prestress Manufacturer 104 104 ST., BRISTOL, VERMONT 05703 Phone: (802)288-6201 Fax: (802)288-6102	T. BUCK CONSTRUCTION CONTRACTOR AUBURN, MAINE
	STATE OF VERMONT AGENCY OF TRANSPORTATION COUNTY OF ADDISON	DATE: OCT. 9, 2013 SCALE: NOTED
	TOWN OF MIDDLEBURY ROUTE NO. VT 128, EAST MIDDLEBURY GORGE BRIDGE NO. 15 PROJECT NO.: RS 0174(0)	CHKD: DFM: T.D. JOB NO: 25411-015
	P/C ABUTMENT MATERIAL LIST	DWG. NO.: ABM1