

Vermont Agency of Transportation


RECEIVED

ON: June 26, 2014

and Checked for

CONFORMANCE

BY: Jennifer Fitch DATE: 06/30/2014

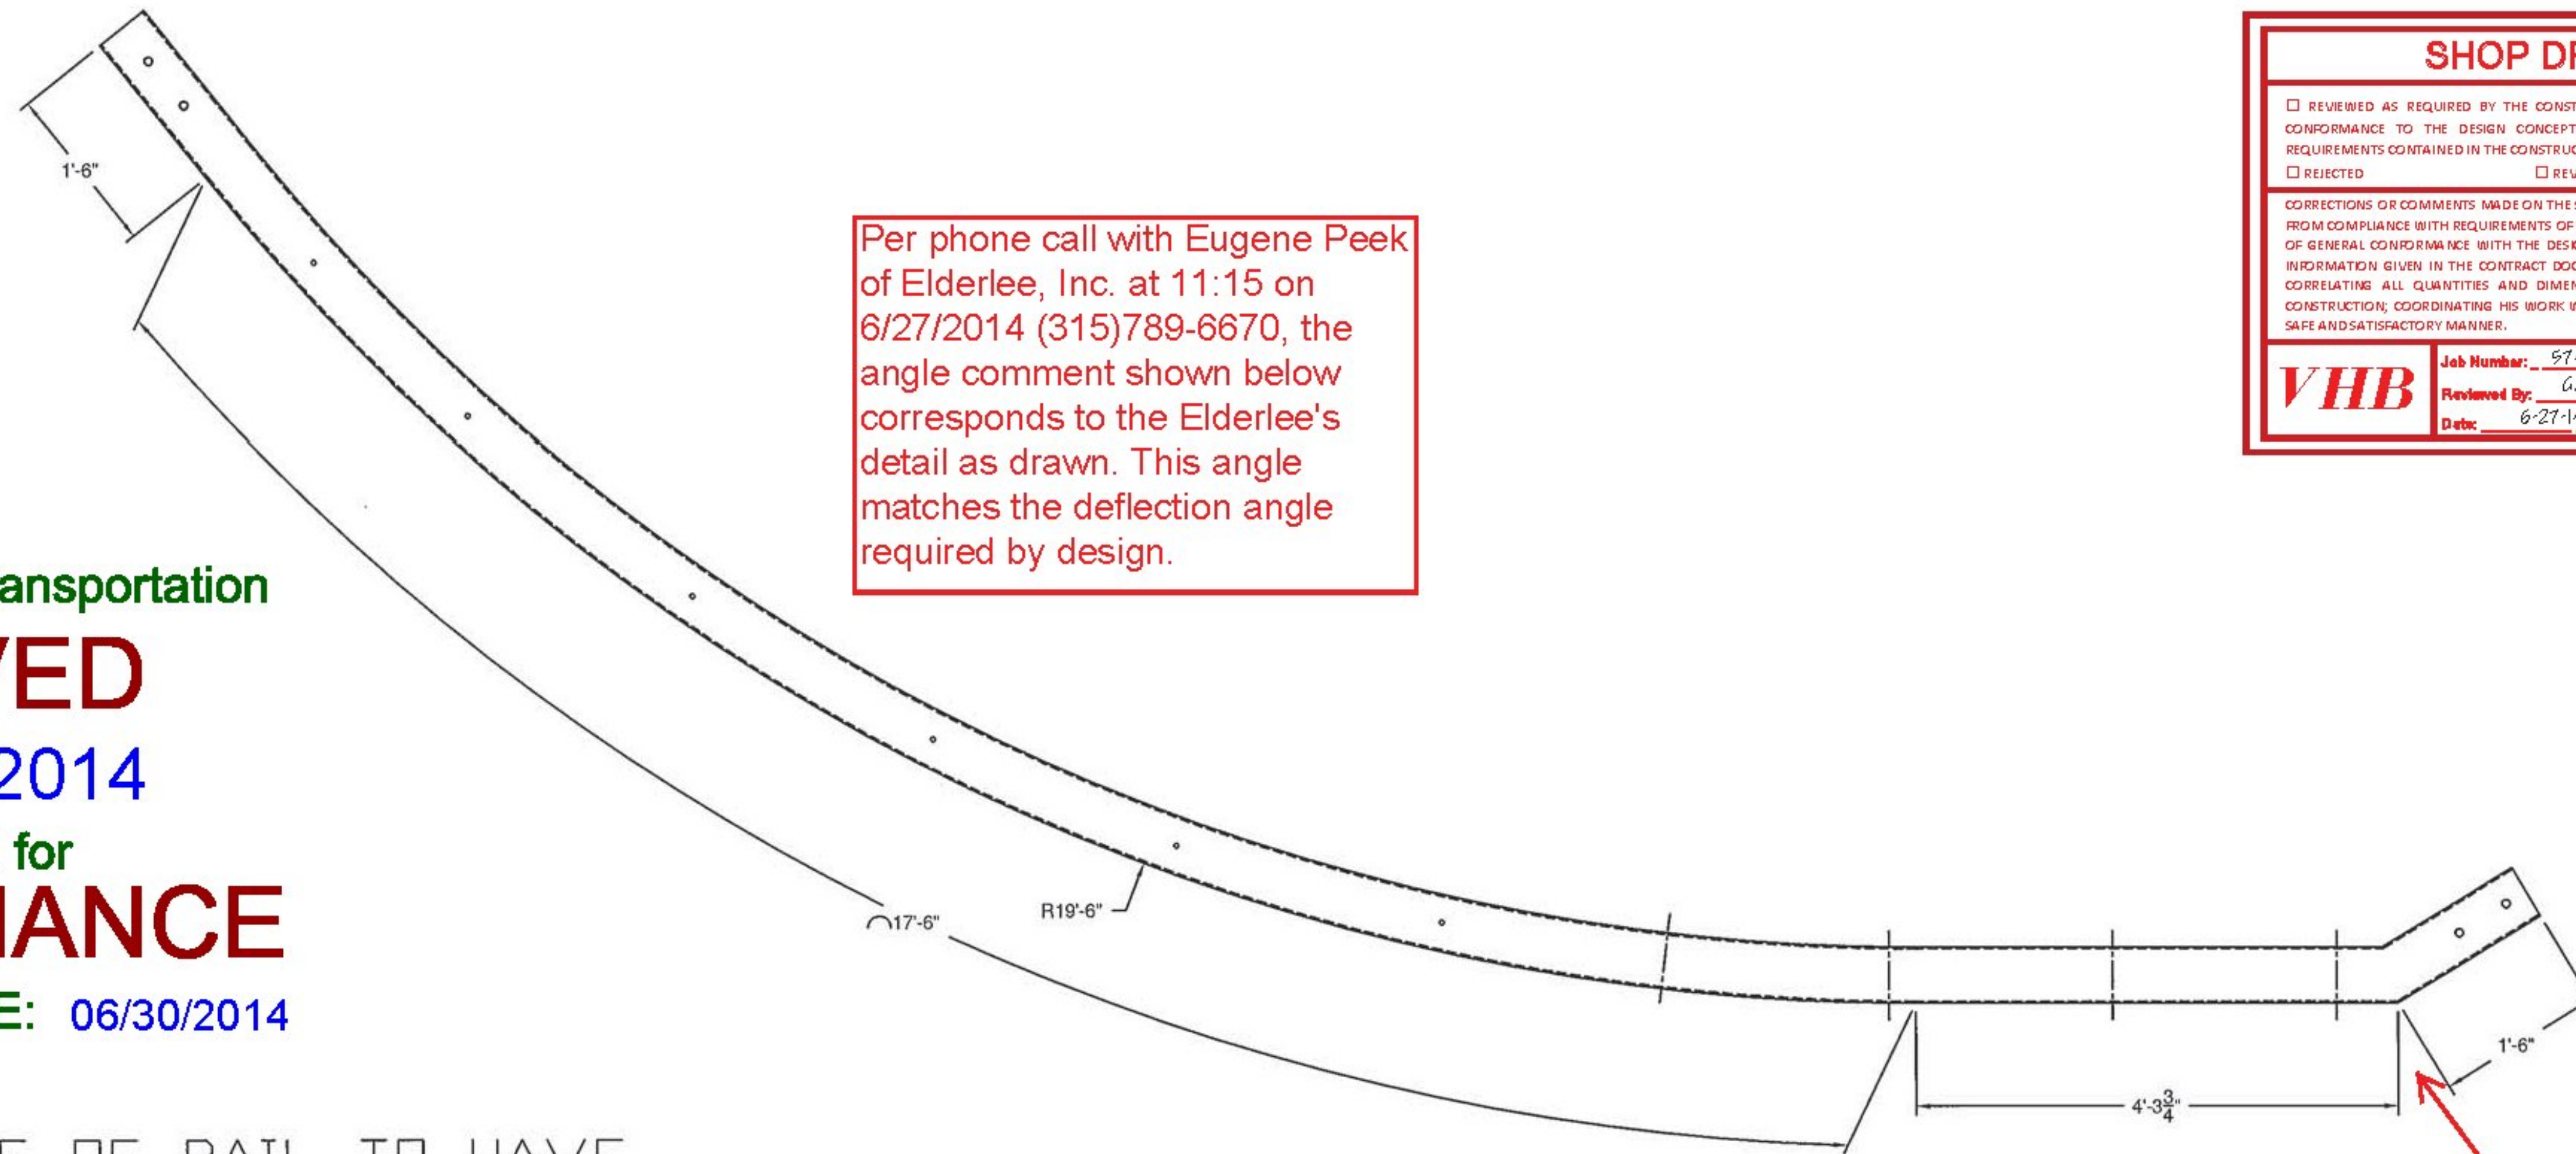

SHOP DRAWING REVIEW		
<input type="checkbox"/> REVIEWED AS REQUIRED BY THE CONSTRUCTION CONTRACT DOCUMENTS AND APPROVED, BUT ONLY FOR CONFORMANCE TO THE DESIGN CONCEPT OF THE WORK, AND SUBJECT TO FURTHER LIMITATIONS AND REQUIREMENTS CONTAINED IN THE CONSTRUCTION CONTRACT DOCUMENTS.		
<input type="checkbox"/> REJECTED	<input type="checkbox"/> REVISE AND RESUBMIT	<input checked="" type="checkbox"/> FURNISH AS CORRECTED
CORRECTIONS OR COMMENTS MADE ON THE SHOP DRAWINGS DURING THIS REVIEW DO NOT RELIEVE CONTRACTOR FROM COMPLIANCE WITH REQUIREMENTS OF THE DRAWINGS AND SPECIFICATIONS. THIS CHECK IS ONLY FOR REVIEW OF GENERAL CONFORMANCE WITH THE DESIGN CONCEPT OF THE PROJECT AND GENERAL COMPLIANCE WITH THE INFORMATION GIVEN IN THE CONTRACT DOCUMENTS. THE CONTRACTOR IS RESPONSIBLE FOR CONFIRMING AND CORRELATING ALL QUANTITIES AND DIMENSIONS; SELECTING FABRICATION PROCESSES AND TECHNIQUES OF CONSTRUCTION; COORDINATING HIS WORK WITH THAT OF ALL OTHER TRADES; AND PERFORMING HIS WORK IN A SAFE AND SATISFACTORY MANNER.		
VHB	Job Number: 5743B	
	Reviewed By: G.S. Goodrich	
	Date: 6-27-14	


FACE OF RAIL TO HAVE 19'-6" CONVEX RADIUS

Ø 7/8" HOLE TOP+BOTTOM 2 REQ'D

TOP VIEW

1/2" HOLES TOP+BOTTOM (TYP.) 6 REQ'D

Ø 7/8" HOLES (TOP & BOTTOM)

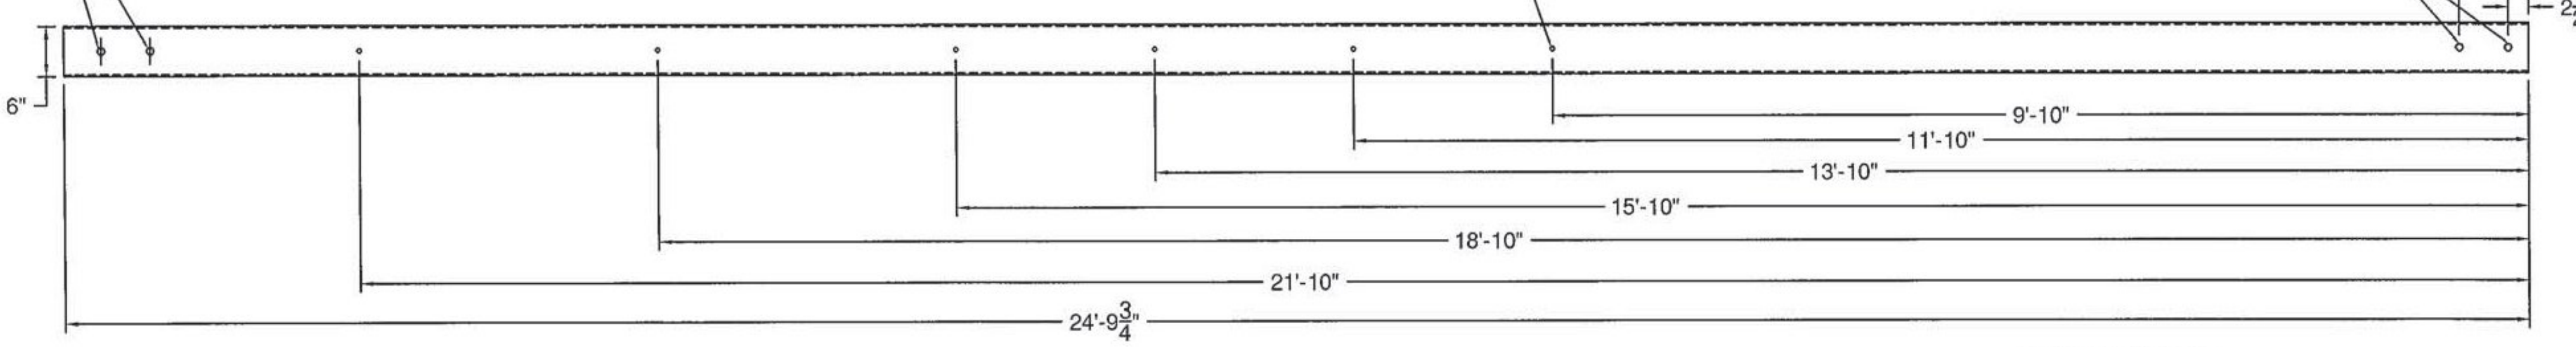


Angle 31.1803611 degrees.

SIDE VIEW

WW1

Ø 7/8" HOLES FRONT+BACK (TYP.) 4 REQ'D

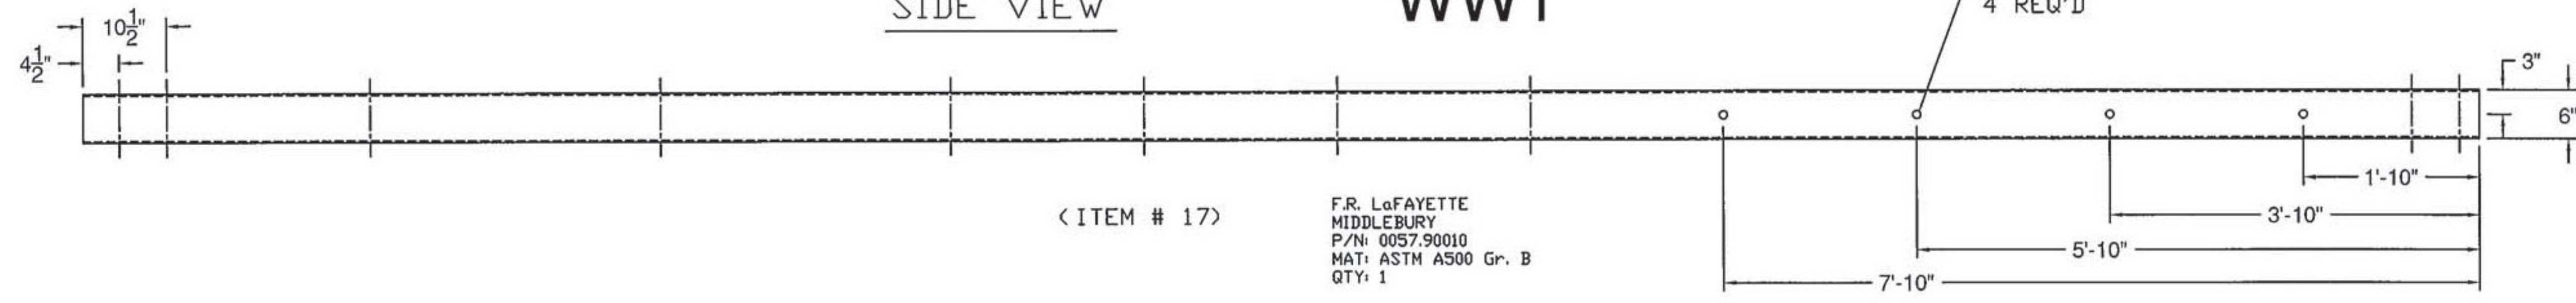

< ITEM # 17 >

F.R. LaFAYETTE
MIDDLEBURY
P/N: 0057.90010
MAT: ASTM A500 Gr. B
QTY: 1