

Vermont Agency of Transportation


RECEIVED

ON: June 26, 2014

and Checked for

CONFORMANCE

BY: Jennifer Fitch DATE: 06/30/2014

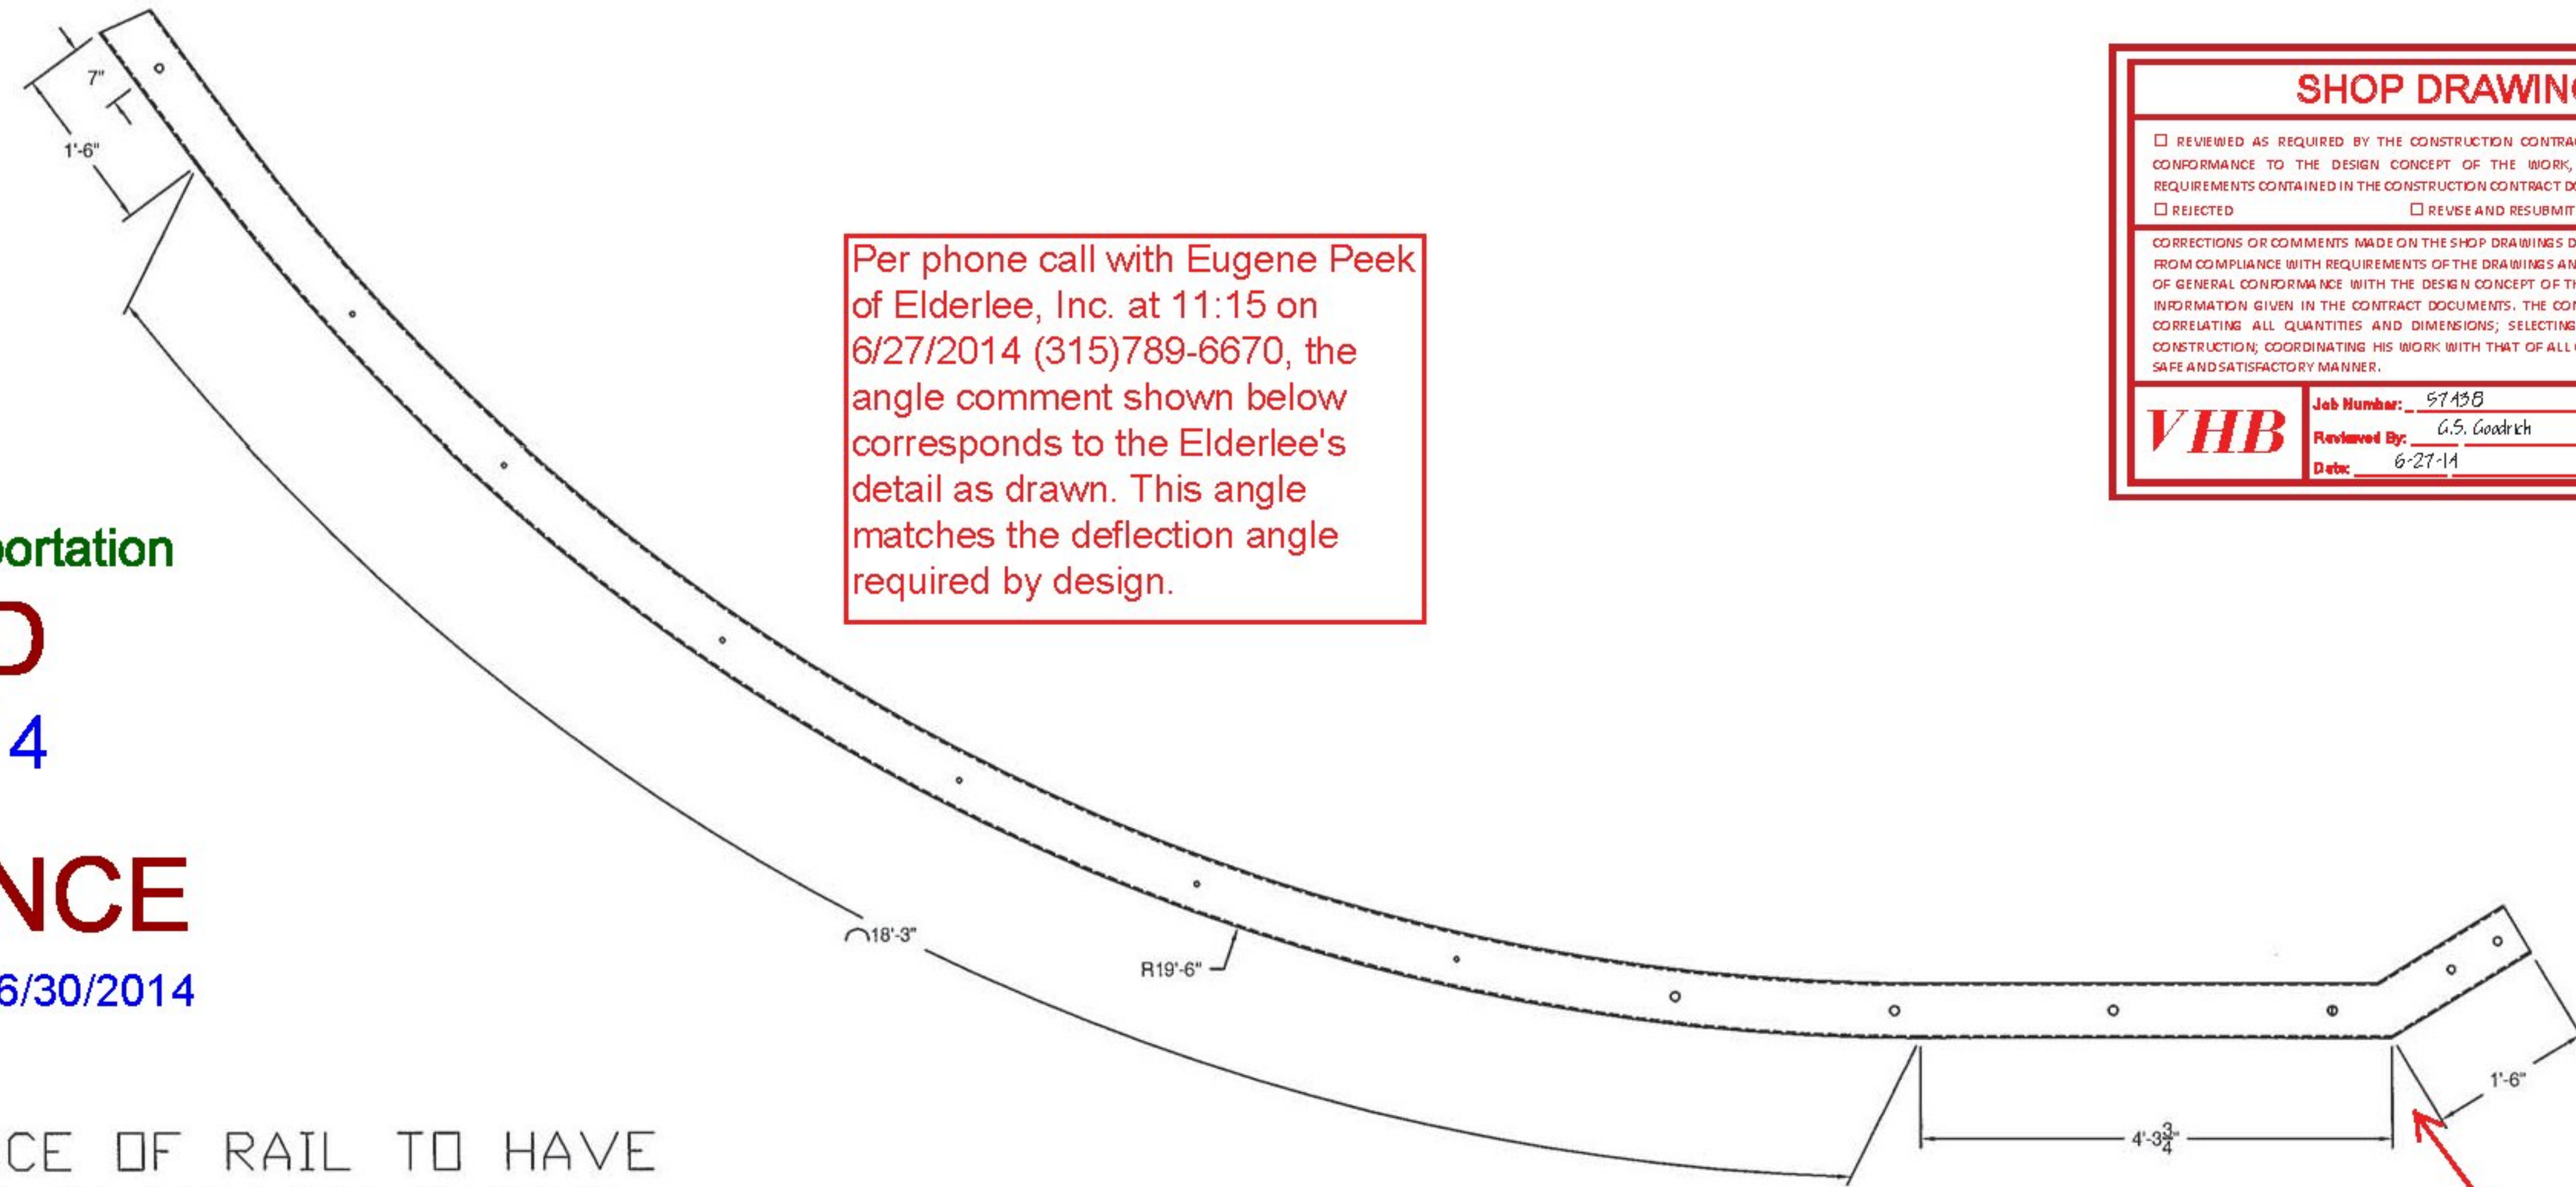


Per phone call with Eugene Peek of Elderlee, Inc. at 11:15 on 6/27/2014 (315)789-6670, the angle comment shown below corresponds to the Elderlee's detail as drawn. This angle matches the deflection angle required by design.

SHOP DRAWING REVIEW	
<input type="checkbox"/> REVIEWED AS REQUIRED BY THE CONSTRUCTION CONTRACT DOCUMENTS AND APPROVED, BUT ONLY FOR CONFORMANCE TO THE DESIGN CONCEPT OF THE WORK, AND SUBJECT TO FURTHER LIMITATIONS AND REQUIREMENTS CONTAINED IN THE CONSTRUCTION CONTRACT DOCUMENTS.	
<input type="checkbox"/> REJECTED	<input type="checkbox"/> REVISE AND RESUBMIT
<input checked="" type="checkbox"/> FURNISH AS CORRECTED	
CORRECTIONS OR COMMENTS MADE ON THE SHOP DRAWINGS DURING THIS REVIEW DO NOT RELIEVE CONTRACTOR FROM COMPLIANCE WITH REQUIREMENTS OF THE DRAWINGS AND SPECIFICATIONS. THIS CHECK IS ONLY FOR REVIEW OF GENERAL CONFORMANCE WITH THE DESIGN CONCEPT OF THE PROJECT AND GENERAL COMPLIANCE WITH THE INFORMATION GIVEN IN THE CONTRACT DOCUMENTS. THE CONTRACTOR IS RESPONSIBLE FOR CONFIRMING AND CORRELATING ALL QUANTITIES AND DIMENSIONS; SELECTING FABRICATION PROCESSES AND TECHNIQUES OF CONSTRUCTION; COORDINATING HIS WORK WITH THAT OF ALL OTHER TRADES; AND PERFORMING HIS WORK IN A SAFE AND SATISFACTORY MANNER.	
VHB	Job Number: 5745B
	Reviewed By: G.S. Goodrich
	Date: 6-27-14


FACE OF RAIL TO HAVE
19'-6" CONVEX RADIUS

Angle 31.1803611 degrees.

MITER CUT FOR
9'-0" KICKBACKS
@ 21°

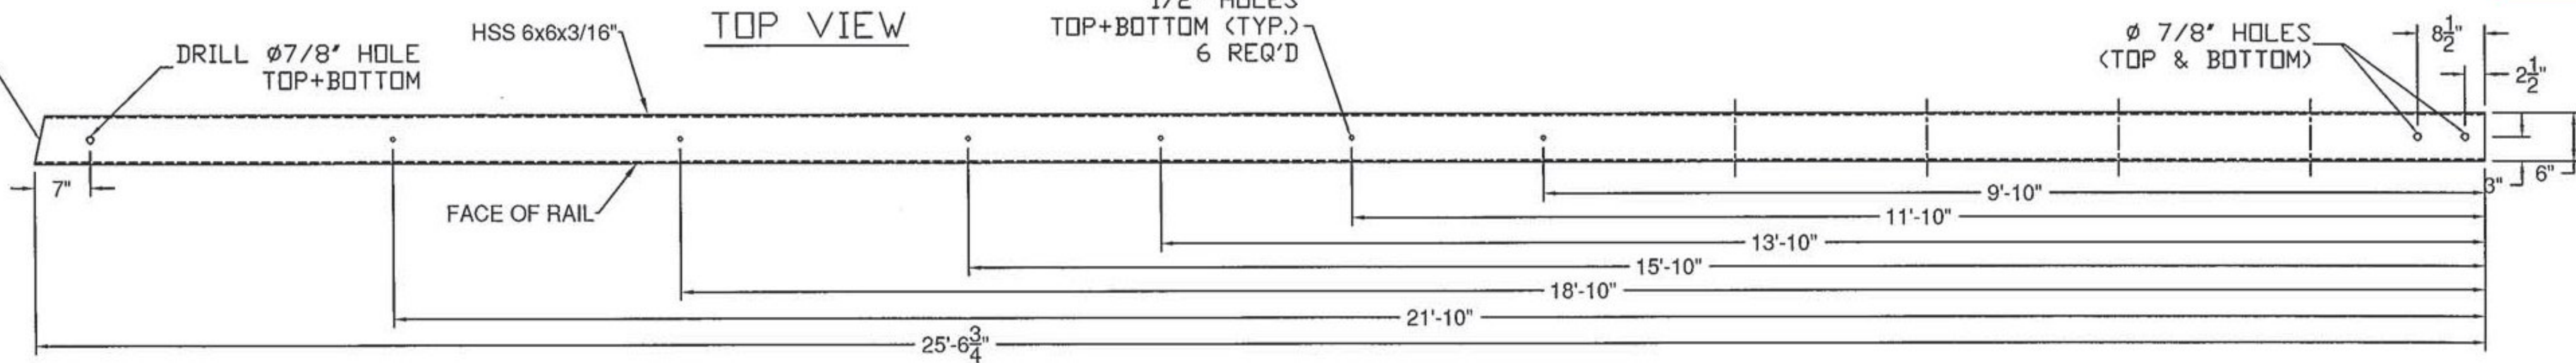

WW1

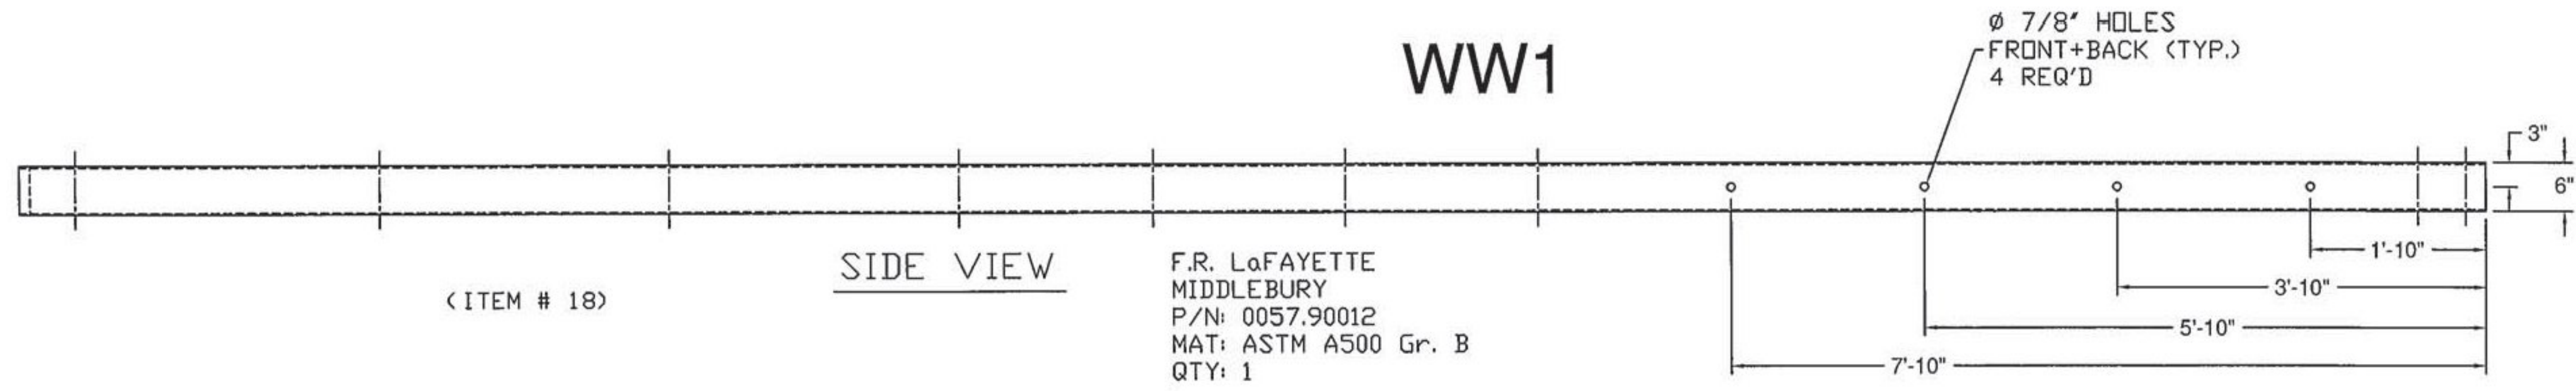

(ITEM # 18)

SIDE VIEW

F.R. LaFAYETTE
MIDDLEBURY
P/N: 0057.90012
MAT: ASTM A500 Gr. B
QTY: 1