

Vermont Agency of Transportation

RECEIVED

ON: February 12, 2014

and Checked for

CONFORMANCE

BY: Jennifer Fitch DATE: 02/27/14

SHOP DRAWING REVIEW

REVIEWED AS REQUIRED BY THE CONSTRUCTION CONTRACT DOCUMENTS AND APPROVED, BUT ONLY FOR CONFORMANCE TO THE DESIGN CONCEPT OF THE WORK, AND SUBJECT TO FURTHER LIMITATIONS AND REQUIREMENTS CONTAINED IN THE CONSTRUCTION CONTRACT DOCUMENTS.


REJECTED REVISE AND RESUBMIT FURNISH AS CORRECTED

CONTRACTORS OR COMMENTORS MADE ON THE SHOP DRAWINGS DURING THIS REVIEW DO NOT RELIEVE CONTRACTOR FROM COMPLIANCE WITH REQUIREMENTS OF THE DRAWINGS AND SPECIFICATIONS. THIS CHECK IS ONLY FOR REVIEW OF GENERAL CONFORMANCE WITH THE DESIGN CONCEPT OF THE PROJECT AND GENERAL COMPLIANCE WITH THE INFORMATION GIVEN IN THE CONTRACT DOCUMENTS. THE CONTRACTOR IS RESPONSIBLE FOR CONFIRMING AND CORRELATING ALL QUANTITIES AND DIMENSIONS, SELECTING FABRICATION PROCESSES AND TECHNIQUES OF CONSTRUCTION, COORDINATING HIS WORK WITH THAT OF ALL OTHER TRADES, AND PERFORMING HIS WORK IN A SAFE AND SATISFACTORY MANNER.


VHB Job Number: 57438.00
Vermont Highway Builders, Inc. Reviewed By: R. Mason
 Date: 2-14-14

SUBMITTED
 FEB 12 2014
 J. P. CARRARA & SONS, INC.
 MIDDLEBURY, VT 05753

| MARK: SH-NB3 QTY.: 1 WT.: 46.07 T VOL.: 22.75 cy | | | |
|--|----------|---|------|
| MATERIAL LIST / NEXT BEAM | | | |
| ITEM | MARK | DESCRIPTION | QTY. |
| 1 | SH-N401L | #4 BENT BAR (LEVEL II, DUAL COATED) | 168 |
| 2 | SH-N402L | #4 BENT BAR (LEVEL II, DUAL COATED) | 262 |
| 3 | SH-N403L | #4 HAIRPIN (LEVEL II, DUAL COATED) | 126 |
| 4 | SH-N404L | #4 BENT BAR (LEVEL II, DUAL COATED) | 8 |
| 5 | | #4 x 8'-0" (LVL. II, DUAL COATED) | 18 |
| 6 | | | |
| 7 | | #5 x 7'-4" (LVL. II, DUAL COATED) | 16 |
| 8 | | #5 x 8'-0" (LVL. II, DUAL COATED) | 254 |
| 9 | | #5 x 63'-0" (W/ (1) 2'-6" STAGGERED LAP) (LVL. II, DUAL COATED) | 24 |
| 10 | | | |
| 11 | SH-N601L | #6 BENT BAR (LEVEL II, DUAL COATED) | 4 |
| 12 | SH-N602L | #6 BENT BAR (LEVEL II, DUAL COATED) | 12 |
| 13 | | | |
| 14 | | | |
| 15 | | | |
| 16 | | | |
| 17 | | | |
| 18 | HK-N8 | BRG. P 3/4" x 1'-0 1/4" x 1'-4" W/ ANCHORS (GALV.) | 2 |
| 19 | | SET OF (4) 0.60" x 270 KSI STRAND LIFTING LOOPS | 4 |
| 20 | | | |

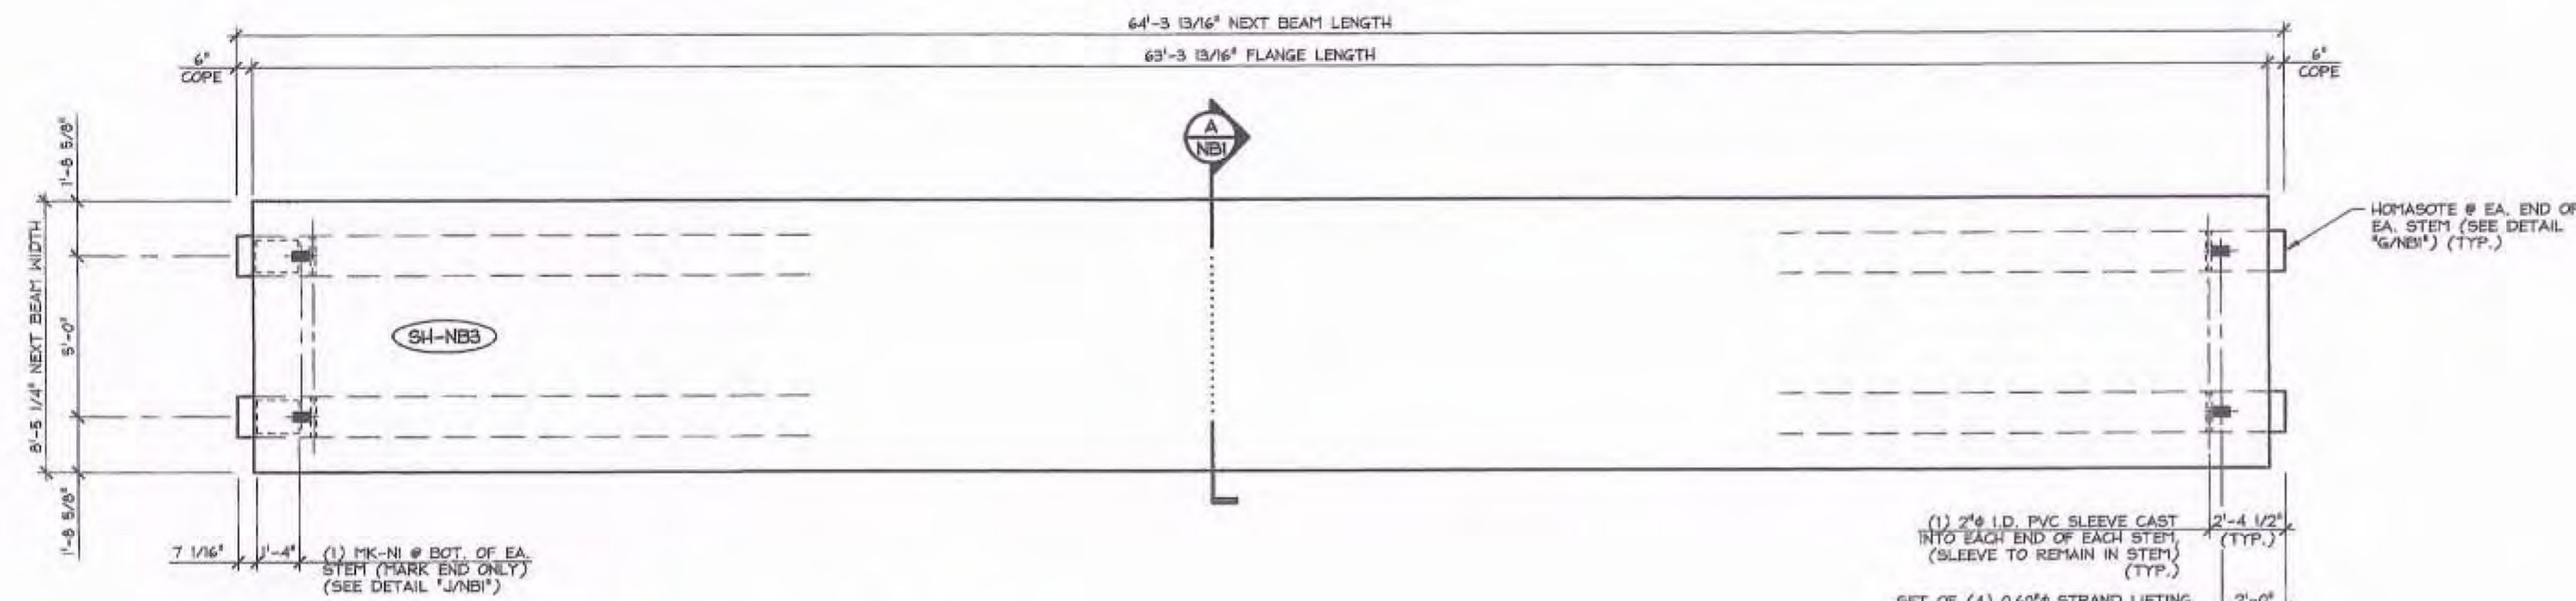

1 DIMENSIONAL PLAN VIEW IN FORM
 NBS 1/4" = 1'-0"

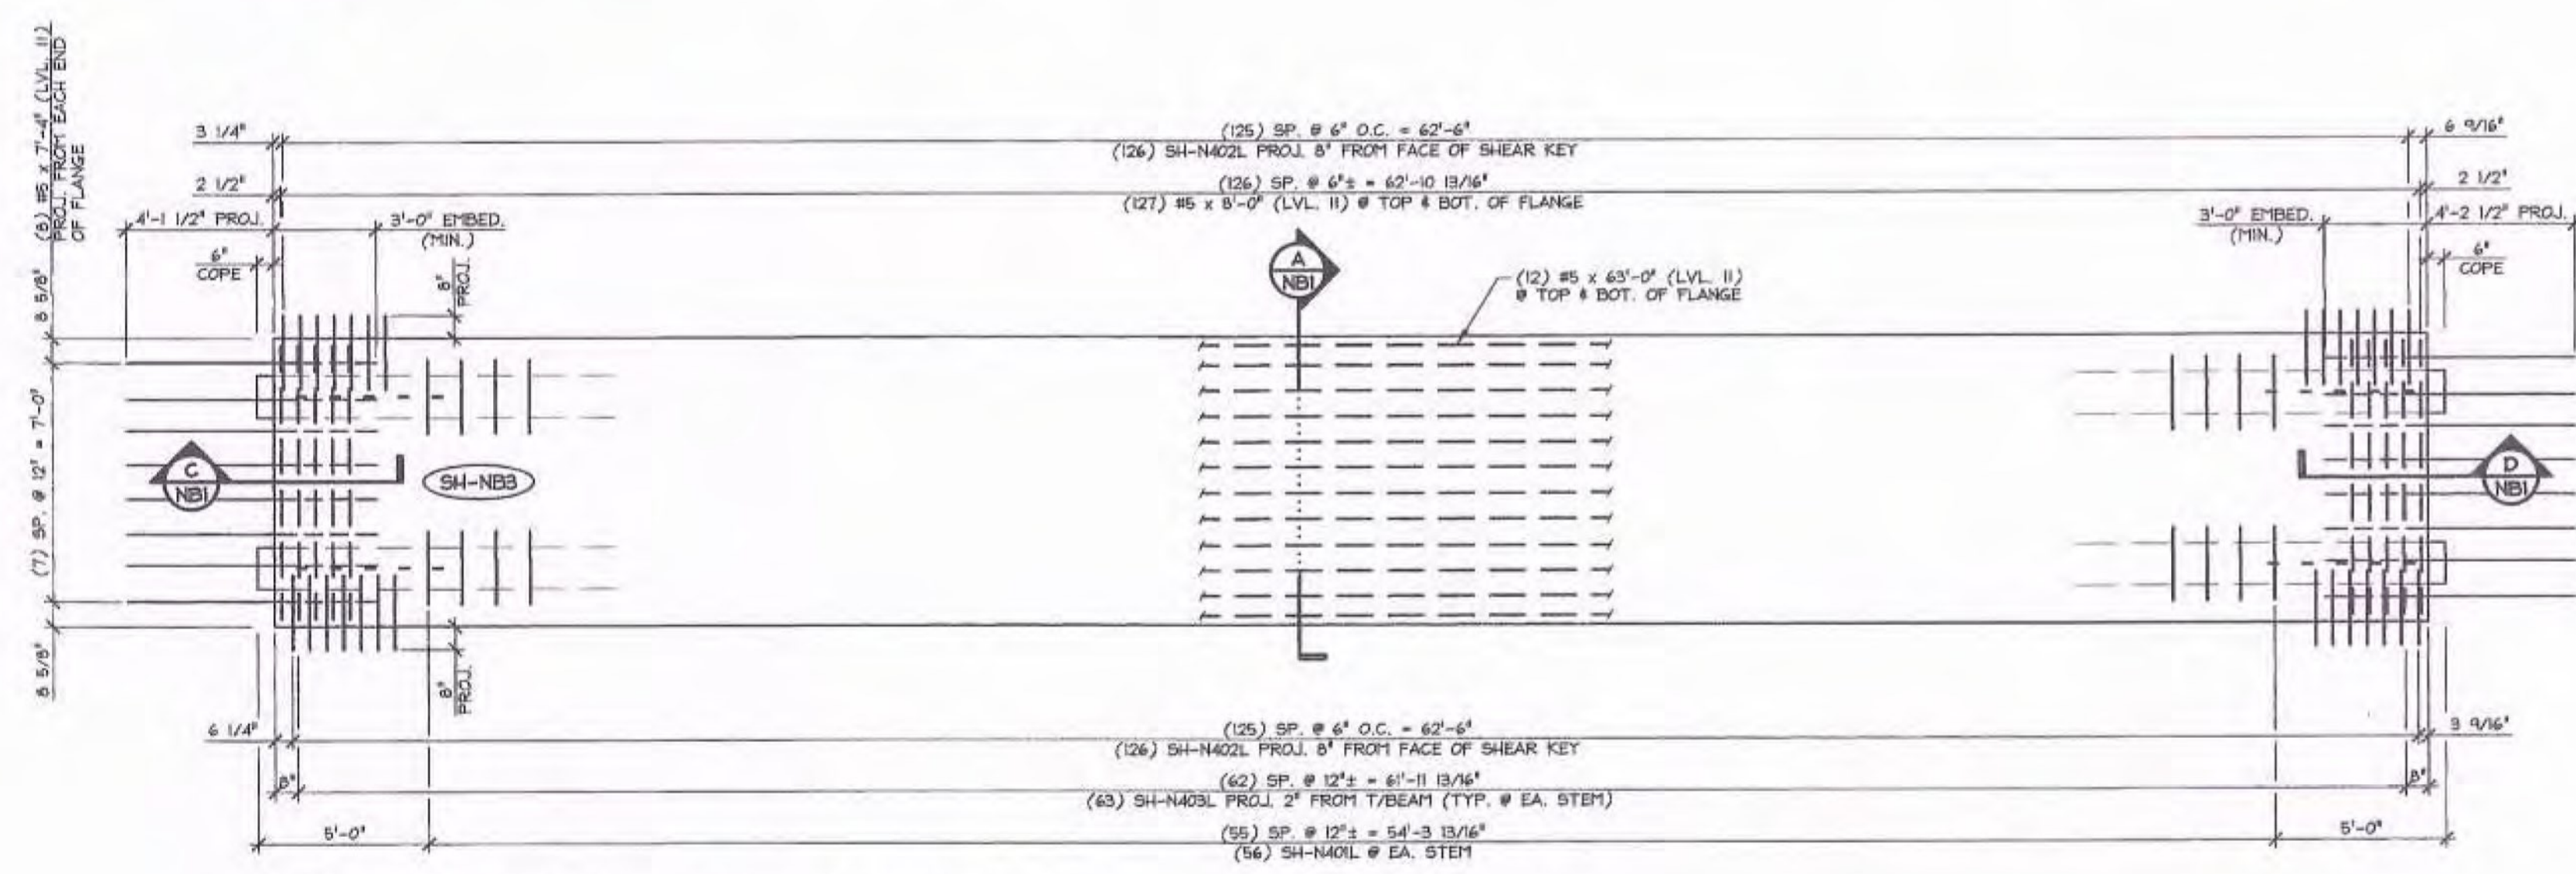

2 REINFORCING PLAN VIEW IN FORM
 NBS SEE CURTAIN WALL DETAILS FOR PROJECTING BAR BENDING & PROJECTING STRAND BENDING 1/4" = 1'-0"

| | | | | |
|-----------------|--|--|--|-------------------|
| APPROVAL STAMP: | J.P. CARRARA & SONS INC. Precast & Prestress Manufacturer <small>284 GAZ. CIR., MIDDLEBURY, VERMONT 05753 Phone:(802)388-6301 Fax:(802)388-9010</small> | | T. BUCK CONSTRUCTION CONTRACTOR AUBURN, MAINE | |
| | STATE OF VERMONT AGENCY OF TRANSPORTATION COUNTY OF ADDISON | | DATE: OCT. 9, 2013 | SCALE: NOTED |
| | TOWN OF MIDDLEBURY ROUTE NO. VT 125, EAST MIDDLEBURY GORGE BRIDGE NO.: 13 PROJECT NO.: RS 0174(8) | | CHKD: DFTM: B.L. | JOB NO: 23411-013 |
| | PRESTRESSED NEXT BEAM PLANS | | DWG. NO: NBS | |