


MISCELLANEOUS MATERIALS				
ITEM	MARK	QTY.	DESCRIPTION	REMARKS
1		72	#4 x 8'-0" (LVL II, DUAL COATED)	
2				
3				
4		32	#5 x 6'-11 1/2" (LVL II, DUAL COATED)	
5		64	#5 x 7'-4" (LVL II, DUAL COATED)	
6		984	#5 x 8'-0" (LVL II, DUAL COATED)	
7		96	#5 x 6'-0" (W/ (1) 2'-6" STAGGERED LAP) (LVL II, DUAL COATED)	
8				
9				
10				
11				
12	MK-NI	8	BRG. E 3/4" x 1'-0 1/4" x 1'-4" W/ ANCHORS (GALV.)	SEE DETAIL, THIS SHEET
13	MK-N2	16	DAYTON 7/8" F-42 LOOP FERRULE INSERT (GALV.)	
14	MK-N3	6	DAYTON 1" F-42 LOOP FERRULE INSERT (STAINLESS STEEL)	
15	MK-N4	30	MODIFIED UNIVERSAL 4APR DECK FORM HANGER 48" (GALV.) (20" LG.)	
16	MK-N5	30	DAYTON 1/2" F-42 LOOP FERRULE INSERT (GALV.)	
17		16	SET OF (4) 0.60" x 270 KSI STRAND LIFTING LOOPS	
18				
19				
20				

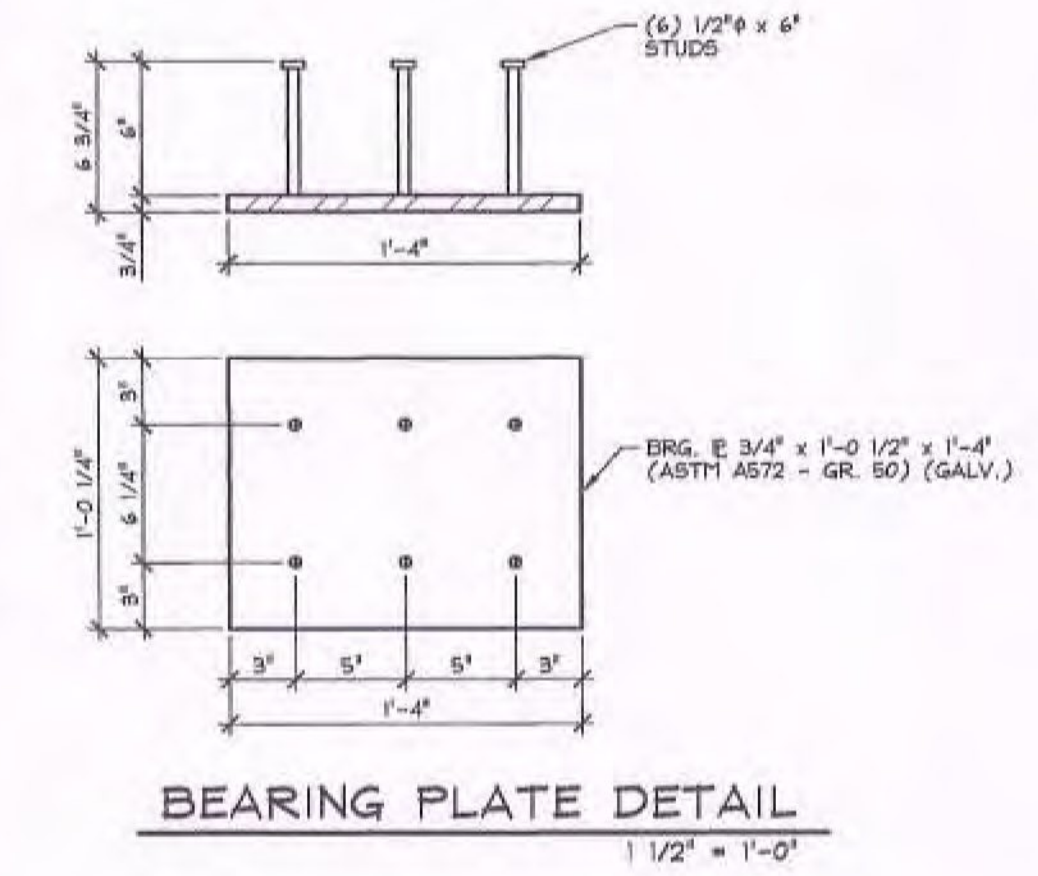

Vermont Agency of Transportation
RECEIVED
 ON: February 12, 2014
 and Checked for
CONFIRMANCE
 BY: Jennifer Fitch DATE: 02/27/14

SHOP DRAWING REVIEW	
<input checked="" type="checkbox"/>	REVIEWED AS REQUIRED BY THE CONSTRUCTION CONTRACT DOCUMENTS AND APPROVED, BUT ONLY FOR CONFORMANCE TO THE DESIGN CONCEPT OF THE WORK, AND SUBJECT TO FURTHER LIMITATIONS AND REQUIREMENTS CONTAINED IN THE CONSTRUCTION CONTRACT DOCUMENTS.
<input type="checkbox"/>	REJECTED
<input type="checkbox"/>	REUSE AND RESUBMIT
<input type="checkbox"/>	FURNISH AS CORRECTED
<input type="checkbox"/>	FURNISH AS CORRECTED
CORRECTIONS OR COMMENTS MADE ON THE SHOP DRAWINGS DURING THIS REVIEW DO NOT RELIEVE CONTRACTOR FROM COMPLIANCE WITH REQUIREMENTS OF THE DRAWINGS AND SPECIFICATIONS. THIS CHECK IS ONLY FOR REVIEW OF GENERAL CONFORMANCE WITH THE DESIGN CONCEPT OF THE PROJECT AND GENERAL COMPLIANCE WITH THE INFORMATION GIVEN IN THE CONTRACT DOCUMENTS. THE CONTRACTOR IS RESPONSIBLE FOR COMPARING AND CORRELATING ALL QUANTITIES AND DIMENSIONS, SELECTING FABRICATION PROCESSES AND TECHNIQUES OF CONSTRUCTION, COORDINATING HIS WORK WITH THAT OF ALL OTHER TRADES, AND PERFORMING HIS WORK IN A SAFE AND SATISFACTORY MANNER.	
VHB Vermont Highway Builders, Inc.	Job Number: 57428-00 Reviewed By: R. Masse Date: 2-14-14

SUBMITTED
 FEB 12 2014
 J. P. CARRARA & SONS, INC.
 MIDDLEBURY, VT 05753

APPROVAL STAMP:	J.P. CARRARA & SONS INC. Precast & Prestress Manufacturer 264 C&S DR., MIDDLEBURY, VERMONT 05753 Phone: (802)388-6361 Fax: (802)388-3010	T. BUCK CONSTRUCTION CONTRACTOR AUBURN, MAINE
	STATE OF VERMONT AGENCY OF TRANSPORTATION COUNTY OF ADDISON	DATE: OCT. 9, 2013 SCALE: NOTED
	TOWN OF MIDDLEBURY ROUTE NO. VT 125, EAST MIDDLEBURY GORGE BRIDGE NO.: 13 PROJECT NO.: RS 0174(8)	CHKD: DFTM: B.L. JOB NO: 23411-013
	NEXT BEAM MATERIALS LIST	DWG. NO: NBM1

2-11-14 REVISED AS NOTED