


Vermont Agency of Transportation  
**RECEIVED**  
 ON: December 16, 2013  
 and Checked for  
**CONFORMANCE**  
 BY: Jennifer Fitch DATE: 12/18/2013

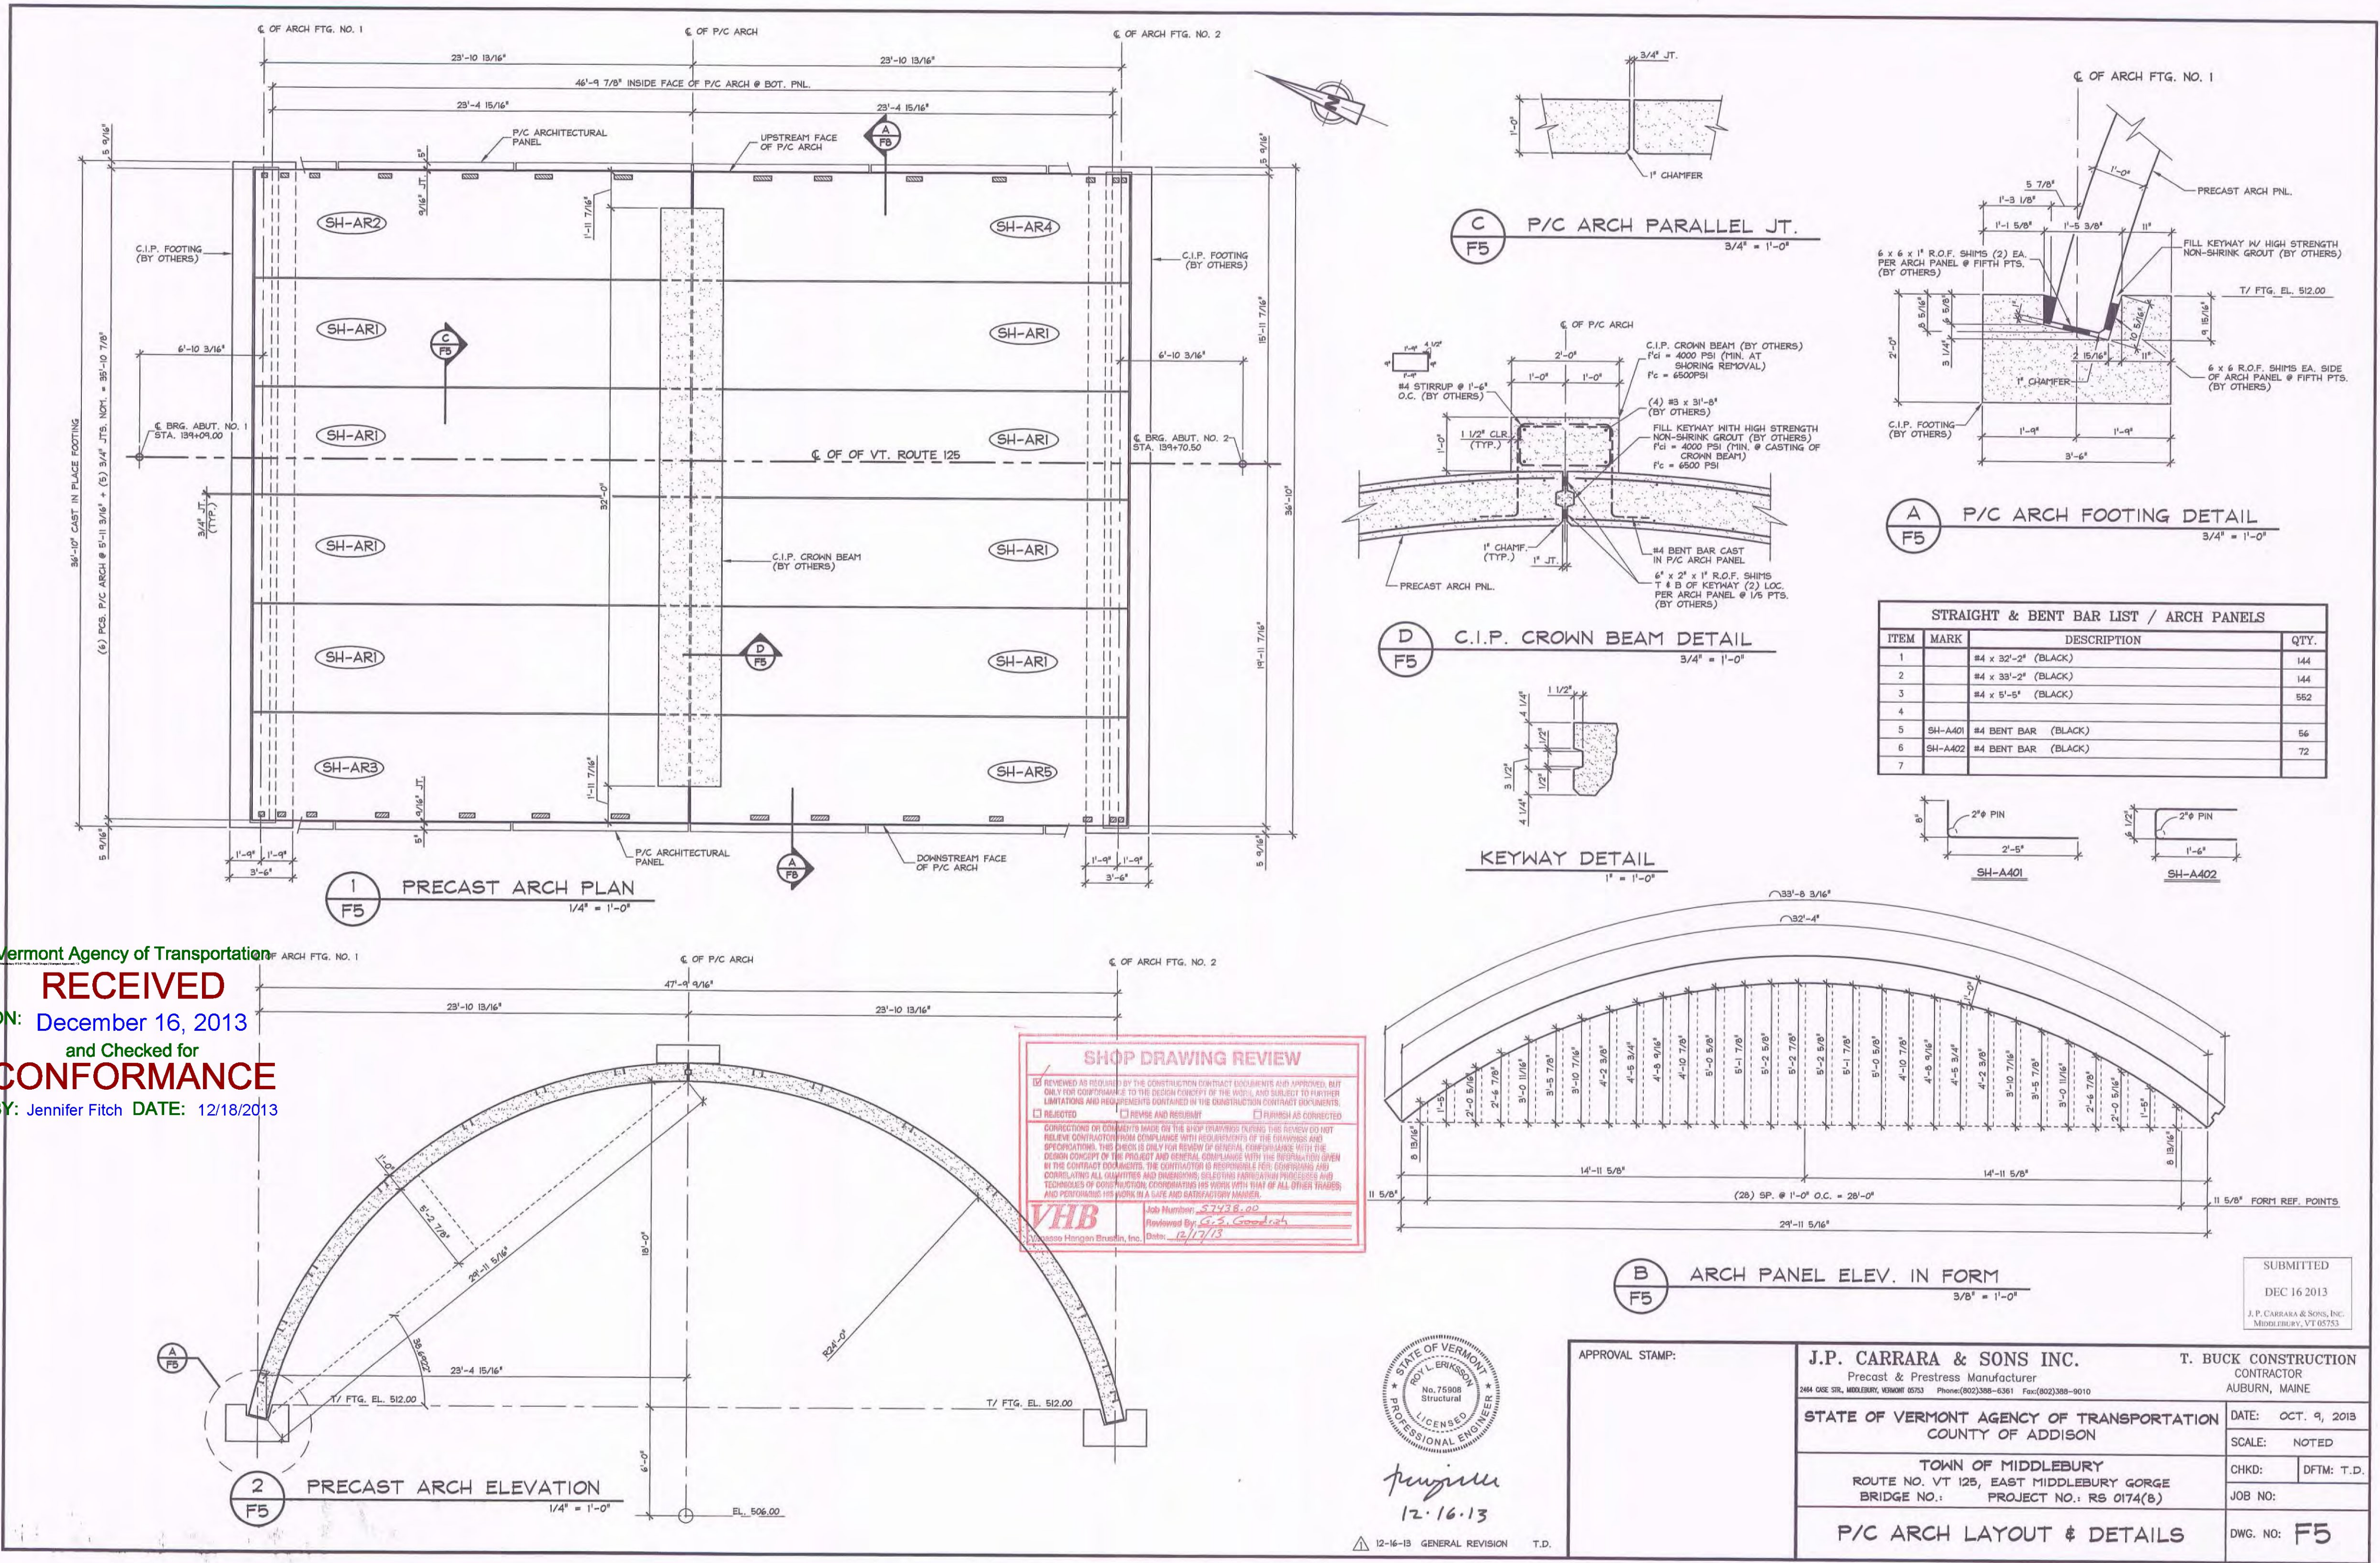

STRAIGHT & BENT BAR LIST / ARCH PANELS

ITEM	MARK	DESCRIPTION	QTY.
1	#4 x 32'-2"	(BLACK)	144
2	#4 x 38'-2"	(BLACK)	144
3	#4 x 11'-9"	(BLACK)	552
4	SH-A401	#4 BENT BAR (BLACK)	56
5	SH-A402	#4 BENT BAR (BLACK)	72

**SHOP DRAWING REVIEW**

REVIEWED AS REQUIRED BY THE CONSTRUCTION CONTRACT DOCUMENTS AND APPROVED, BUT ONLY FOR CONFORMANCE TO THE DESIGN INTENT OF THE WORK, AND SUBJECT TO FURTHER LIMITATIONS AND REQUIREMENTS FORWARDED BY THE CONSTRUCTION CONTRACT DOCUMENTS.

REJECTED  REVISE AND RESUBMIT  FORWASH AS CORRECTED

CONNECTIONS OR CONDITIONS MADE BY THE SHOP DRAWING REVIEWER: THE REVIEWER DOES NOT RELIEVE CONTRACTORS FROM COMPLIANCE WITH REQUIREMENTS OF THE CONTRACT DOCUMENTS. OPERATIONS. THIS REVIEW IS ONLY FOR REVIEW OF GENERAL CONFORMANCE WITH THE DESIGN CONCEPT OF THE PROJECT AND GENERAL COMPLIANCE WITH THE REQUIREMENTS SET FORTH IN THE CONTRACT DOCUMENTS. THE CONTRACTOR IS RESPONSIBLE FOR ALL CONFORMANCE AND COMPLIANCE WITH ALL APPLICABLE AND RELEVANT REGULATIONS, PERMITS, ORDINANCES AND TECHNICALS OF CONSTRUCTION, COORDINATION AND WITH THE TEAM OF ALL OTHER ENGINEERS AND PROFESSIONALS WORKING ON THIS PROJECT AND MANUFACTURING STANDARDS.

Job Number: 57222.00  
 Reviewed By: G. S. Carrara, Inc.  
 Checked By: J. P. Carrara, Inc.  
 Date: 12/17/13



*J.P. Carrara*  
 12.16.13

12-16-13 GENERAL REVISION T.D.

APPROVAL STAMP:

**J.P. CARRARA & SONS, INC.**  
 Precast & Prestress Manufacturer  
 204 ONE ONE MIDDLEBURY AVENUE SOUTH Middlebury, VT 05753 Phone: (802)338-4351 Fax: (802)338-9010

**T. BUCK CONSTRUCTION**  
 CONTRACTOR  
 AUBURN, MAINE

STATE OF VERMONT AGENCY OF TRANSPORTATION  
 COUNTY OF ADDISON

TOWN OF MIDDLEBURY  
 ROUTE NO. VT 125, EAST MIDDLEBURY GORGE  
 BRIDGE NO. PROJECT NO. RS 0174(8)

P/C ARCH LAYOUT & DETAILS

DATE: OCT. 9, 2013  
 SCALE: NOTED  
 CHKD: DFTM: T.D.  
 JOB NO:  
 DWG. NO: F5

SUBMITTED  
 DEC 16 2013  
 J.P. CARRARA & SONS, INC.  
 Middlebury, VT 05753