



1 ARCH PANEL PLAN IN FORM W/ REINF.
1/2" = 1'-0"

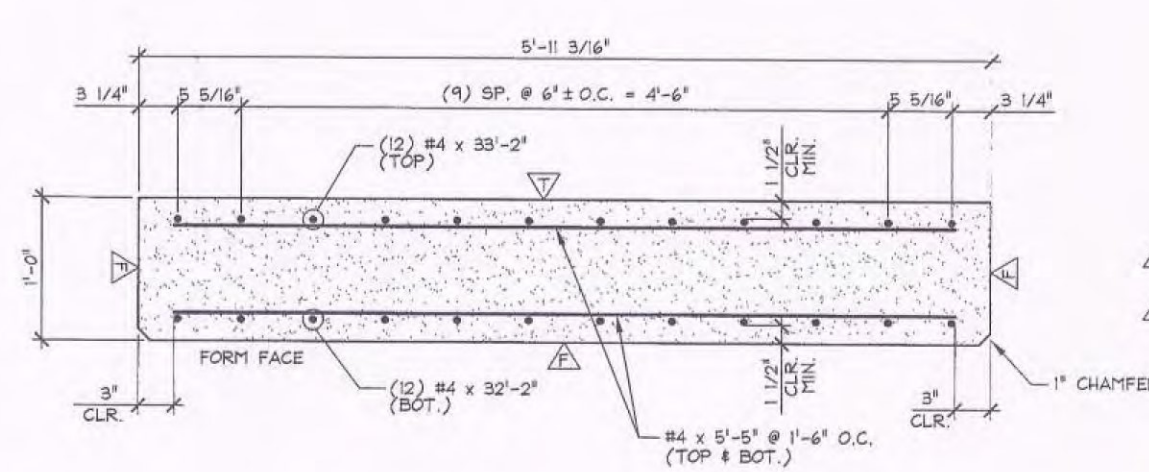

A ARCH PANEL REINFORCEMENT SECTION
1/2" = 1'-0"

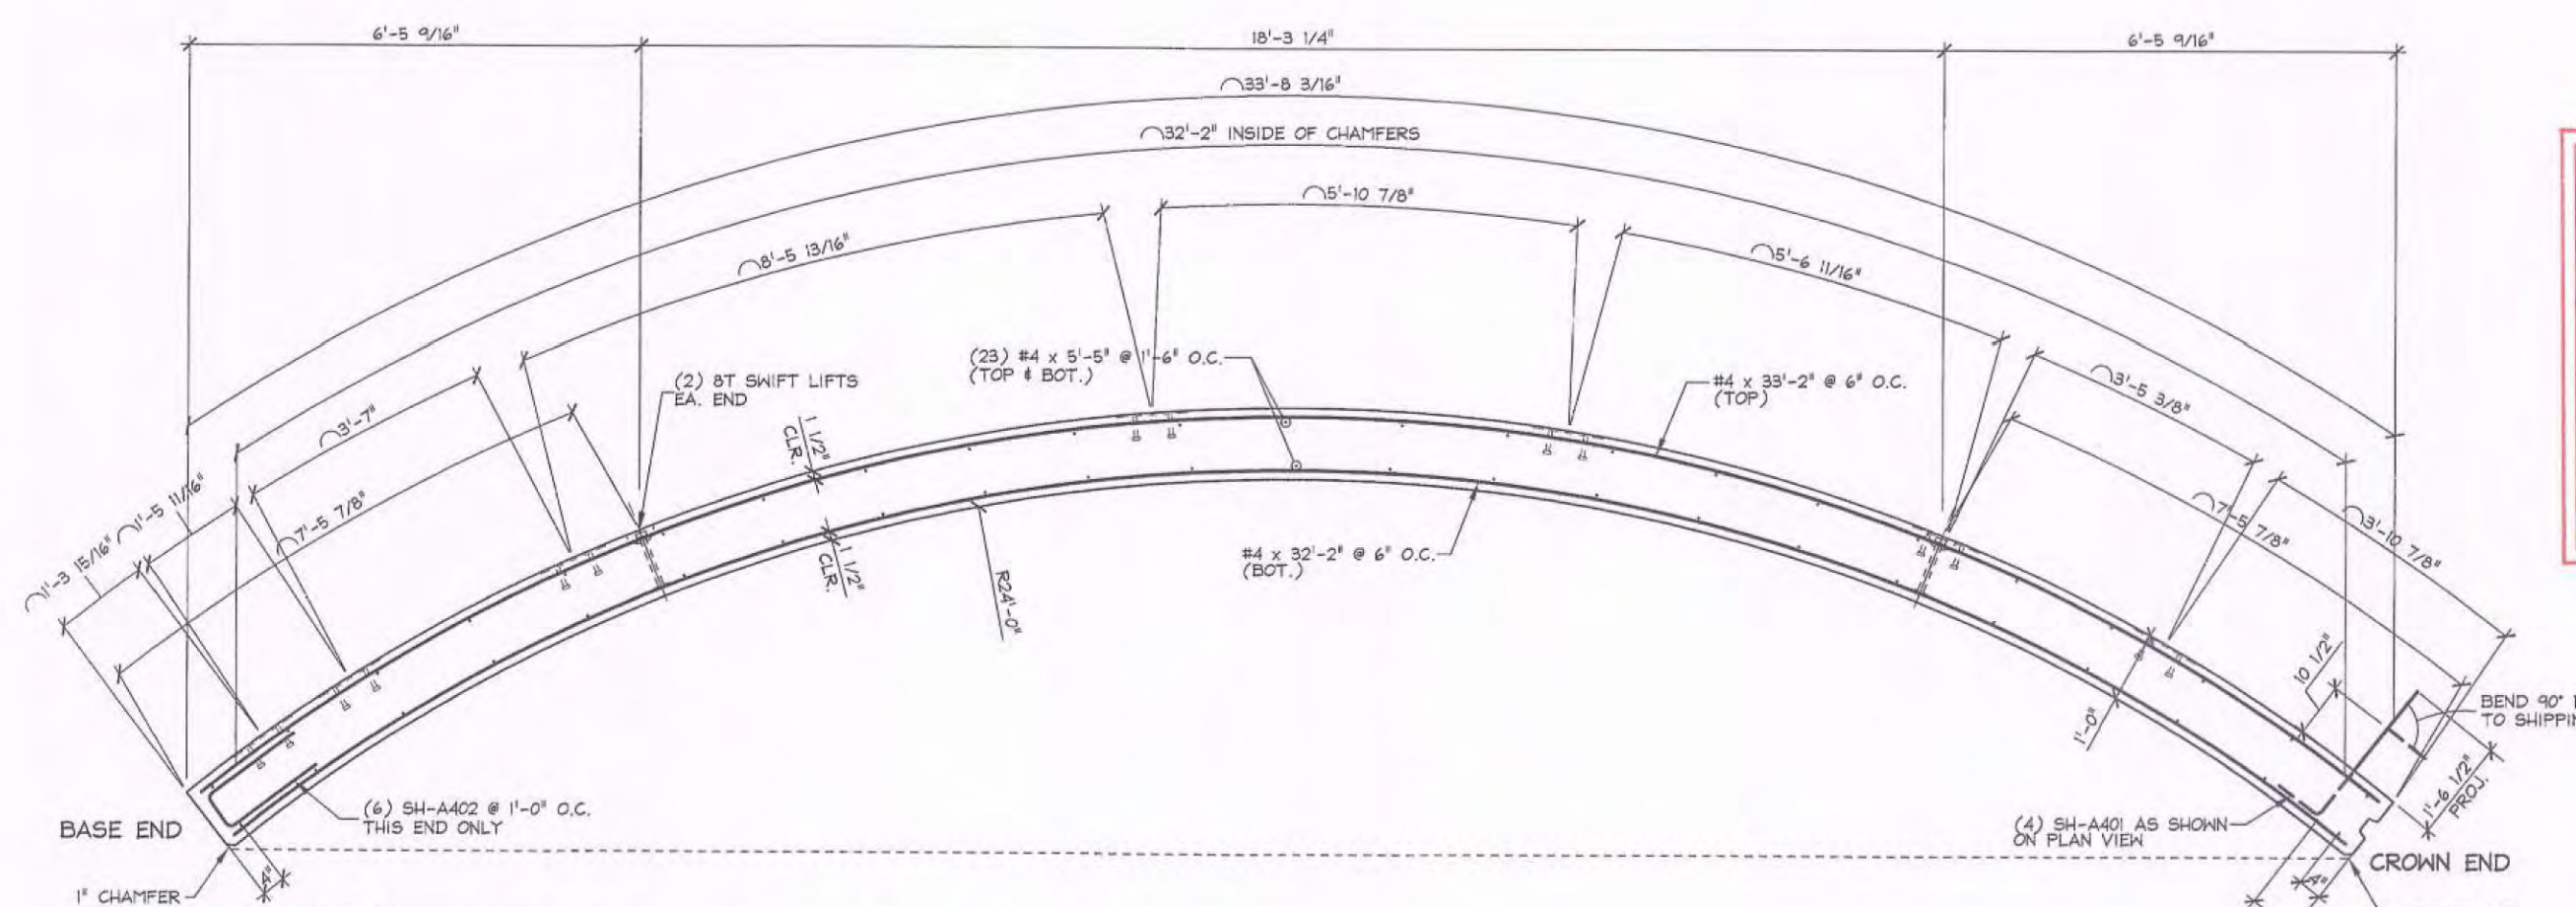


B ARCH PANEL REINFORCEMENT SECTION
1/2" = 1'-0"

SHOP DRAWING REVIEW

REVIEWED AS REQUIRED BY THE CONSTRUCTION CONTRACT DOCUMENTS AND APPROVED, BUT ONLY FOR CONFORMANCE TO THE DESIGN CONCEPT OF THE ARCH AND SUBJECT TO FURTHER LISTINGS AND REQUIREMENTS CONTAINED IN THE CONSTRUCTION CONTRACT DOCUMENTS.


CONSTRUCTION OR COMMENTS MADE ON THE SHOP DRAWINGS DURING THE REVIEW DO NOT RELIEVE CONTRACTOR FROM COMPLIANCE WITH REQUIREMENTS OF THE DRAWINGS AND SPECIFICATIONS. THIS CHECK IS ONLY FOR REVIEW OF GENERAL CONFORMANCE WITH THE DESIGN CONCEPT OF THE PROJECT AND GENERAL COMPLIANCE WITH THE INFORMATION GIVEN IN THE CONTRACT DOCUMENTS. THE CONTRACTOR IS RESPONSIBLE FOR CONFORMANCE AND CONSULTING ALL QUANTITIES AND DIMENSIONS, SELECTING FABRICATION PROCESSES AND TECHNIQUES OF CONSTRUCTION, COORDINATING HIS WORK WITH THAT OF ALL OTHER TRADES, AND PERFORMING HIS WORK IN A SAFE AND SUBSTANTIAL MANNER.

VHB
Vermont Highway Builders, Inc.
Job Number: 57428-D0
Reviewed By: G. S. [Signature]
Date: 12/17/13

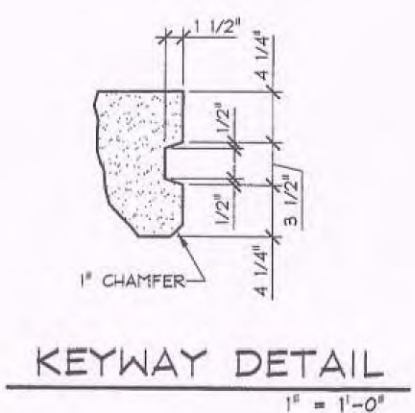

KEYWAY DETAIL
1" = 1'-0"

- HANDLING NOTES:**
1. ARCH PANEL SHALL BE HANDLED USING (4) 8T x 10' SL ANCHORS AT FIFTH POINTS.
 2. ARCH PANEL SHALL BE STRIPPED USING (4) 8T x 10' SL ANCHORS.
 3. FOR YARD STORAGE, ARCH PANEL SHALL BE LOWERED USING (4) 8T x 10' SL ANCHORS UNTIL PANEL CONTACTS THE STORAGE FRAME. PLACED 1'-3" FROM THE PANEL END AS SHOWN. THE BASE OF THE PANEL SHALL THEN BE LOWERED TO THE HARDWOOD SUPPORT.
 4. THE PANEL SHALL BE HOISTED FROM THE STORAGE POSITION IN THE REVERSE SEQUENCE SPECIFIED ABOVE.
 5. THE ARCH PANEL SHALL BE SHIPPED WITH A SUPPORT CONFIGURATION MATCHING THE "YARD STORAGE DETAIL" AND SHALL BE INSTALLED FOLLOWING THE ABOVE PROCEDURE, USING (4) 8T x 10' SL ANCHORS.

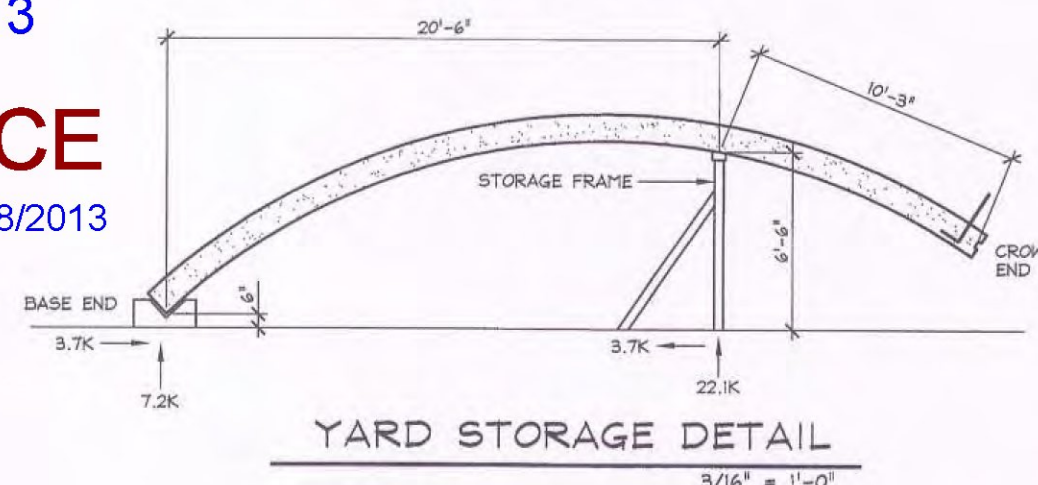


YARD STORAGE DETAIL
3/8" = 1'-0"

4000 PSI @ RELEASE
8500 PSI @ 28 DAYS
FIX DESIGN: 48M NO DG
FIX DESIGN: 42M NO DG

SUBMITTED
DEC 16 2013
J.P. CARRARA & SONS, INC.
MIDDLEBURY, VT 05753


NOTE:
EITHER OR BOTH OF THE ABOVE APPROVED FIX DESIGNS SHALL BE USED IN FABRICATION. RECORDS AND TESTING SHALL BE IN ACCORDANCE WITH I.P.C. GSI AND VT ADT SPECIFICATION.

ITEM	MARK	DESCRIPTION	QTY.
1		#4 x 33'-2" BLACK	12
2		#4 x 32'-2" BLACK	12
3		#4 x 5'-5" BLACK	46
4			
5	SH-A401	#4 BENT BAR BLACK	4
6	SH-A402	#4 BENT BAR BLACK	6
7	PK-API	E 3/8" x 3' x 1'-0" W/ (2) 5/8" x 3' HS (GALV.)	7
8			
9			
10		DAYTON 6T x 10' SHIFT LIFT ANCH. (BLACK) (WITH RECESS PLUG)	4
11			
12			
13			
14			
15			

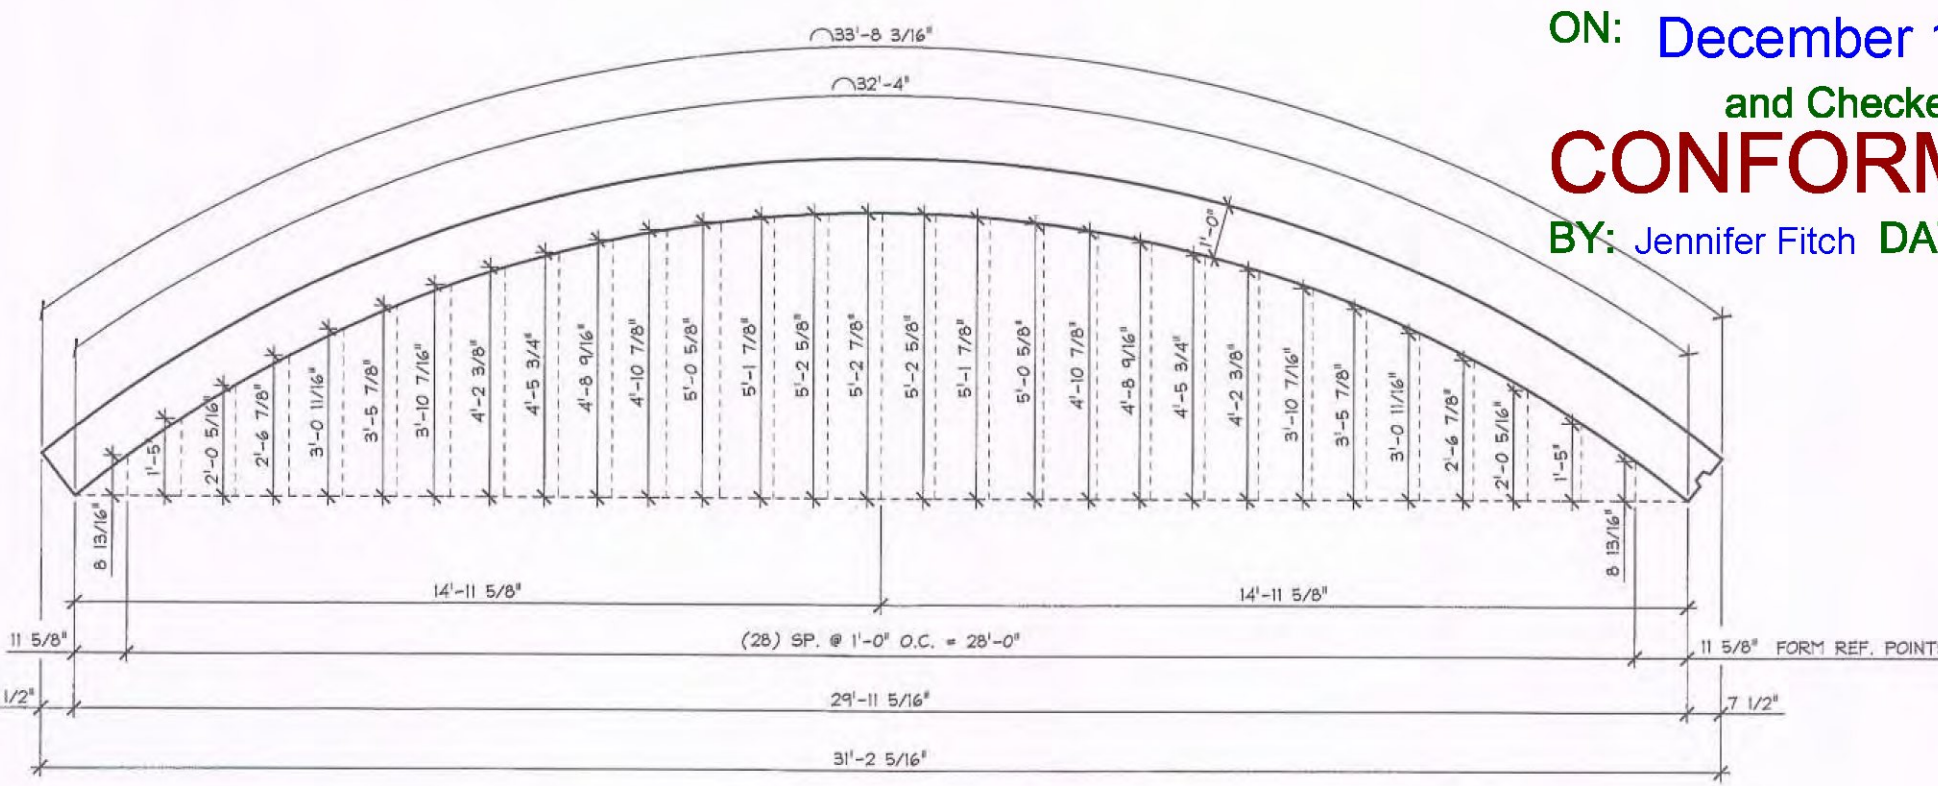

ARCH PANEL ELEV. IN FORM
3/8" = 1'-0"

Vermont Agency of Transportation
RECEIVED
ON: December 16, 2013
and Checked for
CONFORMANCE
BY: Jennifer Fitch DATE: 12/18/2013

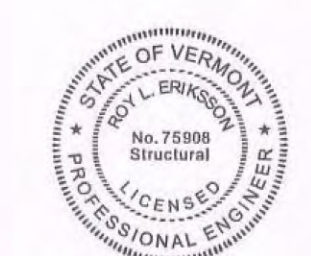

Jennifer Fitch
12.16.13

APPROVAL STAMP:

J.P. CARRARA & SONS INC.
Precast & Prestress Manufacturer
244 ONE DR. MIDDLEBURY, VERMONT 05753 Phone: (802)389-6361 Fax: (802)389-9010

T. BUCK CONSTRUCTION
CONTRACTOR
AUBURN, MAINE

STATE OF VERMONT AGENCY OF TRANSPORTATION
COUNTY OF ADDISON

TOWN OF MIDDLEBURY
ROUTE NO. VT 125, EAST MIDDLEBURY GORGE
BRIDGE NO. 1 PROJECT NO.: RS 0174(8)

DATE: OCT. 9, 2013
SCALE: NOTED
CHKD: DFTM: T.D.
JOB NO:
DWG. NO: AR5

PRECAST ARCH PANEL DETAILS