

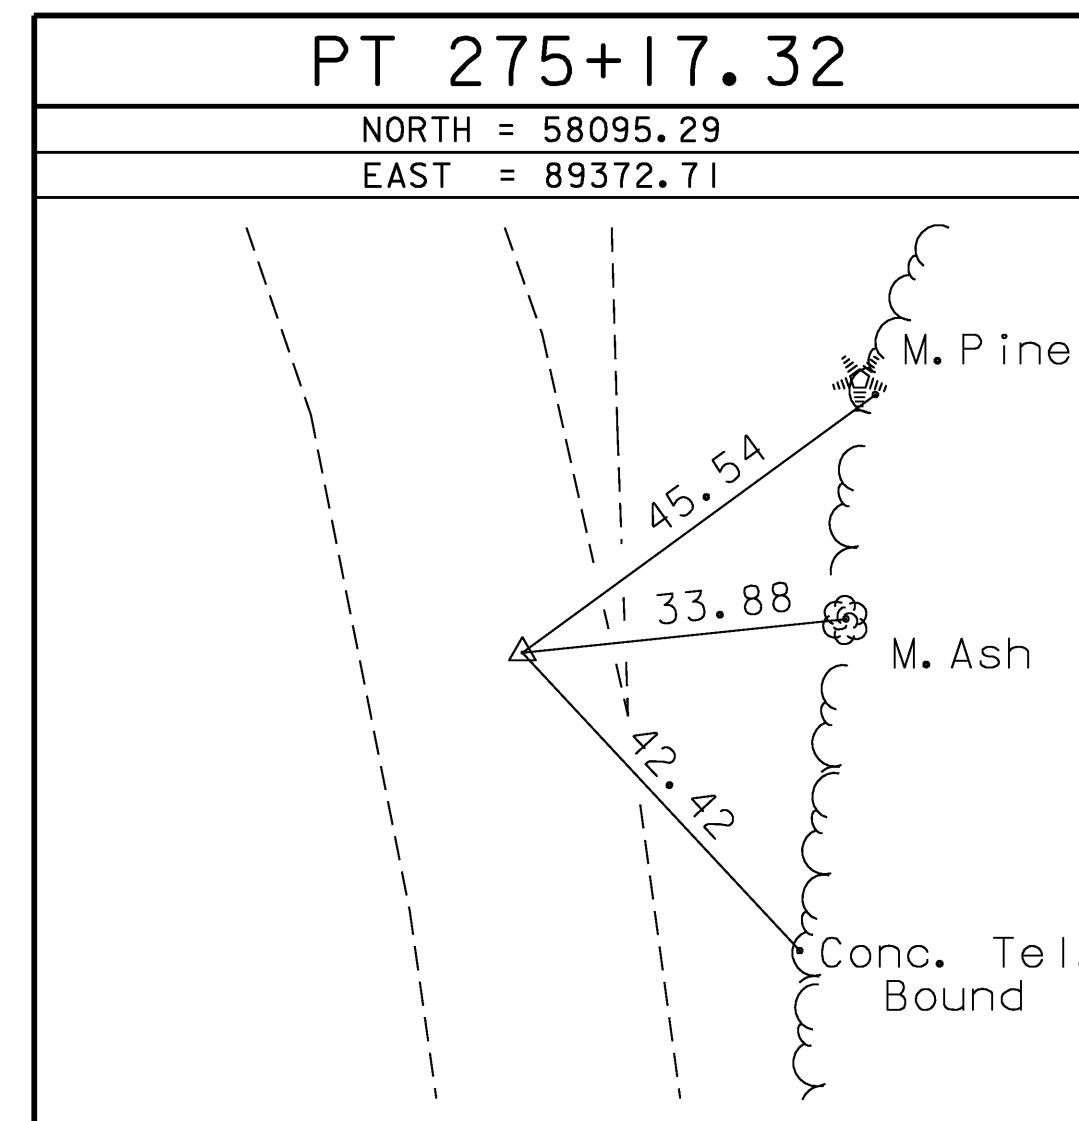
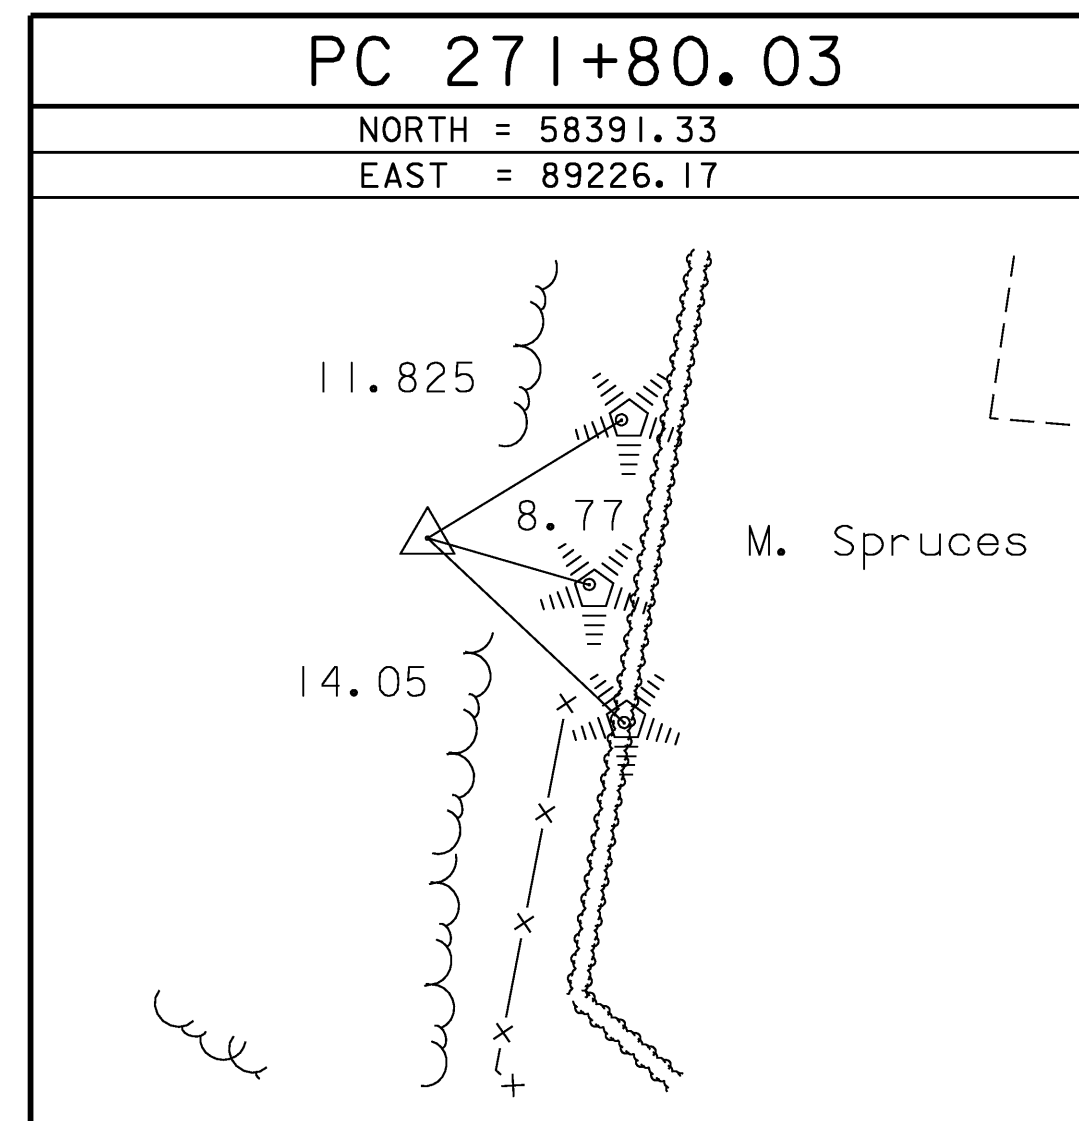
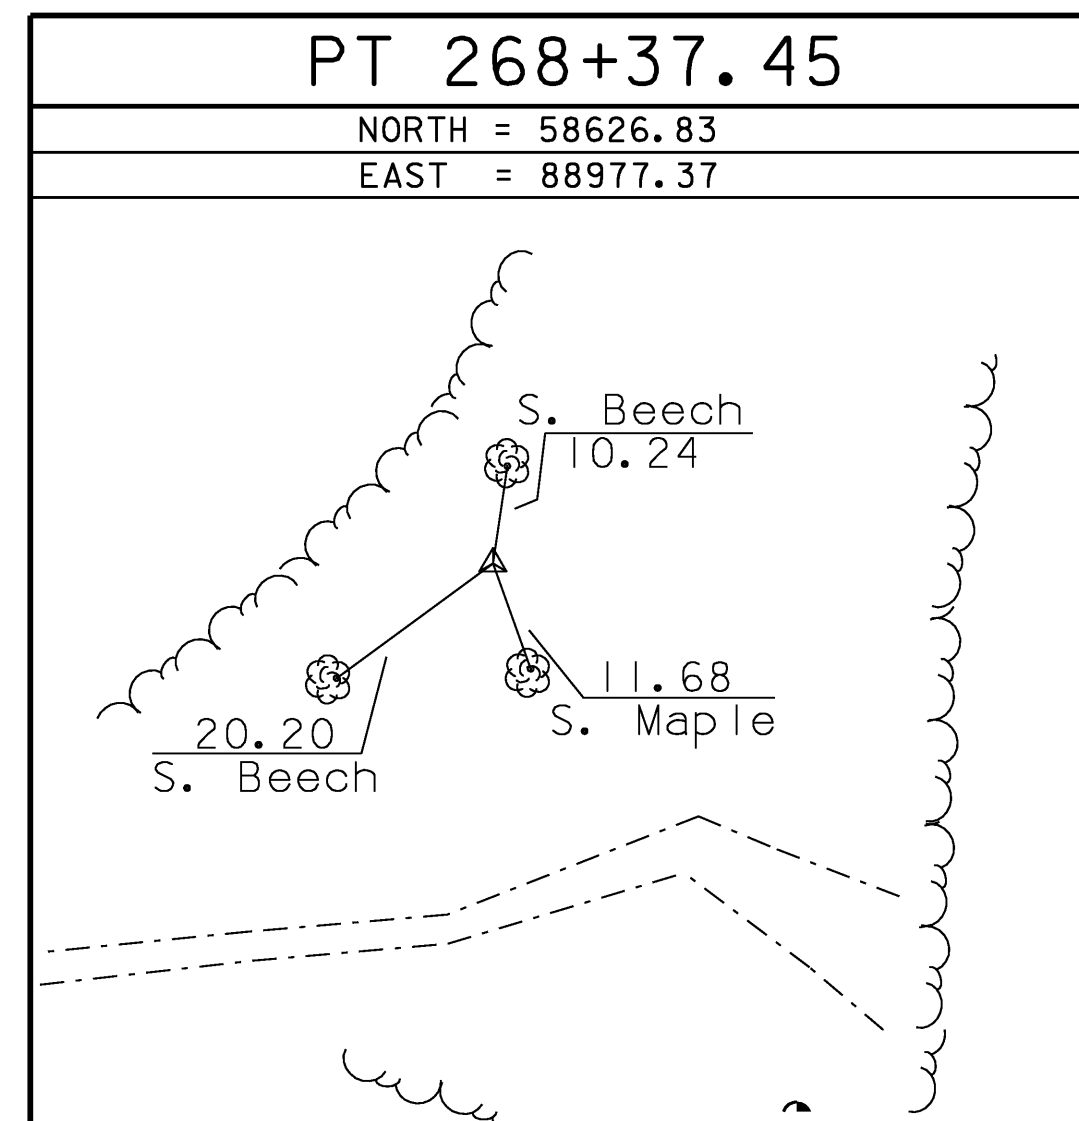
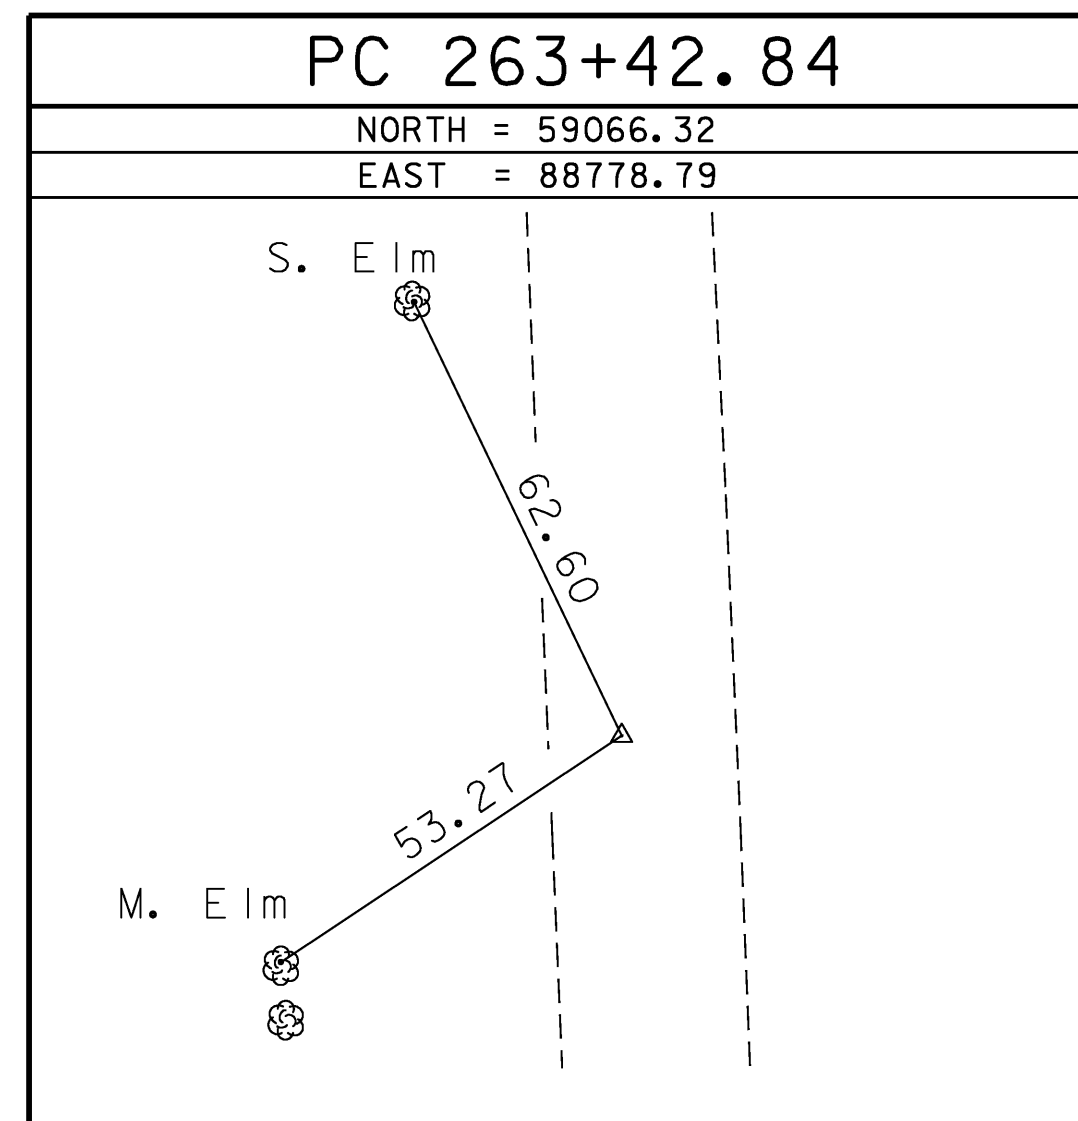 
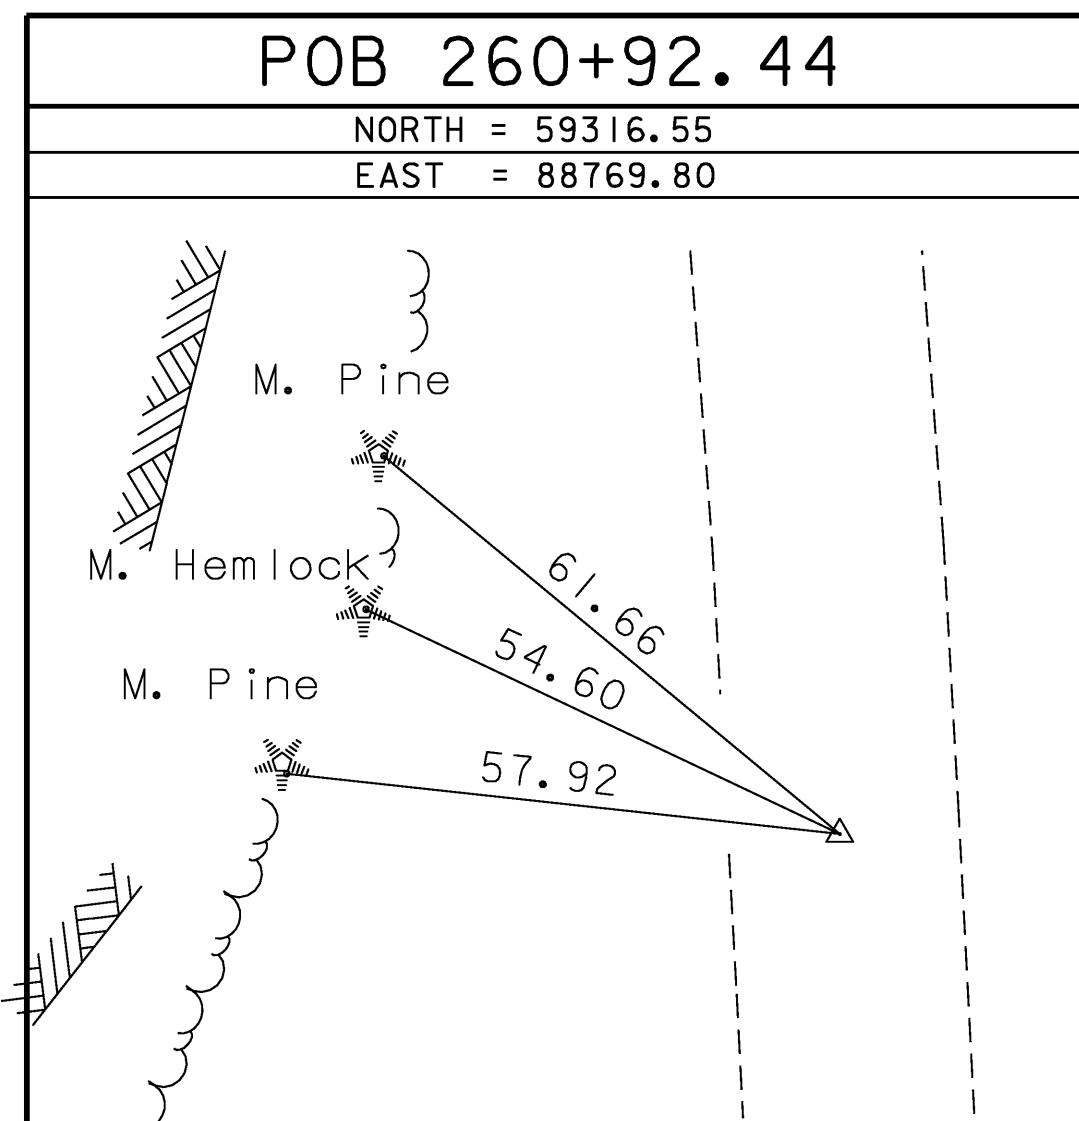 
 
 



ALIGNMENT TIES



• ALIGNMENT STAKED 06/06/03 by J. Hulett & P. Winters & A. Somaini

ALIGNMENT TIES

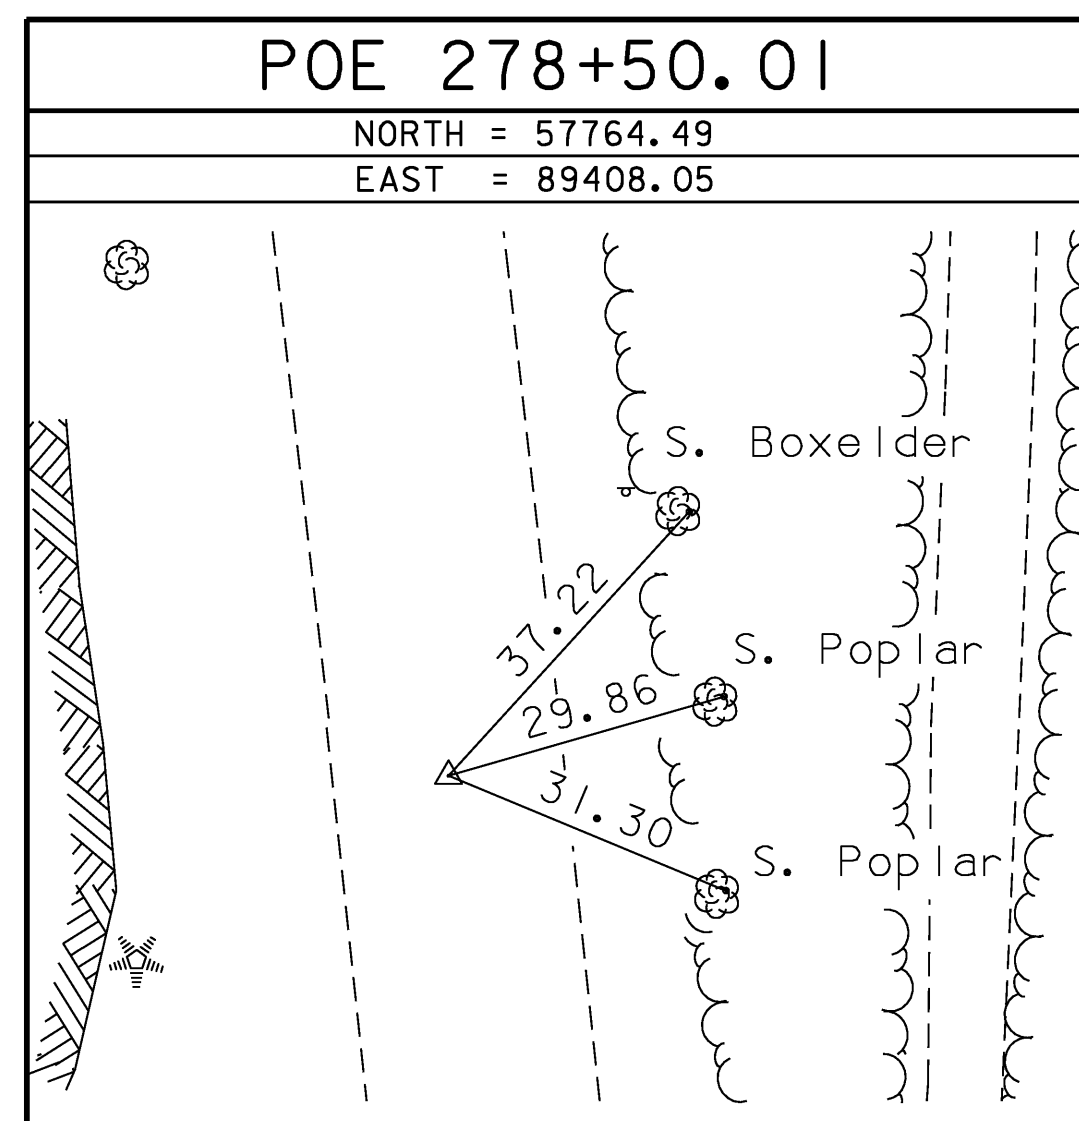

DATUM	
VERTICAL	NAVD 83
HORIZONTAL	NAD 88
ADJUSTMENT	Compass

TIE SHEET #2

PROJECT NAME: Moretown - Middlesex	
PROJECT NUMBER: BRS 0284 (14)	
FILE NAME: 78f219/survey/xf219+1.dgn	PLOT DATE: 15-JUN-2009
PROJECT LEADER: M. EVANS-MONGEON	DRAWN BY: R. Bullock
DESIGNED BY: M. EVANS-MONGEON	CHECKED BY: L. RUSSEL
	SHEET 11 OF 103