


NOTE: THE INFORMATION IN THIS PLAN SHEET SHALL BE USED IN CONJUNCTION WITH THE ROADWAY CROSS SECTIONS AND TH#9 CROSS SECTIONS FOR PROPER DITCH LAYOUT.

ALL DIMENSIONS ON THIS SHEET ARE MEASURED FROM THE CENTERLINE OF RT. 2 OR TH 9 TO THE CENTER OF THE INDICATED DITCH

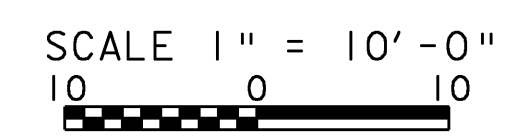

**DITCH LAYOUT SHEET 1**

PROJECT NAME:	MORETOWN-MIDDLESEX	PLOT DATE:	15-JUN-2009
PROJECT NUMBER:	BRS 0284(14)	DRAWN BY:	G. ROKES
FILE NAME:	78f219\STR\s78f219d1p.dgn	CHECKED BY:	S. SCRIBNER
PROJECT LEADER:	M. EVANS-MONGEON	SHEET	15 OF 103
DESIGNED BY:	G. ROKES		

SET THIS SECTION OF DITCH BY TH 9 CROSS SECTIONS

USE ROADWAY CROSS SECTIONS AND TH 9 CROSS SECTIONS TO SET DITCH CENTERLINE.

FLARE END OF DITCH AND ALLOW TO DRAIN INTO FIELD

