



# US 2 PROPOSED PROFILE

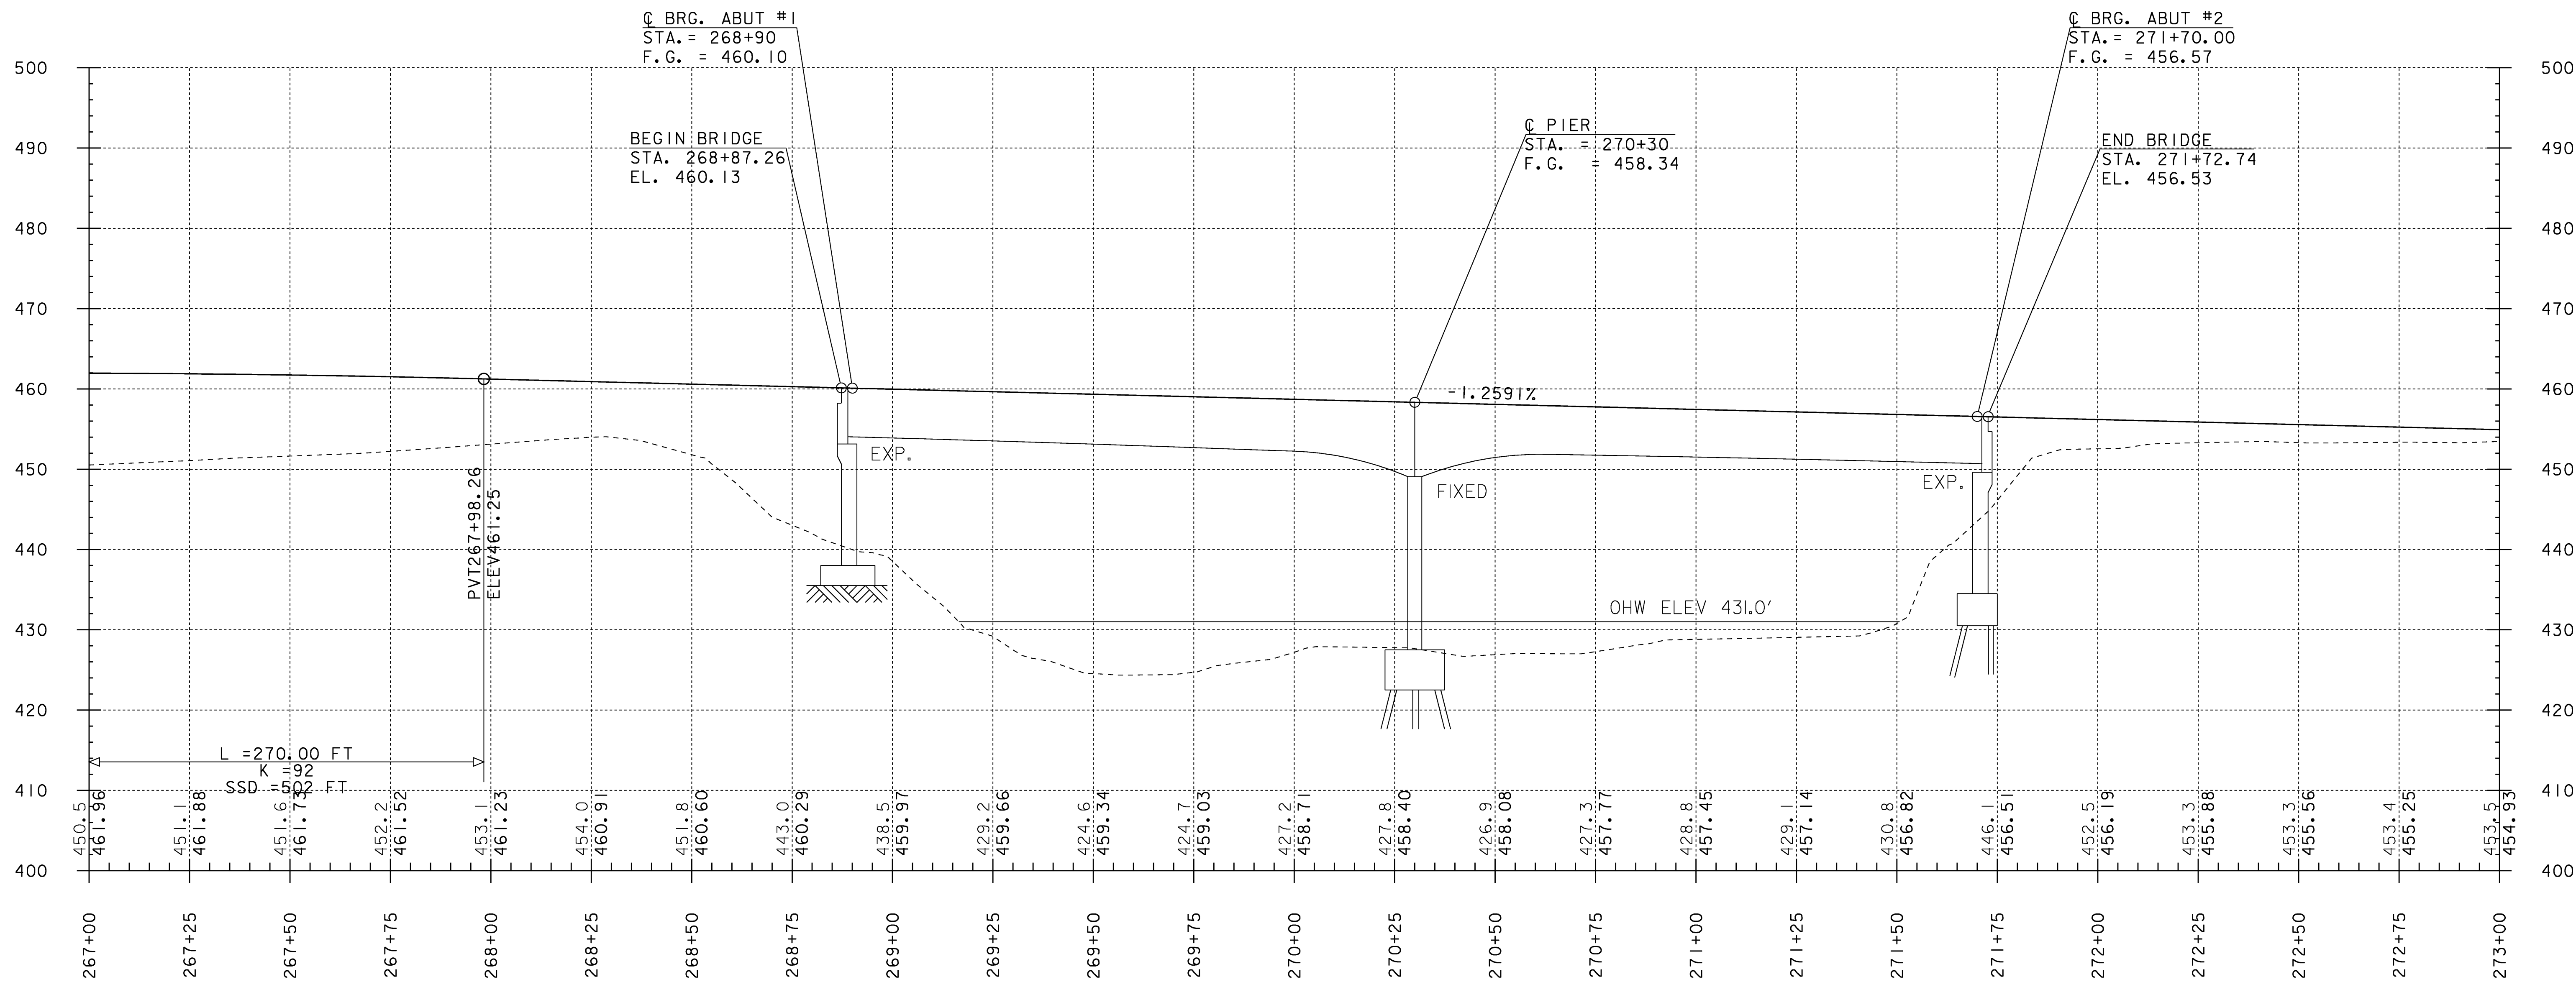

NOTE: ELEVATIONS SHOWN TO THE TENTH ARE EXISTING GROUND  
ELEVATIONS SHOWN TO THE HUNDREDTH ARE FINISH GRADE

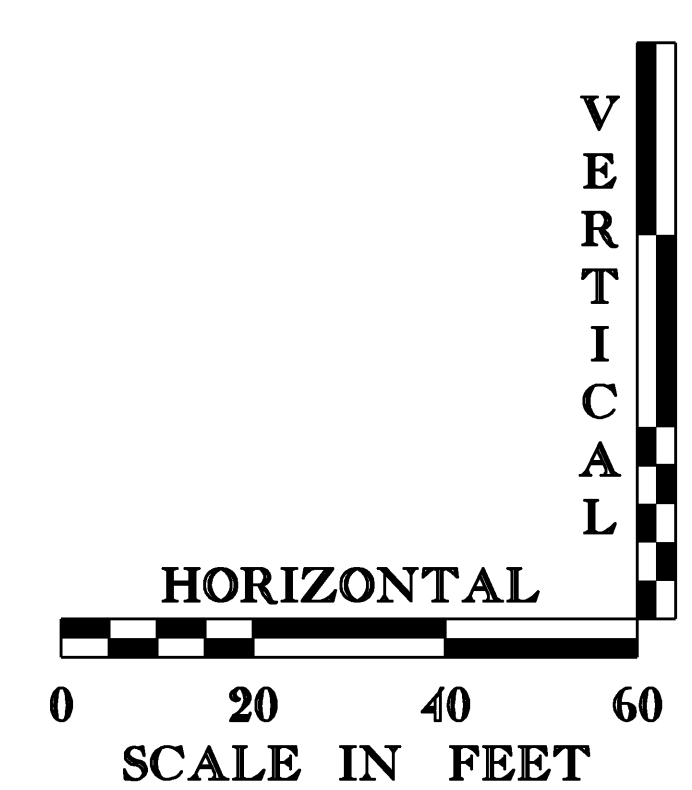

## US 2 PROFILE SHEET #2

PROJECT NAME: MORETOWN-MIDDLESEX  
PROJECT NUMBER: BRS 0284(14)

FILE NAME: 78f219/str/s78f219xs3.dgn  
PROJECT LEADER: M. EVANS-MONGEON  
DESIGNED BY: S. SCRIBNER  
IPARM: s78f219pfl.i

PLOT DATE: 15-JUN-2009  
DRAWN BY: L. DUQUETTE  
CHECKED BY: S. SCRIBNER  
SHEET 18 OF 103