


LEGEND	
	WETLAND
	SOIL TYPE BOUNDARY
	FLOOD PLAIN
	ARCHAEOLOGY
	RIPARIAN BUFFER
	OHW (ORDINARY HIGH WATER)

SOIL INFORMATION
 ONDAWA FINE SANDY LOAM
 SLOPE 0-3%
 HYDROLOGIC SOIL GROUP: B
 WELL TO MODERATELY WELL DRAINING
 LOW ERODIBILITY

SOIL INFORMATION
 ONDAWA FINE SANDY LOAM
 SLOPE 0-3%
 HYDROLOGIC SOIL GROUP: B
 WELL TO MODERATELY WELL DRAINING
 LOW ERODIBILITY

SOIL INFORMATION
 RUMNEY FINE SANDY LOAM
 SLOPE 0-2%
 HYDROLOGIC SOIL GROUP: C
 POOR DRAINING
 LOW ERODIBILITY

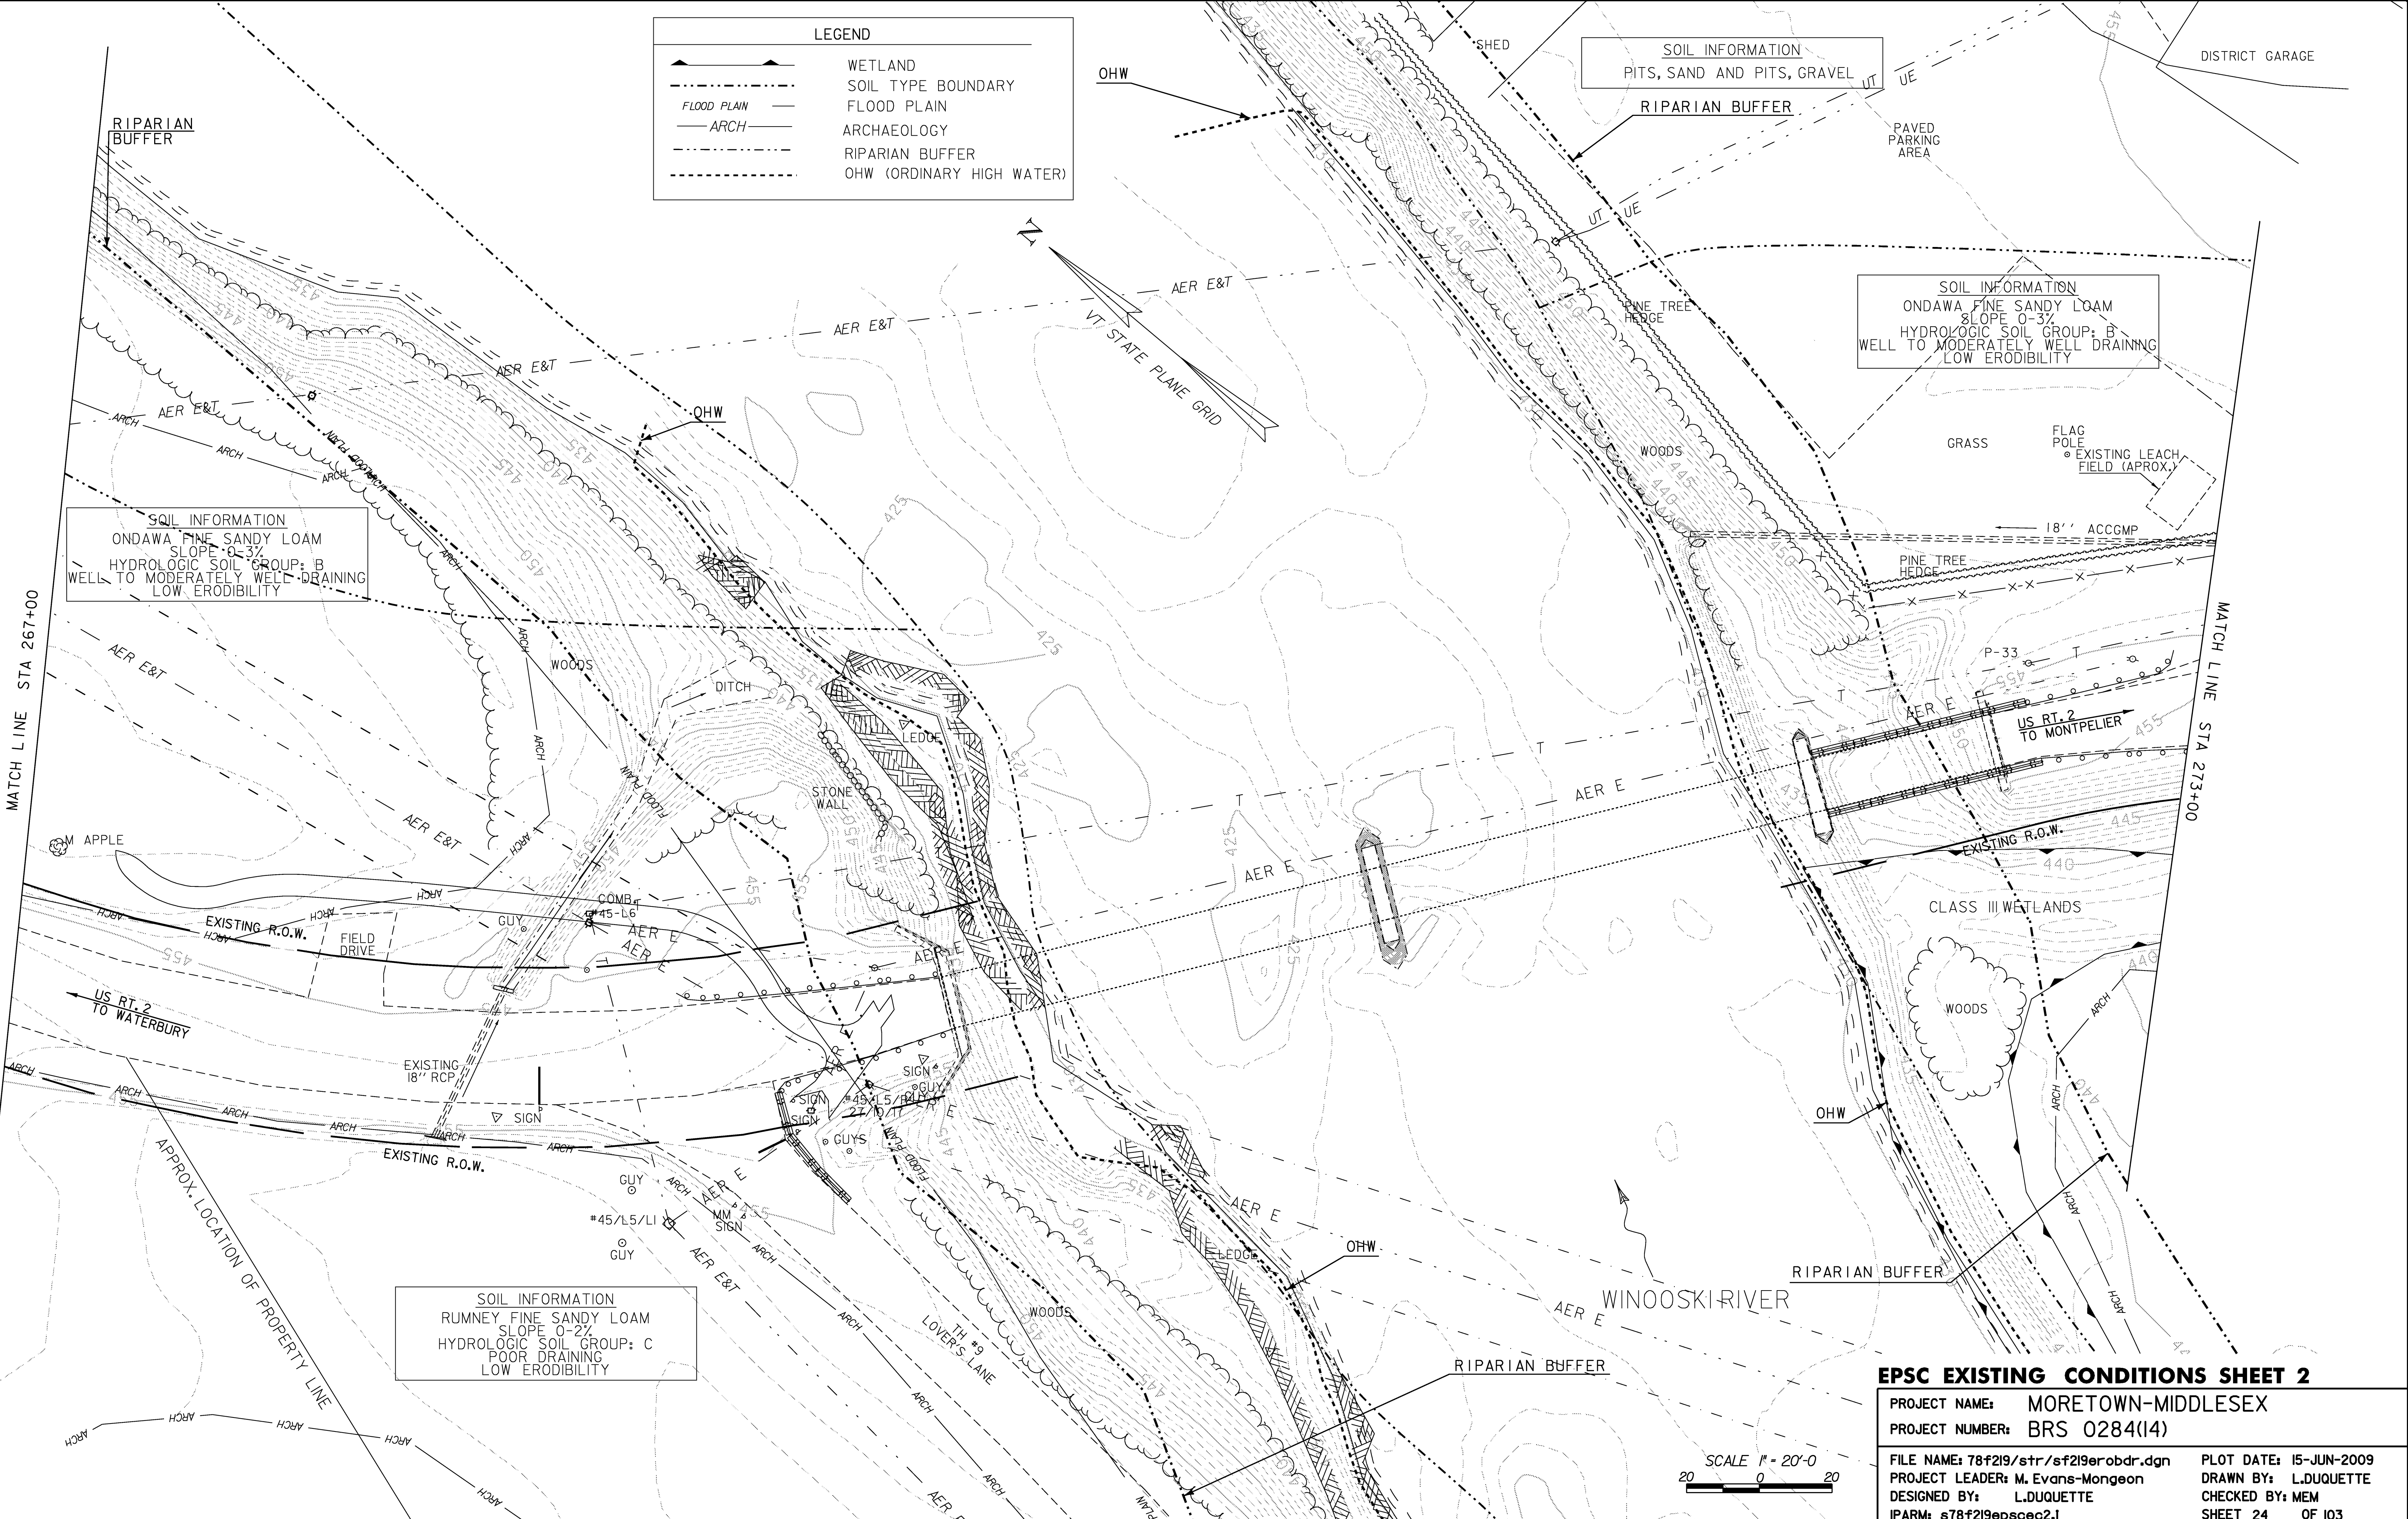

EPSC EXISTING CONDITIONS SHEET 2

PROJECT NAME: MORETOWN-MIDDLESEX
 PROJECT NUMBER: BRS 0284(14)

FILE NAME: 78f219/str/sf219erobdr.dgn PLOT DATE: 15-JUN-2009
 PROJECT LEADER: M. Evans-Mongeon DRAWN BY: L.DUQUETTE
 DESIGNED BY: L.DUQUETTE CHECKED BY: MEM
 IPARM: s78f219epscec2.1 SHEET 24 OF 103

