
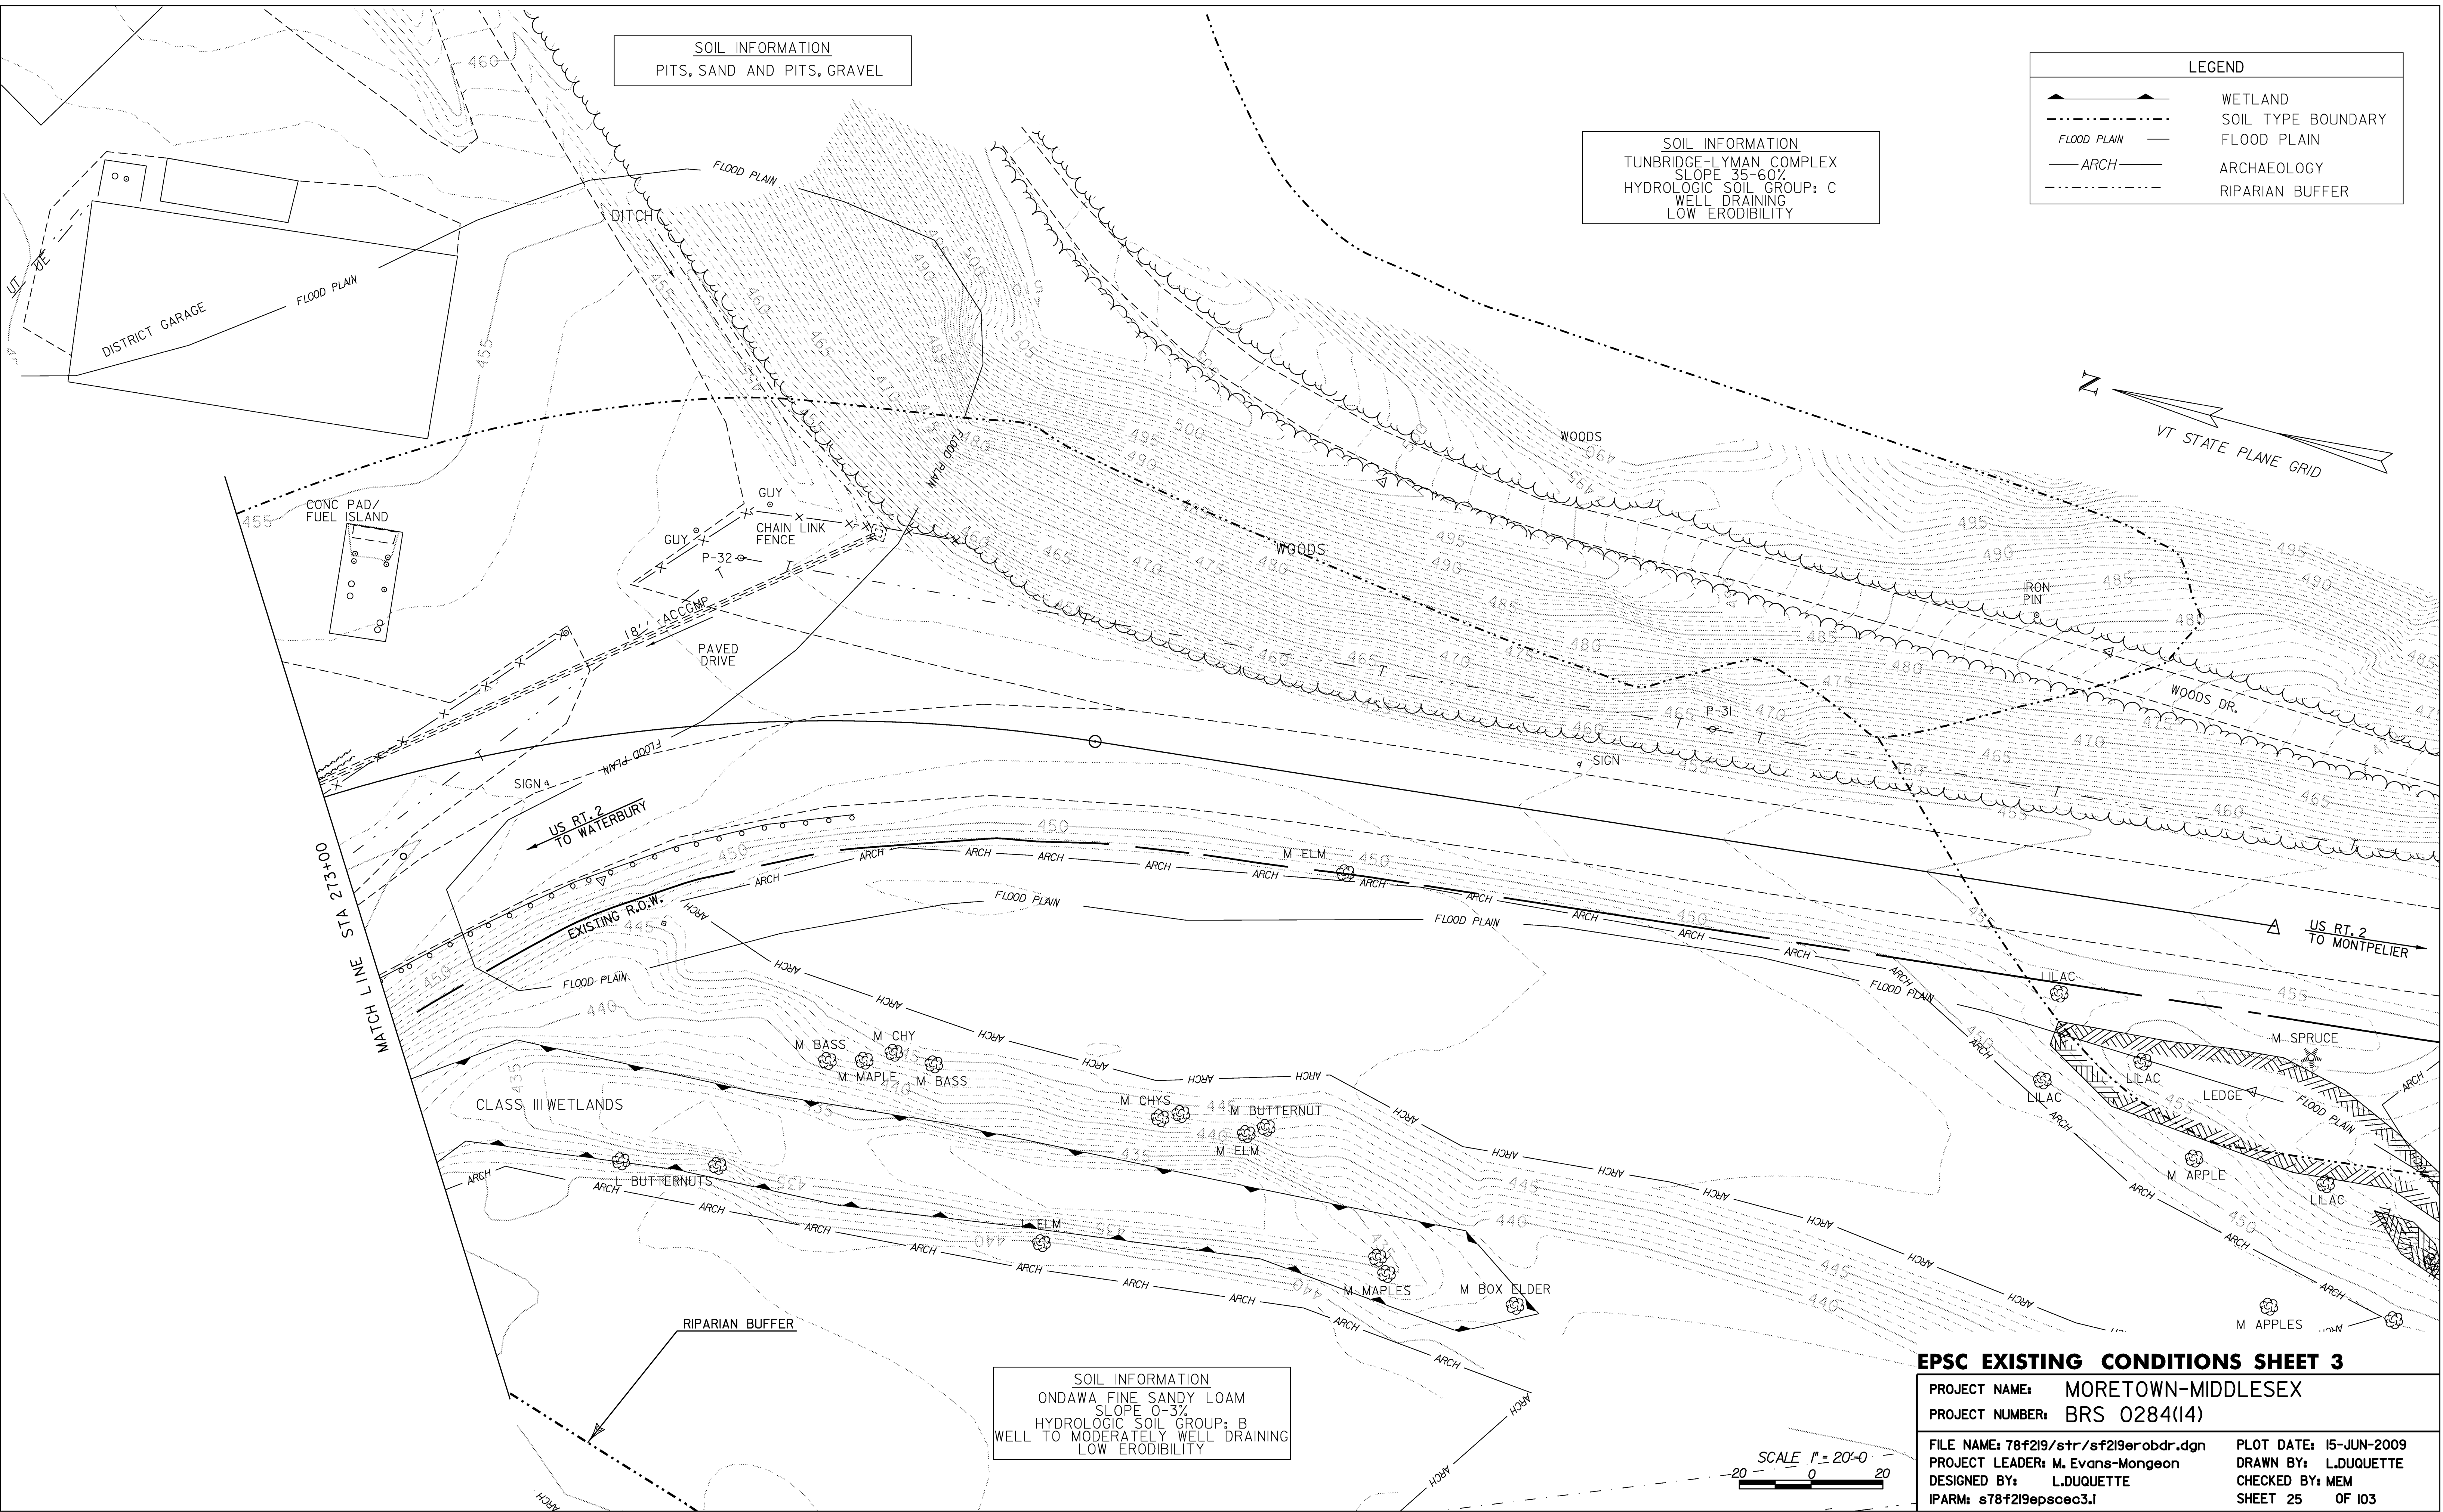


SOIL INFORMATION
PITS, SAND AND PITS, GRAVEL

SOIL INFORMATION
TUNBRIDGE-LYMAN COMPLEX
SLOPE 35-60%
HYDROLOGIC SOIL GROUP: C
WELL DRAINING
LOW ERODIBILITY

SOIL INFORMATION
ONDAWA FINE SANDY LOAM
SLOPE 0-3%
HYDROLOGIC SOIL GROUP: B
WELL TO MODERATELY WELL DRAINING
LOW ERODIBILITY

LEGEND	
	WETLAND
	SOIL TYPE BOUNDARY
	FLOOD PLAIN
	ARCHAEOLOGY
	RIPARIAN BUFFER

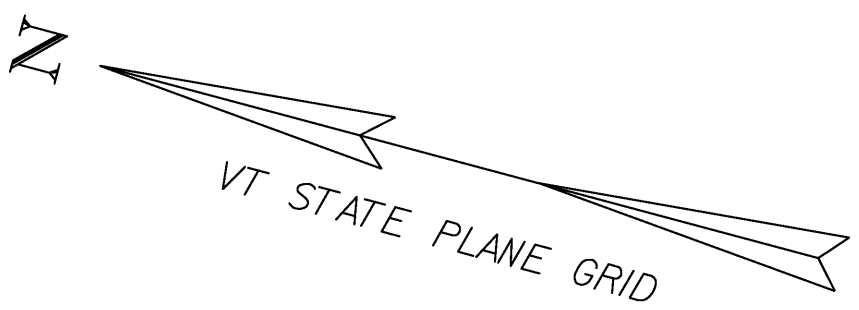

EPSC EXISTING CONDITIONS SHEET 3

PROJECT NAME: MORETOWN-MIDDLESEX	PLOT DATE: 15-JUN-2009
PROJECT NUMBER: BRS 0284(I4)	DRAWN BY: L.DUQUETTE
FILE NAME: 78f219/str/sf219erobdr.dgn	CHECKED BY: MEM
PROJECT LEADER: M. Evans-Mongeon	SHEET 25 OF 103
DESIGNED BY: L.DUQUETTE	
IPAR: s78f219epscec3.1	

