


LEGEND			
BF	Barrier Fence	PDF	PDF - Project Demarcation Fence
[Cross-hatched box]	Temp. erosion Control Matting	[Dashed line]	Defined Limits of Disturbance
[Wavy line]	Woven Wire Silt Fence	[Circle with cross]	Stone Fill, Type IV (as Indicated)
[Dashed line]	Silt Fence	[Circle with dot]	Stone Fill, Type II (as Indicated)
[Circle with triangle]	Perm. Construction Limits	[Dashed line]	OHW - Ordinary High Water
[Circle with triangle]	Temp. Construction Limits	[Wavy line]	Wetland
[Wavy line]	Turbidity Curtain	ARCH	Archaeology
[Dashed line]	Riparian buffer	[Hatched box]	Stabilized construction entrance

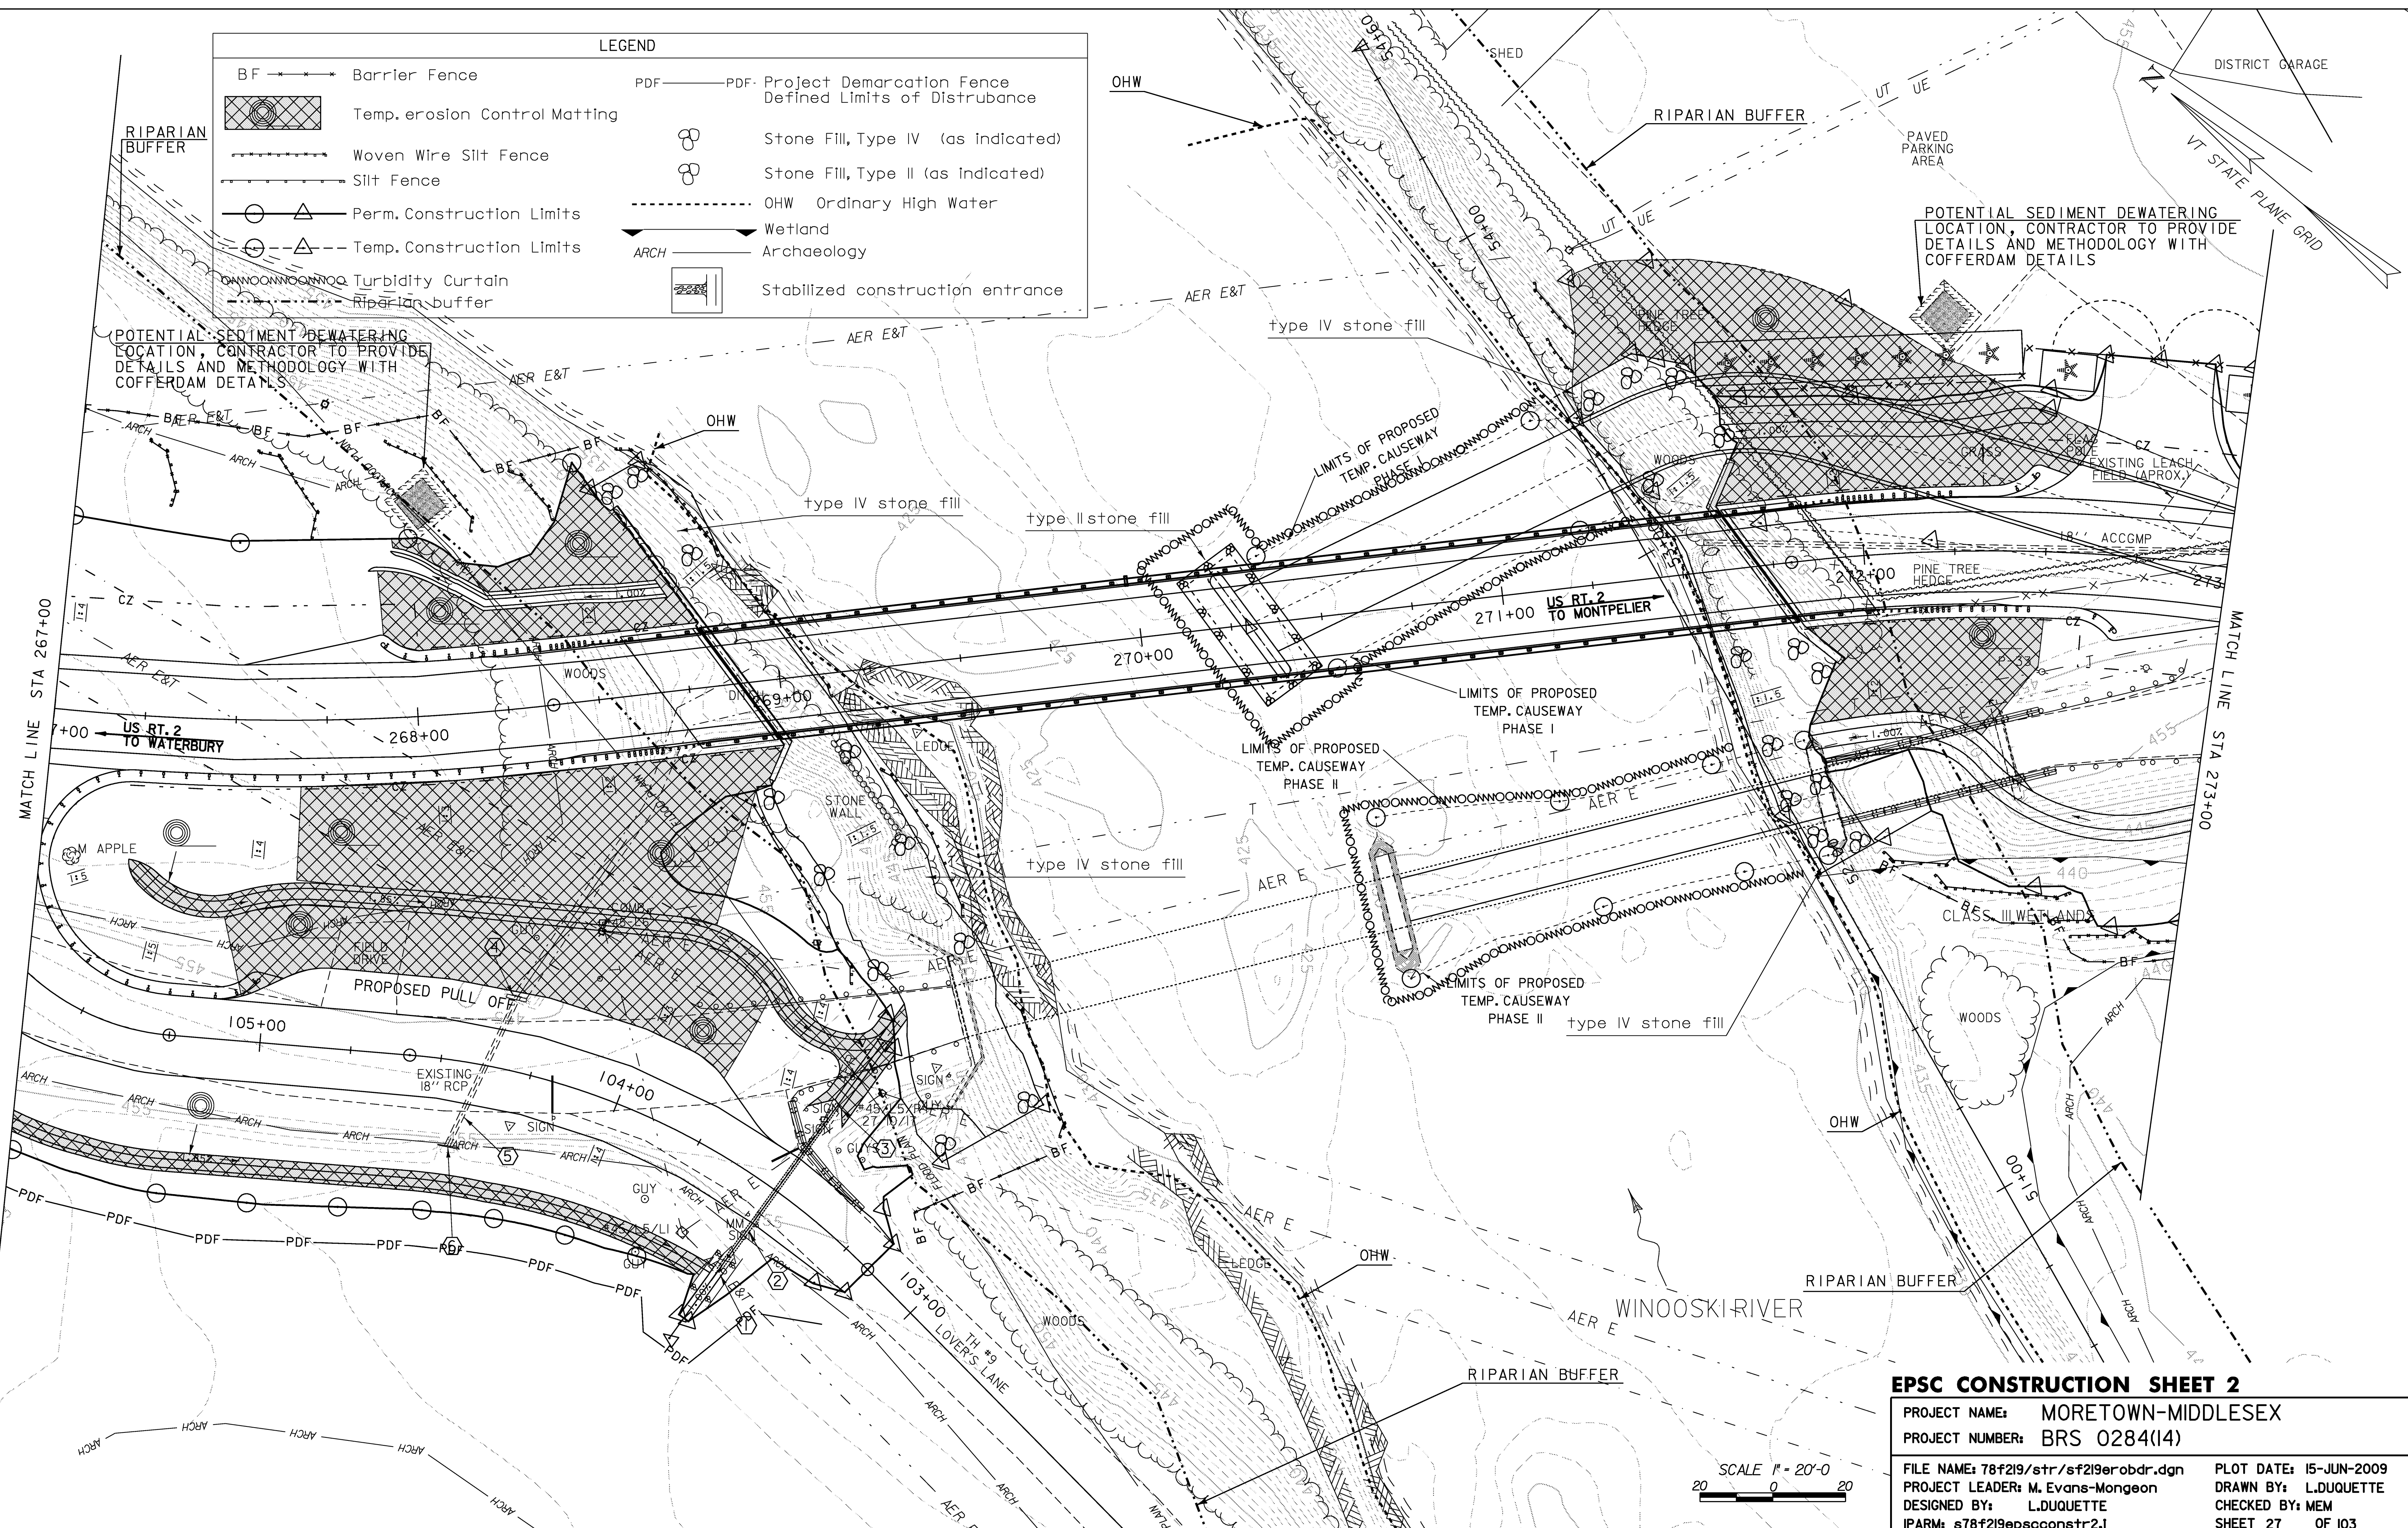

**EPSC CONSTRUCTION SHEET 2**

PROJECT NAME: MORETOWN-MIDDLESEX  
 PROJECT NUMBER: BRS 0284(14)

FILE NAME: 78f219/str/sf219erobdr.dgn  
 PROJECT LEADER: M. Evans-Mongeon  
 DESIGNED BY: L. DUQUETTE  
 IPARM: s78f219epsconstr2.1

PLOT DATE: 15-JUN-2009  
 DRAWN BY: L. DUQUETTE  
 CHECKED BY: MEM  
 SHEET 27 OF 103