
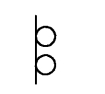

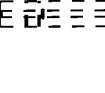



LEGEND

-  - TYPE III BARRICADES
-  - SIGN AND POSTS
-  - (ETTBA) EXISTING TEMPORARY TRAFFIC BARRIER (3 EA BARRIERS ON SITE)
-  - (PTTB) PROPOSED TEMPORARY TRAFFIC BARRIER ARE RELOCATED (ETTBA'S) AFTER THE TRAFFIC IS MOVED TO PROPOSED ALIGNMENT.

SCALE 1" = 75'-0"


TRAFFIC CONTROL SHEET

PROJECT NAME: MORETOWN-MIDDLESEX	PLOT DATE: 15-JUN-2009
PROJECT NUMBER: BRS 0284(14)	DRAWN BY: G. ROKES
FILE NAME: /78f219/str/sf219tc.dgn	CHECKED BY: S. SCRIBNER
PROJECT LEADER: M. Evans-Mongeon	SHEET 36 OF 103
DESIGNED BY: G. ROKES	
IPARM: s78f219tc.i	

NOTE: ONCE TRAFFIC IS ON THE PROPOSED STRUCTURE, TYPE III BARRICADES AND "BRIDGE CLOSED" SIGNS SHALL BE PLACED IN FRONT OF THE (PTTB) BARRIERS.