

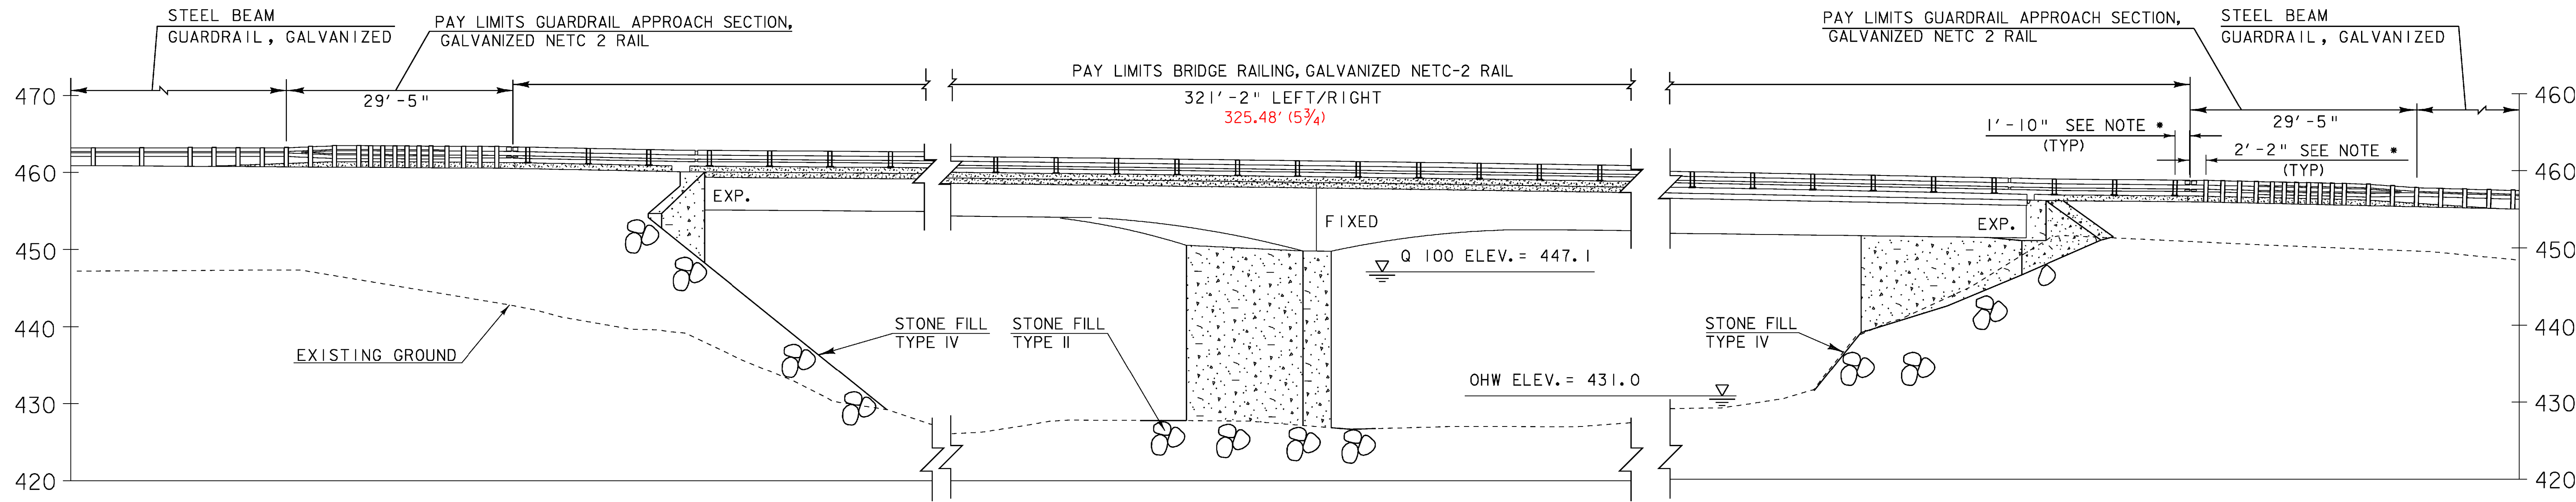


PLAN

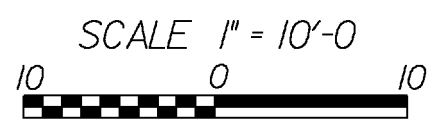

ELEVATION

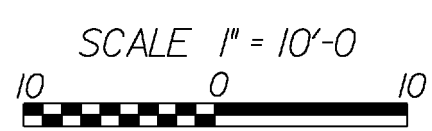

NOTE * SEE BRIDGE RAILING DETAILS SHEET #72

PLAN AND ELEVATION SHEET

PROJECT NAME:	MORETOWN-MIDDLESEX	FILE NAME:	/78f219/str/sf219pe.dgn	PLOT DATE:	15-JUN-2009
PROJECT NUMBER:	BRS 0284(14)	PROJECT LEADER:	M. Evans-Mongeon	DRAWN BY:	G.Rokes
		DESIGNED BY:	S. Scribner	CHECKED BY:	S. Scribner
		IPARM:	s78f219pe.l	SHEET	43 OF 103