



ABUTMENT NO. 1 PLAN

SCALE 1/4" = 1'-0"  
 1 0 2 4 6

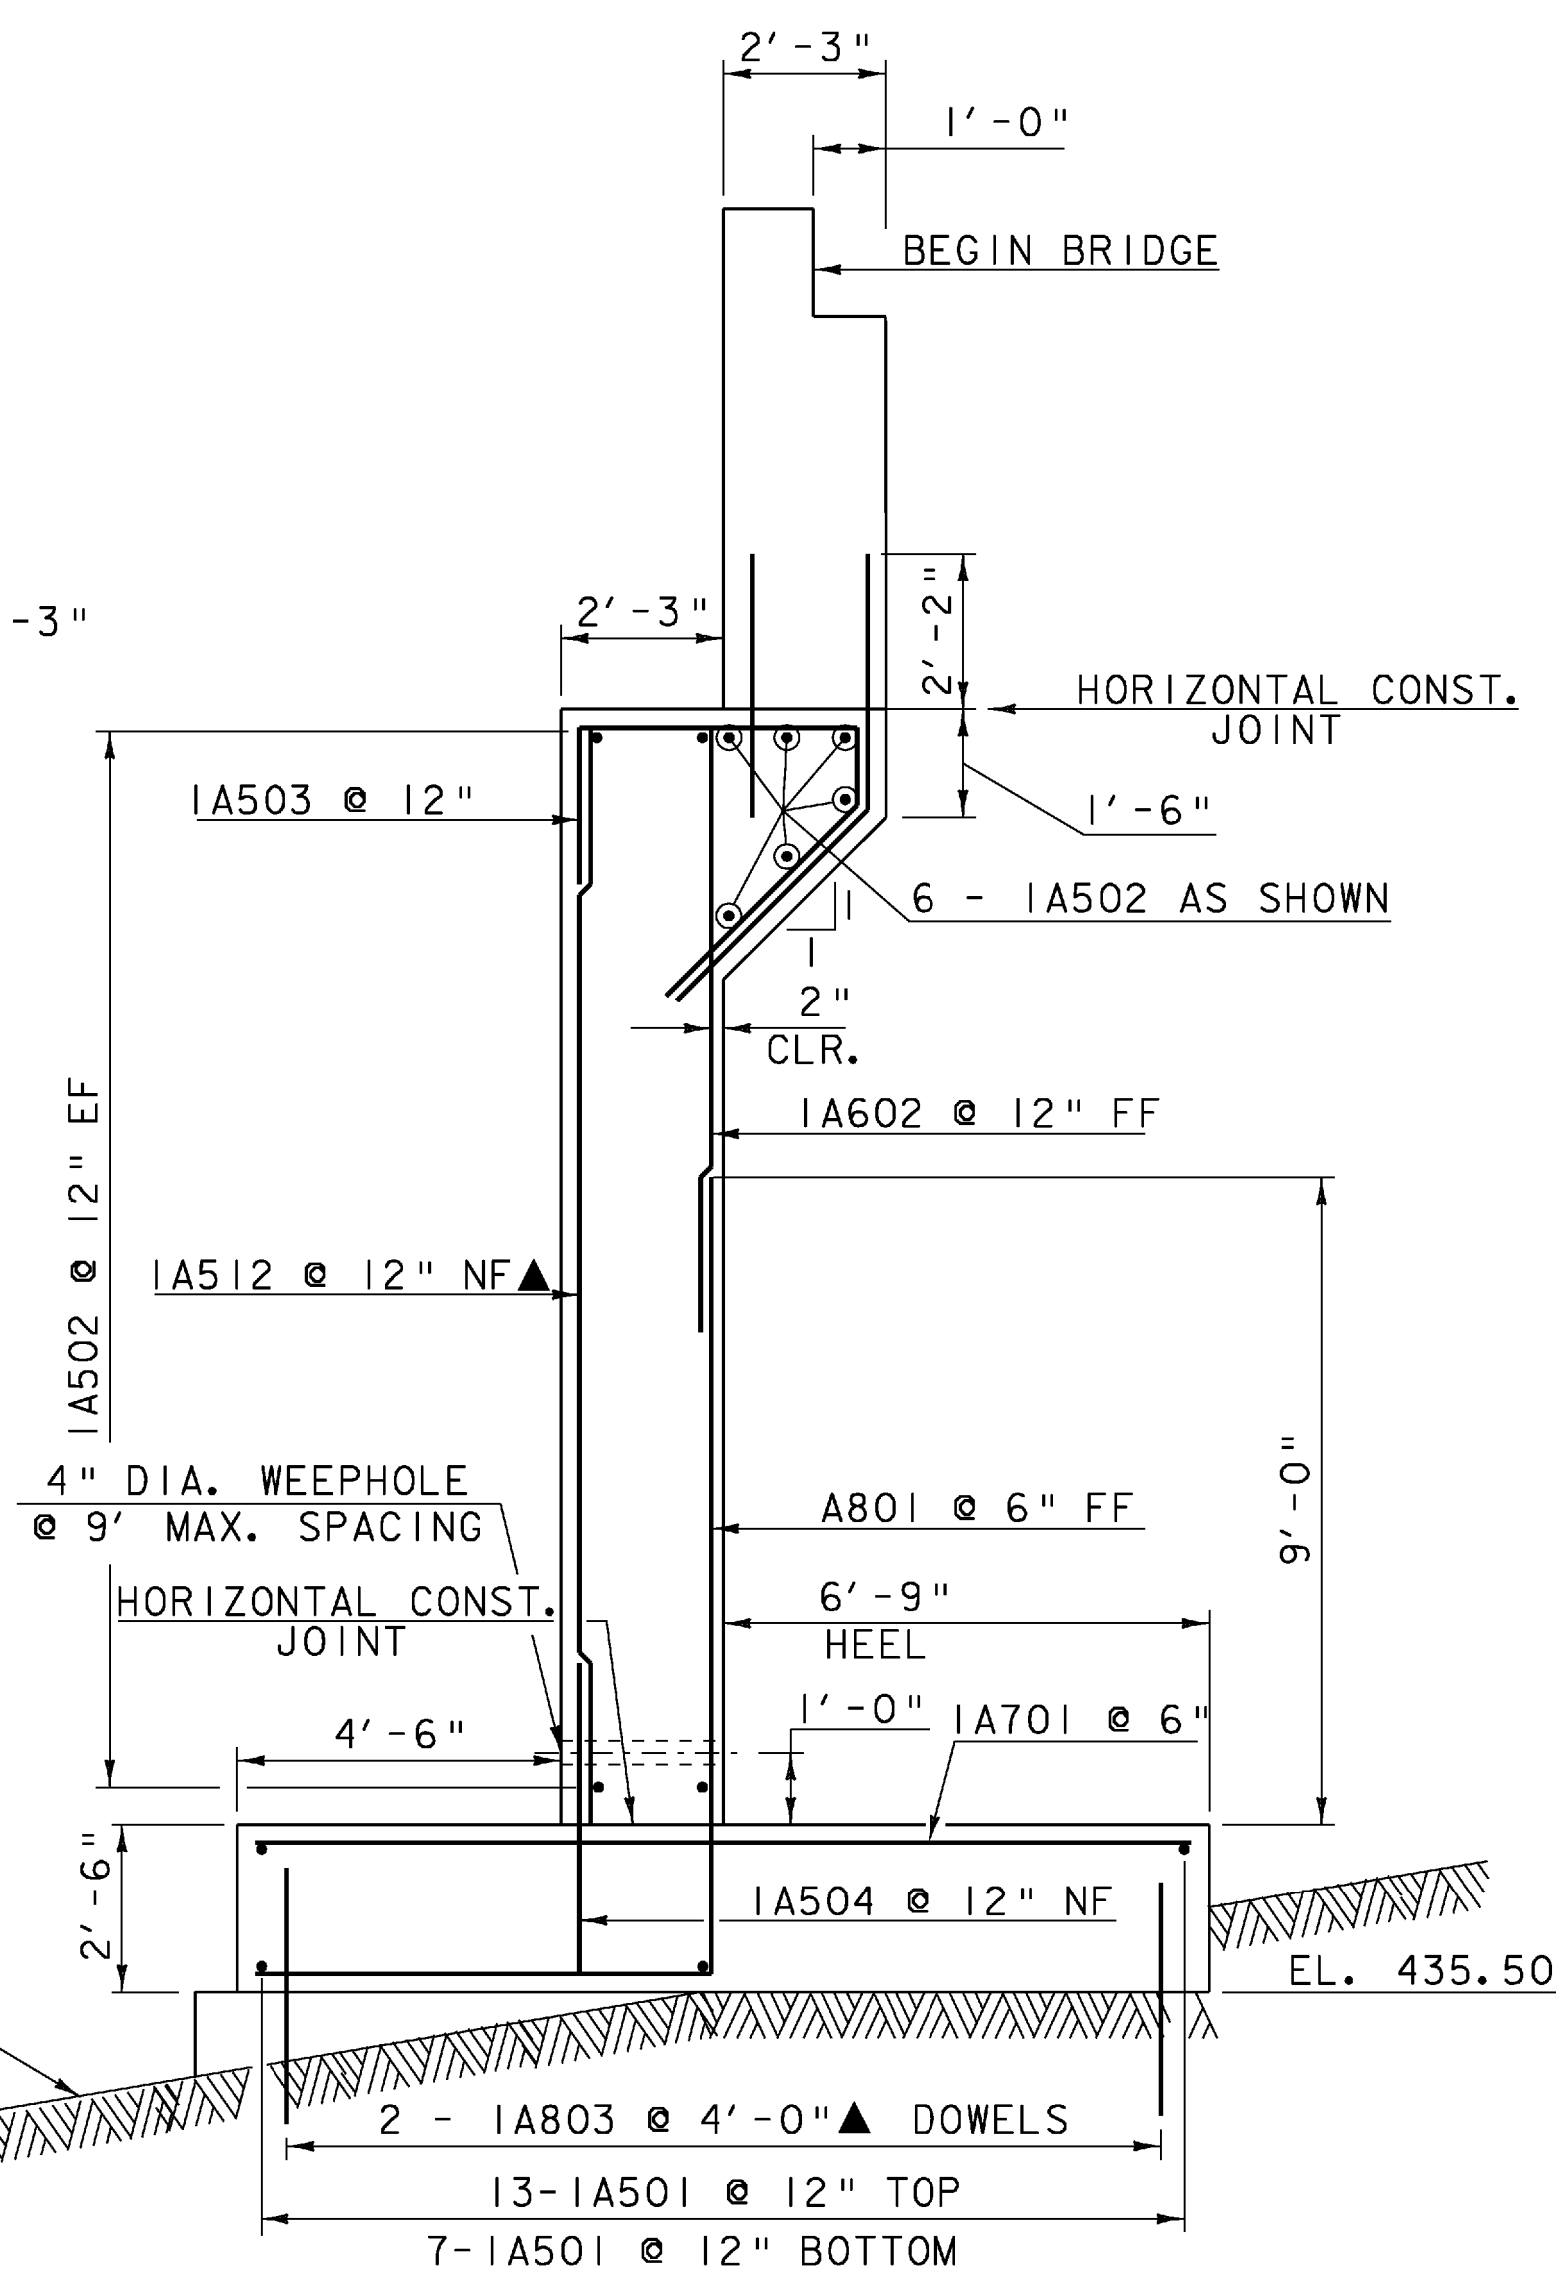

ABUTMENT NO. 1 TYPICAL

SCALE 3/8" = 1'-0"  
 1 0 1 2 3 4

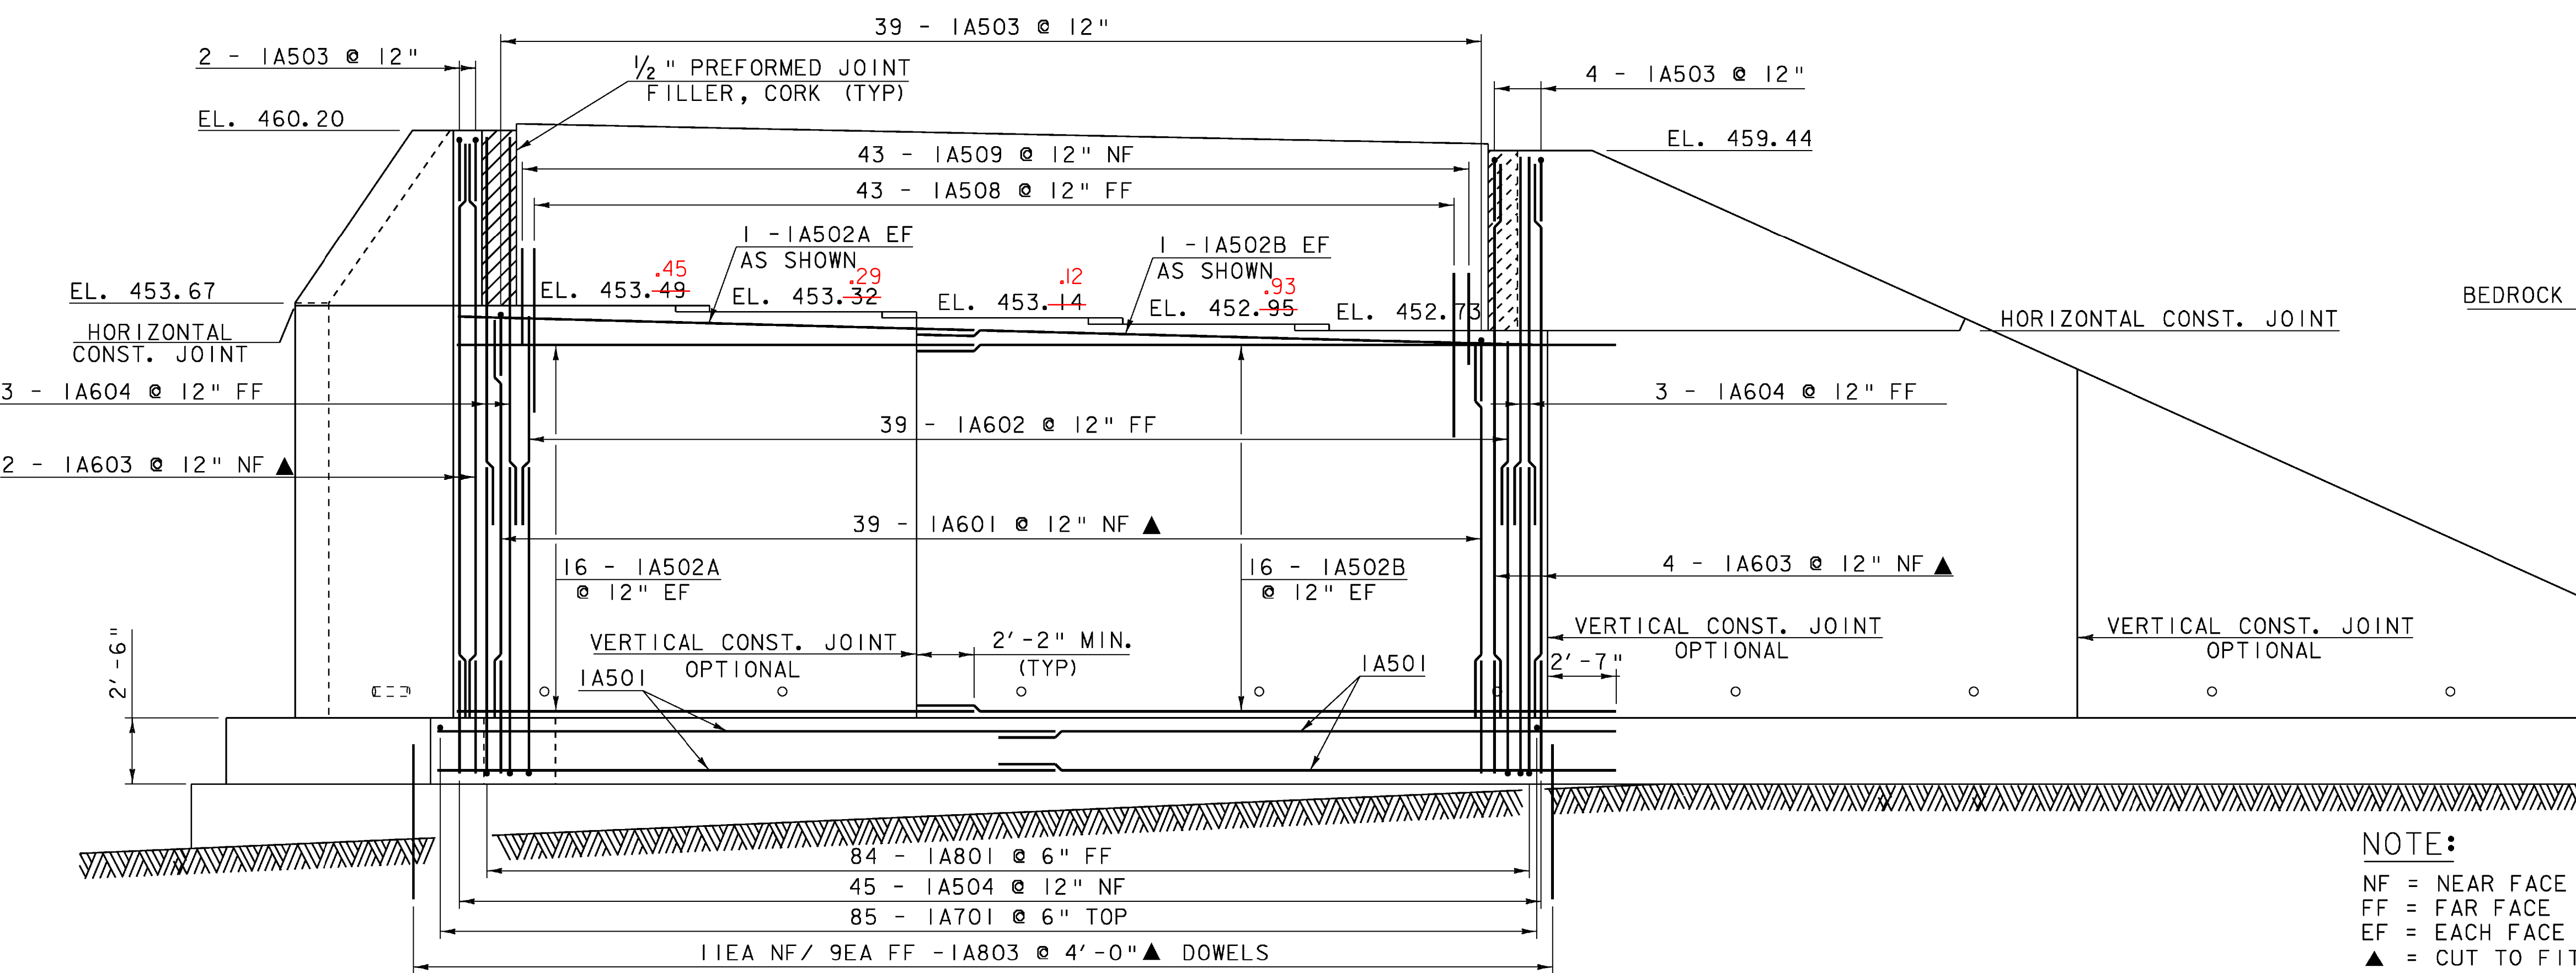

ABUTMENT NO. 1 ELEVATION

SCALE 1/4" = 1'-0"  
 1 0 2 4 6

**NOTE:**  
 NF = NEAR FACE  
 FF = FAR FACE  
 EF = EACH FACE  
 ▲ = CUT TO FIT IN FIELD  
 3" CLEAR, UNLESS OTHERWISE SPECIFIED ON THE PLANS.  
 2'-2" BAR LAP UNLESS OTHERWISE SPECIFIED ON THE PLANS.

NOTE: PAYMENT FOR FURNISHING AND INSTALLING PREFORMED JOINT FILLER, CORK WILL BE MADE INCIDENTAL TO THE ADJACENT CONCRETE.

**ABUTMENT #1 DETAILS**

PROJECT NAME:	MORETOWN-MIDDLESEX	PLOT DATE:	15-JUN-2009
PROJECT NUMBER:	BRS 0284(14)	DRAWN BY:	L. DUQUETTE
FILE NAME:	78f219/struc./sf219sub	CHECKED BY:	S. SCRIBNER
PROJECT LEADER:	M. EVANS-MONGEON	SHEET	64 OF 103
DESIGNED BY:	J. TREI		