



ABUTMENT NO. 2 PLAN

SCALE 1/4" = 1'-0"
 1 0 2 4 6

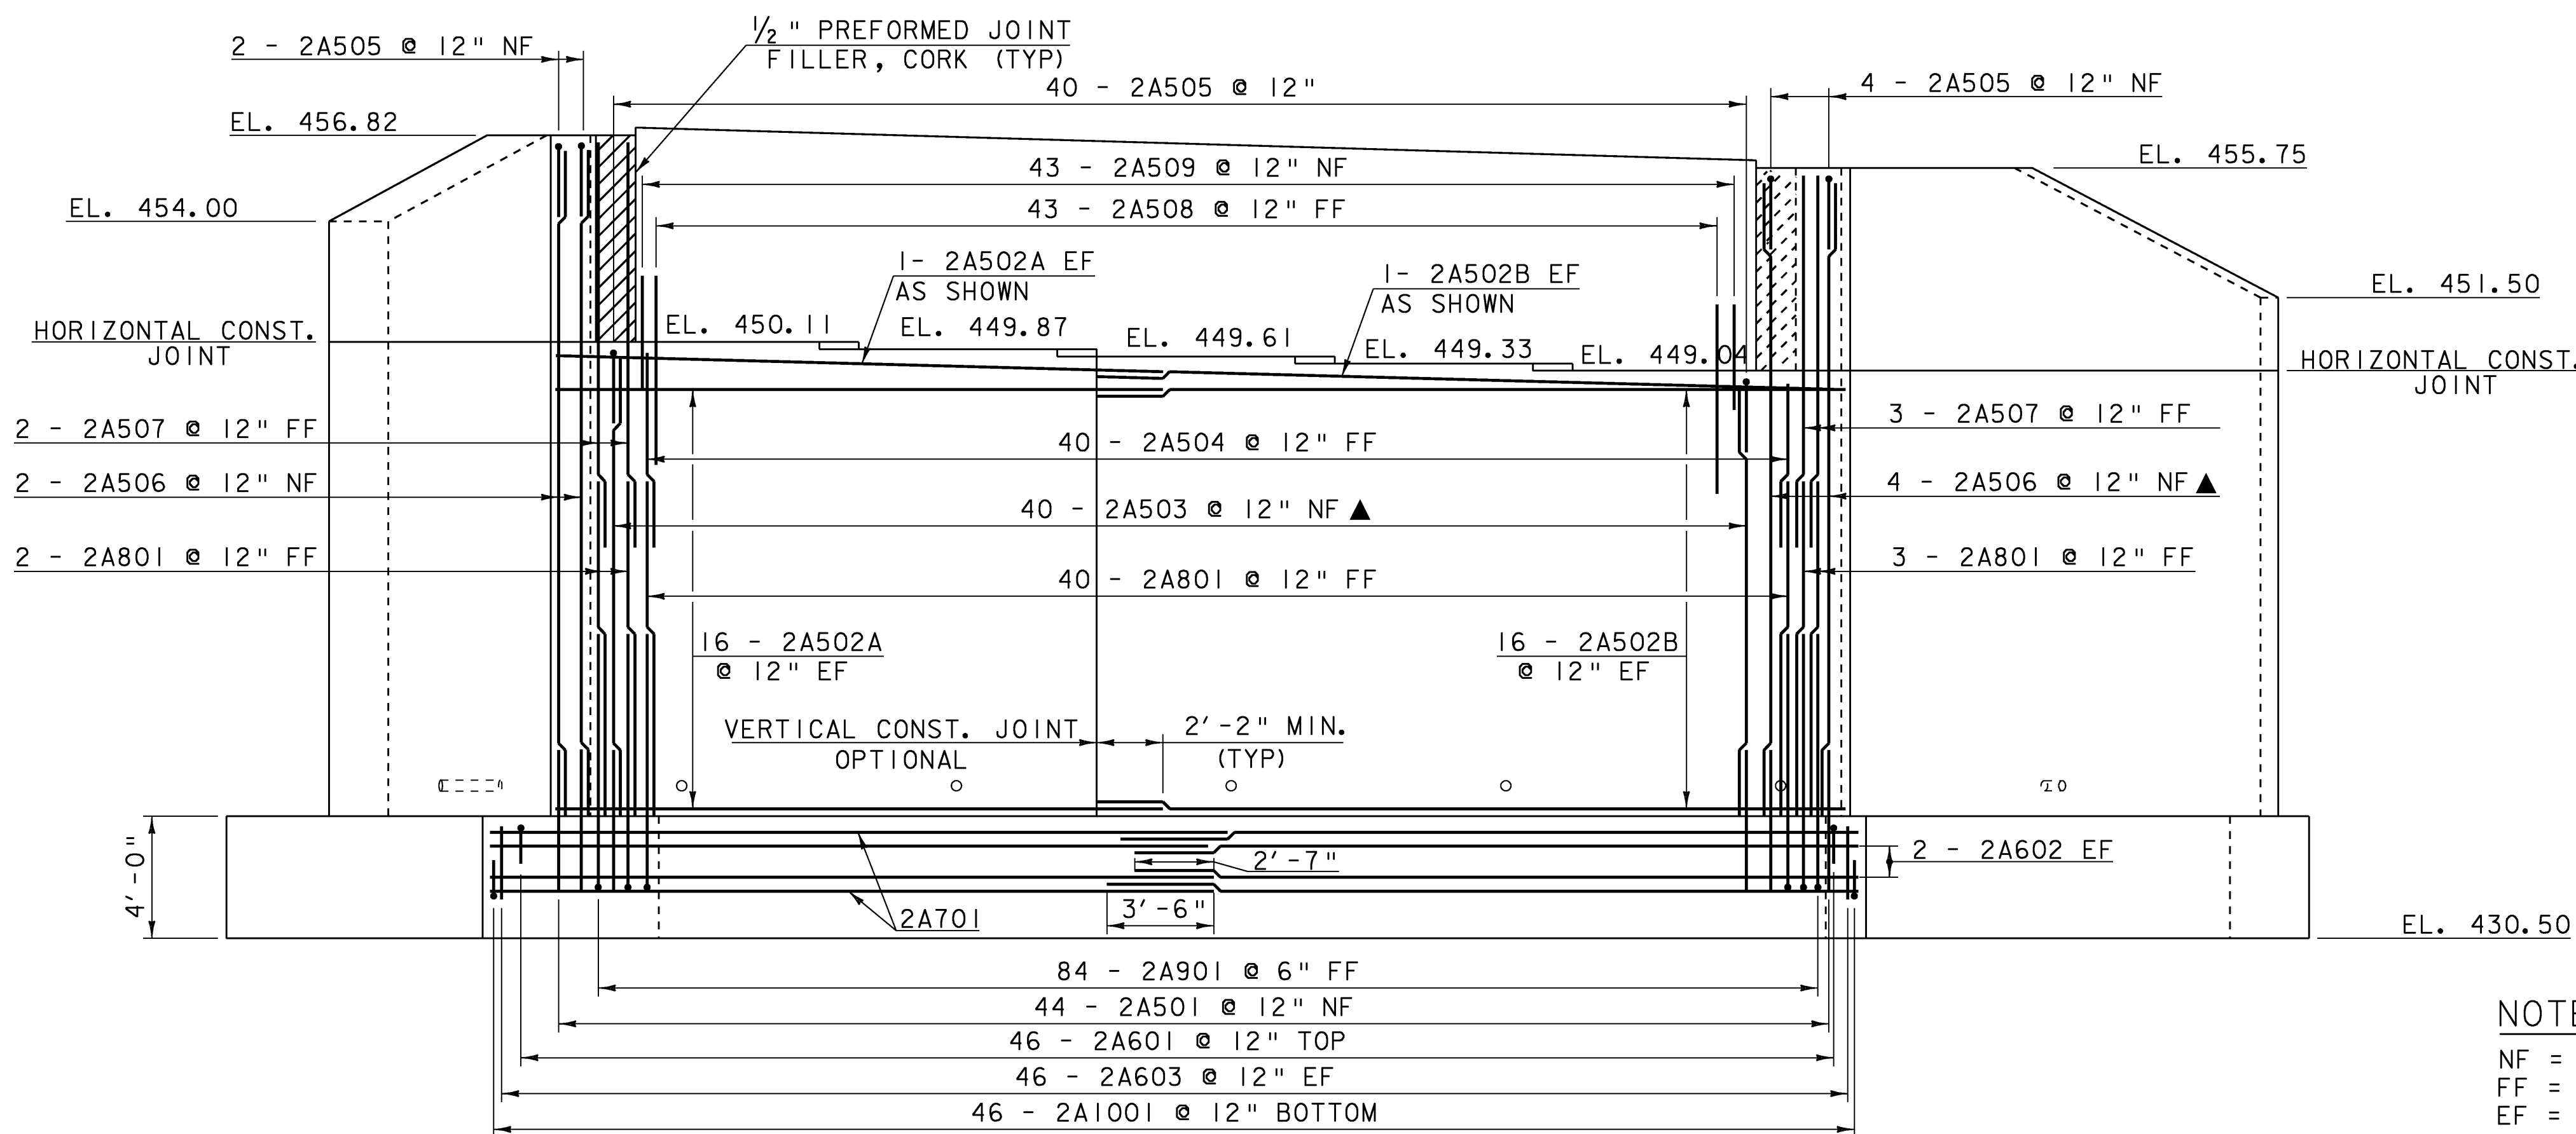

ABUTMENT NO. 2 ELEVATION

SCALE 1/4" = 1'-0"
 1 0 2 4 6

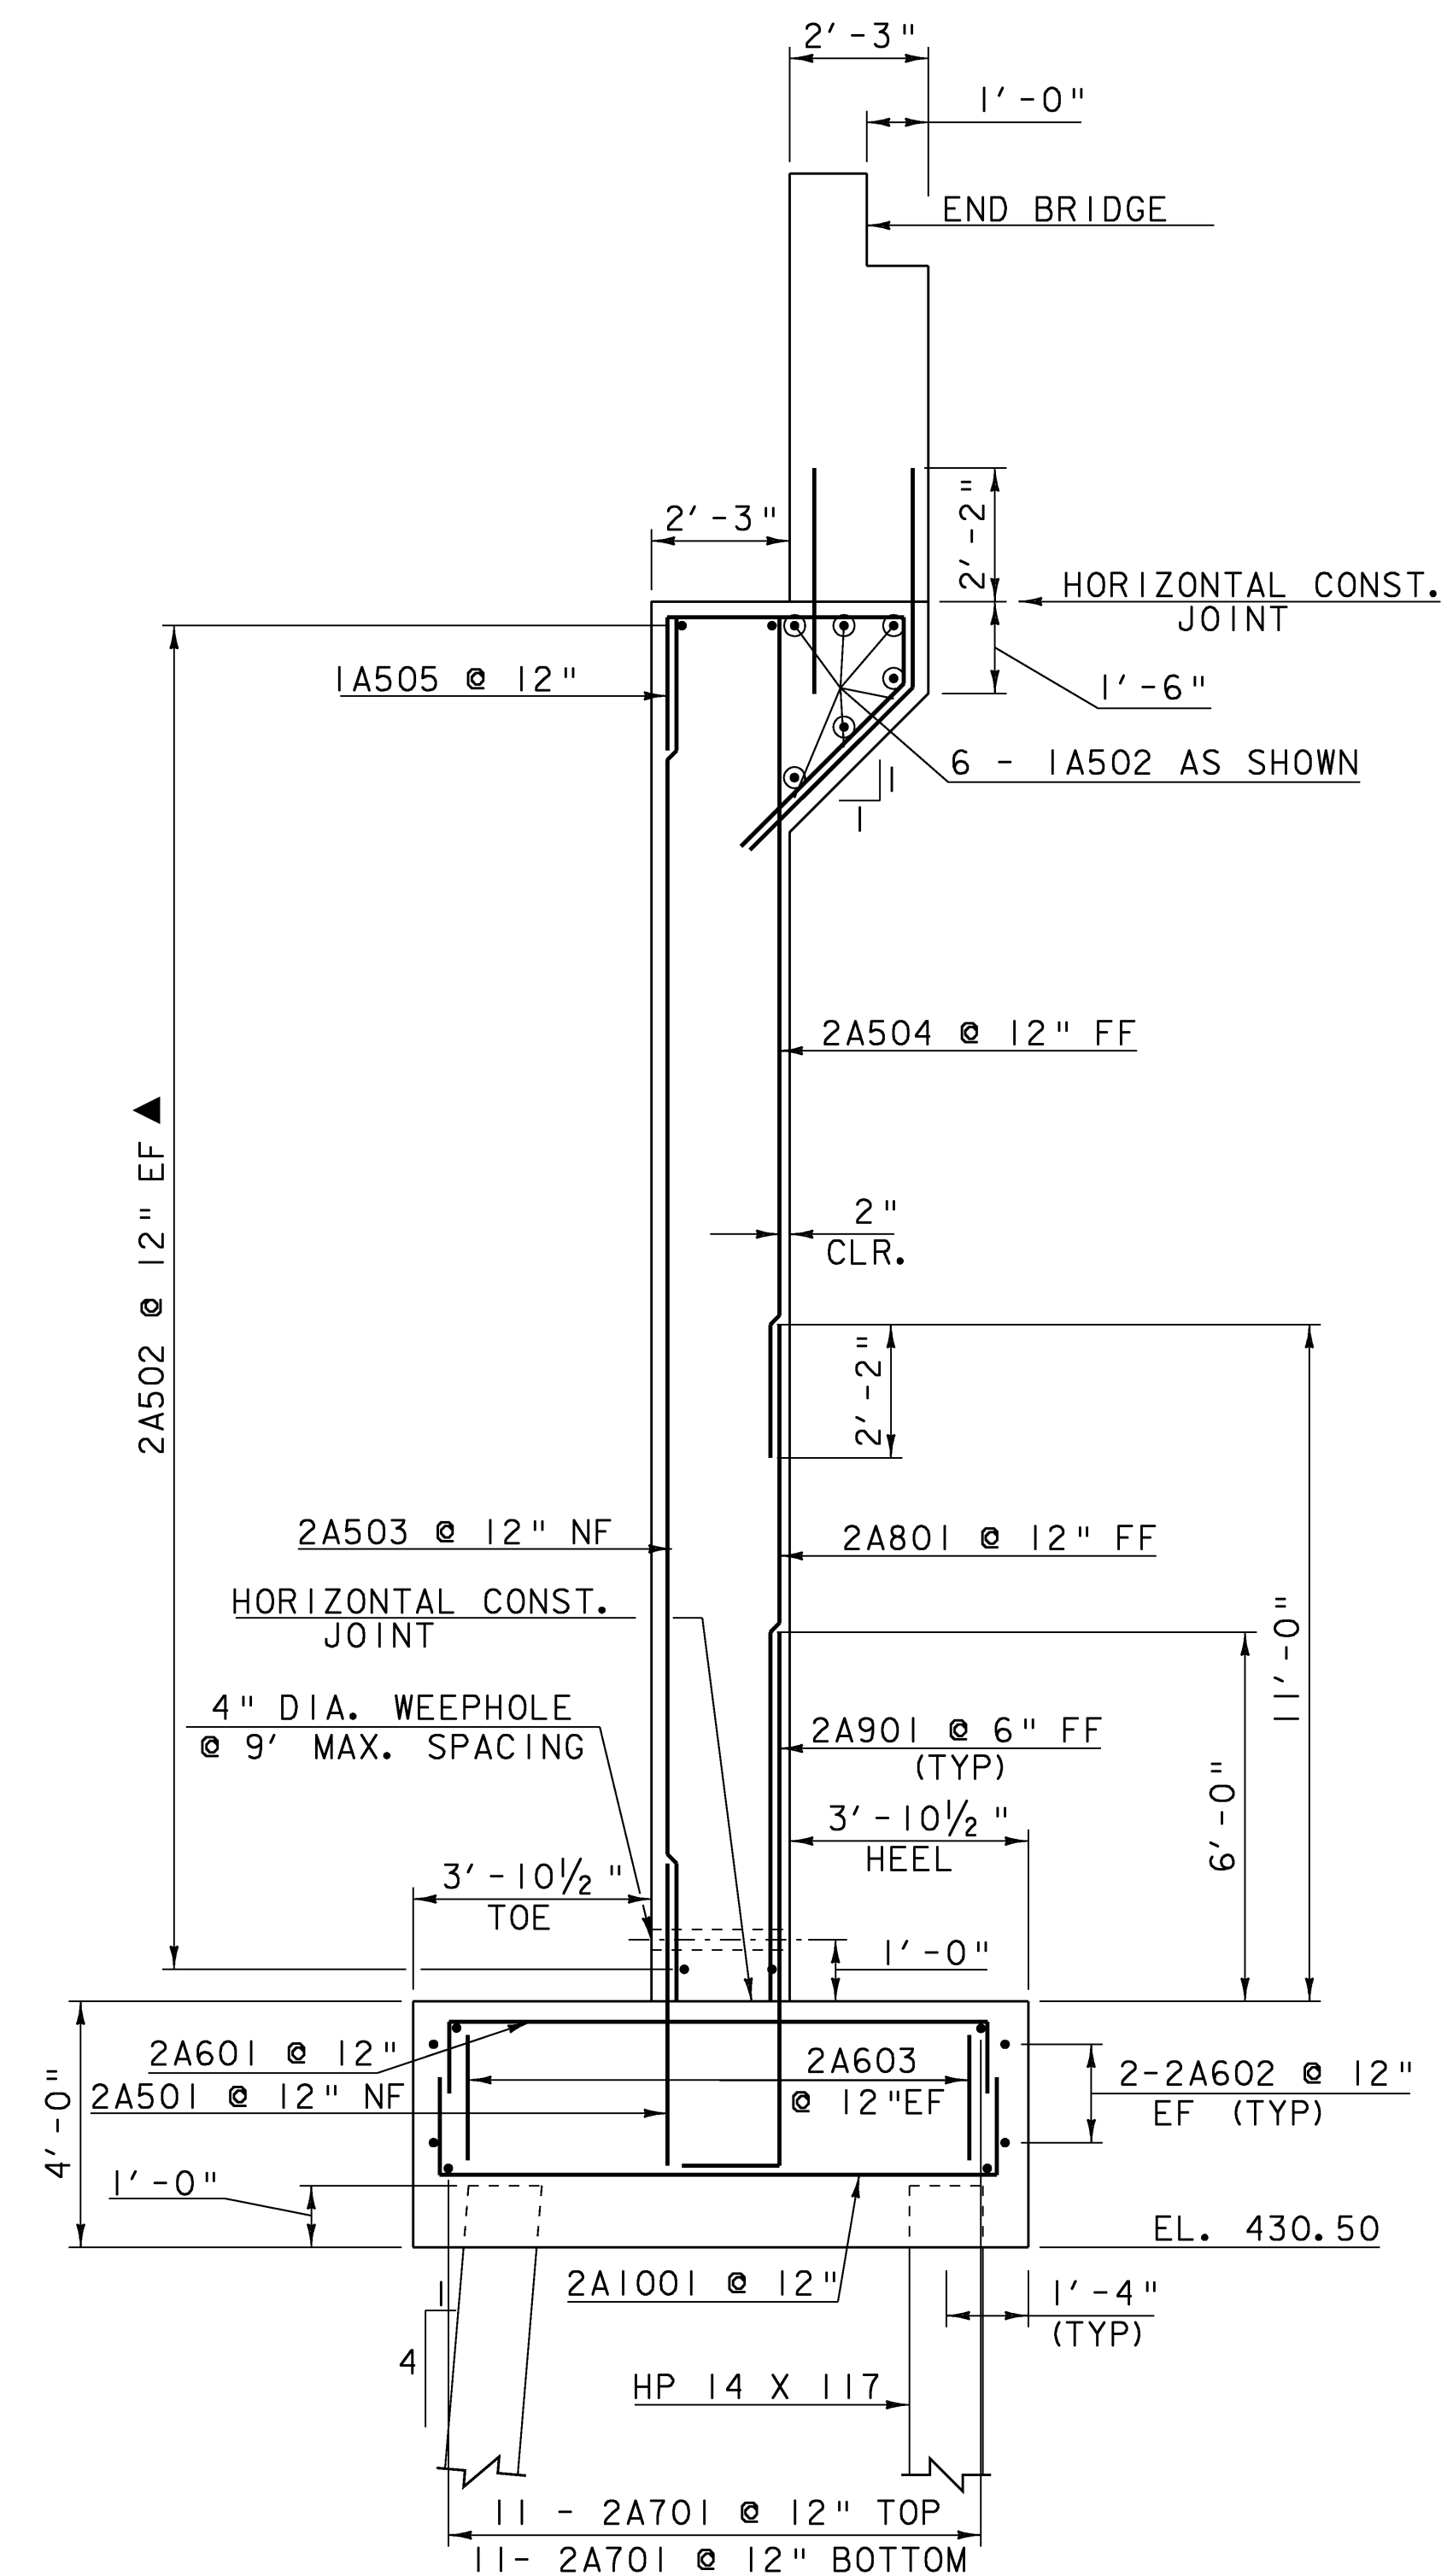

ABUTMENT NO. 2 TYPICAL

SCALE 3/8" = 1'-0"
 1 0 1 2 3 4

NOTE:

- NF = NEAR FACE
- FF = FAR FACE
- EF = EACH FACE
- ▲ = CUT TO FIT IN FIELD
- 3" CLEAR, UNLESS OTHERWISE SPECIFIED ON THE PLANS.
- 2'-2" BAR LAP UNLESS OTHERWISE SPECIFIED ON THE PLANS.

ABUTMENT #2 DETAILS

PROJECT NAME: MORETOWN-MIDDLESEX
 PROJECT NUMBER: BRS 0284(I4)

FILE NAME: 78f219/struc./sf219sub
 PROJECT LEADER: M. EVANS-MONGEON
 DESIGNED BY: S. SCRIBNER

PLOT DATE: 15-JUN-2009
 DRAWN BY: L. DUQUETTE
 CHECKED BY: J. LACROIX
 SHEET 65 OF 103

NOTE: PAYMENT FOR FURNISHING AND INSTALLING PREFORMED JOINT FILLER, CORK WILL BE MADE INCIDENTAL TO THE ADJACENT CONCRETE.