



PIER STEM PLAN

SCALE 1/4" = 1'-0"
 1 0 2 4 6

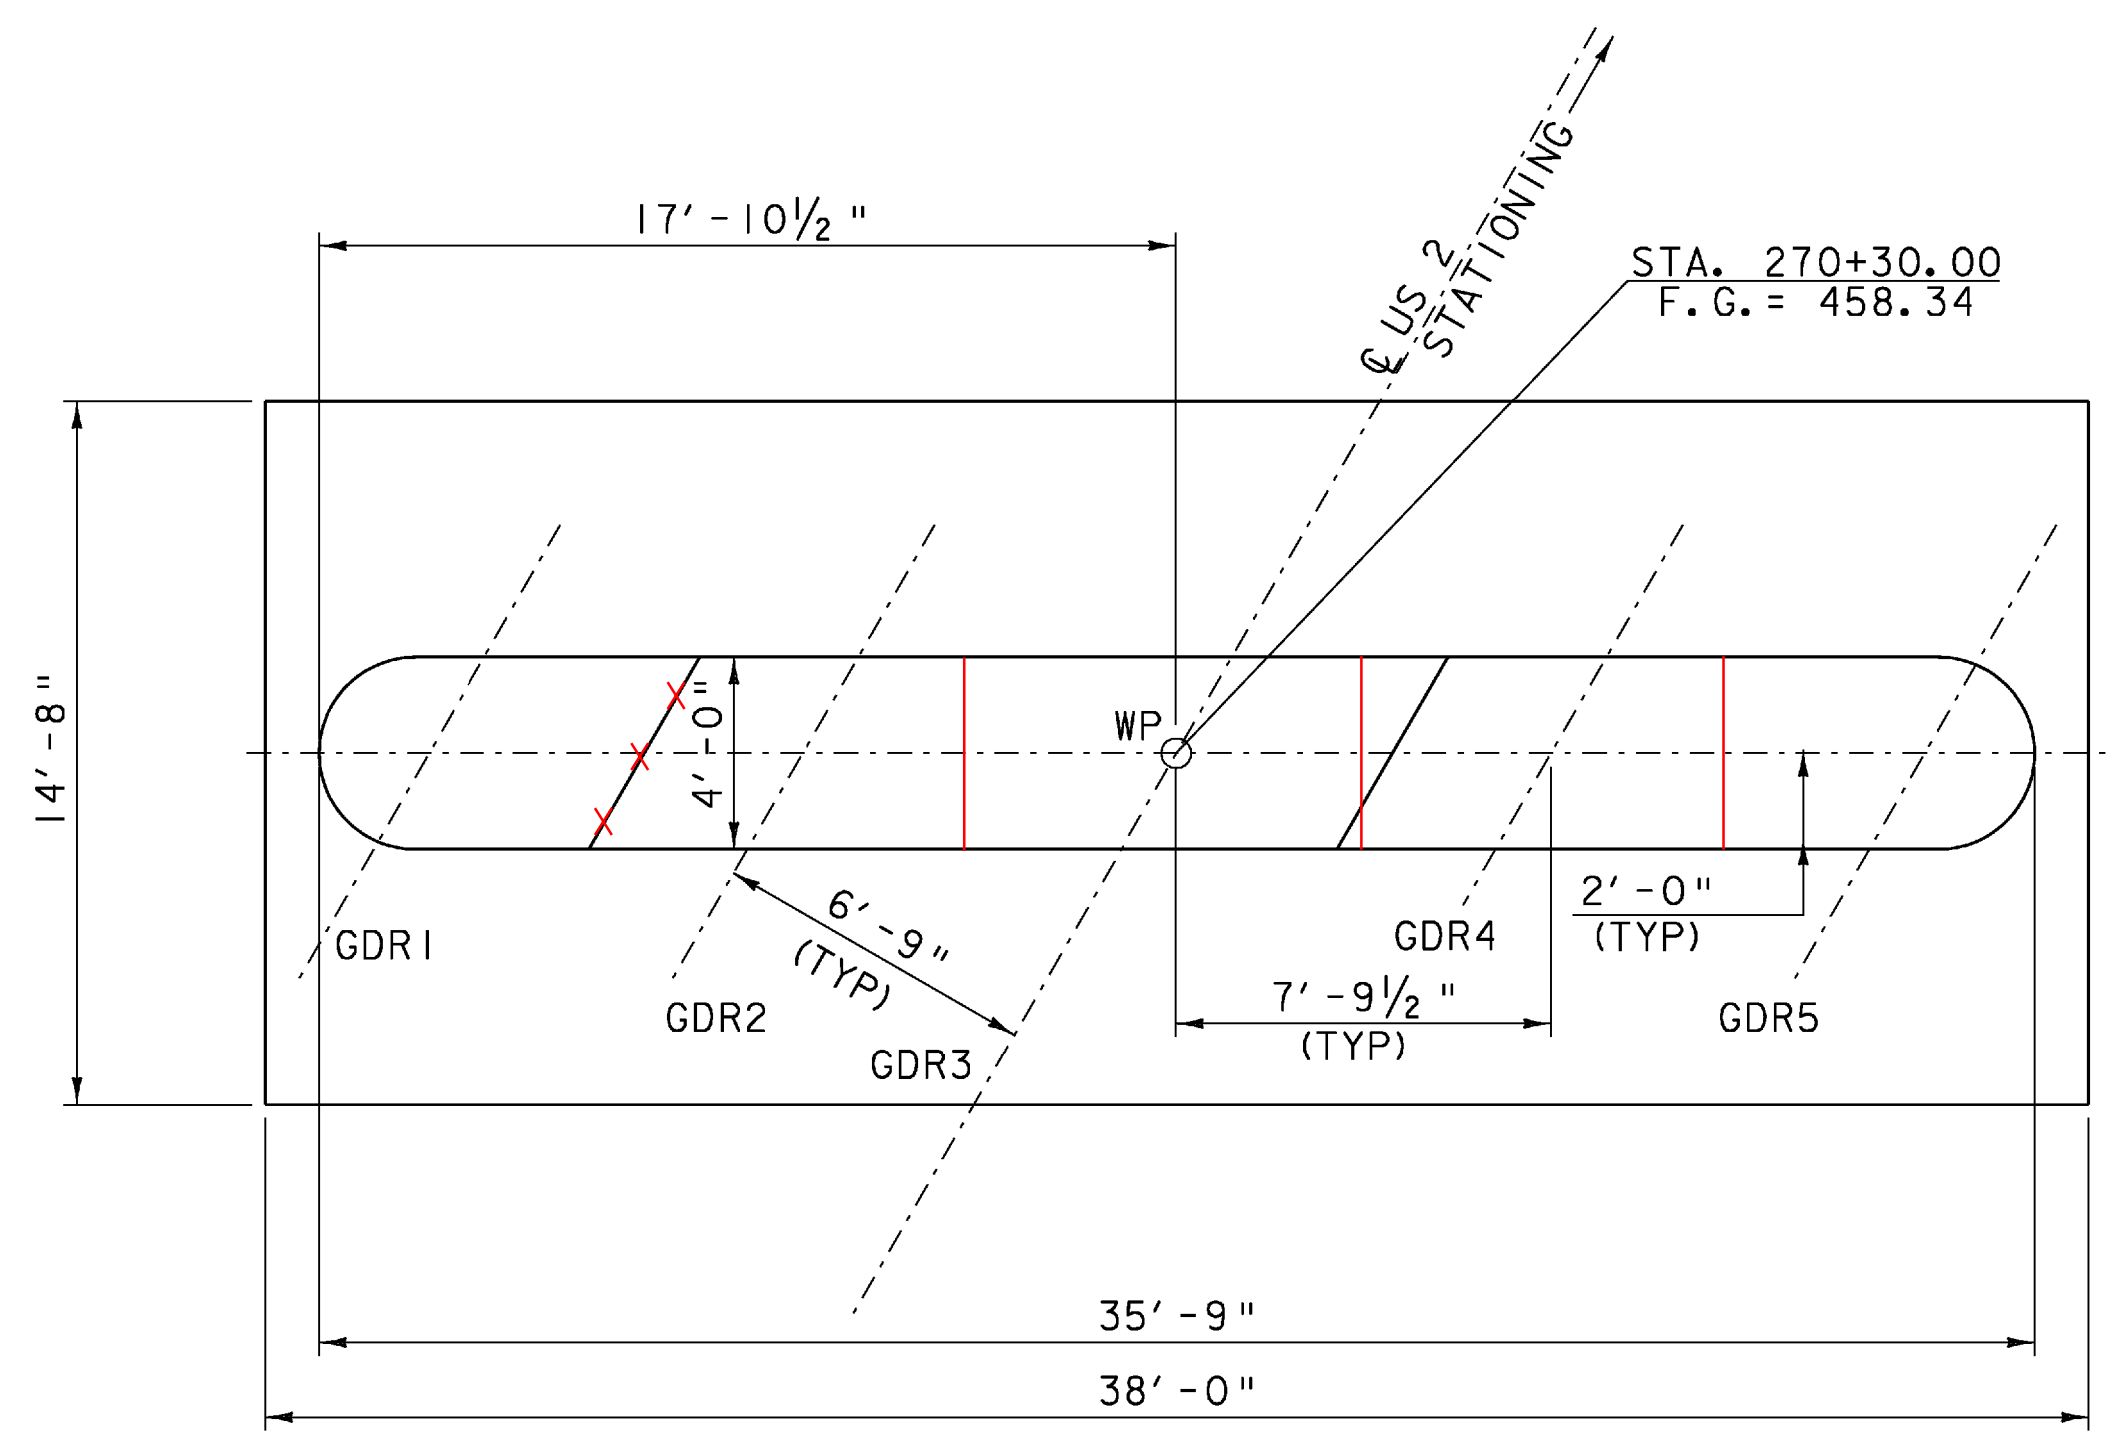


PIER PLAN

SCALE 1/4" = 1'-0"
 1 0 2 4 6

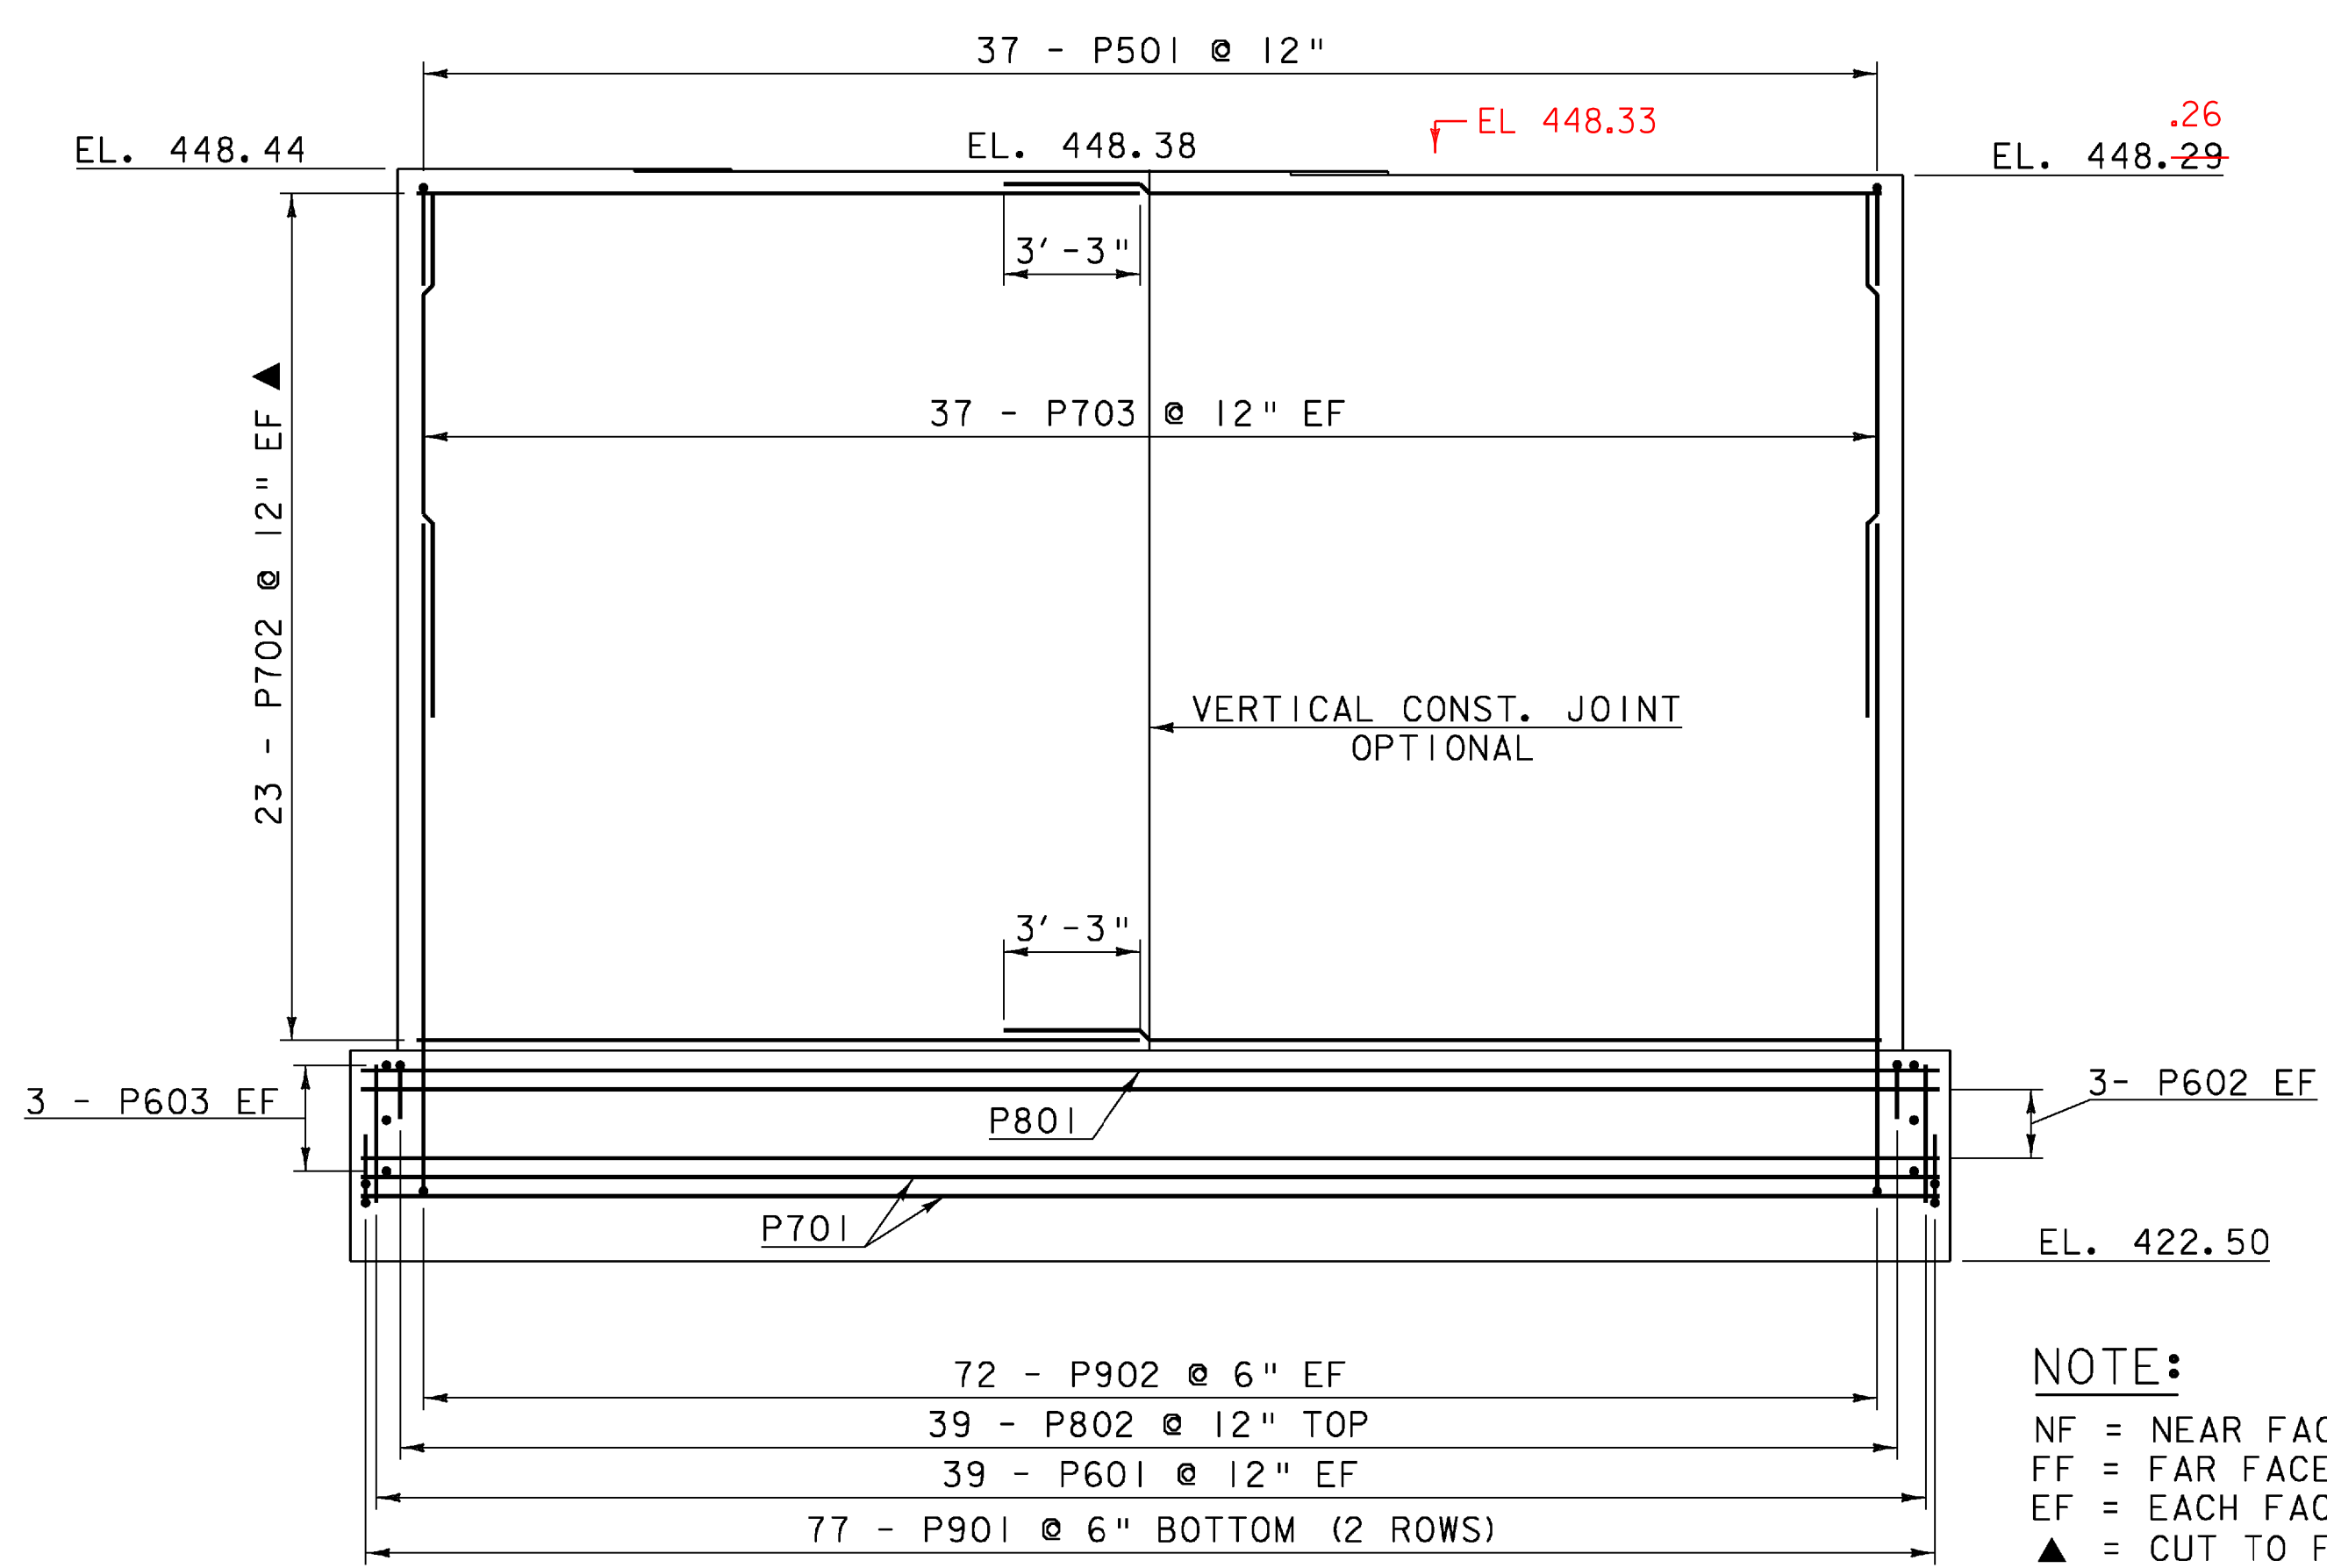

PIER ELEVATION

SCALE 1/4" = 1'-0"
 1 0 2 4 6

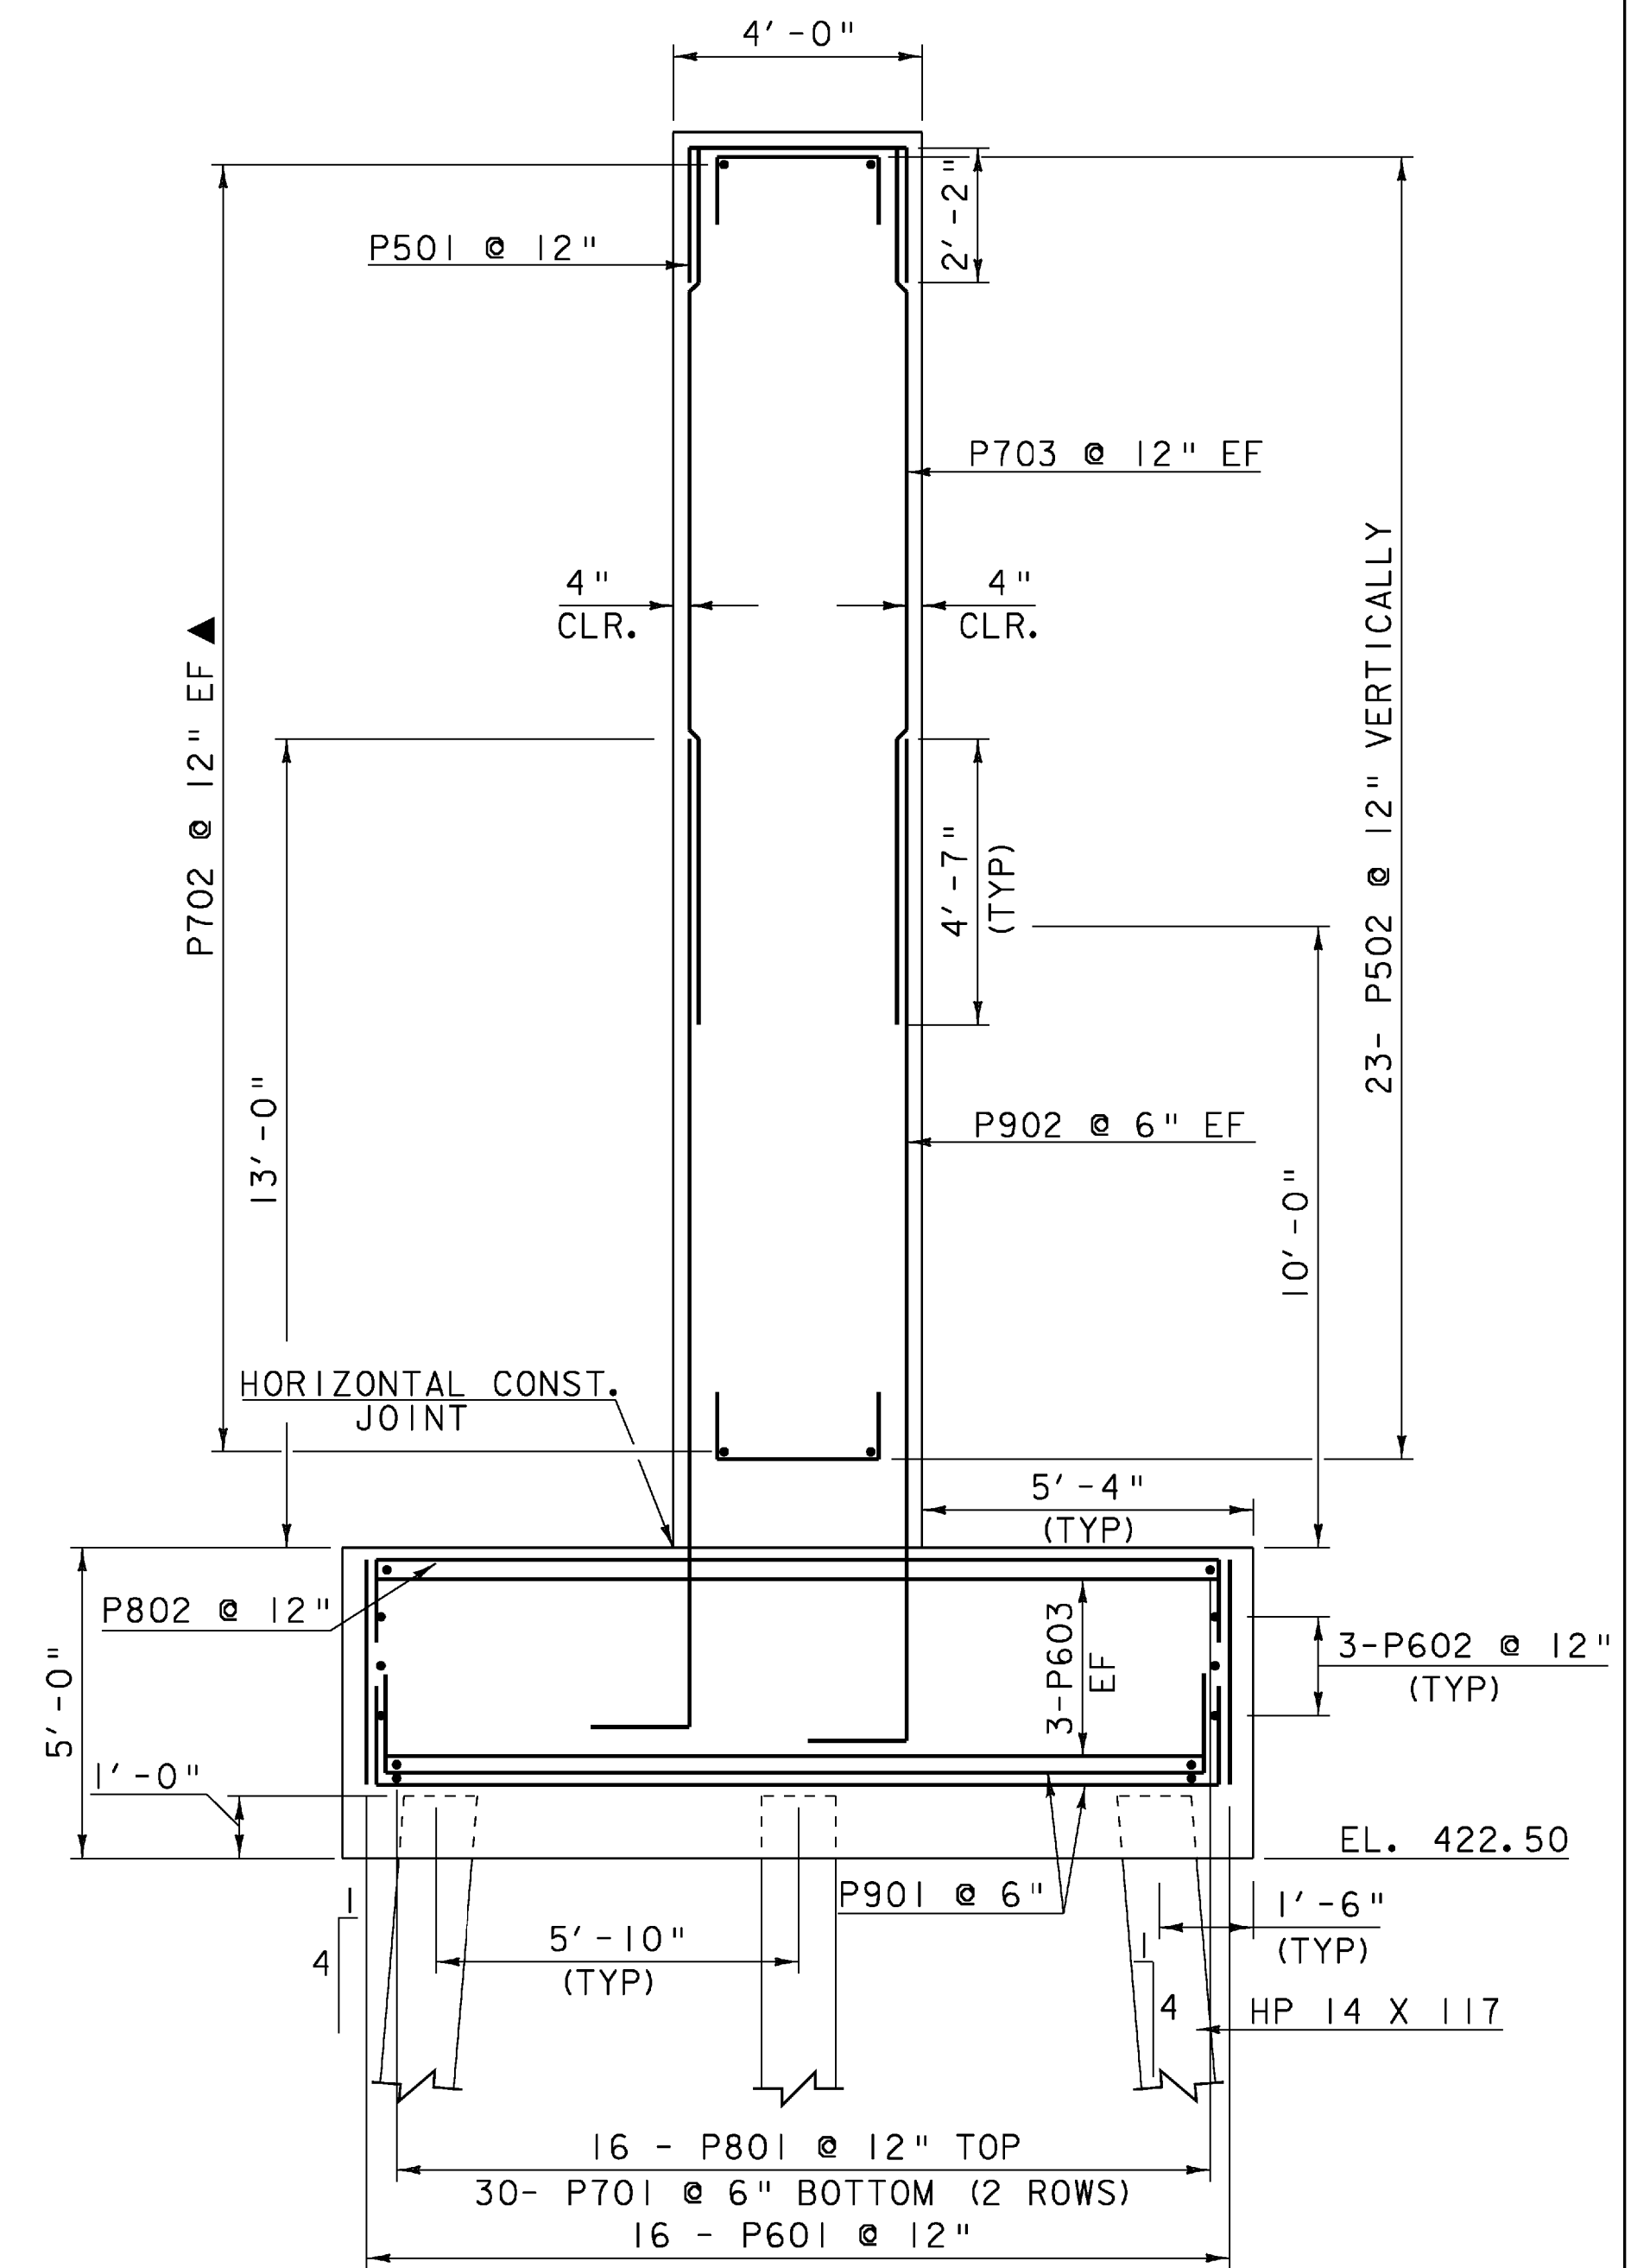

PIER TYPICAL

SCALE 3/8" = 1'-0"
 1 0 1 2 3 4

NOTE:
 NF = NEAR FACE
 FF = FAR FACE
 EF = EACH FACE
 ▲ = CUT TO FIT IN FIELD
 3" CLEAR, UNLESS OTHERWISE SPECIFIED ON THE PLANS.
 2'-2" BAR LAP UNLESS OTHERWISE SPECIFIED ON THE PLANS.

PIER DETAILS

PROJECT NAME:	MORETOWN-MIDDLESEX	PLOT DATE:	15-JUN-2009
PROJECT NUMBER:	BRS 0284(I4)	DRAWN BY:	L. DUQUETTE
FILE NAME:	78f219/struc./sf219sub	CHECKED BY:	J. LACROIX
PROJECT LEADER:	M. EVANS-MONGEON	SHEET	69 OF 103
DESIGNED BY:	S. SCRIBNER		