



ABUTMENT NO. 1 FOOTING REINFORCING PLAN

SCALE 1/4" = 1'-0"  
1 0 2 4 6

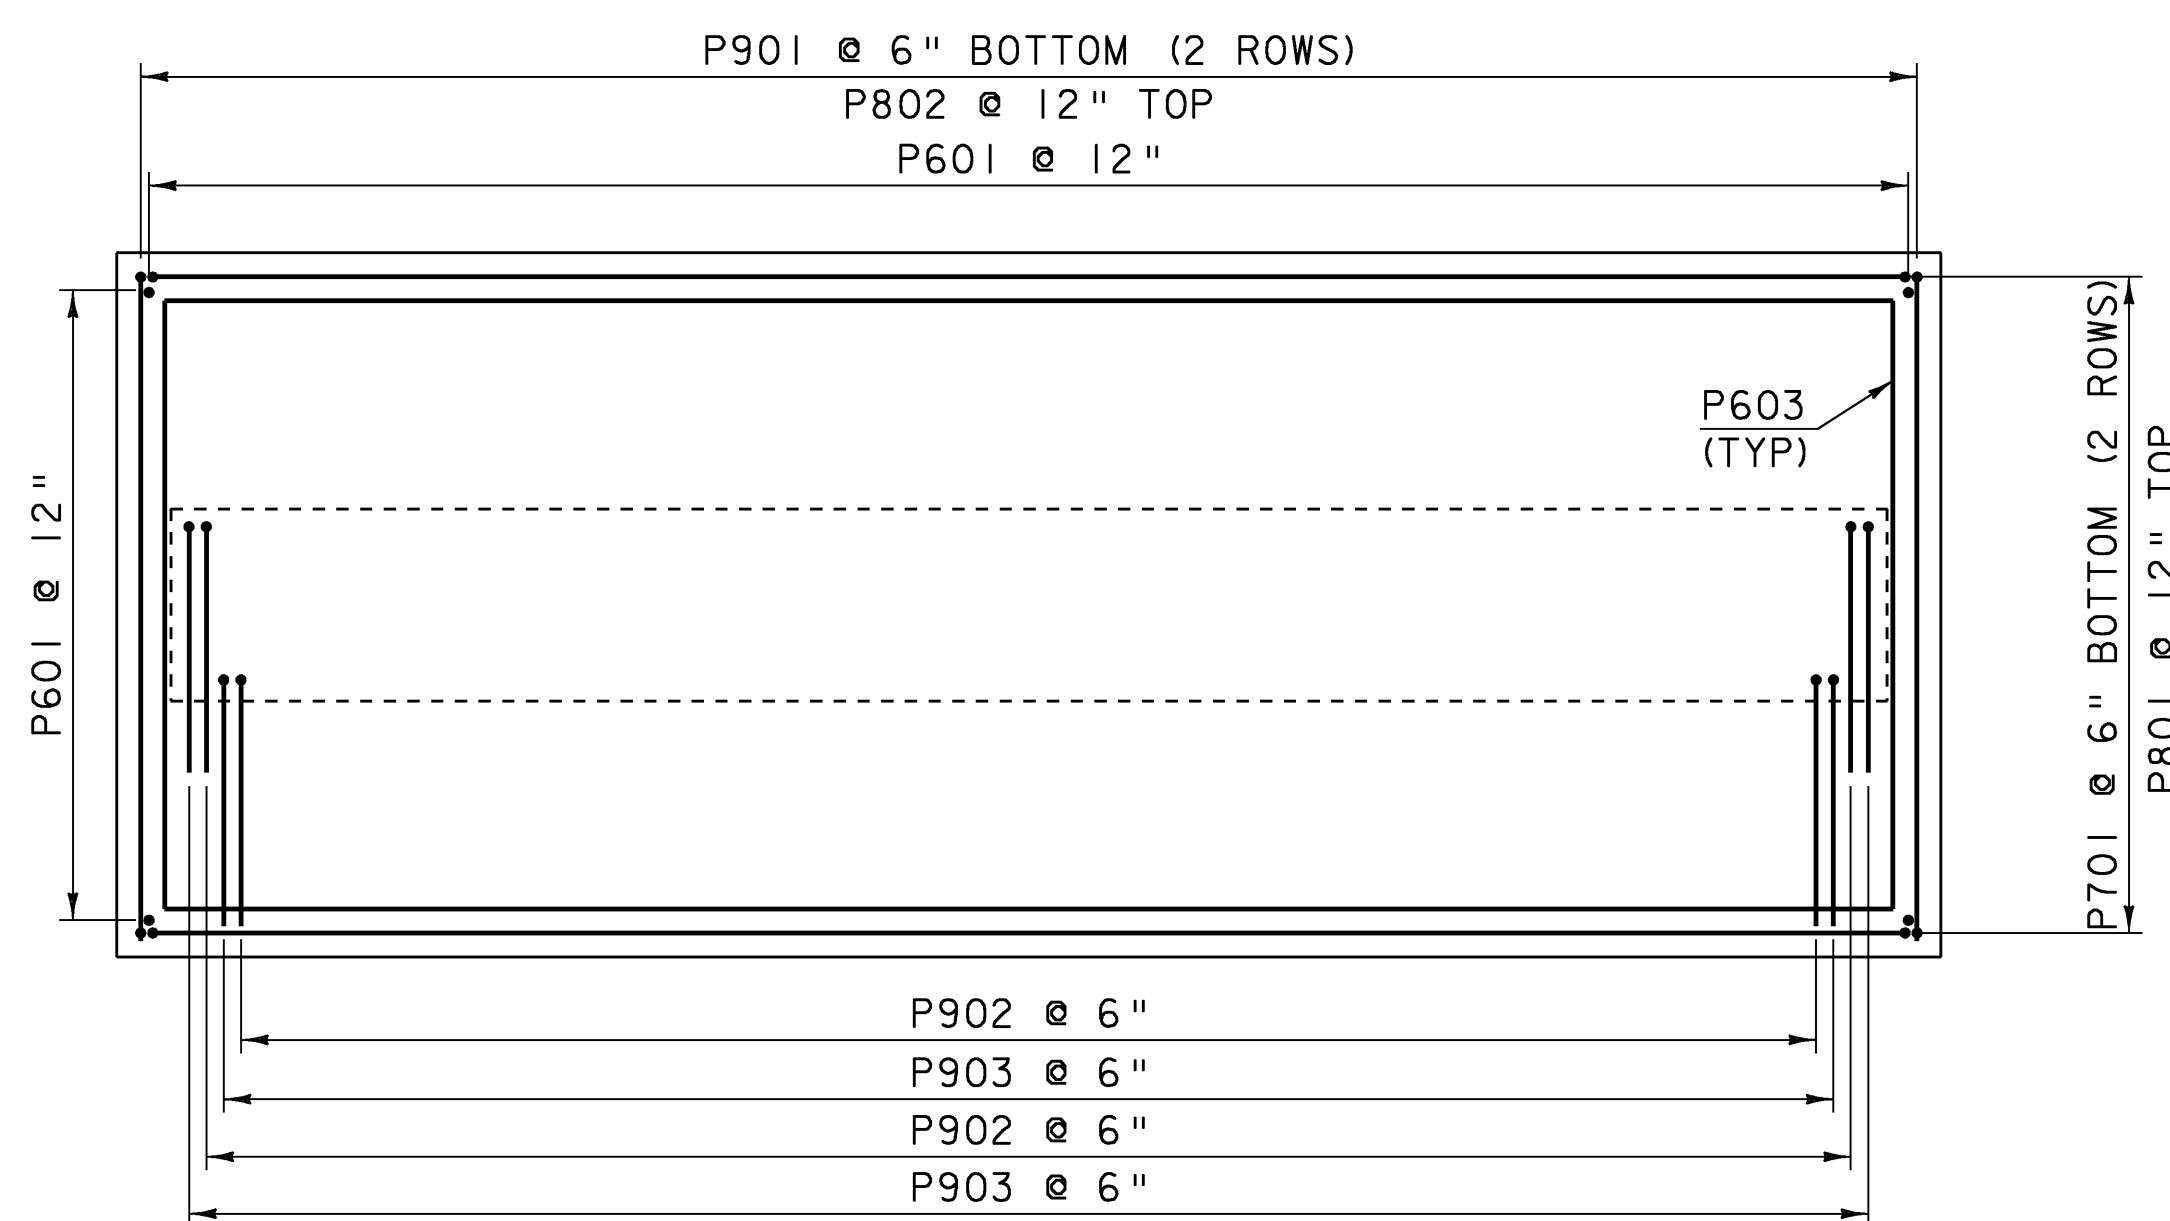

PIER FOOTING REINFORCING PLAN

SCALE 1/4" = 1'-0"  
1 0 2 4 6

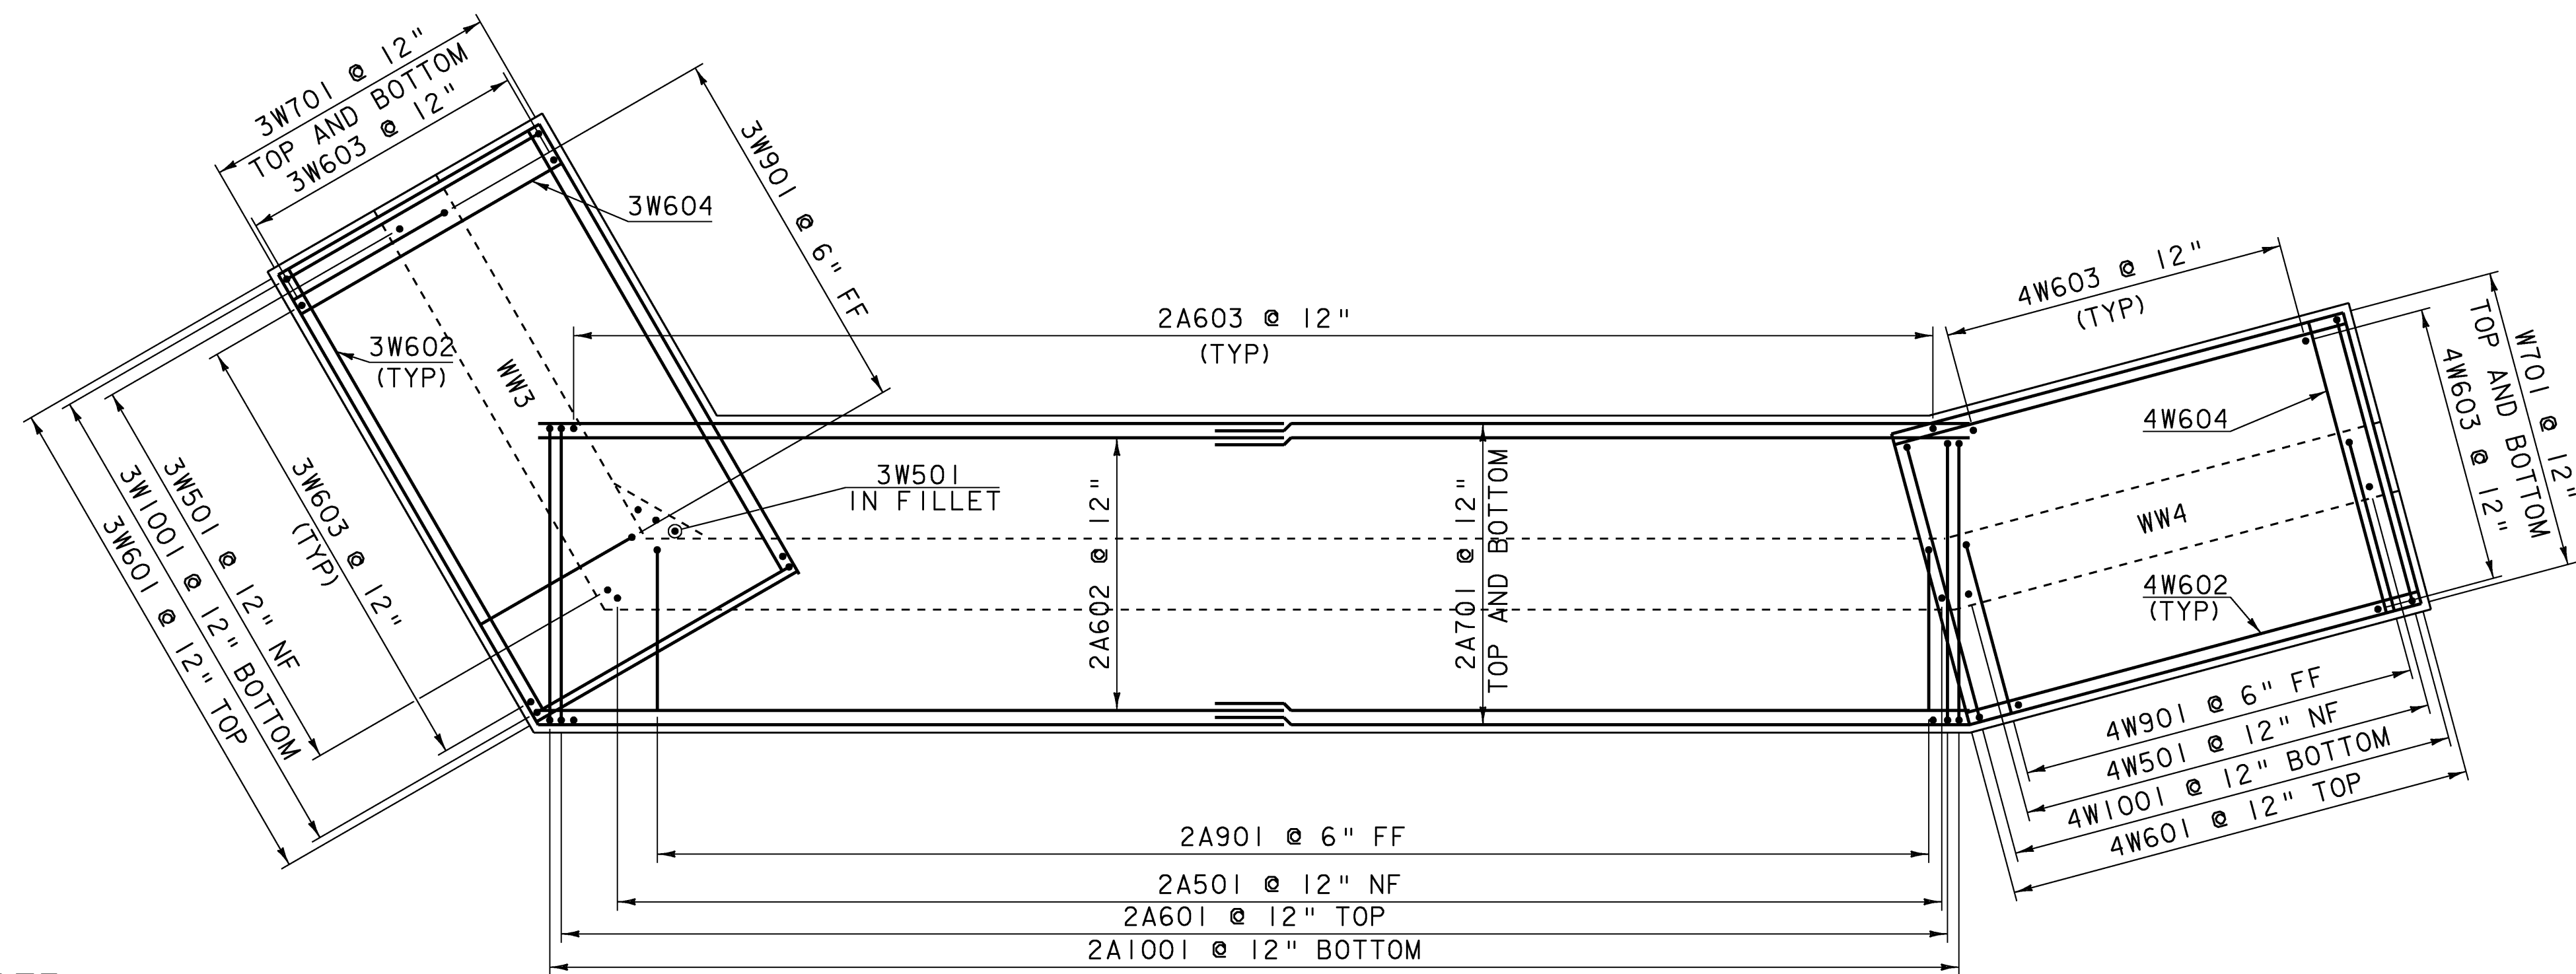

ABUTMENT NO. 2 FOOTING REINFORCING PLAN

SCALE 1/4" = 1'-0"  
1 0 2 4 6

**NOTE:**

- NF = NEAR FACE
- FF = FAR FACE
- EF = EACH FACE
- ▲ = CUT TO FIT IN FIELD
- 3" CLEAR, UNLESS OTHERWISE SPECIFIED ON THE PLANS.
- 2'-2" BAR LAP UNLESS OTHERWISE SPECIFIED ON THE PLANS.

**FOOTING REINFORCING PLAN**

PROJECT NAME: MORETOWN-MIDDLESEX  
PROJECT NUMBER: BRS 0284(14)

FILE NAME: 78f219/struc./sf219sub  
PROJECT LEADER: M. EVANS-MONGEON  
DESIGNED BY: S. SCRIBNER

PLOT DATE: 15-JUN-2009  
DRAWN BY: L. DUQUETTE  
CHECKED BY: J. LACROIX  
SHEET 70 OF 103