


CHAIN LINK FENCE TURNING POINTS		
POINT	STA.	OFF SET
F6	273+11.00	56.00 FT (LT)
F7	273+19.00	31.00 FT (LT)
F8	273+65.95	38.10 FT (LT)
F9	273+83.99	42.29 FT (LT)
F10	274+50.00	64.48 FT (LT)

ML CURVE DATA  
 $\Delta = 40^\circ 28' 28''$   
 $D = 12^\circ 00' 00''$   
 $R = 477.4648'$   
 $T = 176.03'$   
 $L = 337.29'$   
 $E = 31.41'$   
 $BANK = 0.040$

COLD PLANING, BITUMINOUS PAVEMENT  
 277+75.00 ~ 278+50.00  
 REMOVAL OF EXISTING FENCE  
 273+00.00 ~ 274+76.26 LT  
 CHAIN-LINK FENCE (6')  
 273+00.00 ~ 273+65.95 LT  
 273+83.99 ~ 274+76.08 LT  
 GATE FOR CHAIN-LINK FENCE, 6 FEET  
 273+65.95 ~ 273+83.99 LT  
 CONSTRUCT DRIVE (PAVED)  
 273+75.00 LT (WIDTH 20')

REMOVAL AND DISPOSAL OF GUARDRAIL  
 272+38.00 44.0' ~ 273+37.00 14.6' RT  
 272+44.00 64.7' ~ 274+50.00 26.1' RT  
 DELINEATOR WITH STEEL POST  
 VT ROUTE 2  
 273+87.00 56' RT (WHITE)  
 274+54.00 5' LT (WHITE)

- (7) FILL EXISTING 18" ACCGMP WITH SPECIAL PROVISION (CONTROLLED DENSITY (FLOWABLE) FILL)
- (8) STA. 274+55.15 REMOVE EXISTING DROP INLET OFFSET 52'-2" LT -TRENCH EXCAVATION OF ROCK
- (9) NEW PRECAST REINFORCED CONCRETE PIPE DI WITH CAST IRON GRATE 274+55.15 OFFSET 52'-2" LT
- (10) NEW 18" CPEP/CAAP/PCCSP PIPE 273+83.55 OFFSET 60.60' RT TO 274+54.65 OFFSET 51.09' LT LENGTH = 126'-3"
- (11) NEW 18" CPEPES/CAAPES/CPSPES 273+83.55 OFFSET 60.60' RT

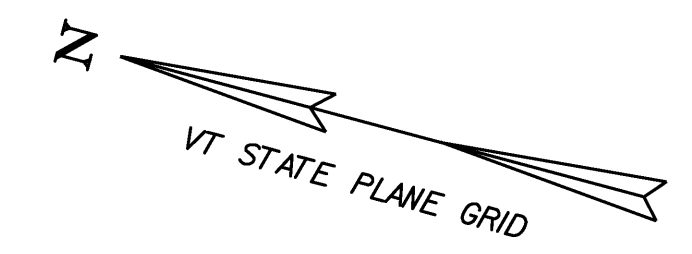

STATE OF VERMONT

STATE OF VERMONT

TO ROW SHEET 19 OF 20 SHEETS  
 MAIN TO CHAIN LINE STA. 273+00

WHITE SPRUCE  
 IN A 15 FT X 10 FT  
 BED SEE LANDSCAPE  
 TREE PLANTING  
 DETAIL

PI STA. 273+56.05 BK.=  
 STA. 273+41.28 AH.

REMOVE EXISTING CHAIN LINK FENCE

6' CHAIN LINK FENCE  
 SEE STANDARD F-4

STA. 274+75  
 END PROJECT

STA. 276+00  
 END APPROACH

US RT. 2  
 TO WATERBURY

US RT. 2 TO  
 MONTPELIER

3B


3A

TEBEAU, MARY KAY  
 FKA COLLINS, MARY KAY

" Area Subject To Current Storm Water Permit #4278-9015, Or Any  
 Subsequent Permit Issued For This Area"

END ROW PROJECT  
 BRS 0284(14)  
 276+12.00 25.54' RT.

DELINEATOR WITH STEEL POST  
 VT ROUTE 2  
 267+20.50 18' RT (BLUE)  
 268+01.40 18' RT (GREEN)  
 +58.50 18' RT (GREEN)  
 00 18' LT (BLUE)  
 RT (WHITE)  
 (WHITE)  
 (BLUE)

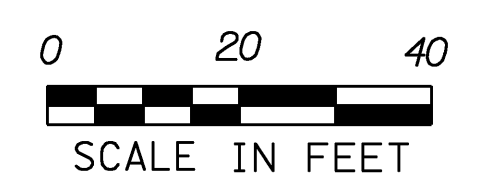

LAYOUT SHEET 3

FOR R.O.W.  
 USE ONLY

PROJECT NAME:	MORETOWN-MIDDLESEX
PROJECT NUMBER:	BRS 0284(14)
FILE NAME:	78f219\structures\78f219bdr.dgn
PROJECT LEADER:	M. Evans-Mongeon
DESIGNED BY:	S. SCRIBNER
R.O.W. SHEET 20 OF 20 SHEETS	
PLOT DATE:	15-JUN-2009
DRAWN BY:	L. DUQUETTE
CHECKED BY:	S. SCRIBNER
SHEET 79 OF 103	