
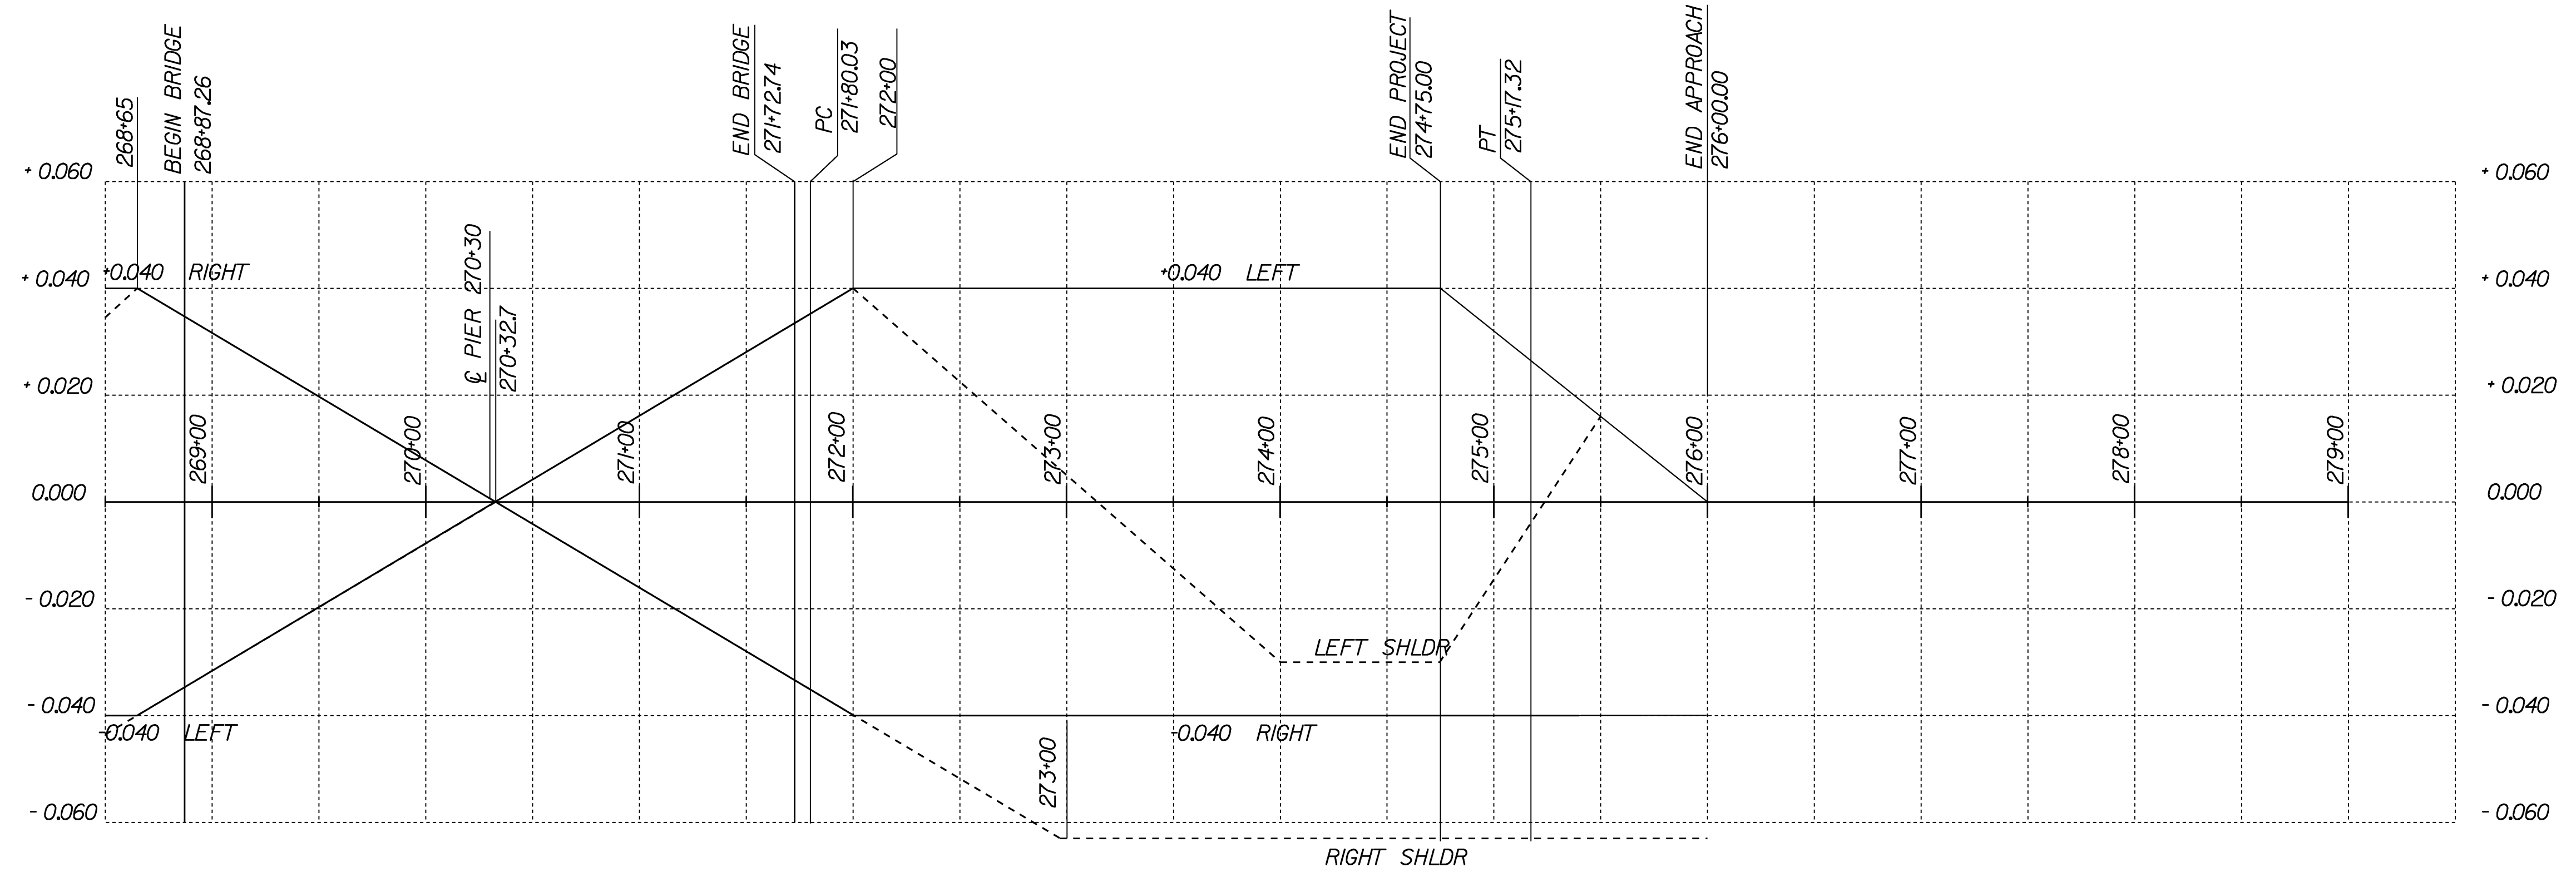


BANKING DIAGRAM

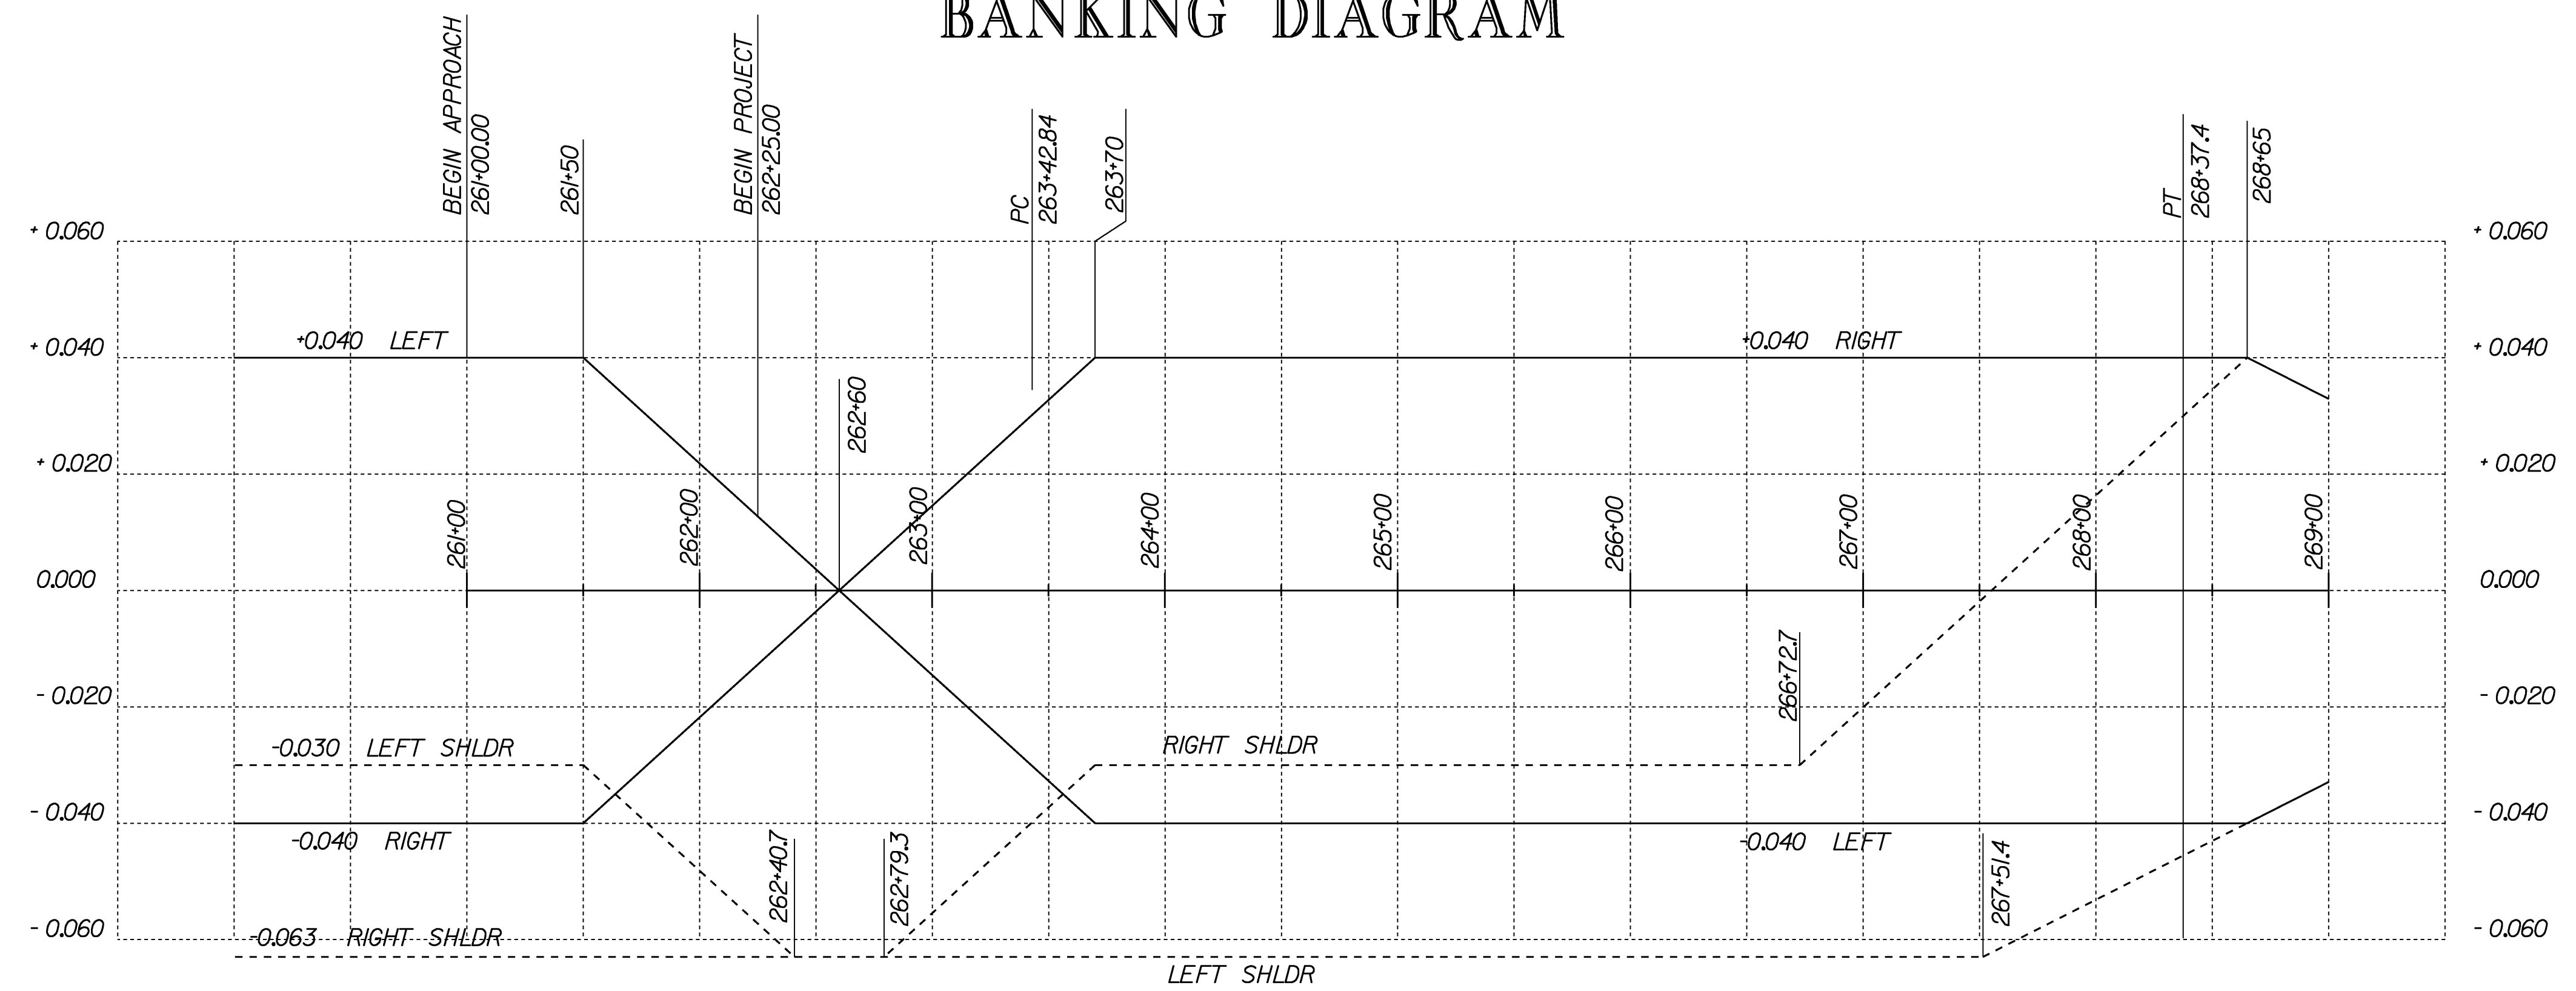

BANKING DIAGRAM

| | |
|-----------------|--------------------------|
| PROJECT NAME: | MORETOWN-MIDDLESEX |
| PROJECT NUMBER: | BRS 0284(14) |
| FILE NAME: | /78f219/str/sf219frm.dgn |
| PROJECT LEADER: | M. Evans-Mongeon |
| DESIGNED BY: | L. Russell |
| IPARM: | s78f219bank.l |
| PLOT DATE: | 15-JUN-2009 |
| DRAWN BY: | L. Russell |
| CHECKED BY: | W. Farley |
| SHEET | 80 OF 103 |