




MATERIAL TRANSITION DETAIL

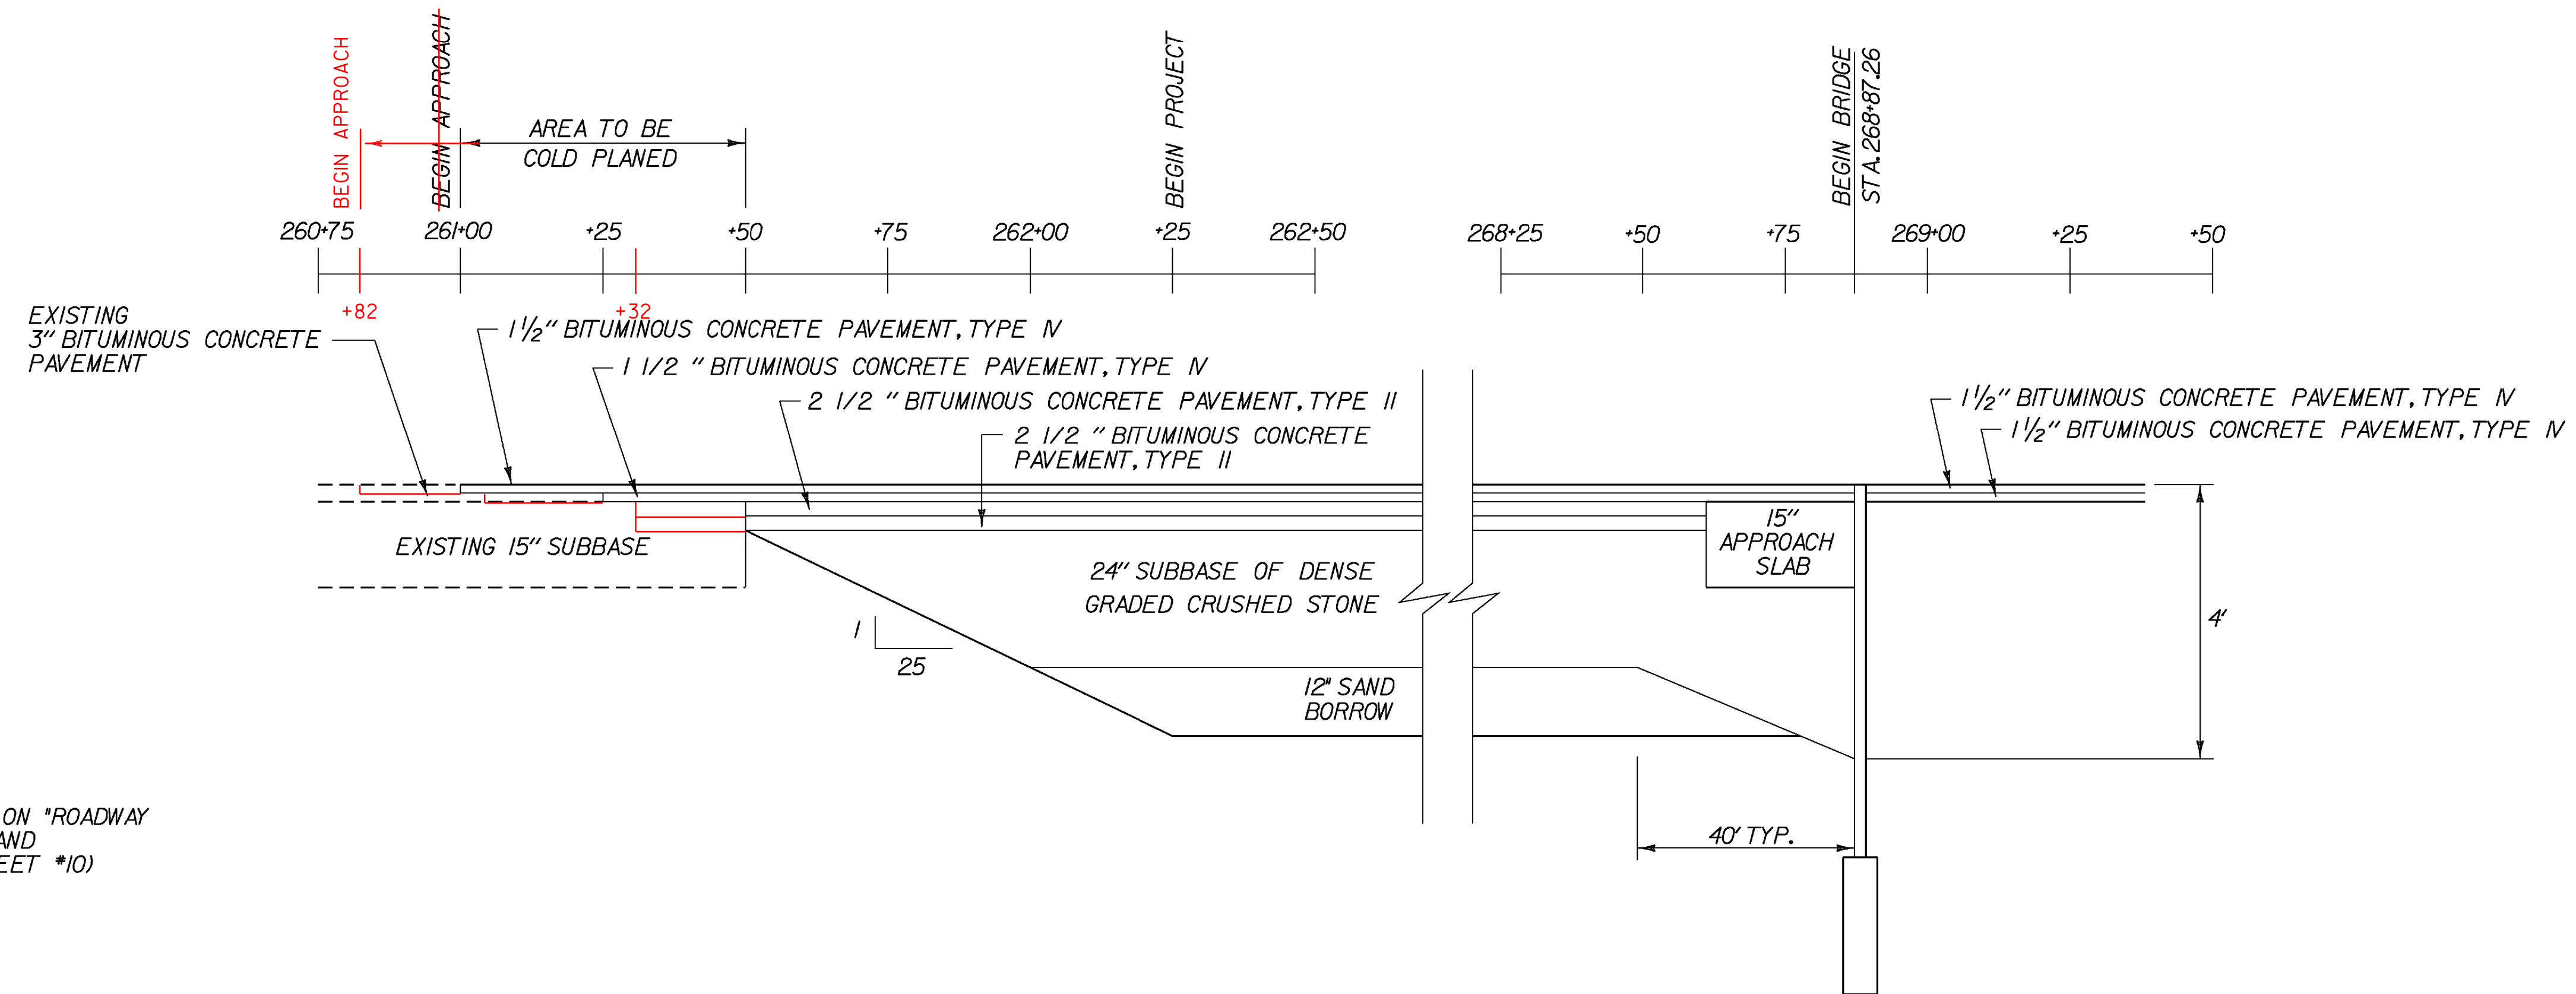


NOTE: 1. SHOULDER TRANSITIONS ARE ON "ROADWAY CROSS SECTION SHEET *I*" AND "ROADWAY CROSS SECTION SHEET *10)"

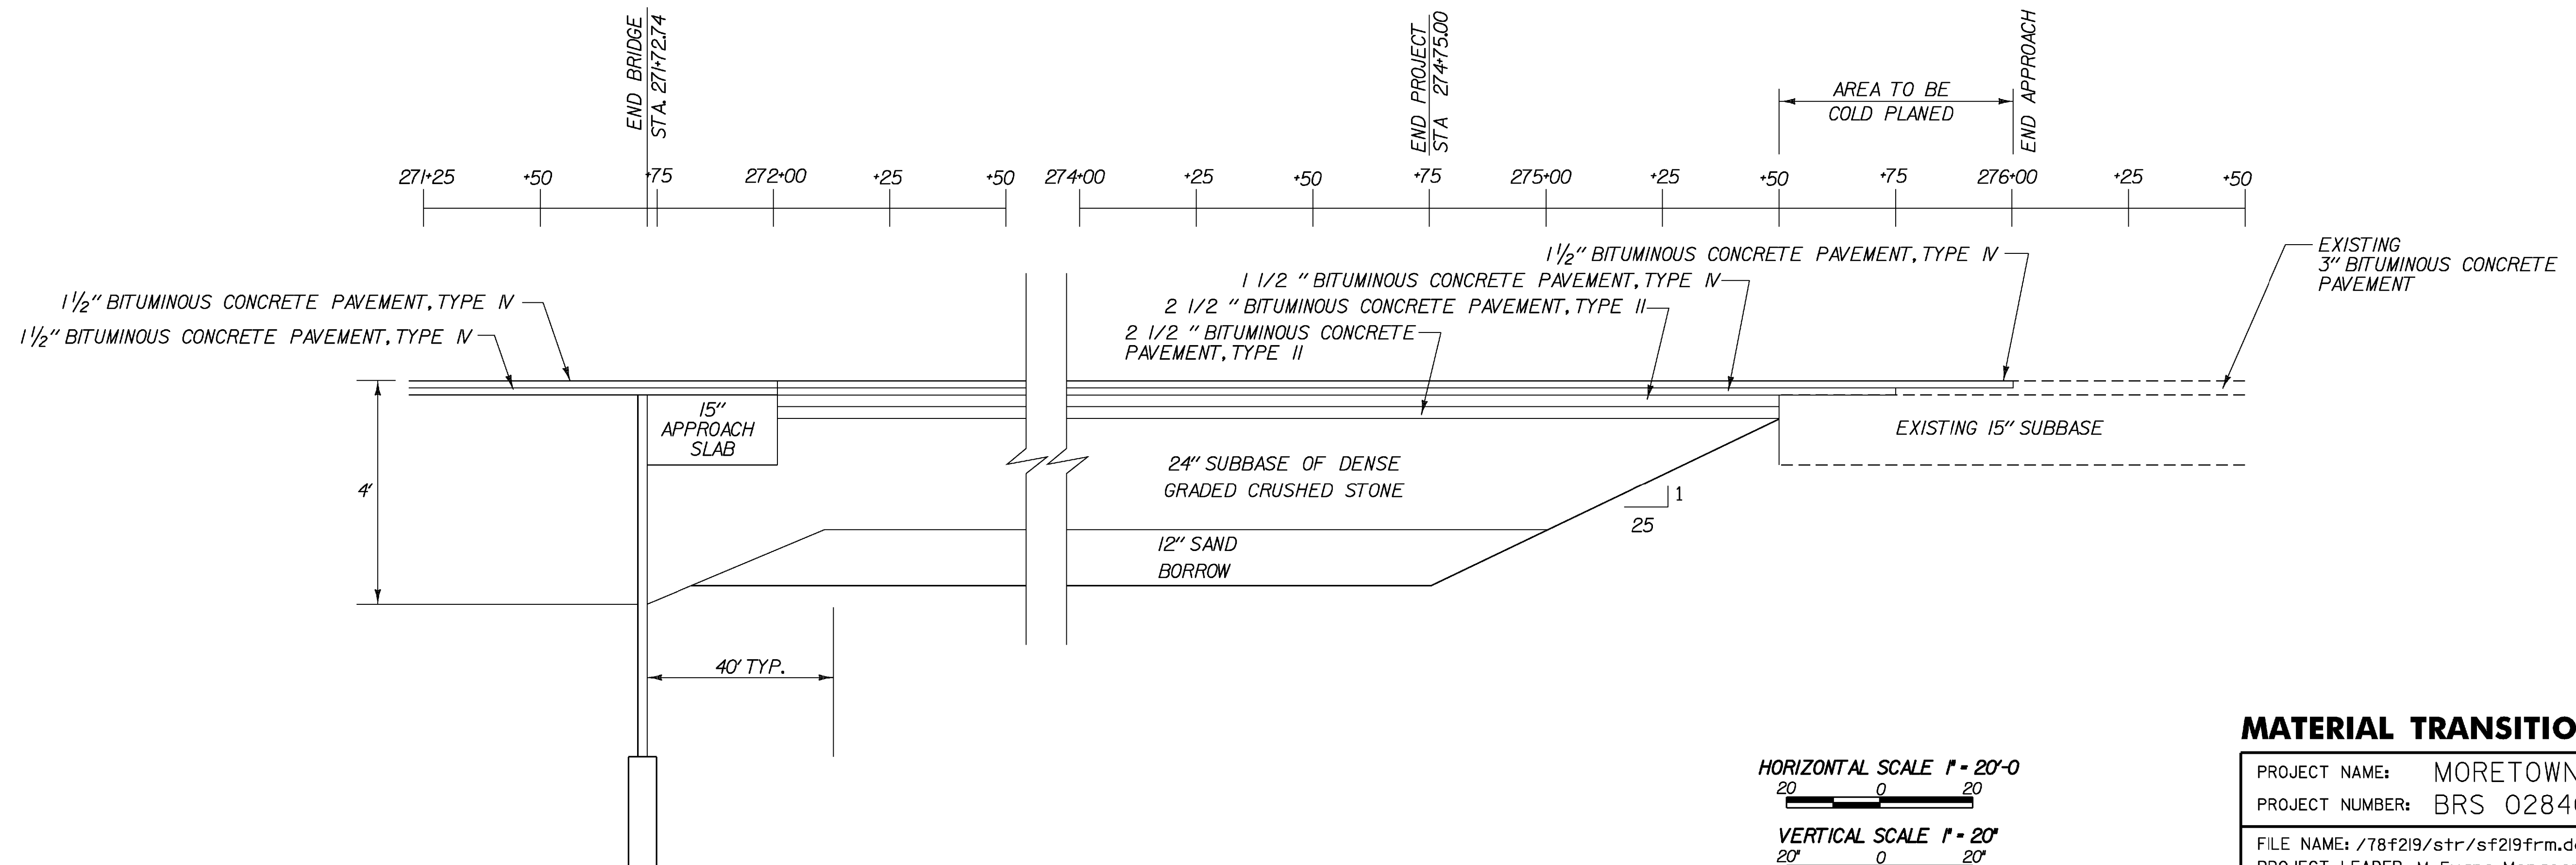

HORIZONTAL SCALE 1" = 20'-0"

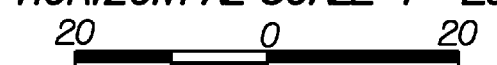

VERTICAL SCALE 1" = 20'

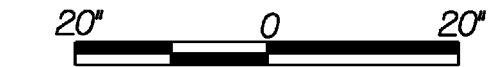

MATERIAL TRANSITION DIAGRAM

PROJECT NAME: MORETOWN-MIDDLESEX

PROJECT NUMBER: BRS 0284(14)

FILE NAME: /78f219/str/sf219frm.dgn

PLOT DATE: 15-JUN-2009

PROJECT LEADER: M. Evans-Mongeon

DRAWN BY: L. DUQUETTE

DESIGNED BY: S. SCRIBNER

CHECKED BY: S. SCRIBNER

IPARM: s78f219mt.1

SHEET 81 OF 103